

RECEIVED

DOE/METC-96/1029-16,2

APR 18 1995

OSTI

**METC/3M Cooperative Agreement CRADA 94-024
High Temperature High Pressure Filter Materials
Exposure Test Program**

Final Report, Volume II

June 1995

U.S. Department of Energy
Office of Fossil Energy
Morgantown Energy Technology Center
3610 Collins Ferry Road
Morgantown, WV 26505

and

Minnesota Mining and Manufacturing Company
3M Ceramic Materials Department
3M Center Building 207-1S-23
St. Paul, MN 55144-1000

Contributors:

J.M. Rockey, J.R. Bird, E. Galloway, A.P. Lui,
D. Eckels, J. Rutten, M.S. Tucker, P.C. Yue,
R.L. Pineault, J.C. Pack, T. Thomson

MASTER

DISTRIBUTION OF THIS DOCUMENT IS UNLIMITED *at*



**METC/3M Cooperative Agreement CRADA 94-024
High Temperature High Pressure Filter Materials
Exposure Test Program**

Final Report, Volume II

June 1995

U.S. Department of Energy
Office of Fossil Energy
Morgantown Energy Technology Center
3610 Collins Ferry Road
Morgantown, WV 26505

and
Minnesota Mining and Manufacturing Company
3M Ceramic Materials Department
3M Center Building 207-1S-23
St. Paul, MN 55144-1000

Contributors:

J.M. Rockey, J.R. Bird, E. Galloway, A.P. Lui,
D. Eckels, J. Rutten, M.S. Tucker, P.C. Yue,
R.L. Pineault, J.C. Pack, T. Thomson

DISCLAIMER

This report was prepared as an account of work sponsored by an agency of the United States Government. Neither the United States Government nor any agency thereof, nor any of their employees, makes any warranty, express or implied, or assumes any legal liability or responsibility for the accuracy, completeness, or usefulness of any information, apparatus, product, or process disclosed, or represents that its use would not infringe privately owned rights. Reference herein to any specific commercial product, process, or service by trade name, trademark, manufacturer, or otherwise does not necessarily constitute or imply its endorsement, recommendation, or favoring by the United States Government or any agency thereof. The views and opinions of authors expressed herein do not necessarily state or reflect those of the United States Government or any agency thereof.

 


Table of Contents

	<u>PAGE</u>
Volume I	
1. Executive Summary	03
2. Objective	04
3. Gasifier and Cleanup Facility Description	04
4. Gasifier and Cleanup Facility Operation	13
A. Test Run 93FBG/MGC07	13
a. Test Objectives	13
b. Run Highlights	13
c. Summary of Gasifier Operating Conditions . . .	14
d. Product Analysis	15-17
e. Summary of Cleanup Rig Conditions	18
B. Test Run 93FBG/MGC08	19
a. Test Objectives	19
b. Run Highlights	19
c. Summary of Gasifier Operating Conditions . .	20
d. Product Analysis	21-23
e. Summary of Cleanup Rig Conditions	24
C. Test Run 93FBG/MGC09	25
a. Test Objectives	25
b. Run Highlights	25
c. Summary of Gasifier Operating Conditions . .	26
d. Product Analysis	27-28
e. Summary of Cleanup Rig Conditions	29
D. Test Run 94FBG/MGC010	30
a. Test Objectives	30
b. Run Highlights	30
c. Summary of Gasifier Operating Conditions . .	31
d. Product Analysis	32-33
e. Summary of Cleanup Rig Conditions	34
Volume II	
Appendix 1: Summary of Particulate Monitoring Results . .	A1
Appendix 2: Detailed Chronology of Significant Run Events	A2
Appendix 3: Daily Process Variable Plots	A3
Appendix 4: Process and Instrumentation Drawings	A4



APPENDIX 1

SUMMARY OF PARTICULATE MONITORING RESULTS



Appendix 1: Summary of Particulate Monitoring Results

This report is a summary of the results of activities of the particulate monitoring group in support of the METC/3M CRADA 94-024. Online particulate monitoring began in June, 1994 and ended in October, 1994. The particulate monitoring group participated in four MGCR runs (#7 through #10). The instrument used in measuring the particle loadings (particle counts and size distribution) is the Particle Measuring Systems Classical Scattering Aerosol Spectrometer Probe High Temperature and High Pressure (PMS Model CSASP-100-HTHP). This PMS unit is rated to operate at temperatures up to 540°C and gage pressures up to 2.07 MPa.

Gas stream conditions, temperature at 540°C, gage pressure at 2.93 MPa, and gas flowrate at 0.0157 SCM per second, precluded the direct measurement of particulate loadings in the gas stream with the PMS unit. A side stream was extracted from the gas stream after it came over to the MGCR, Modular Gas Cleanup Rig, from the FBG, pressurized Fluidized-Bed Gasifier, but before it entered the filter testing vessel. A sampling probe of 0.635 cm O.D. thin wall stainless steel tubing was used for extracting the sample gas isokinetically based on the expected flowrate. The sample gas stream was further split into two streams; one was directed to the PMS unit and the other to the alkali monitor unit. The alkali monitor unit was not used during runs #7 through #10.

The gas flowrate to the PMS unit was controlled by a critical orifice to minimize particle loss. The actual sample gas flowrate was recorded continuously by the DDAS, Distributed Data Acquisition System.

The PMS unit was set to a measuring cycle of 90 seconds which resulted in about 40 measuring cycles per hour. At the end of each cycle it reported the total particle count and particle count in each size group. These were recorded by a PC. To obtain the particle loadings from measurements (i.e. particle number density and particle mass loading) it was necessary to perform post measurement calculations with flow data recorded by the DDAS which also recorded other operation parameters of the FBG and the MGCR.

Unfortunately, technical difficulties prohibited the DDAS recording of the flow data to the PMS unit for runs #7 and #10. All data were processed with flowrate values either actually recorded or a fixed value that was observed during the runs. In cases where actual flow information was available an average of 15 flow values was used to process each data set of 90 seconds (DDAS recorded flow data at a 6 second interval). Only data sets containing 6 or more hours of continuous records were processed in order to obtain a time history of the data trend.

In each data set presented, each data point represents a 15-minute ensemble average (an average of 10 measurements). Three plots of the ensemble averages were generated from each data set; mean particle diameter, mean number concentration, and mean mass loading. For mass loading calculations, a particle mass density value of 1.0 gram per cubic centimeter (1 gm/cc) was used, following the general practice used by some optical particle monitor vendors. The actual mass loading can be easily obtained by multiplying the mass loading with the appropriate particle mass density. For these FBG/MGCR runs the particle mass density varied from 2.2 to 2.5 gm/cc depending on the specific runs. A nominal value of 2.3 gm/cc has been suggested for use.

In the following, for each run presented is an example of an unprocessed particle size distribution of one 90 second measuring cycle and an example of a 15-minute averaged size distribution. Then for each data set, 3 plots are presented, one for the ensemble mean values of diameters, number concentration, and mass loading over each measuring period. In an ideal situation, when constant particle loadings and particle size distribution are present, a straight line curve for these last three plots is expected. But there are many factors that may contribute to the measured variations of particle loading and size; gasifier operations conditions, gas stream flow and pressure fluctuations, particle deposition on and re-entrainment from pipes and valves, etc.

PMS at MGCR Run #7

MGCR Run #7 took place in June, 1994. Nine hours of particulate data were collected. These data were processed with a constant flowrate of 1.18×10^{-3} SCM/sec (150 scfh) because no flow data for the particulate measuring period were recorded by the DDAS. This flow value was the expected flowrate using the combined critical flow orifice and backpressure controlled valve. Figure 5a is the particle size distribution of unprocessed data from a measuring cycle and Figure 5b shows a 15-minute average size distribution. Here we see that the average distribution is very much the same as the distribution of a single measurement. The ensemble mean diameter of the particles for this run is shown in Figure 5c. Since a constant flowrate was used to calculate the particle number concentration (Figure 5d) and mass loading (Figure 5e) they may not represent the true particle loadings.

PMS at MGCR Run #8

MGCR Run #8 took place in July, 1994. Particulate measurements included 8 hours on 7/19/94, 10 hours and 30 minutes on 7/21/94, and 23 hours on 7/22/94. Again, comparing the particle size distributions between an unprocessed single measurement (Figure 6a) and that of a 15 minute average (Figure 6b), shows no significant difference. Figures 6c, 6d, and 6e are plots of the 15 minute ensemble mean particle diameters, number concentrations, and mass loadings for the 8 hour period taken on

7/19/94. The particle data collected on 7/21 and 7/22 showed large fluctuations in ensemble mean diameters (Figure 7a and 7b) and number concentrations (Figures 7b and 8b). Consequently, the mass loadings also show large fluctuations (Figures 7c and 8c).

PMS at MGCR Run #9

Two sets of particulate measurements were taken in this run. On 9/13/94, 7 hours of particulate data were collected. Again, the size distribution is consistent between a single measuring cycle (Figure 9a) and the 15-minute averaged sized distribution (Figure 9b). The ensemble mean particle diameters are relatively large, about 0.8 microns, as shown in Figure 9c. The number concentration plot (Figure 9d) and the mass loading plot (Figure 9e) showed relatively constant values except for a sharp drop at around 1300 hours. The data collected between 9/15 and 9/16 show that the ensemble mean diameters (Figure 10a) varied more than those taken on 9/13. The mean particle concentrations also show large variations (Figure 10b). The mass loadings (Figure 10c) seem to amplify the variations in number concentration.

PMS at MGCR Run #10

In the final run, MGCR Run #10, the DDAS recording bug struck again. The record showed zero values for the particulate sample flow during the measuring period. We again used a constant flowrate of 1.18×10^{-3} SCM/sec (150 scfh) to process the data. The plots in Figures 10a through 10e for this set of data are the same as those for the previous sets of data. While the mean particle diameters remained between 0.85 to 0.7 micrometers (see Figure 10a) there was a big drop in particle number concentration occurring at 1245 hours, as shown in Figure 10b. This big drop in number concentration may be due to partial plugging of the sampling probe or flow valves. If DDAS flow data were available this loss of flow would be accounted for in the averaging.

Conclusion

Obviously the operating conditions of the FBG affected the particulate loading and size distributions in the gas stream. The ability to maintain size calibration of the PMS also affected the measured results. We tried to collect solid samples downstream of the PMS unit to compare loadings from optical measurements. However we found the mass loadings on the high temperature ceramic thimble filters were not consistent. We suspected that leakage at the seal of the thimble filter was the cause. For instance, solid catches under high temperature showed loadings varied from 0.09 to 0.13 gram per hour. It is suspected that thermal expansion may have contributed to the leakage problem.

Supplemental to the online particulate monitoring, the following table provides the hours of filtration and the pounds of solid filtered with respect to the filtration vessel.

Run Number	Hours of Filtration per Run	Pounds of Solid Collected
7	119	2.12
8	189	5.62
9	86	3.38
10	89	2.56

Particle Size Distribution
MGCR Run #7 94/06/14 01:01:26

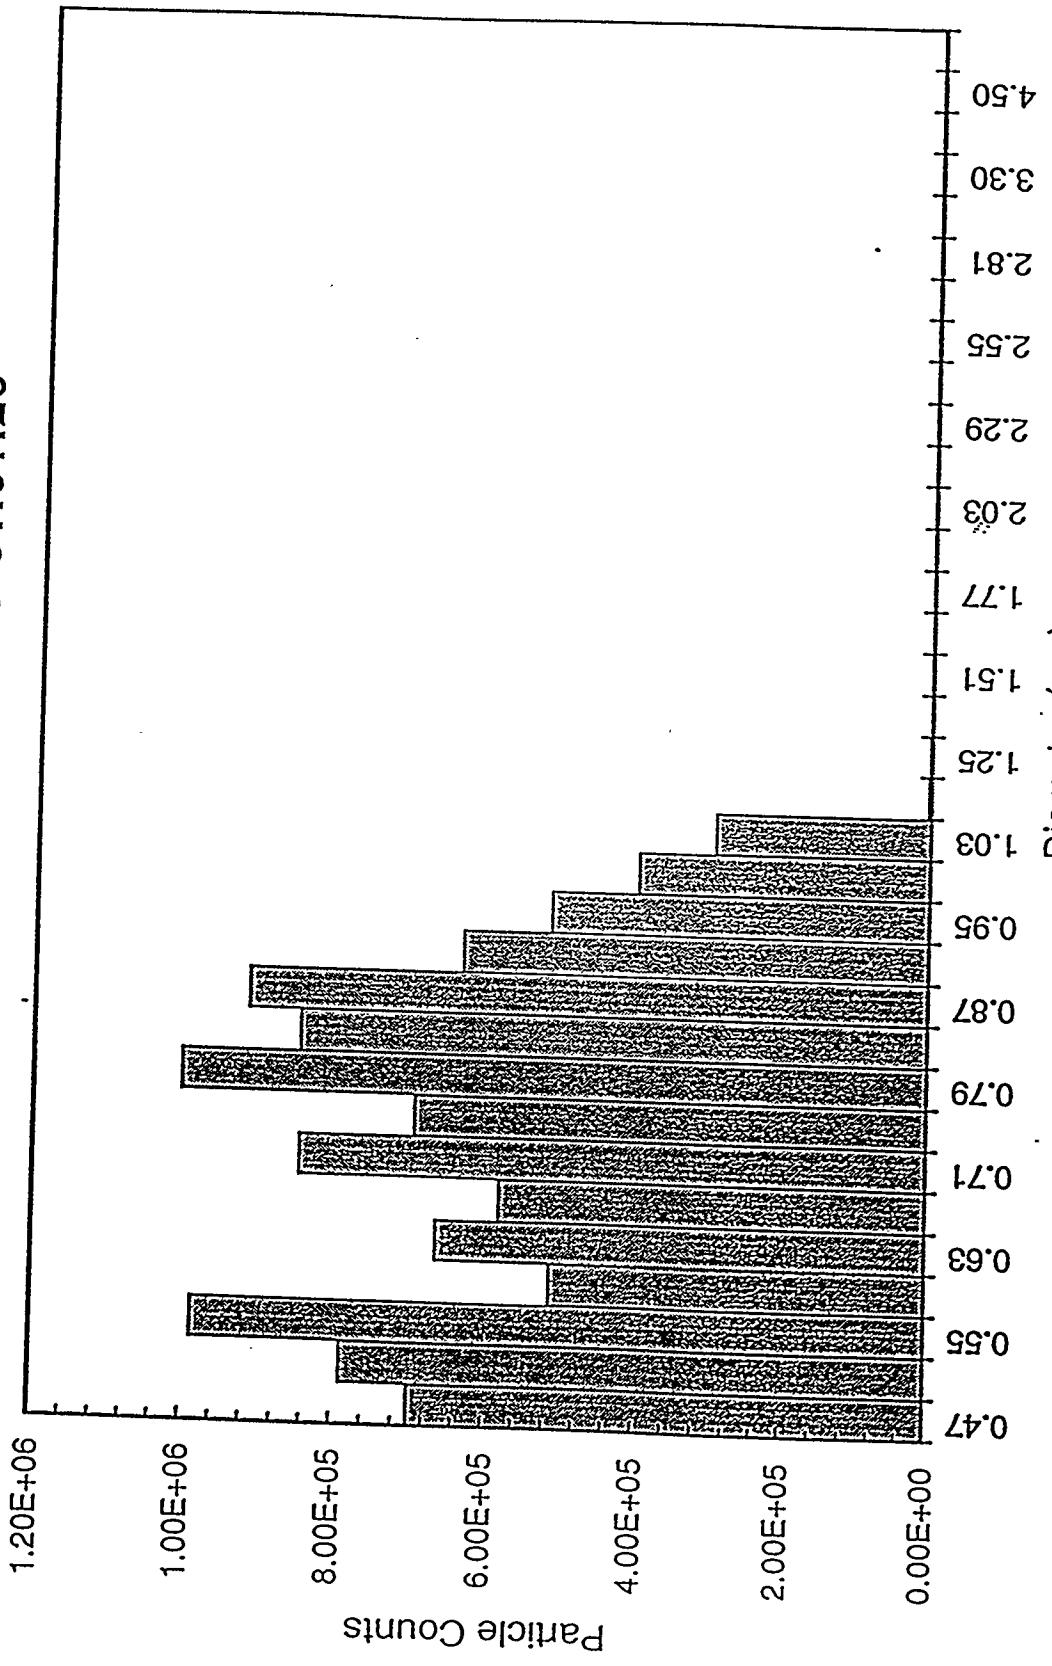


Figure 5a. Unprocessed particle size distribution from a single measurement.

Averaged Particle Size Distribution
MGCR Run #7 94/06/14 01:00

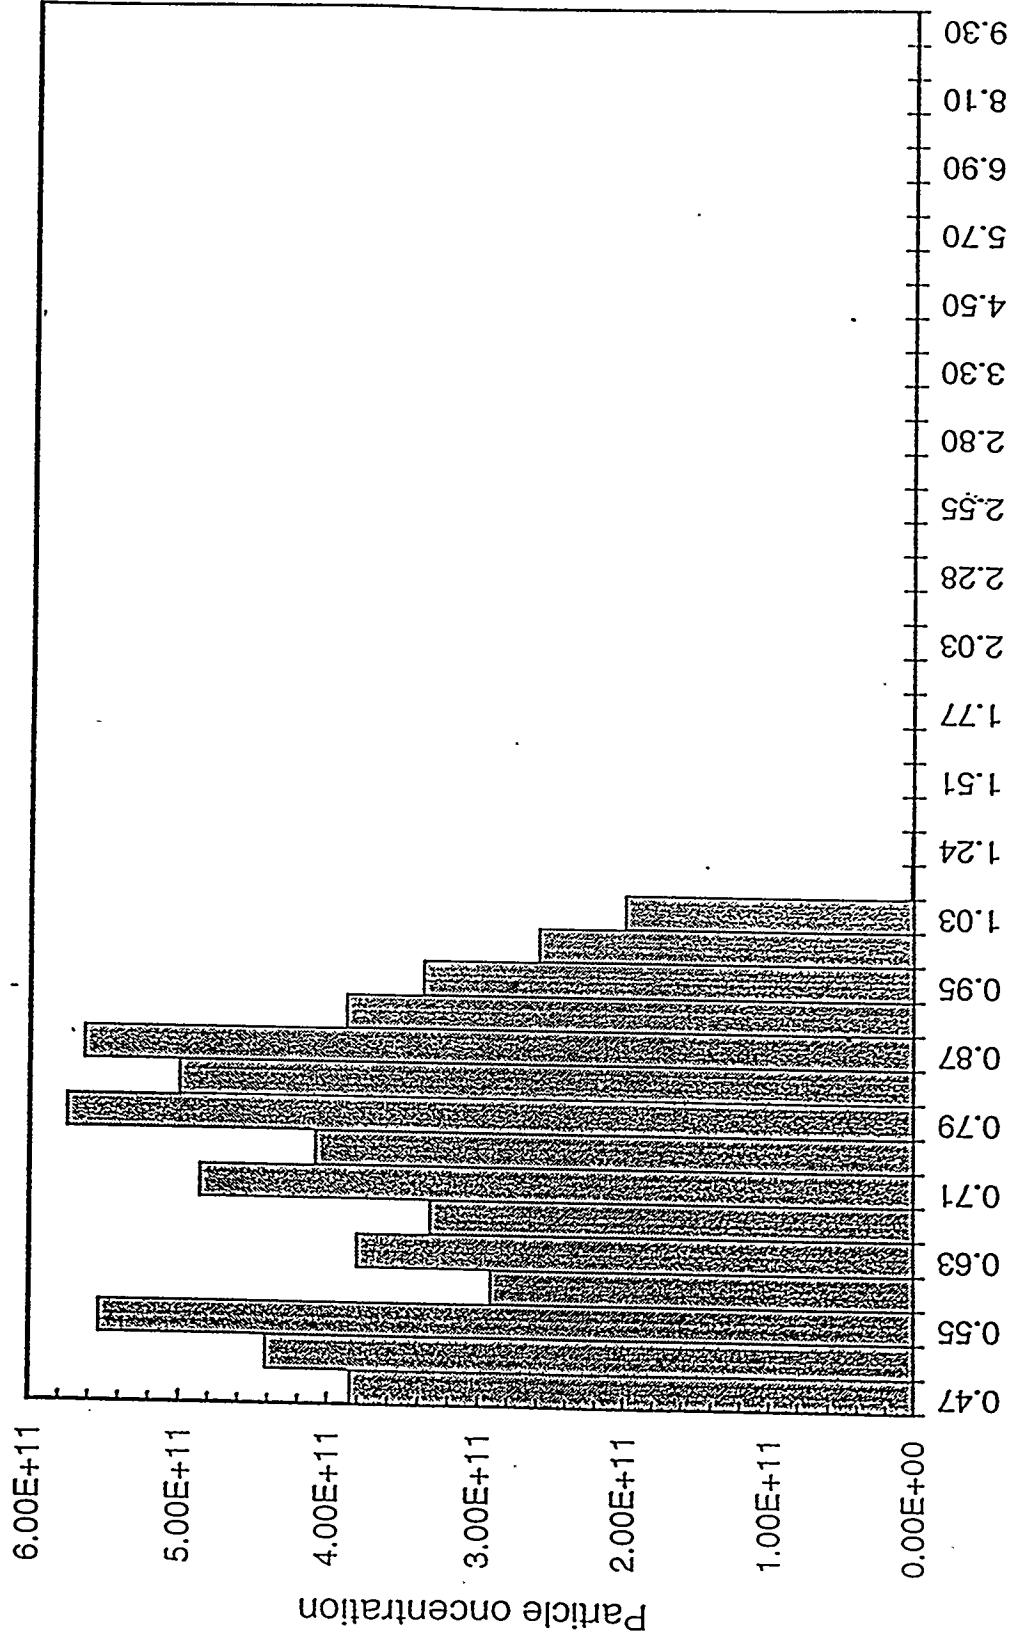


Figure 5b. A 15-minute averaged particle size distribution.

PMS at MGCR Run #7
6/14/94

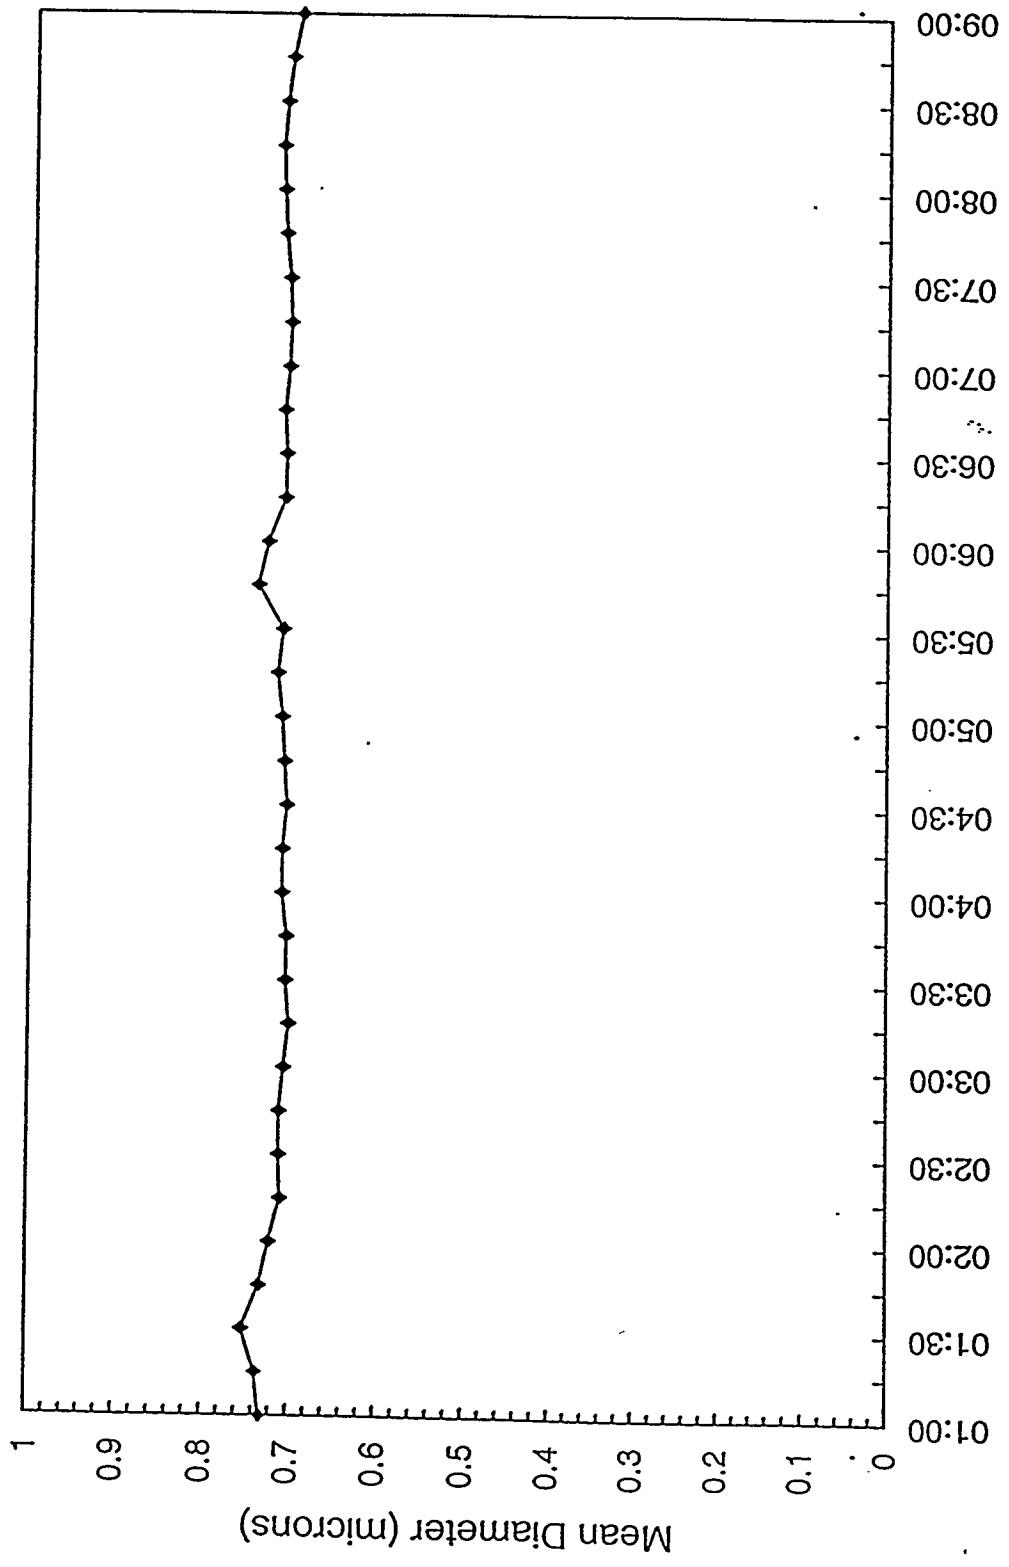


Figure 5c. Ensemble mean particle diameters.

PMS at MGCR Run #7
6/14/94

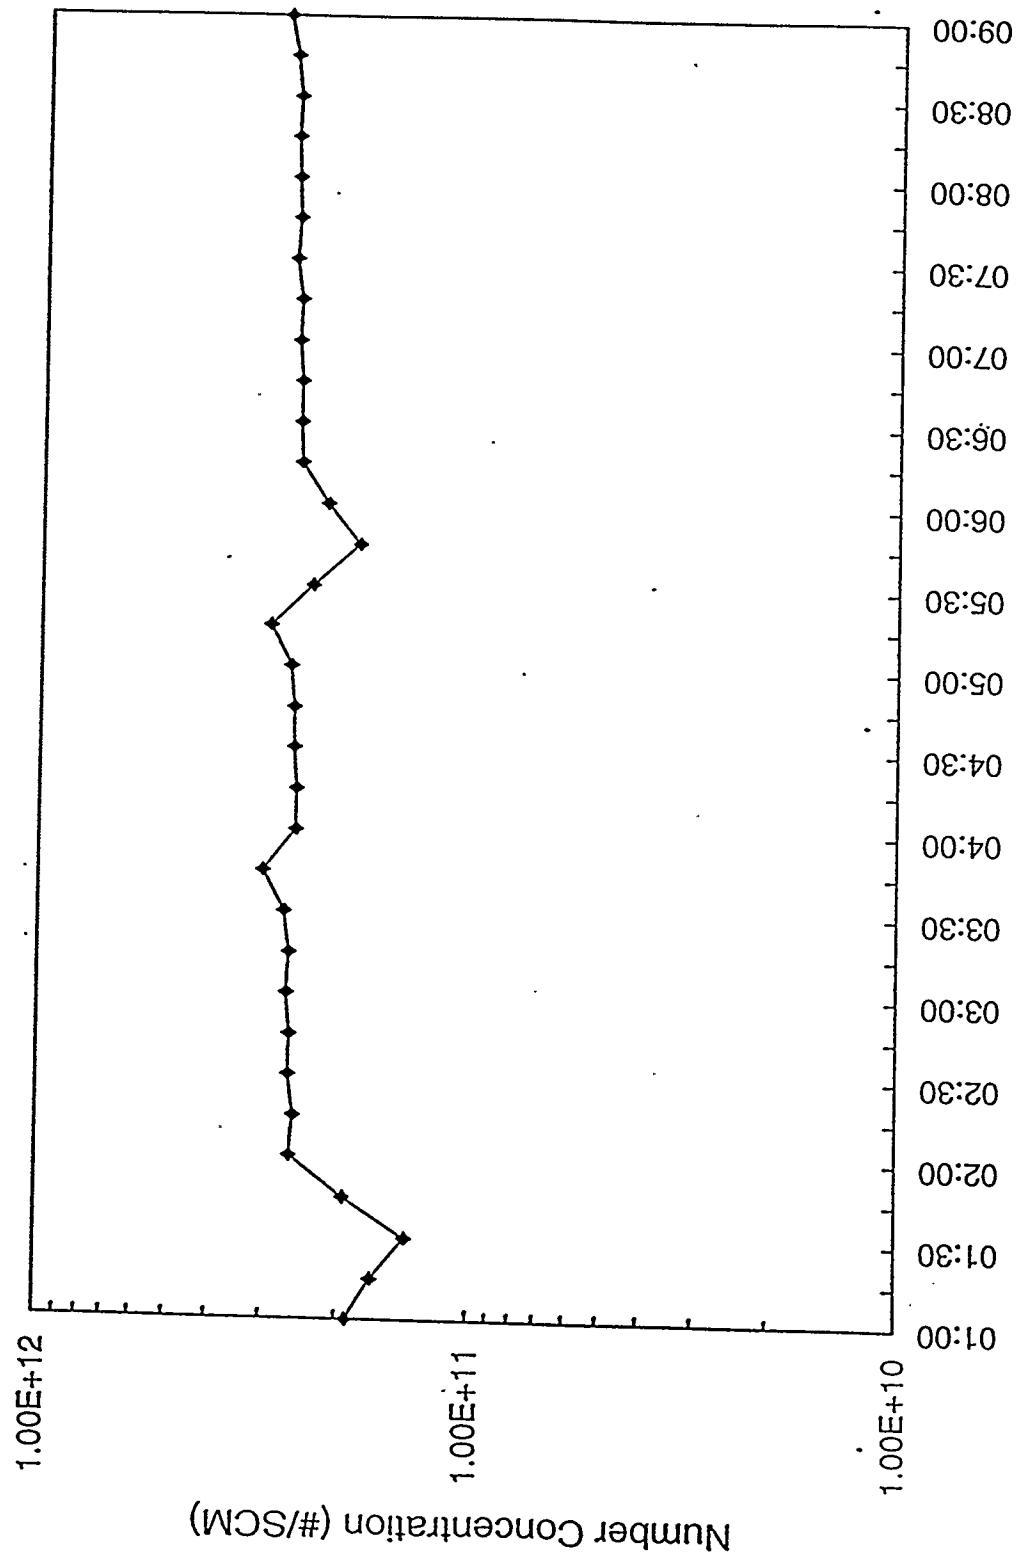


Figure 5d. Ensemble mean particle concentrations.

PMS at MGCR Run #7
6/14/94

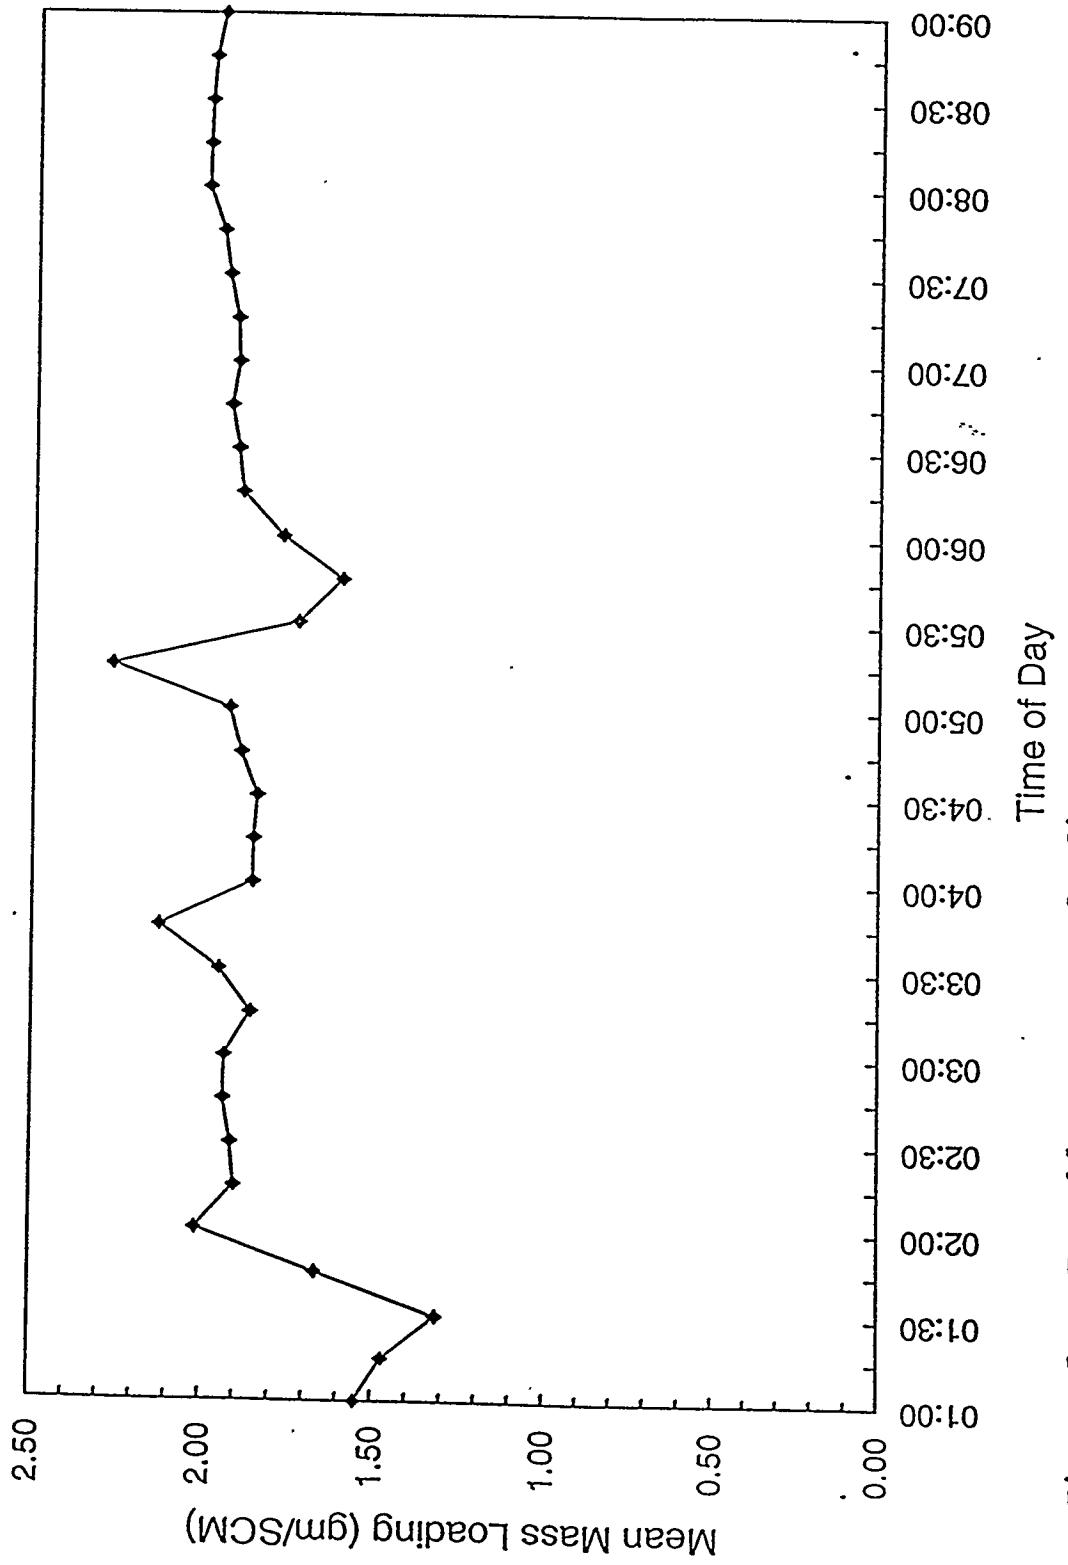


Figure 5e. Ensemble mean mass loadings.

Particle Size Distribution
MGCR Run #8 94/07/19 12:00:13

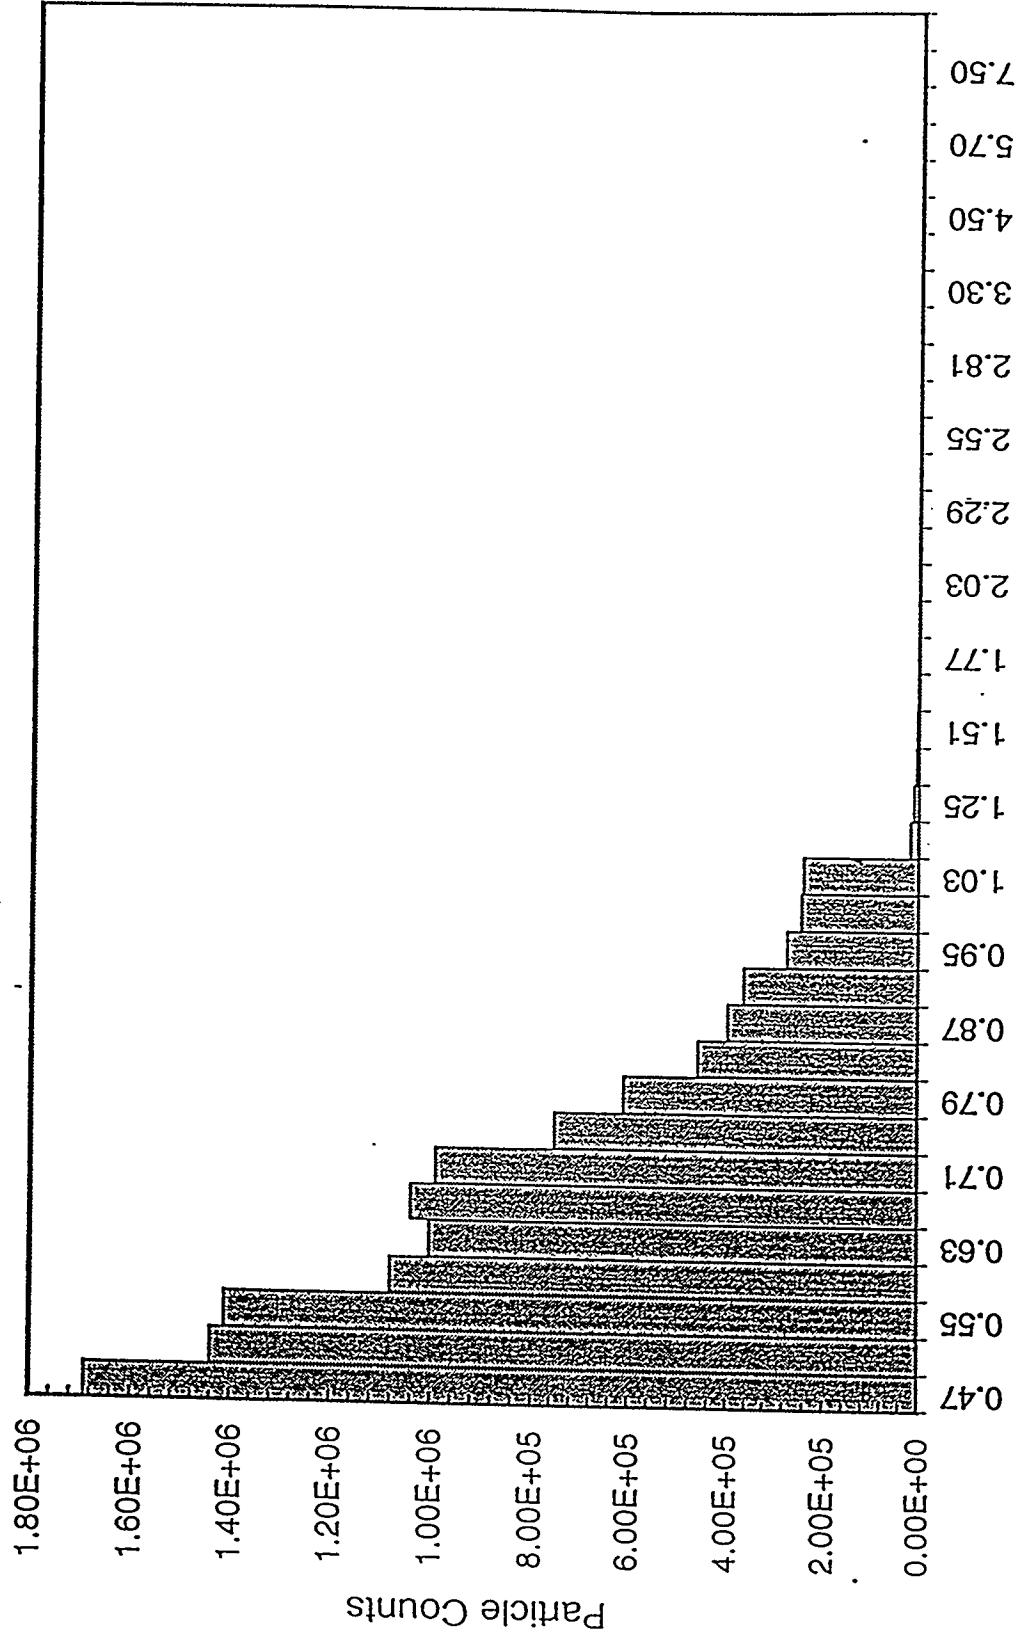


Figure 6a. Unprocessed particle size distribution from a single measurement.

Averaged Particle Size Distribution
MGGCR Run #8 94/07/19 12:00

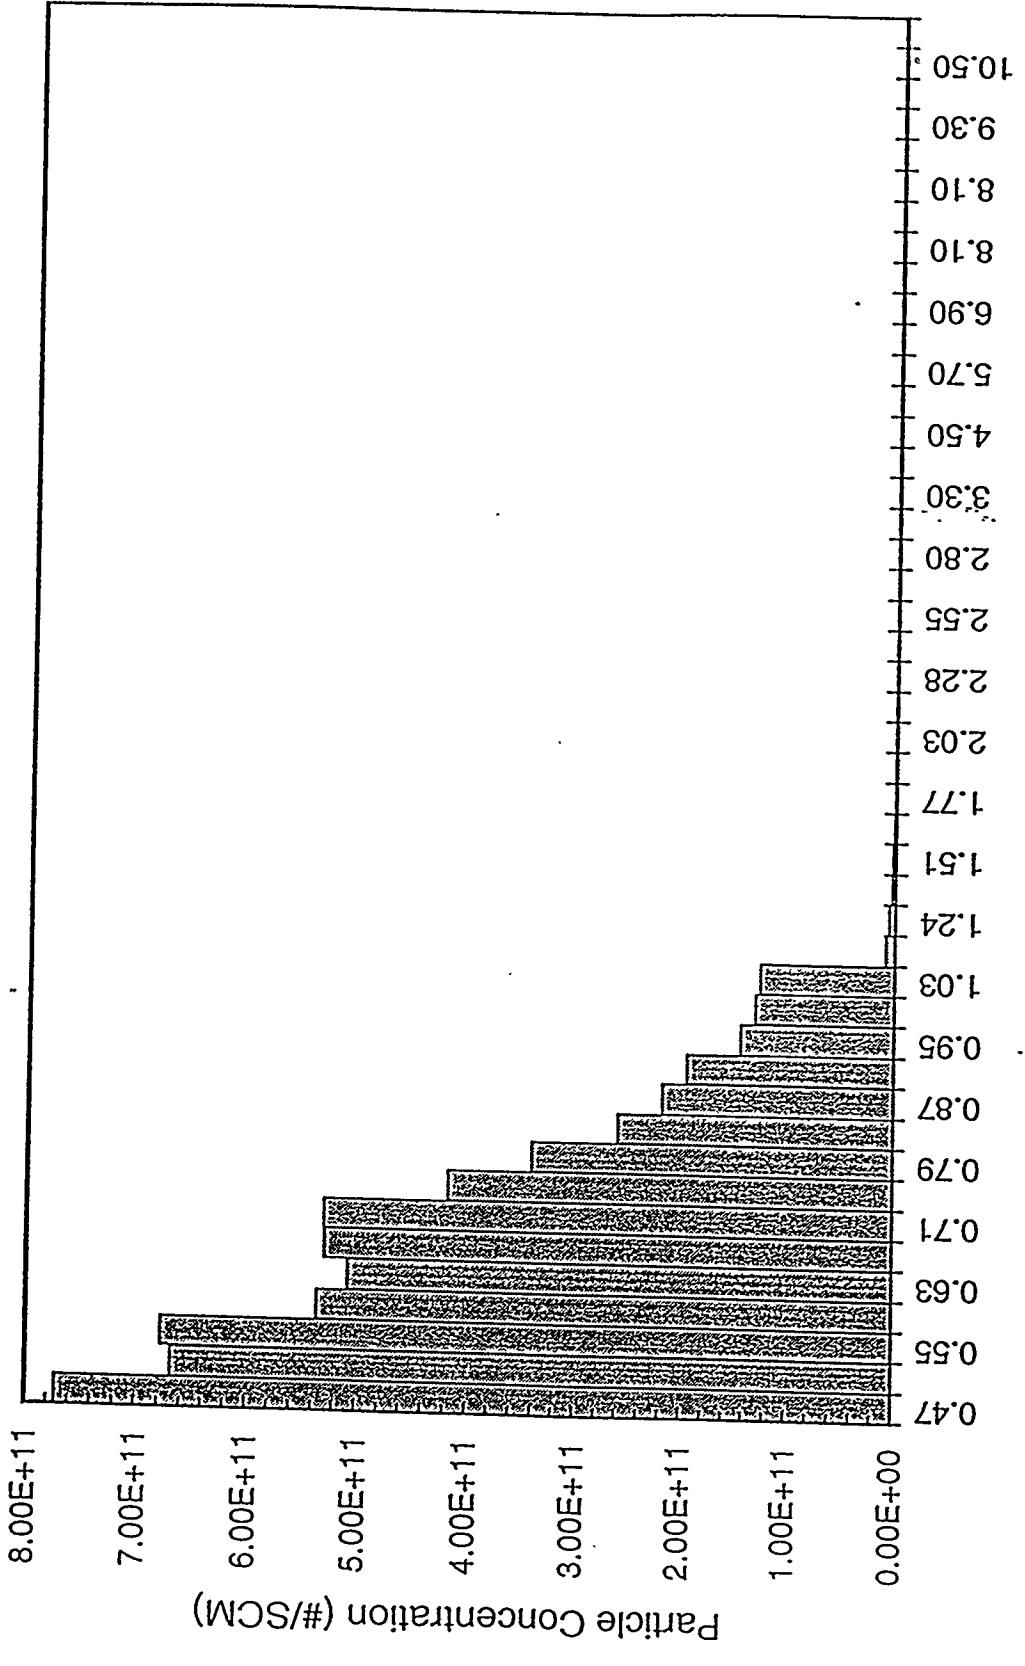


Figure 6b. A 15-minute averaged particle size distribution.

PMS at MGCR Run #8
7/19/94

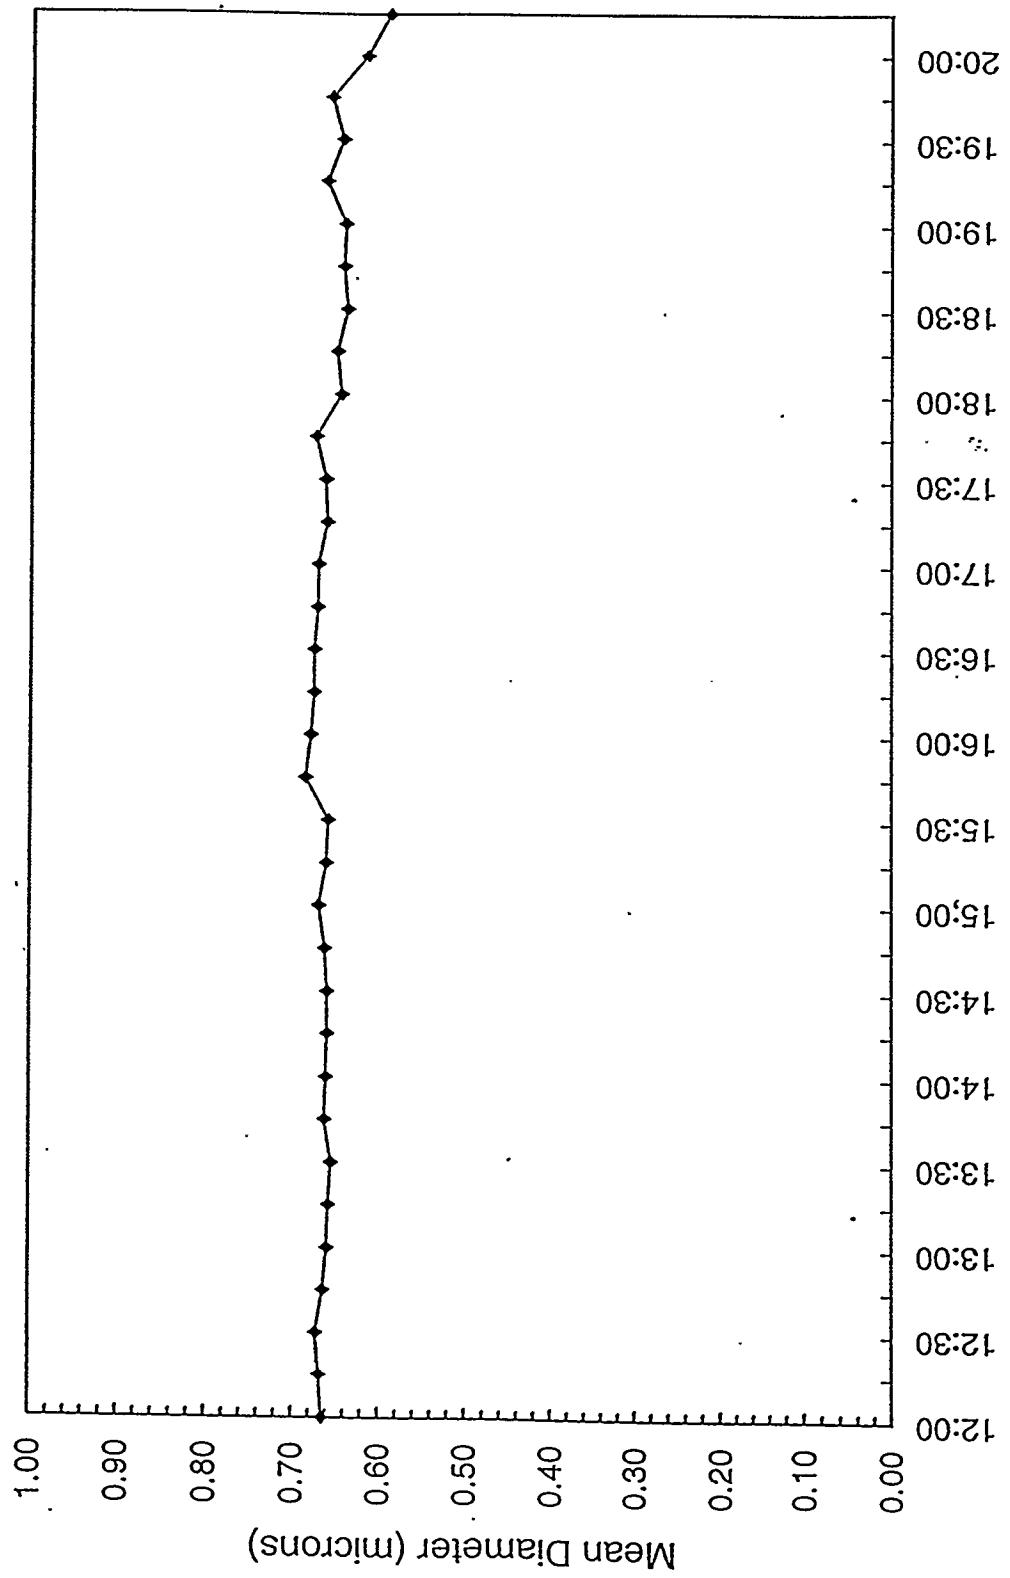


Figure 6c. Ensemble mean particle diameters.

PMS at MGCR Run #8
7/19/94

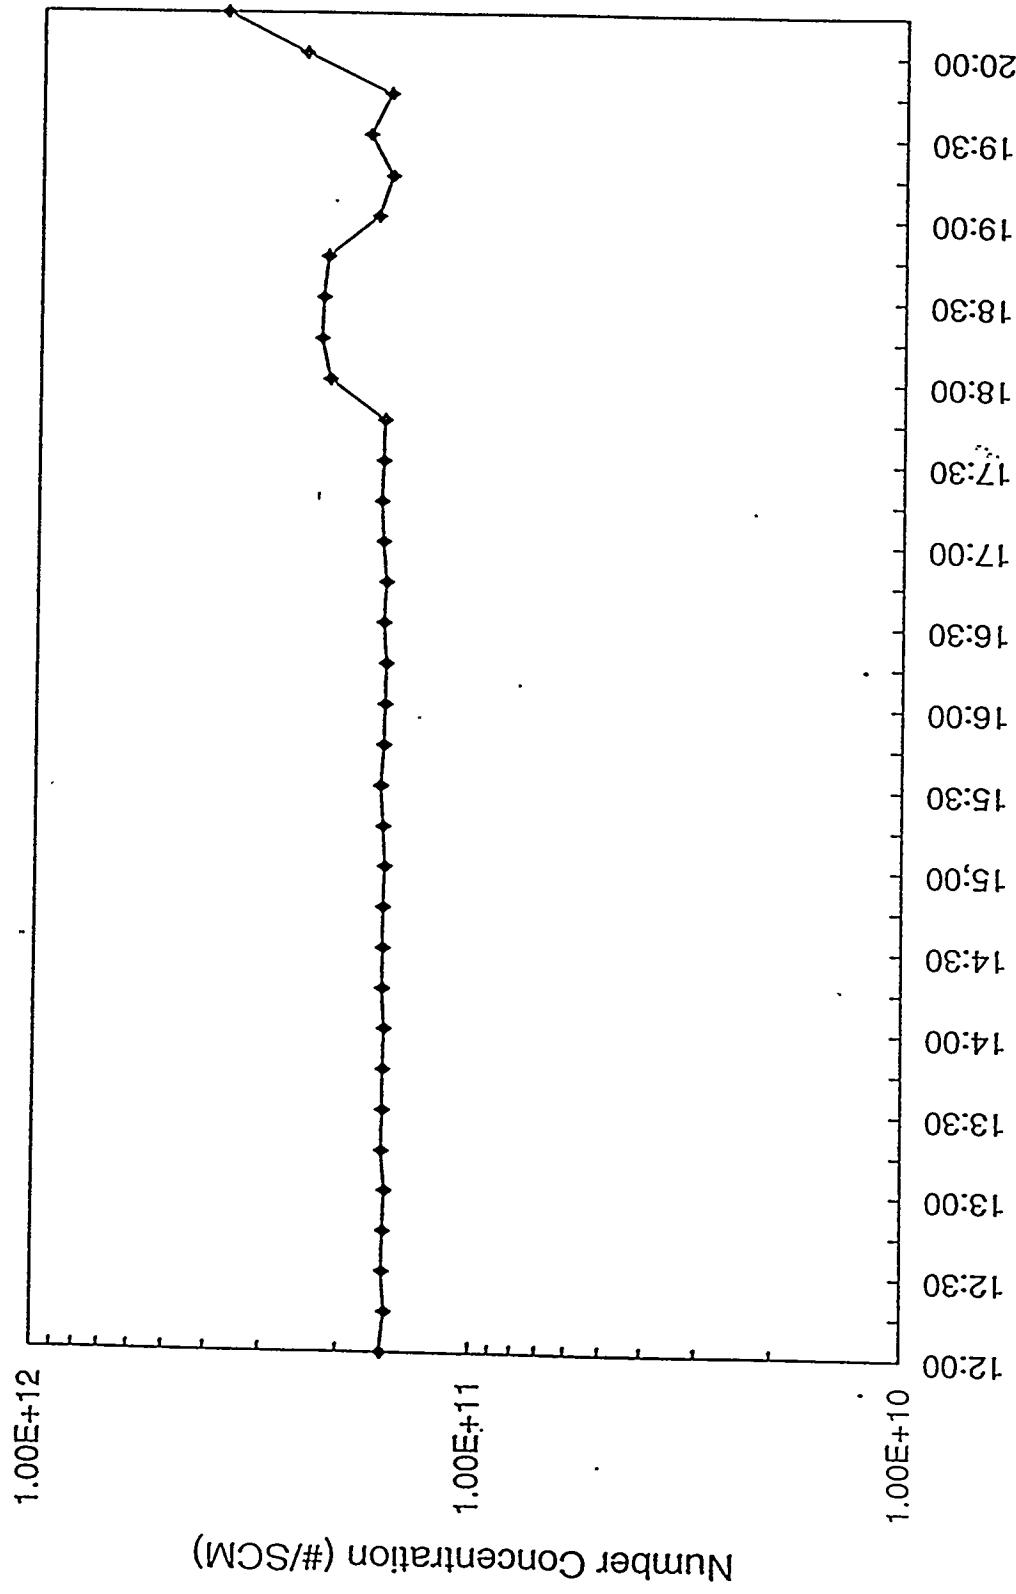


Figure 6d. Ensemble mean particle concentrations.

PMS at MGCR Run #8
7/19/94

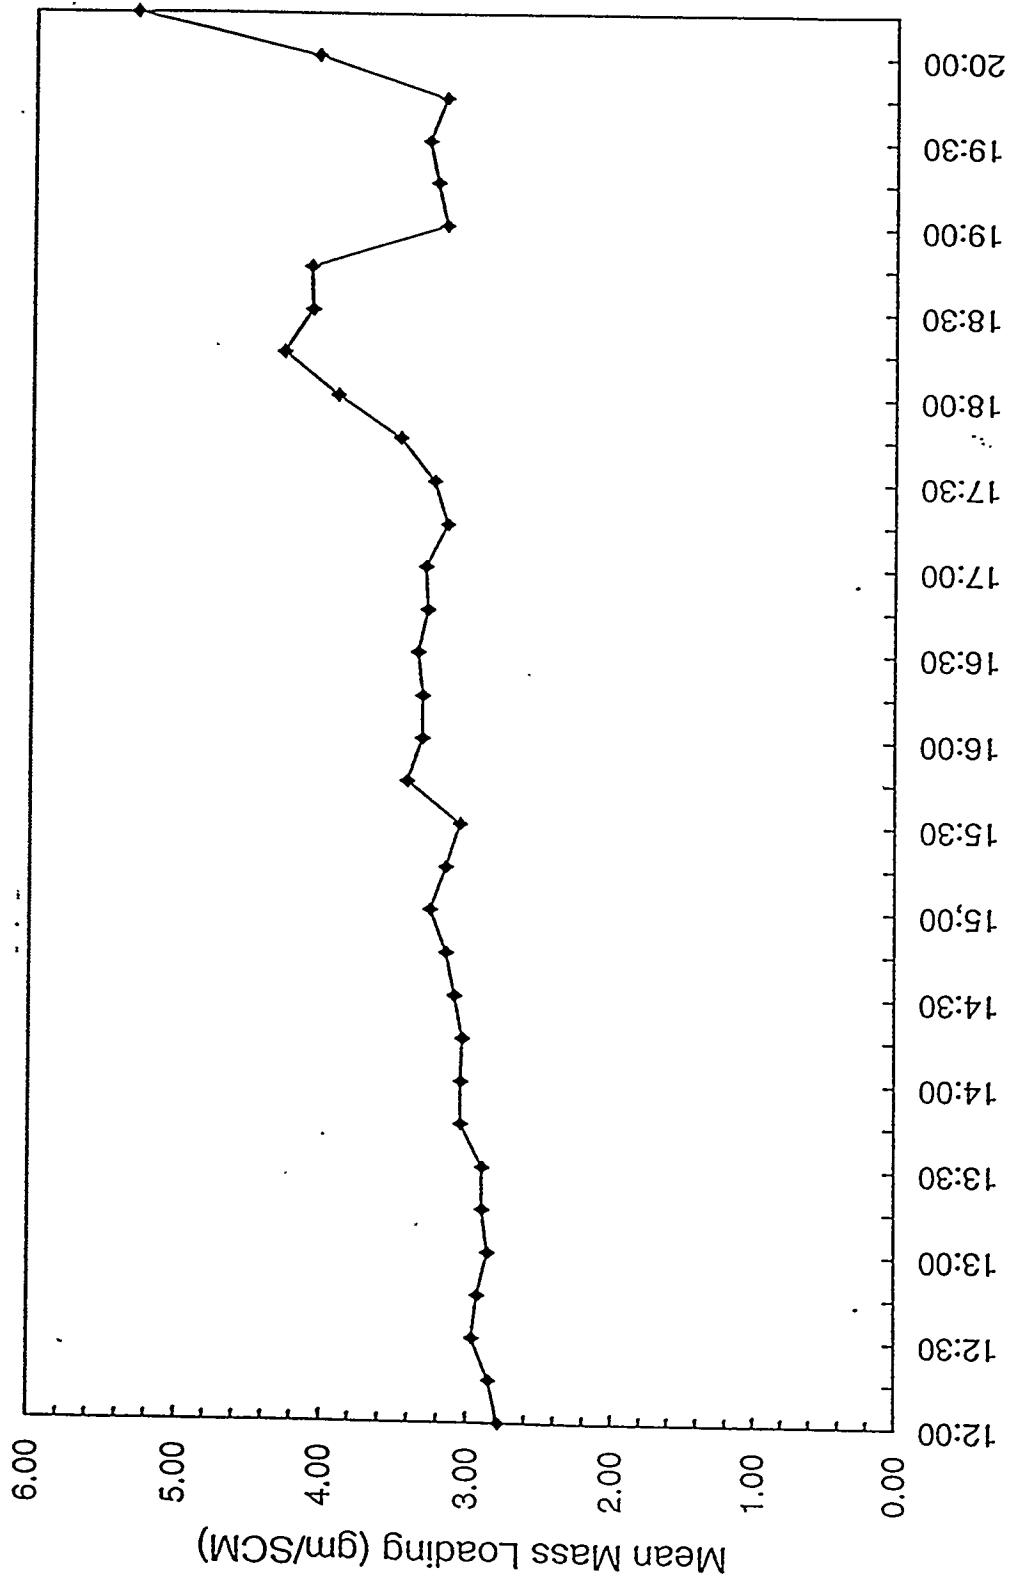


Figure 6e. Ensemble mean mass loadings.

PMS at MGCR Run #8
7/21/94

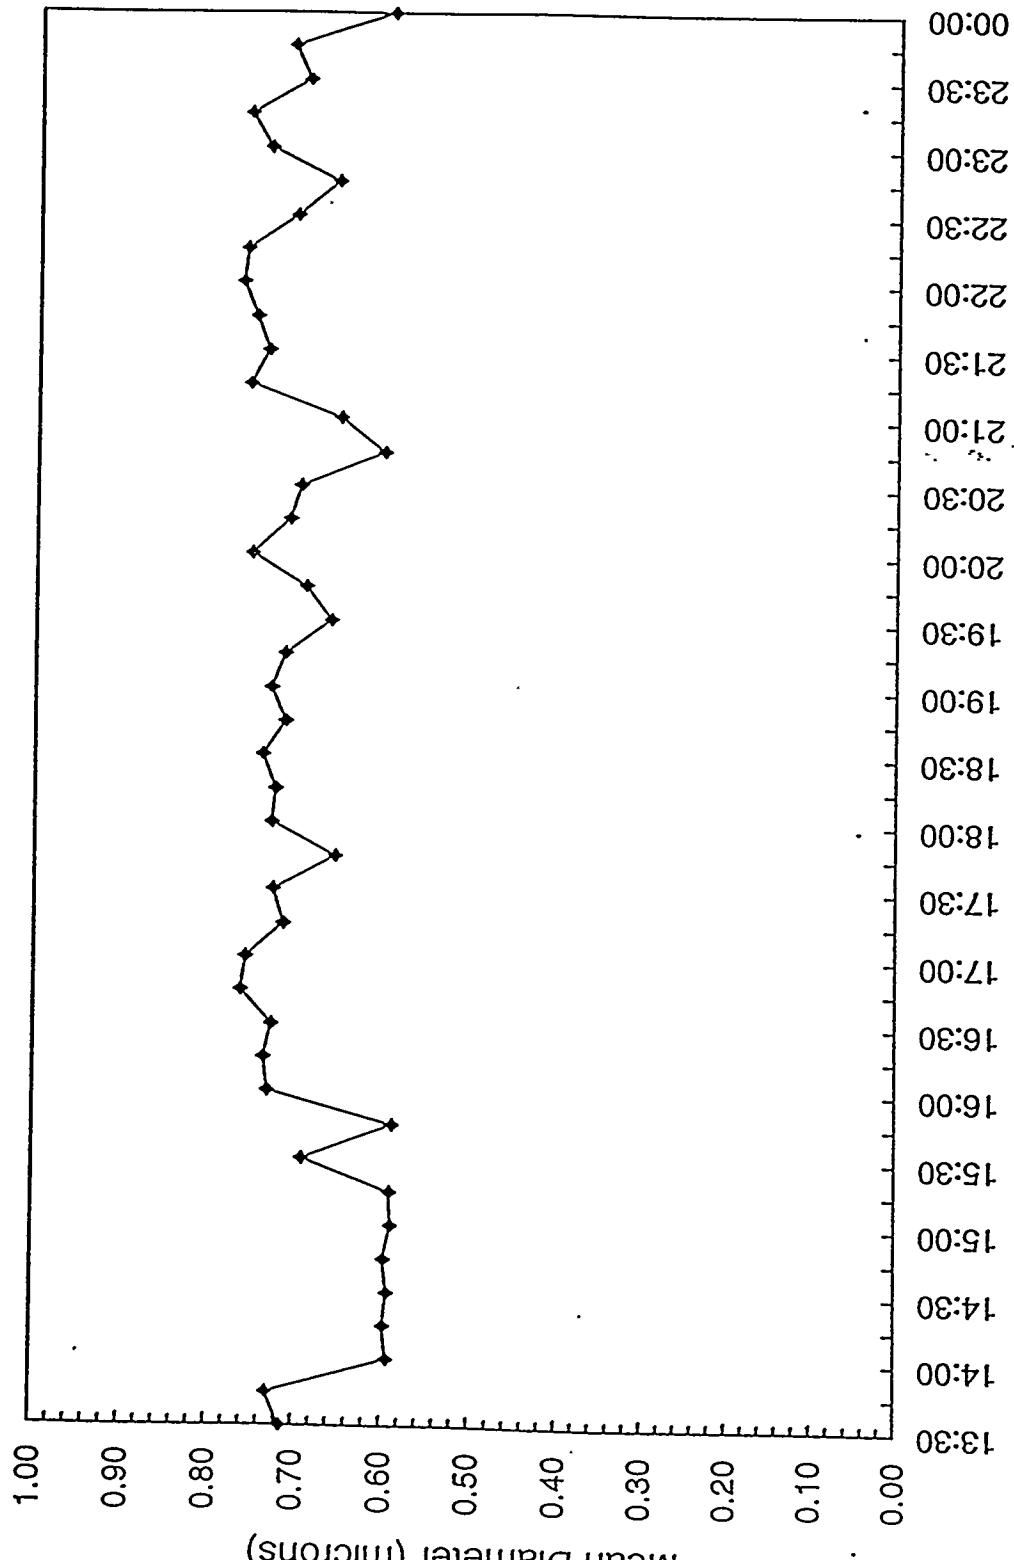


Figure 7a. Ensemble mean particle diameters.

PMS at MGCCR Run #8
7/21/94

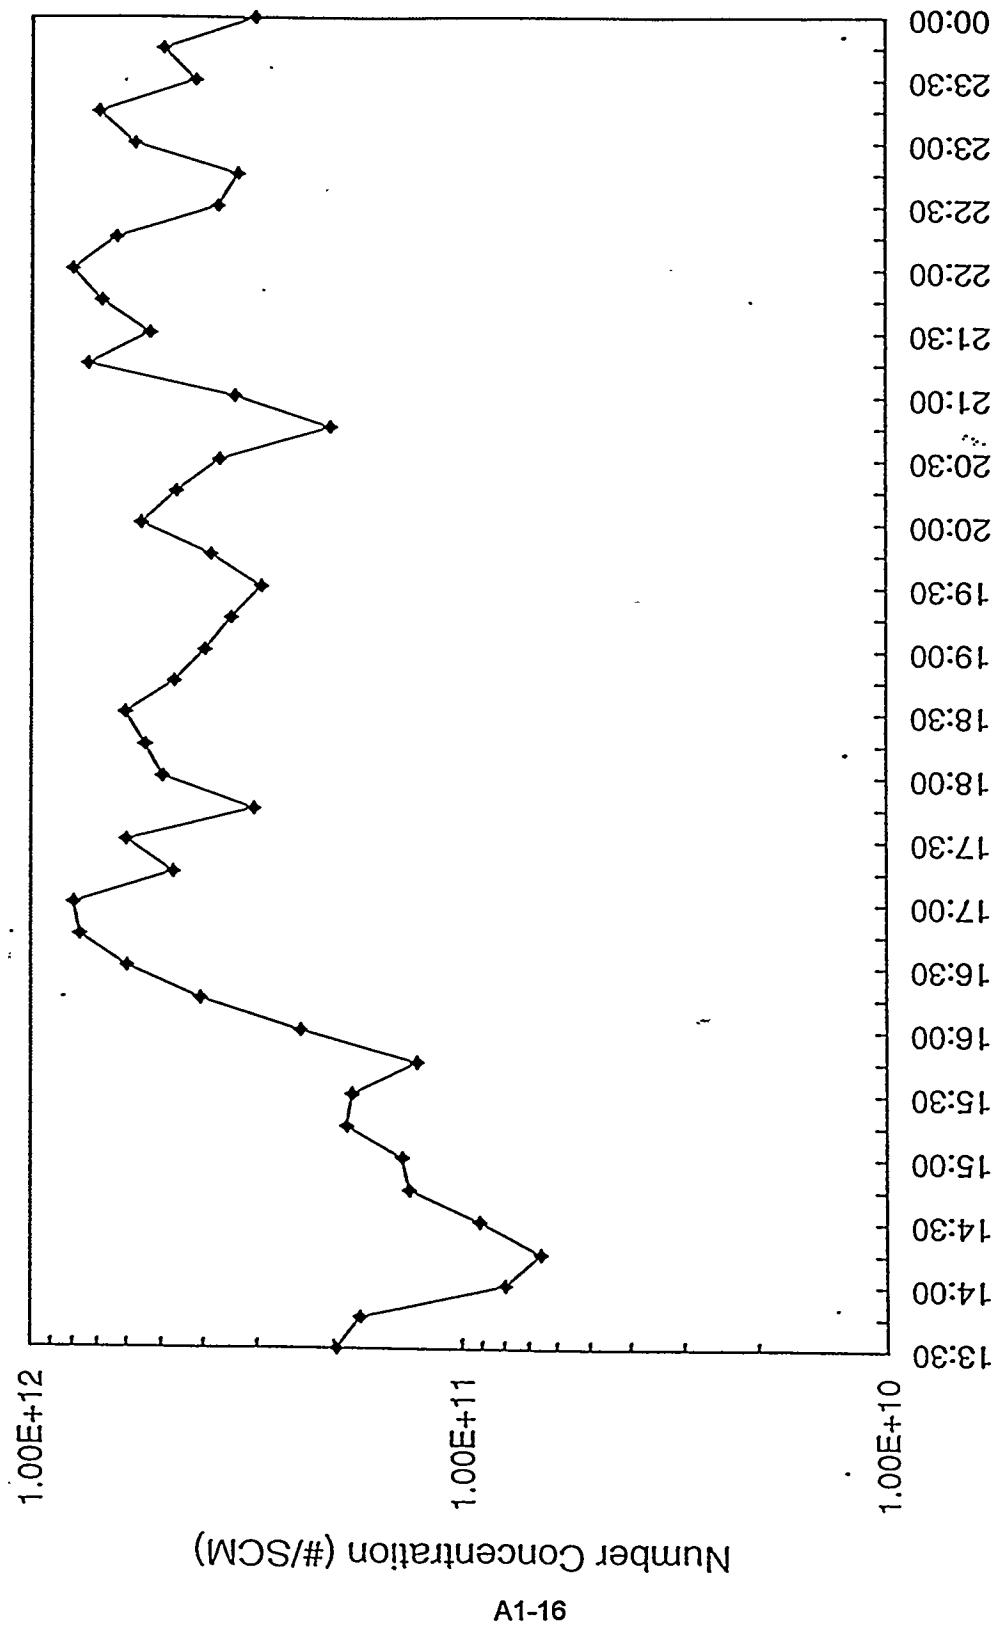


Figure 7b. Ensemble mean particle concentrations.

PMS at MGCR Run #8
7/21/94

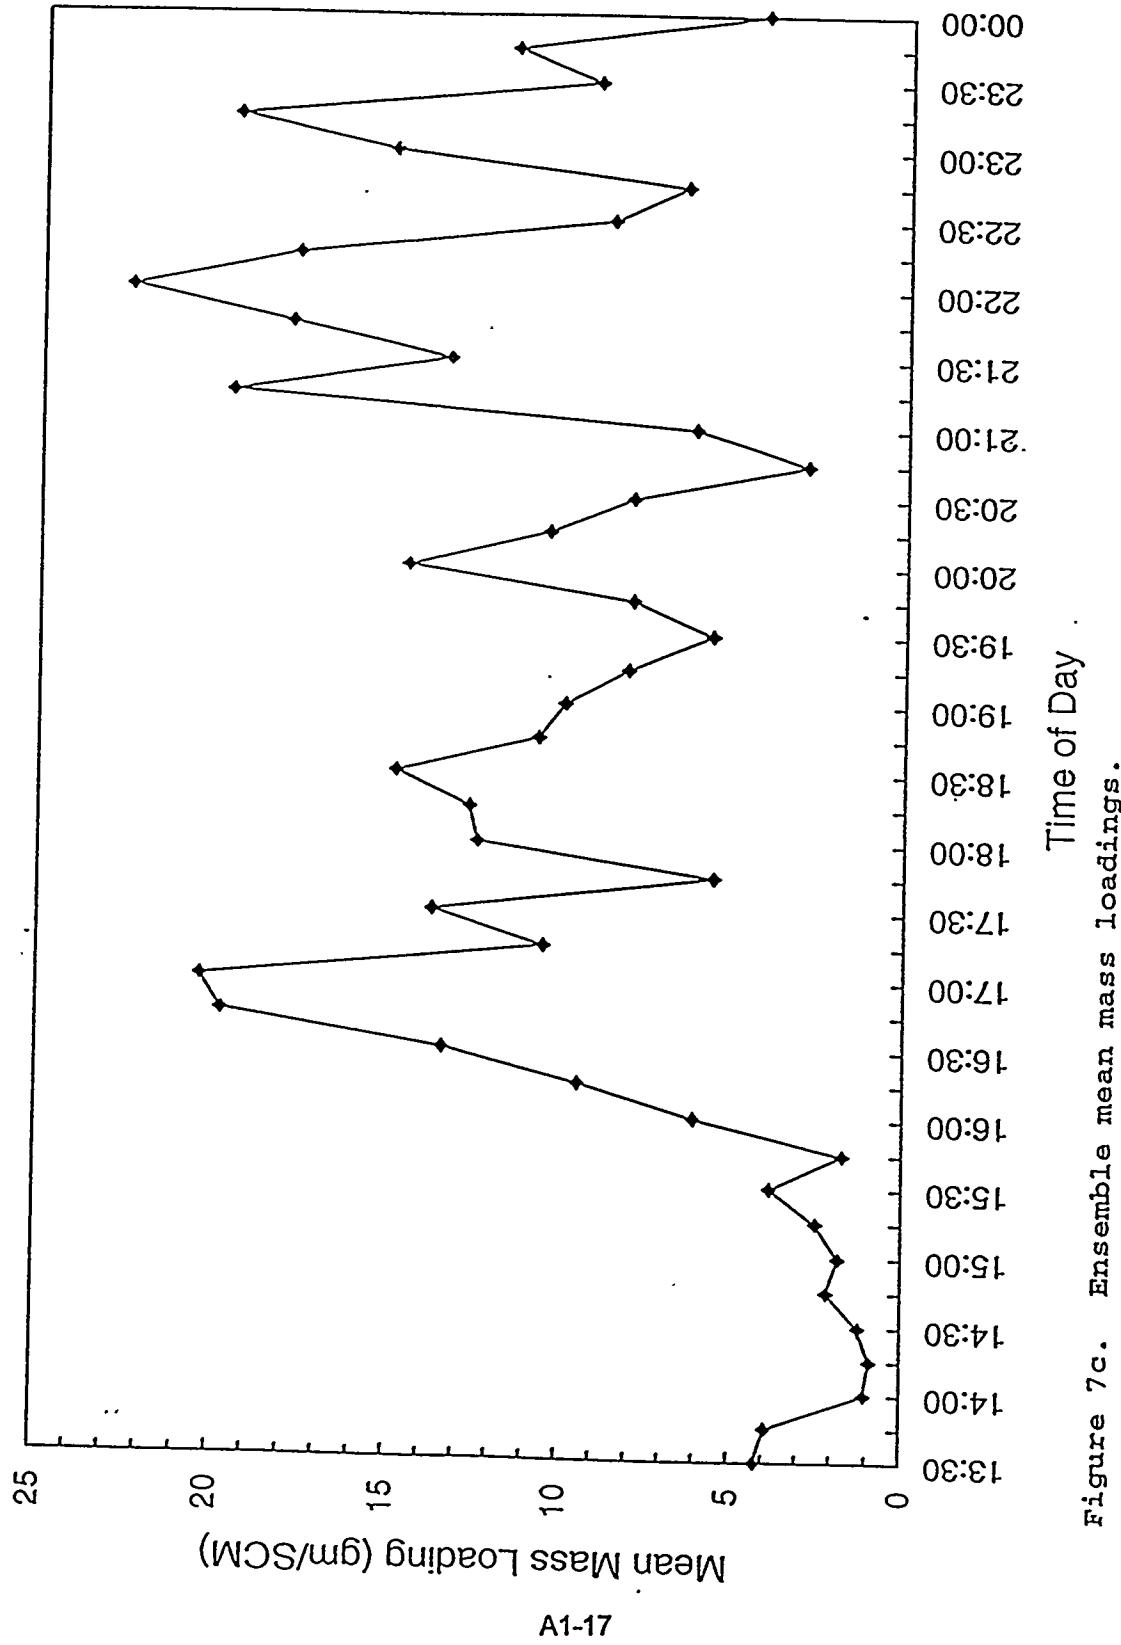


Figure 7c. Ensemble mean mass loadings.

PMS at MGCCR Run #8
7/22/94

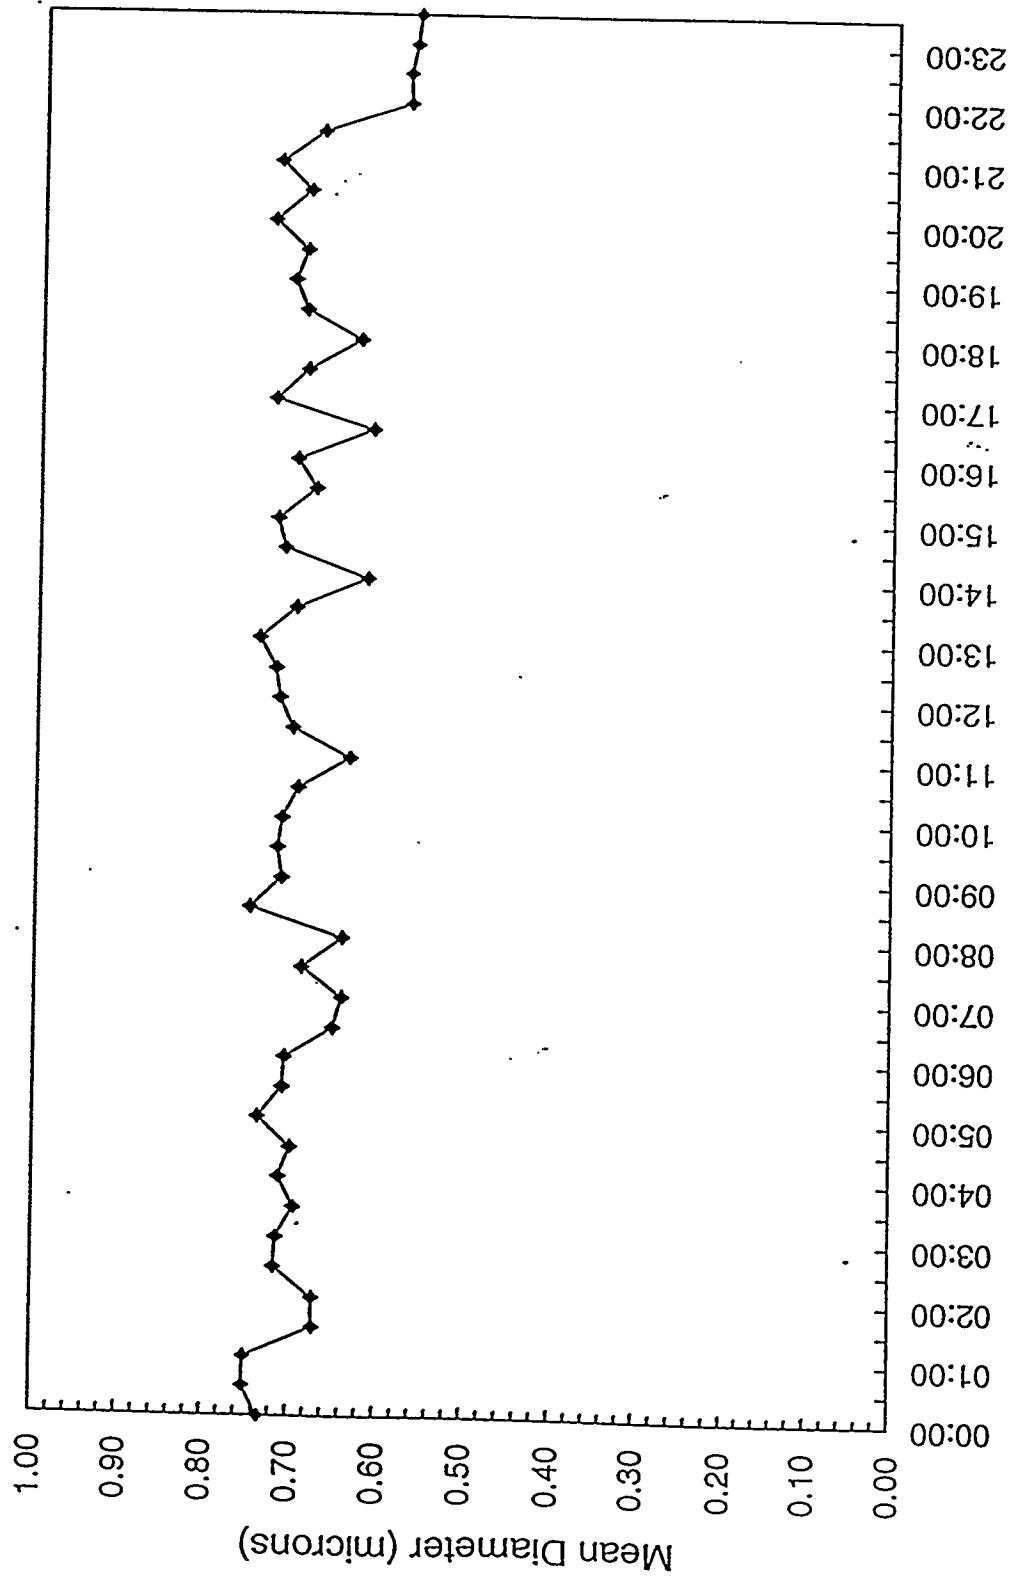


Figure 8a. Ensemble mean particle diameters.

PMS at MGCR Run #8
7/22/94

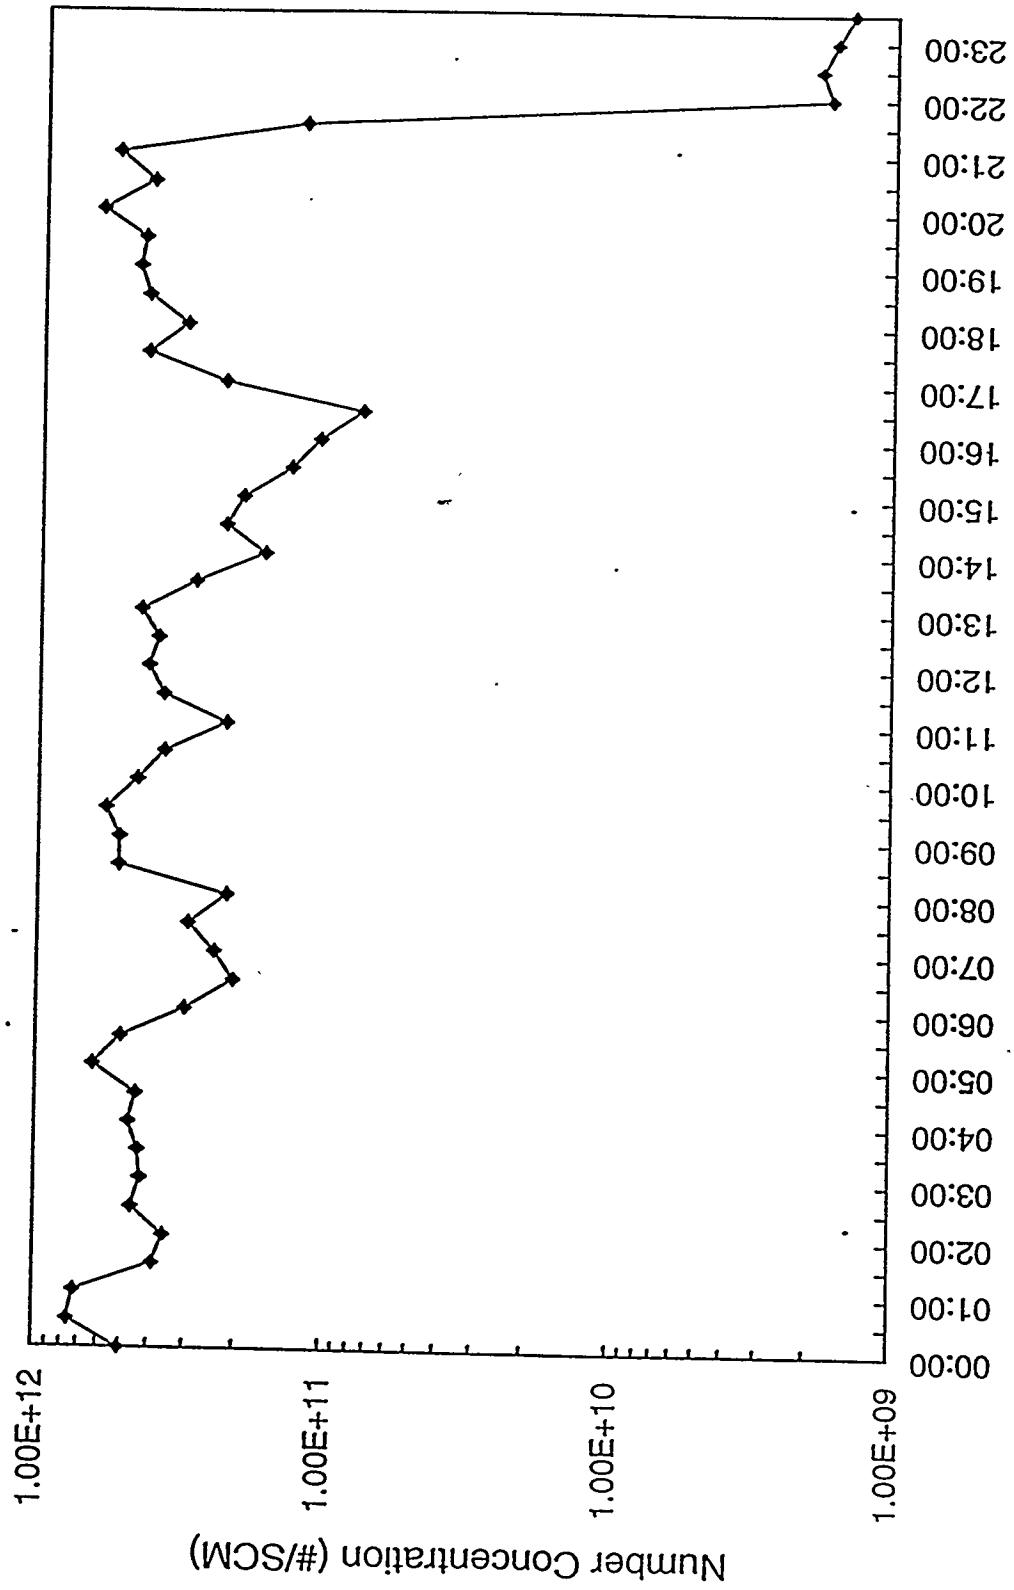


Figure 8b. Ensemble mean particle concentrations.

PMS at MGCR Run #8
7/22/94

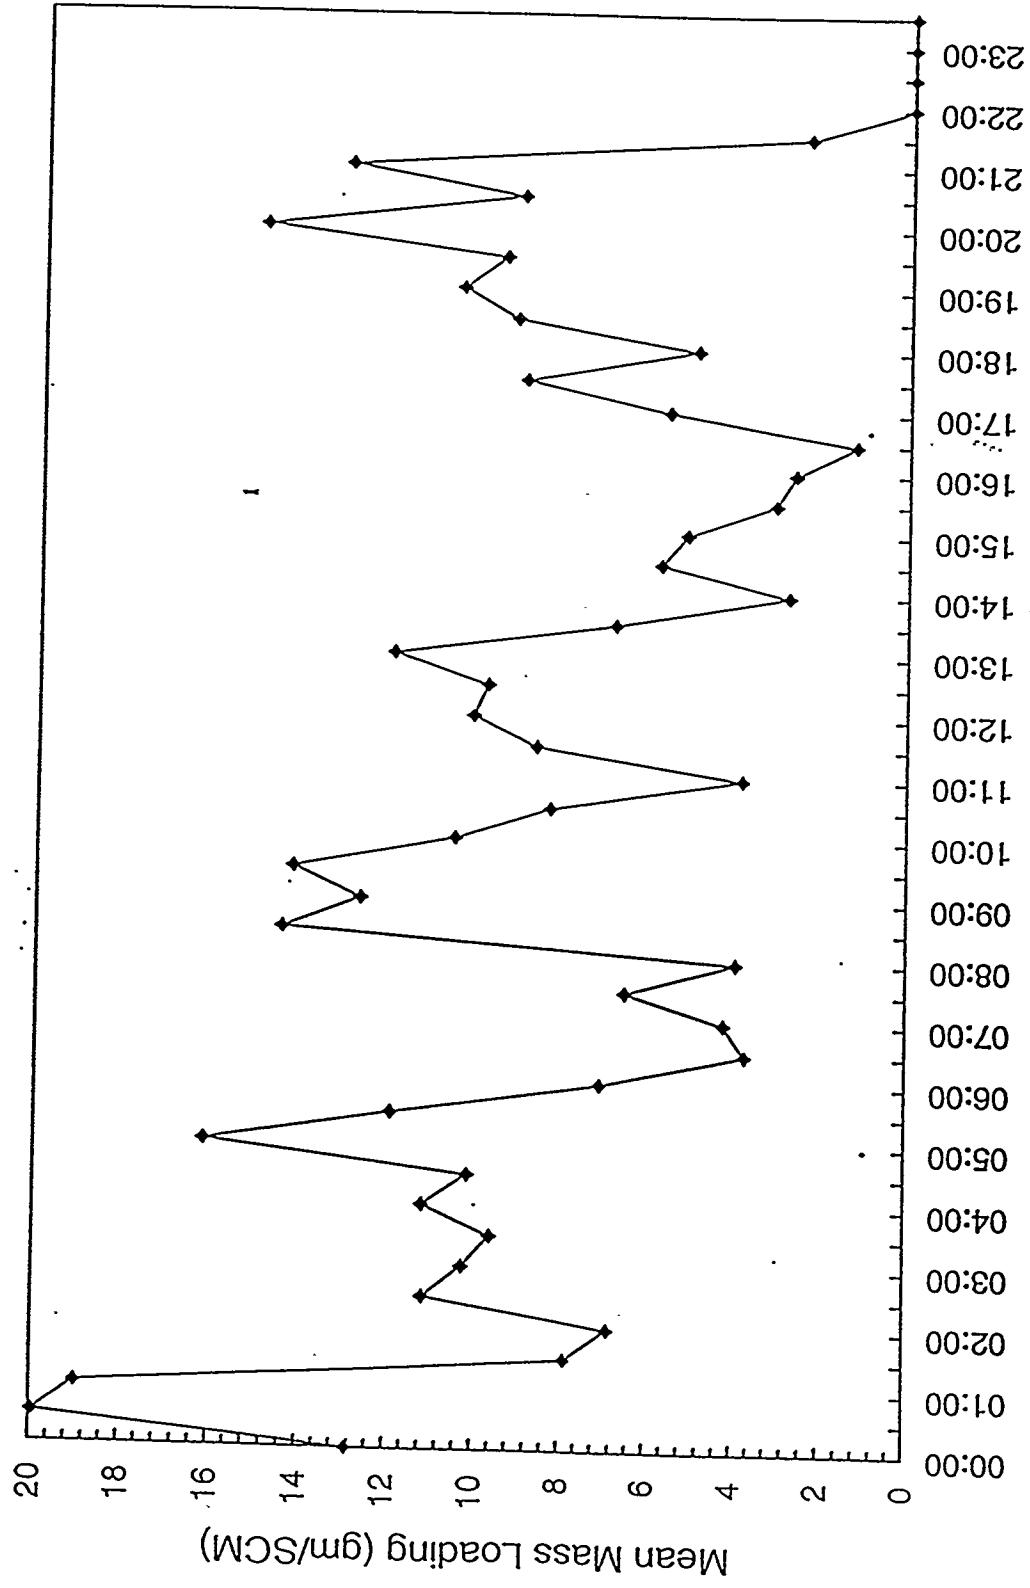


Figure 8c. Ensemble mean mass loadings.

Particle Size Distribution
MGCR Run #9 94/09/13 10:30:58

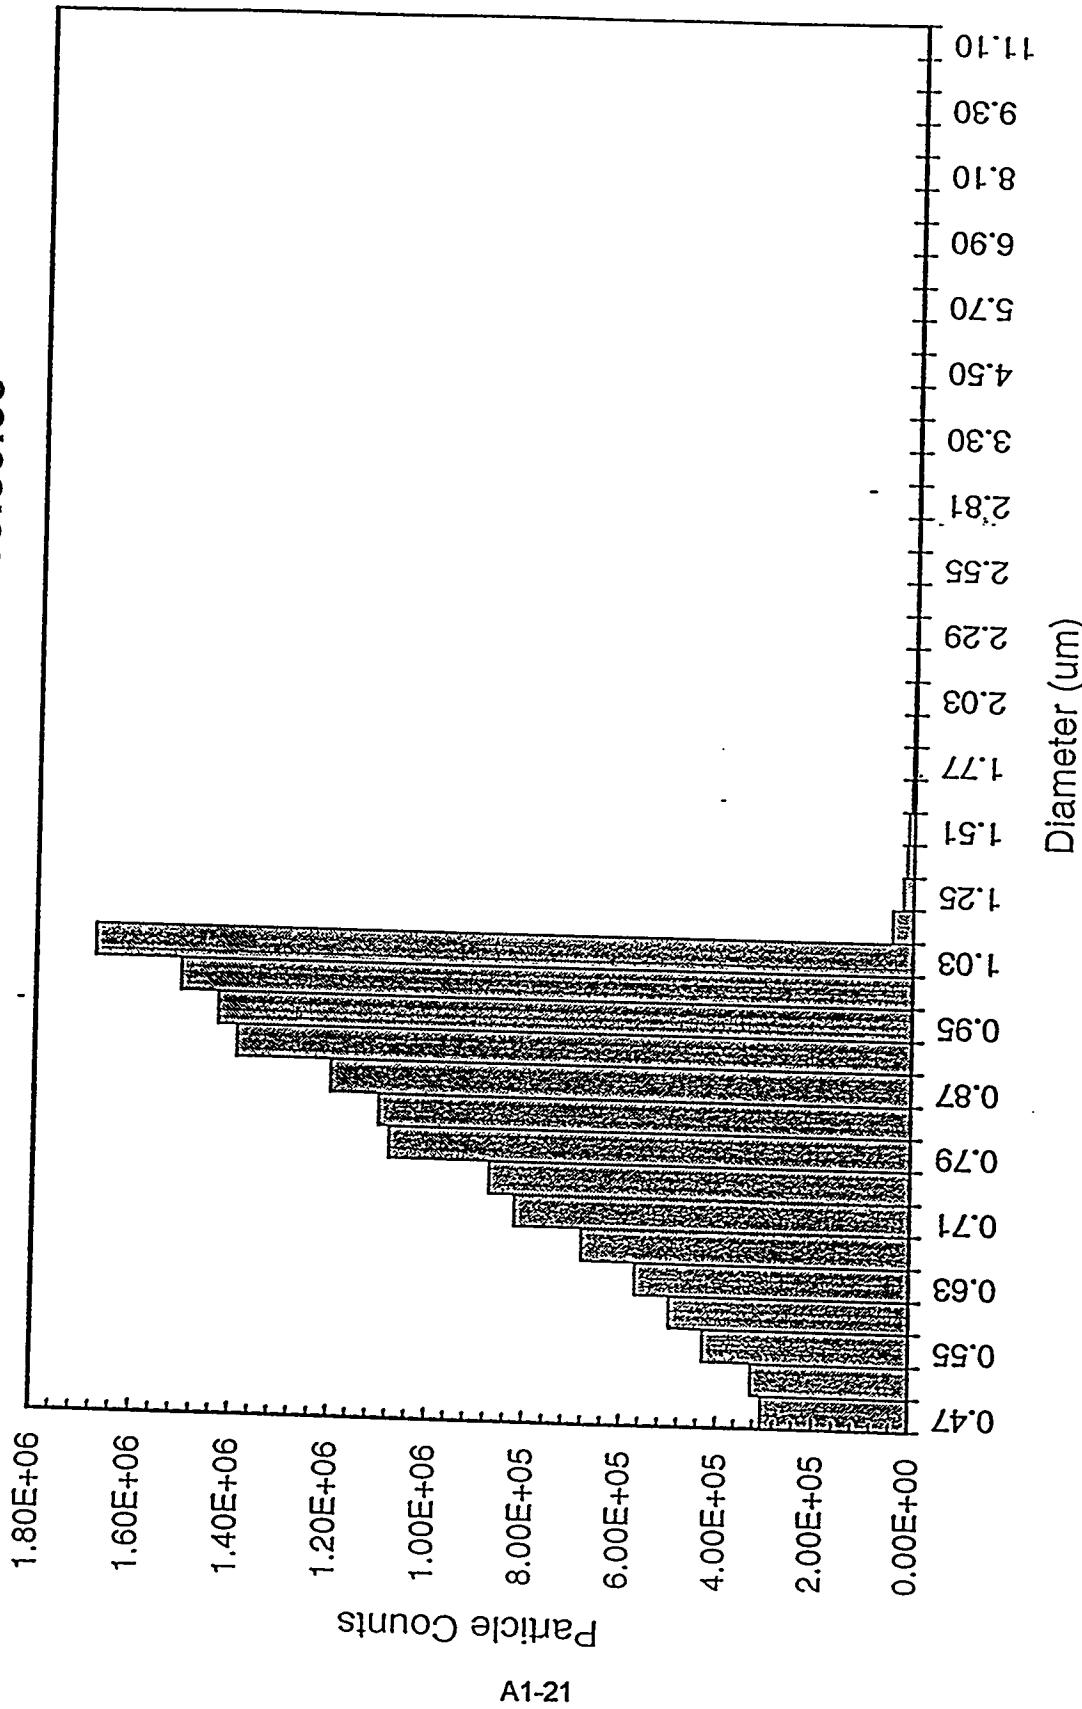


Figure 9a. Unprocessed particle size distribution from a single measurement.

Averaged Particle Size Distribution
MGCR Run #9 49/09/13 10:30


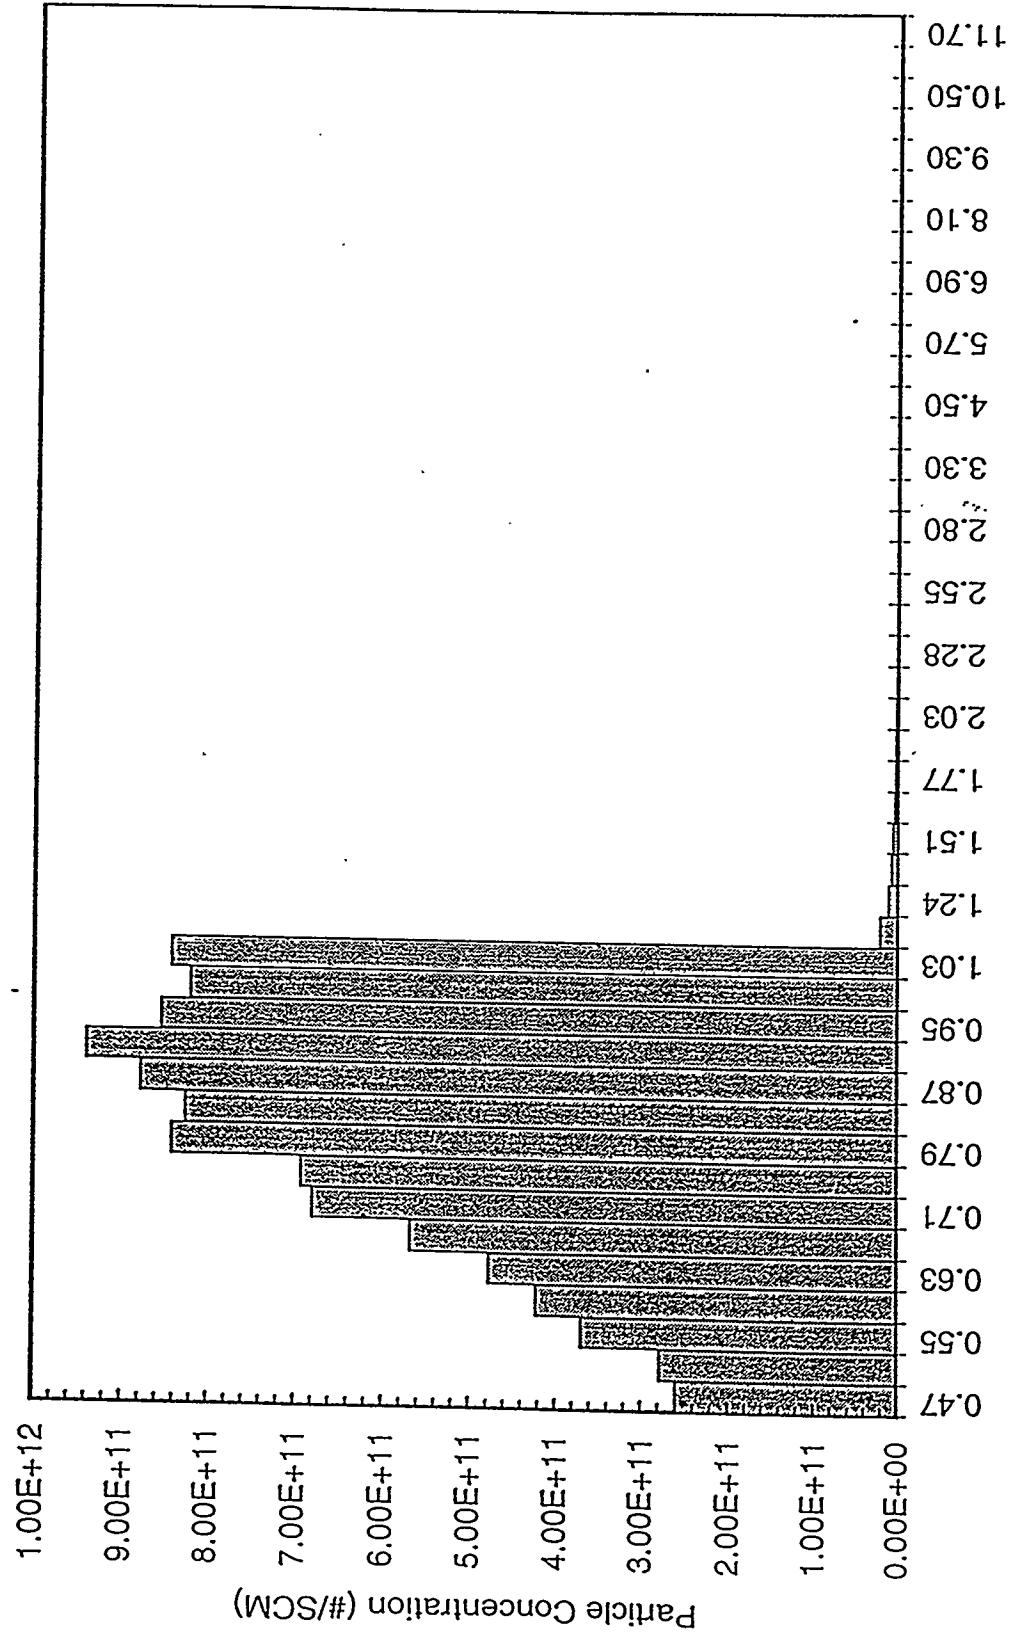


Figure 9b. A 15-minute averaged particle size distribution.

PMS at MGCR Run #9
9/13/94

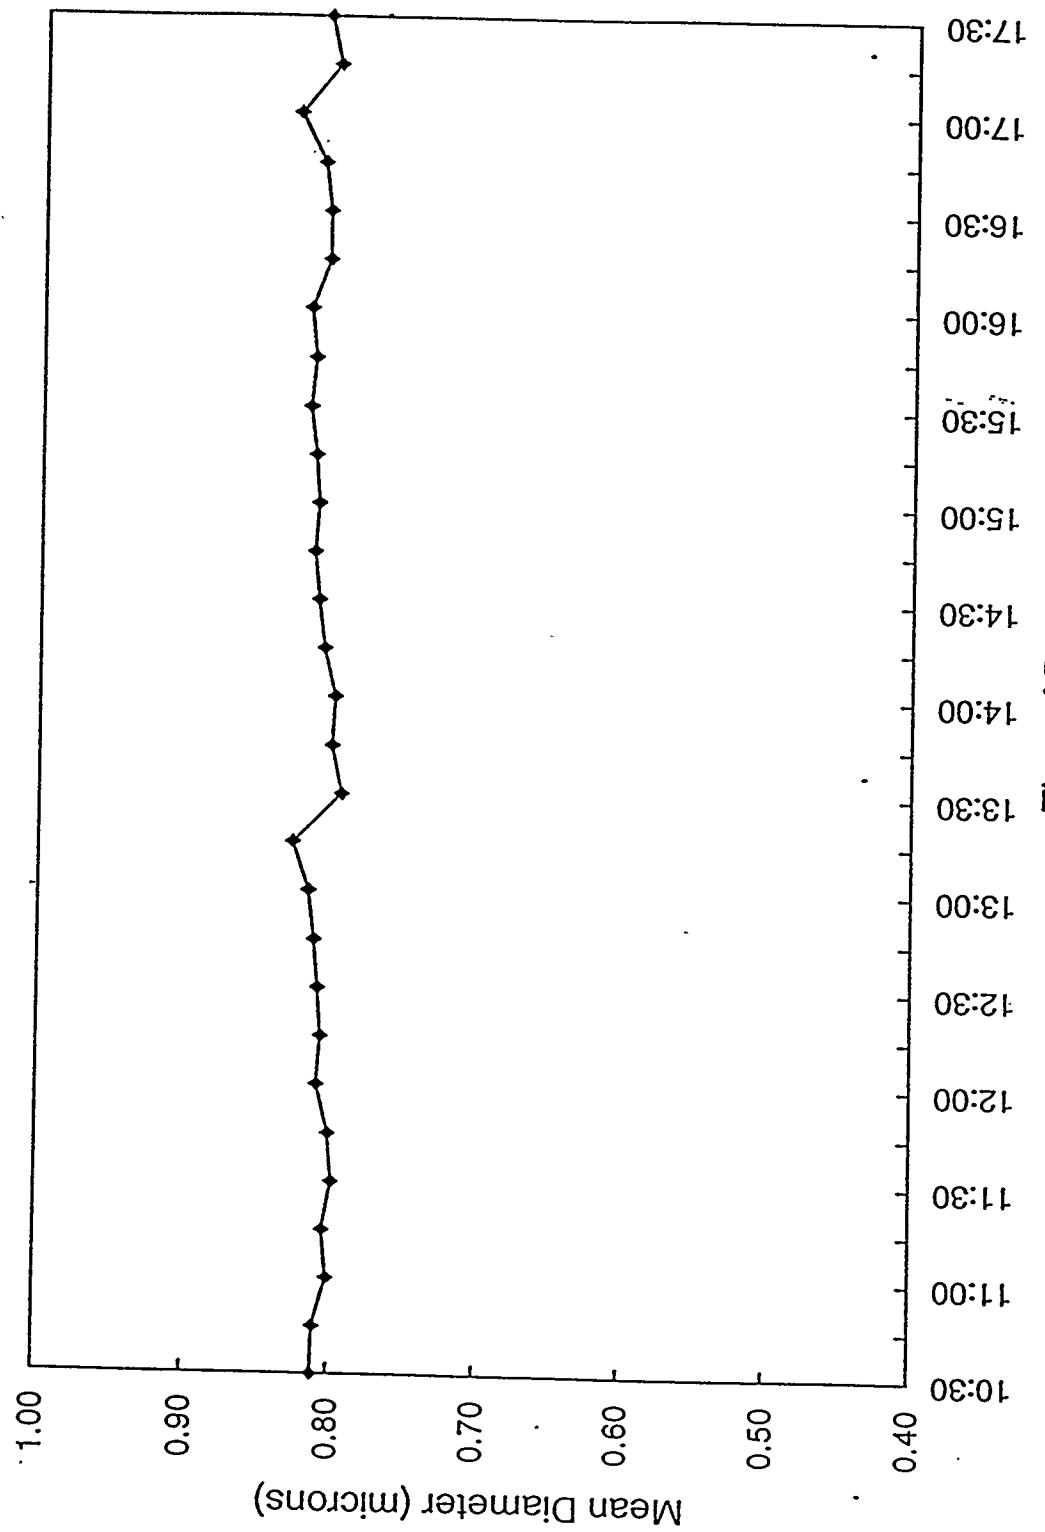

PMS at MGCR Run #9
9/13/94

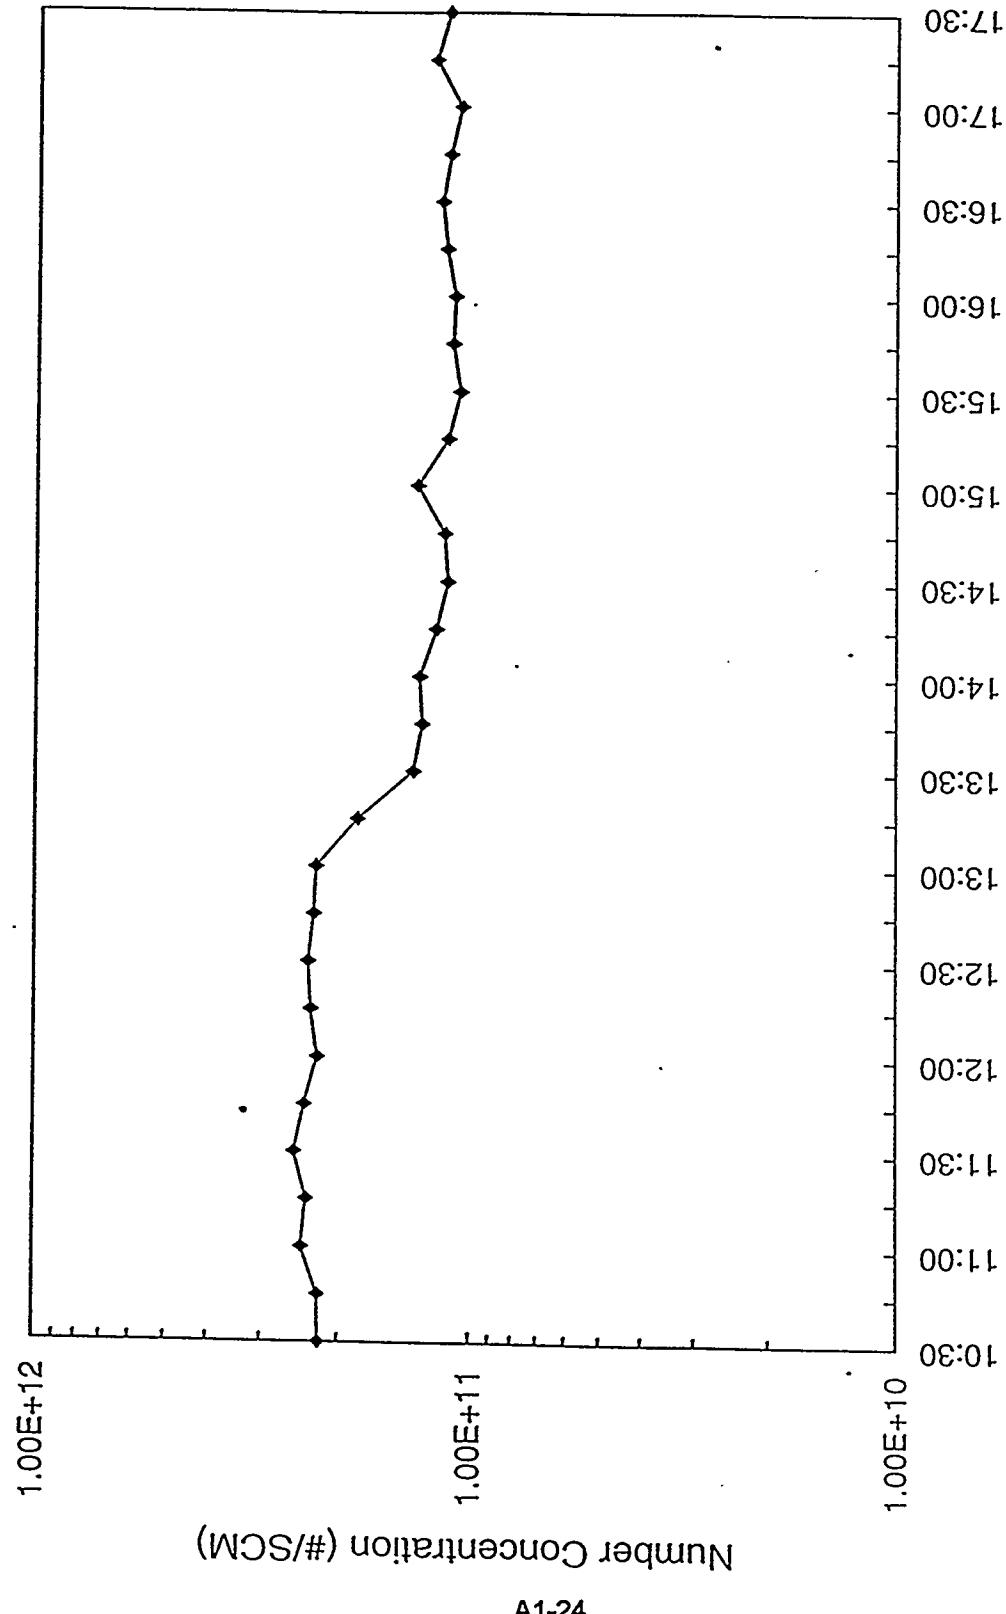


Figure 9d. Ensemble mean particle concentrations.

PMS at MGCCR Run #9
9/13/94

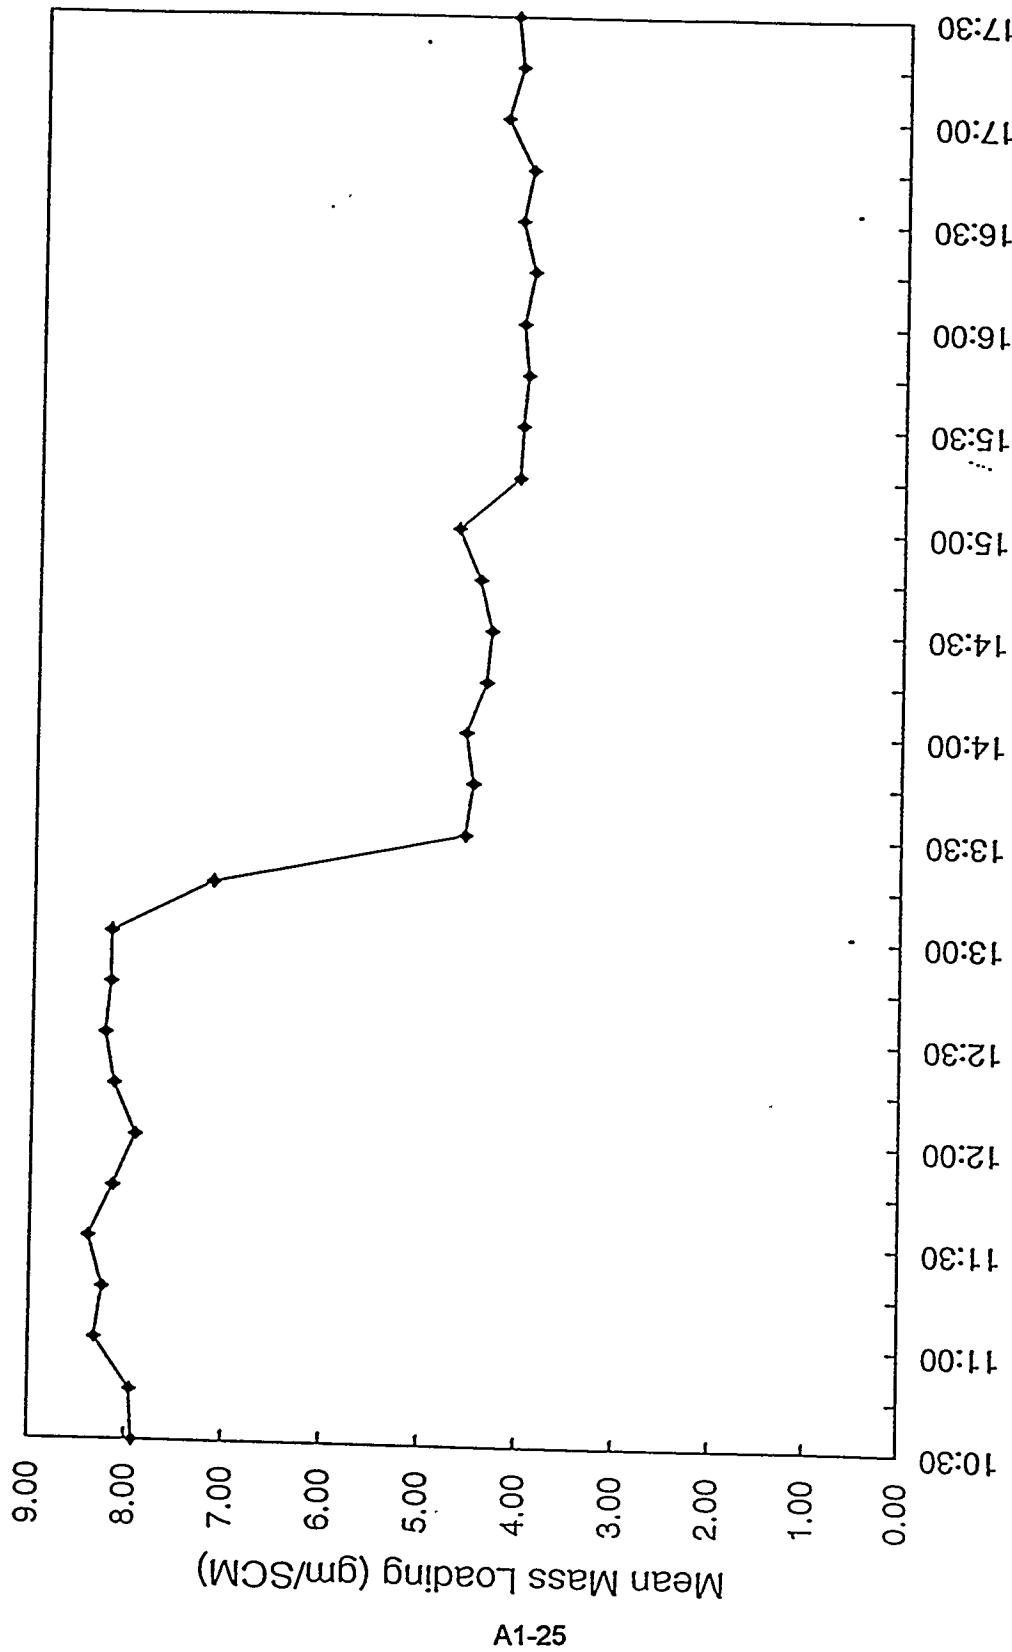


Figure 9e. Ensemble mean mass loadings.

PMs at MGCCR Run #9
9/15-16/94

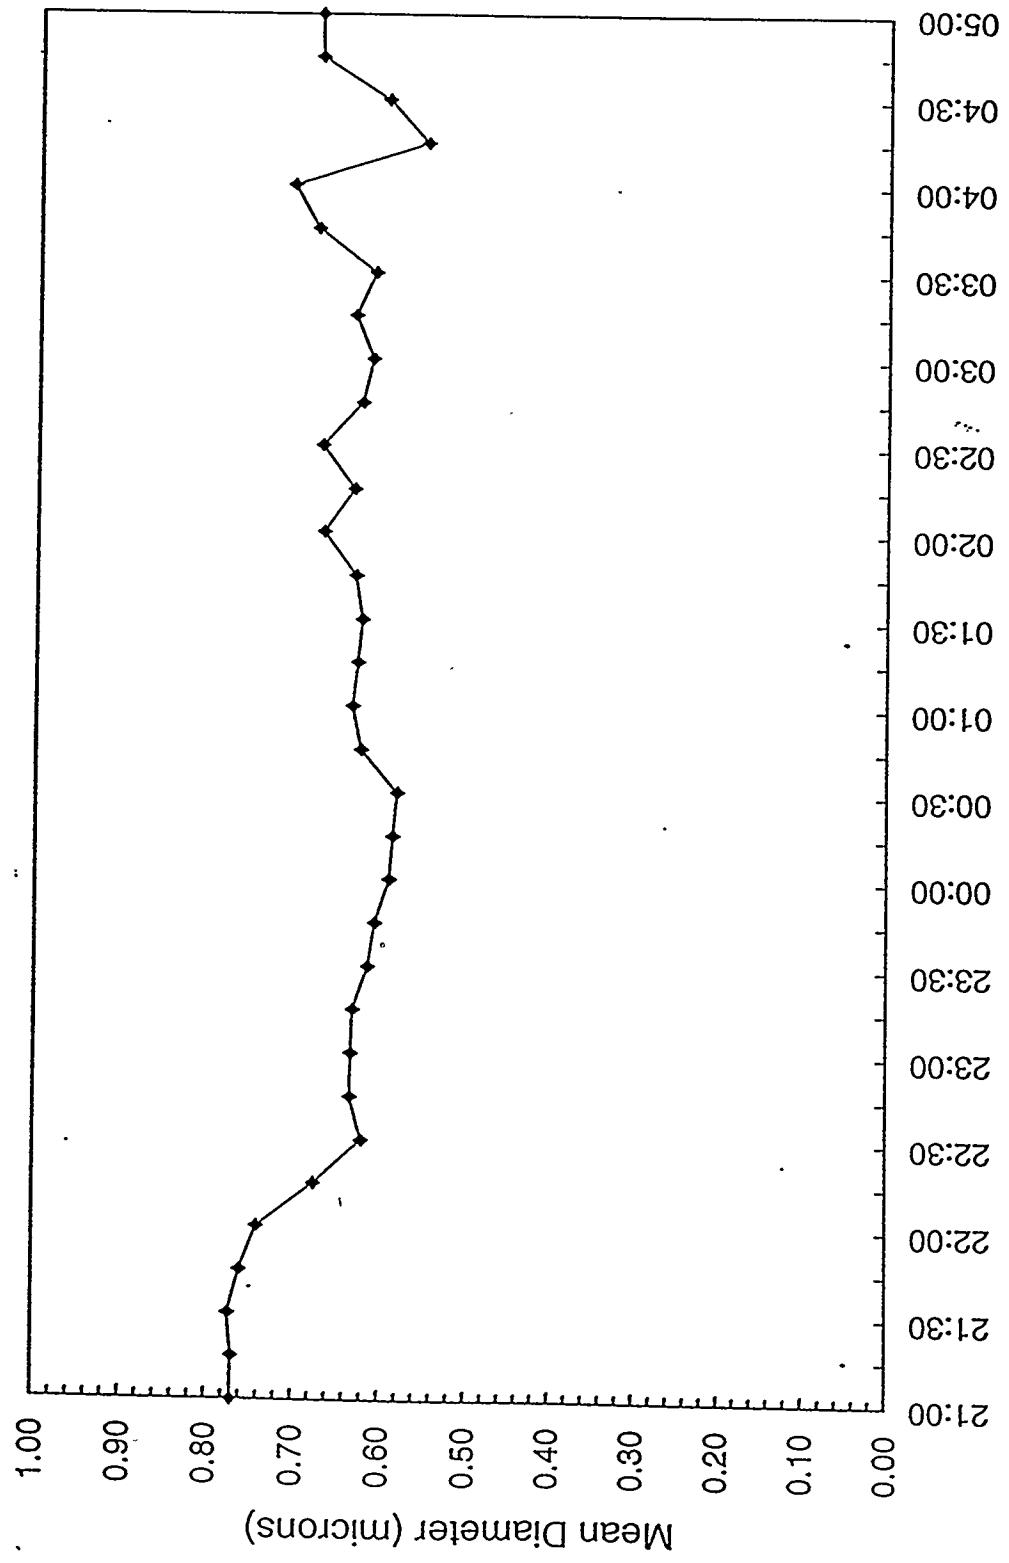


Figure 10a. Ensemble mean particle diameters.

PMS at MGCR Run #9
9/15-16/94

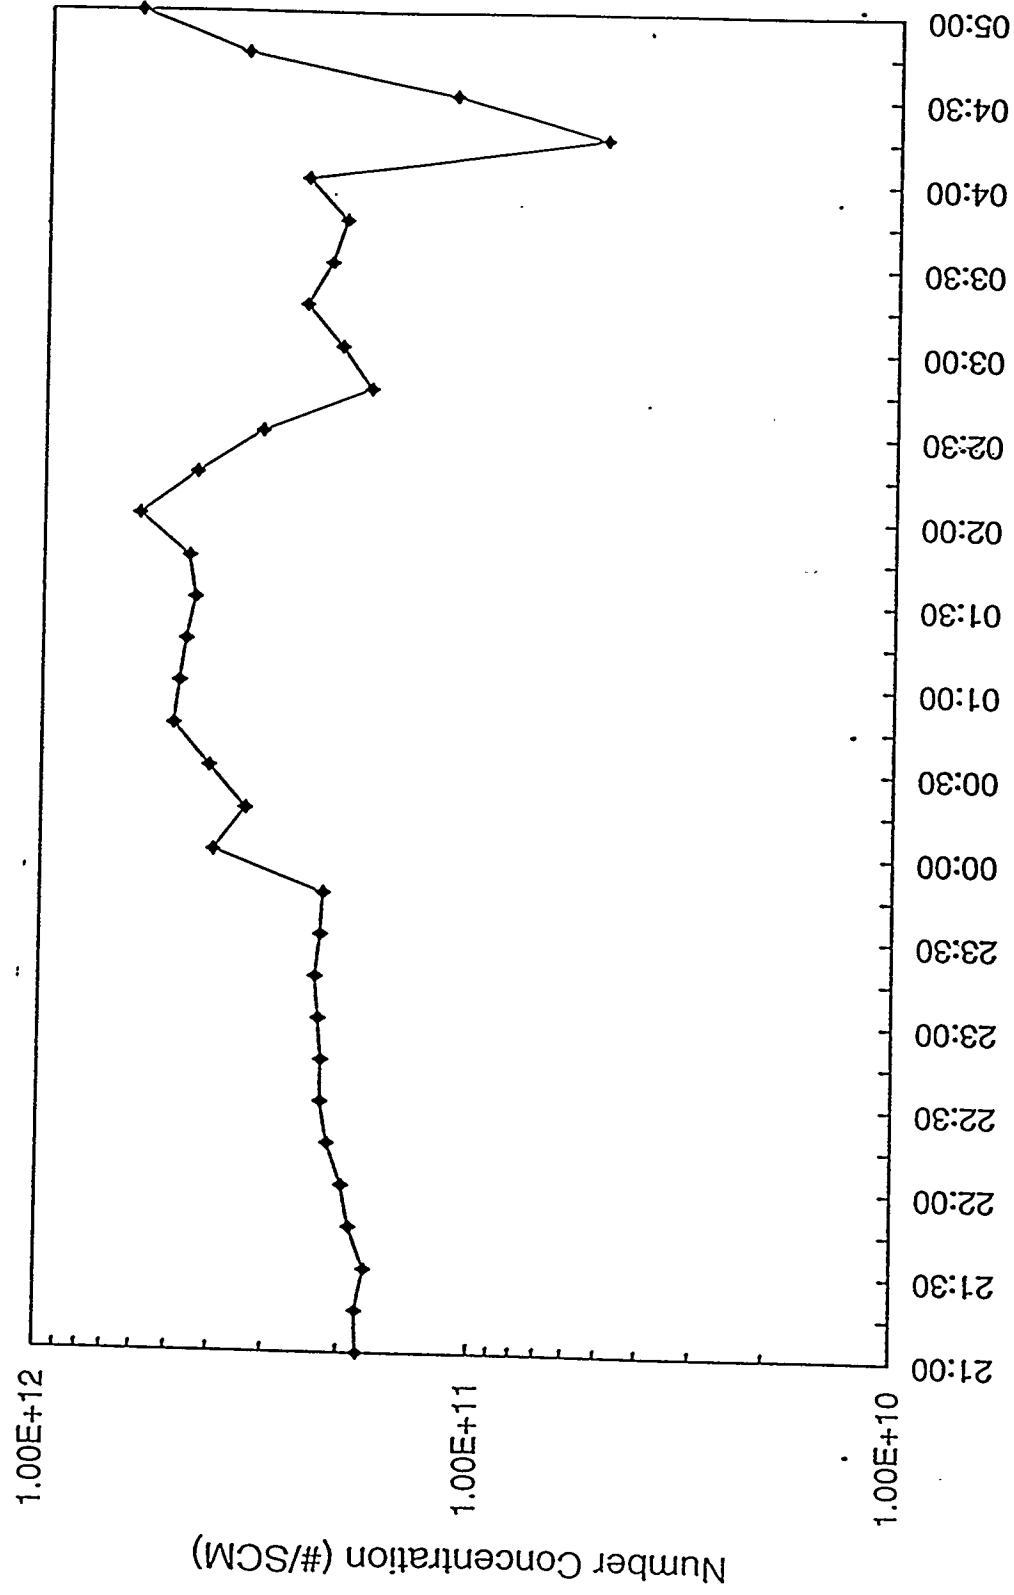


Figure 10b. Ensemble mean particle concentrations.

PMS at MGCR Run #9
9/15-16/94

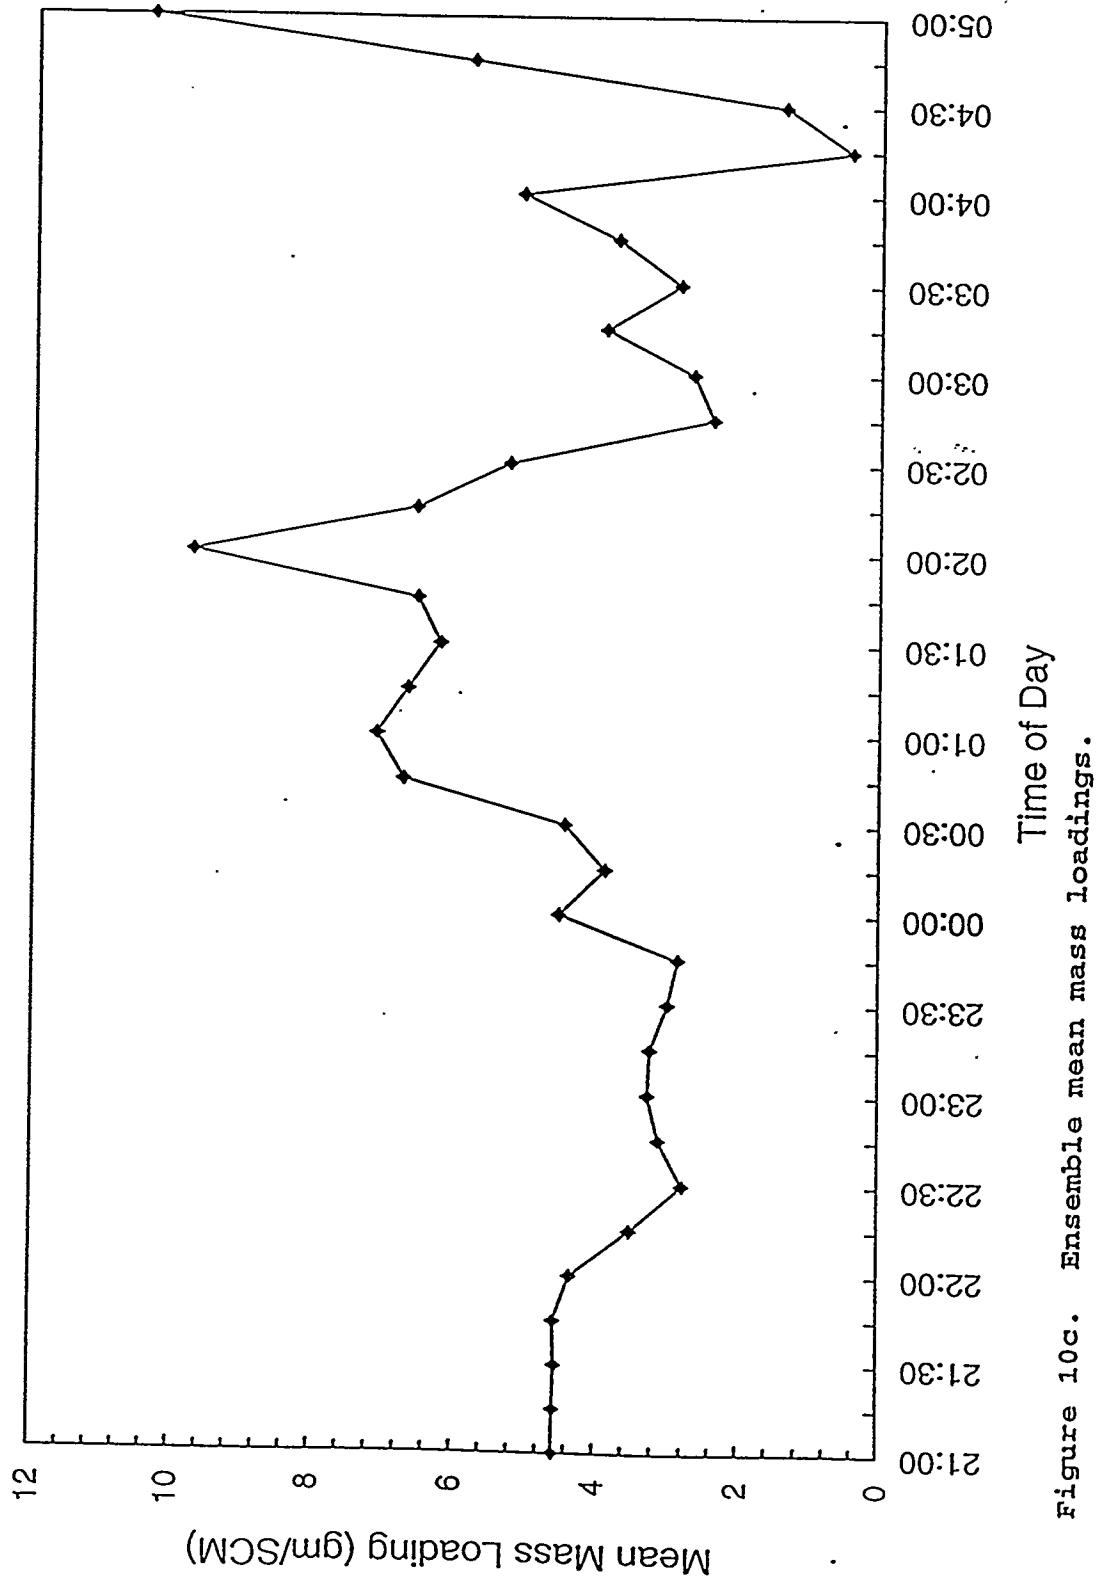


Figure 10c. Ensemble mean mass loadings.

Particle Size Distribution
MGCR Run #10 94/10/26 10:01:10

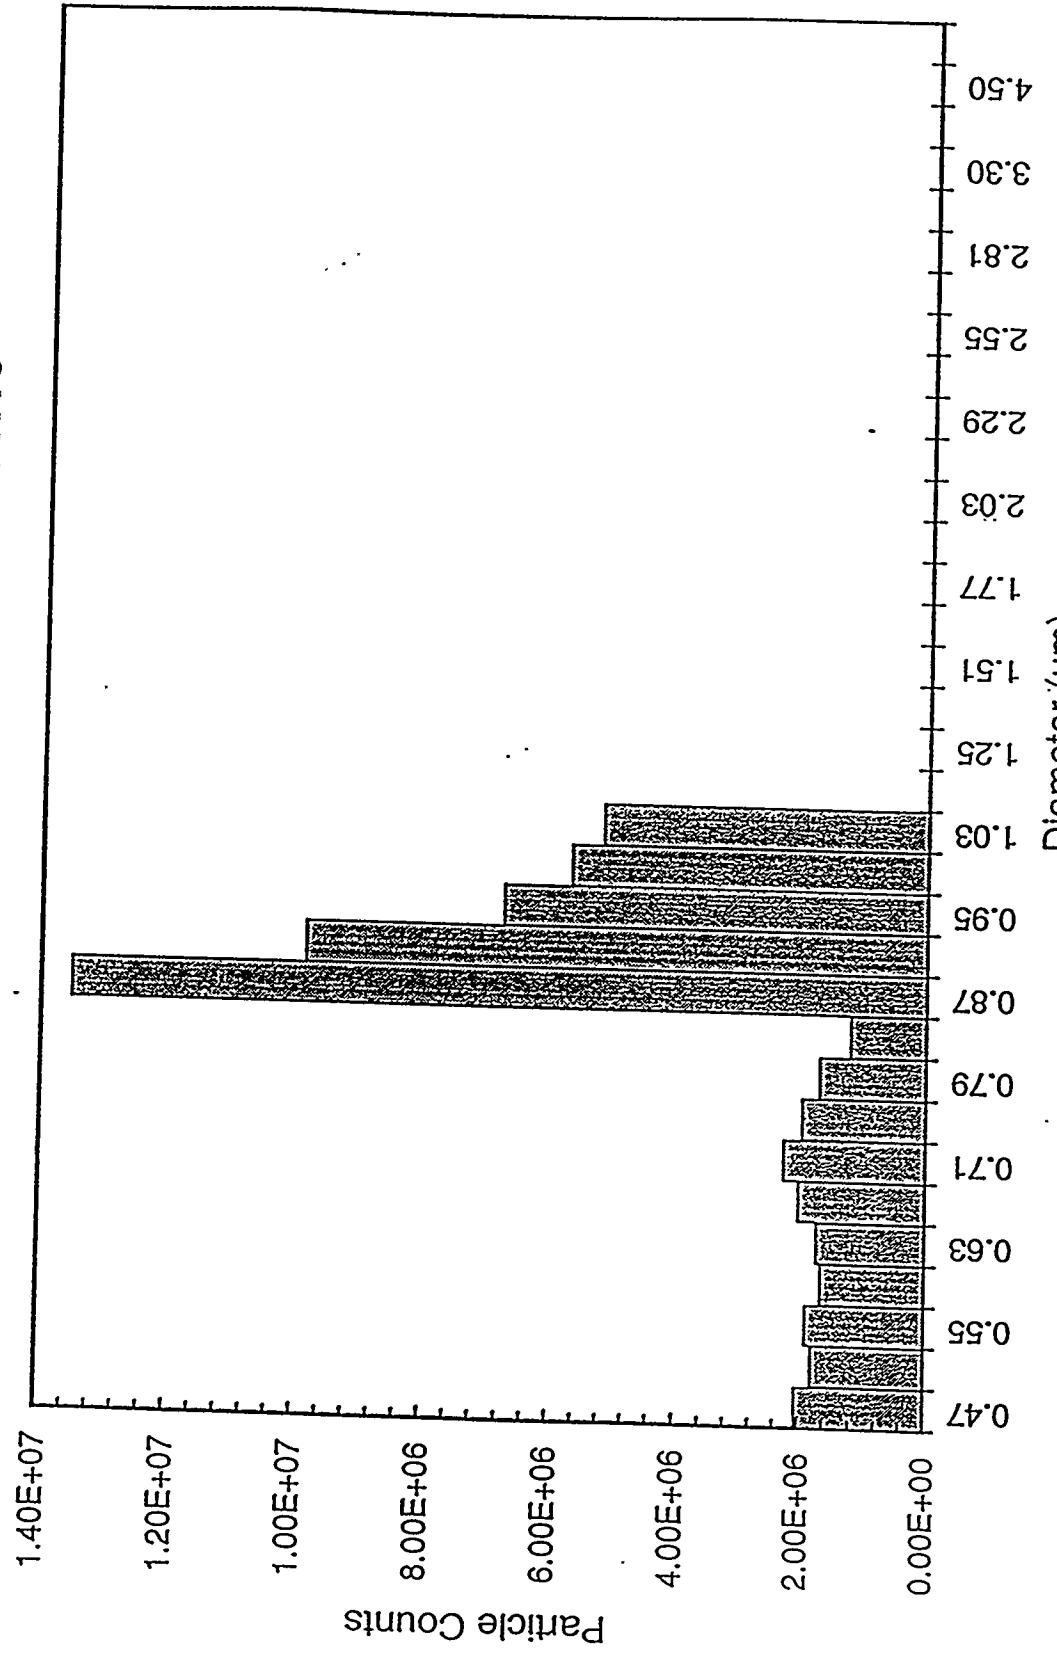


Figure 11a. Unprocessed particle size distribution from a single measurement.

Averaged Particle Size Distribution
MGCR Run #10 94/10/26 10:00

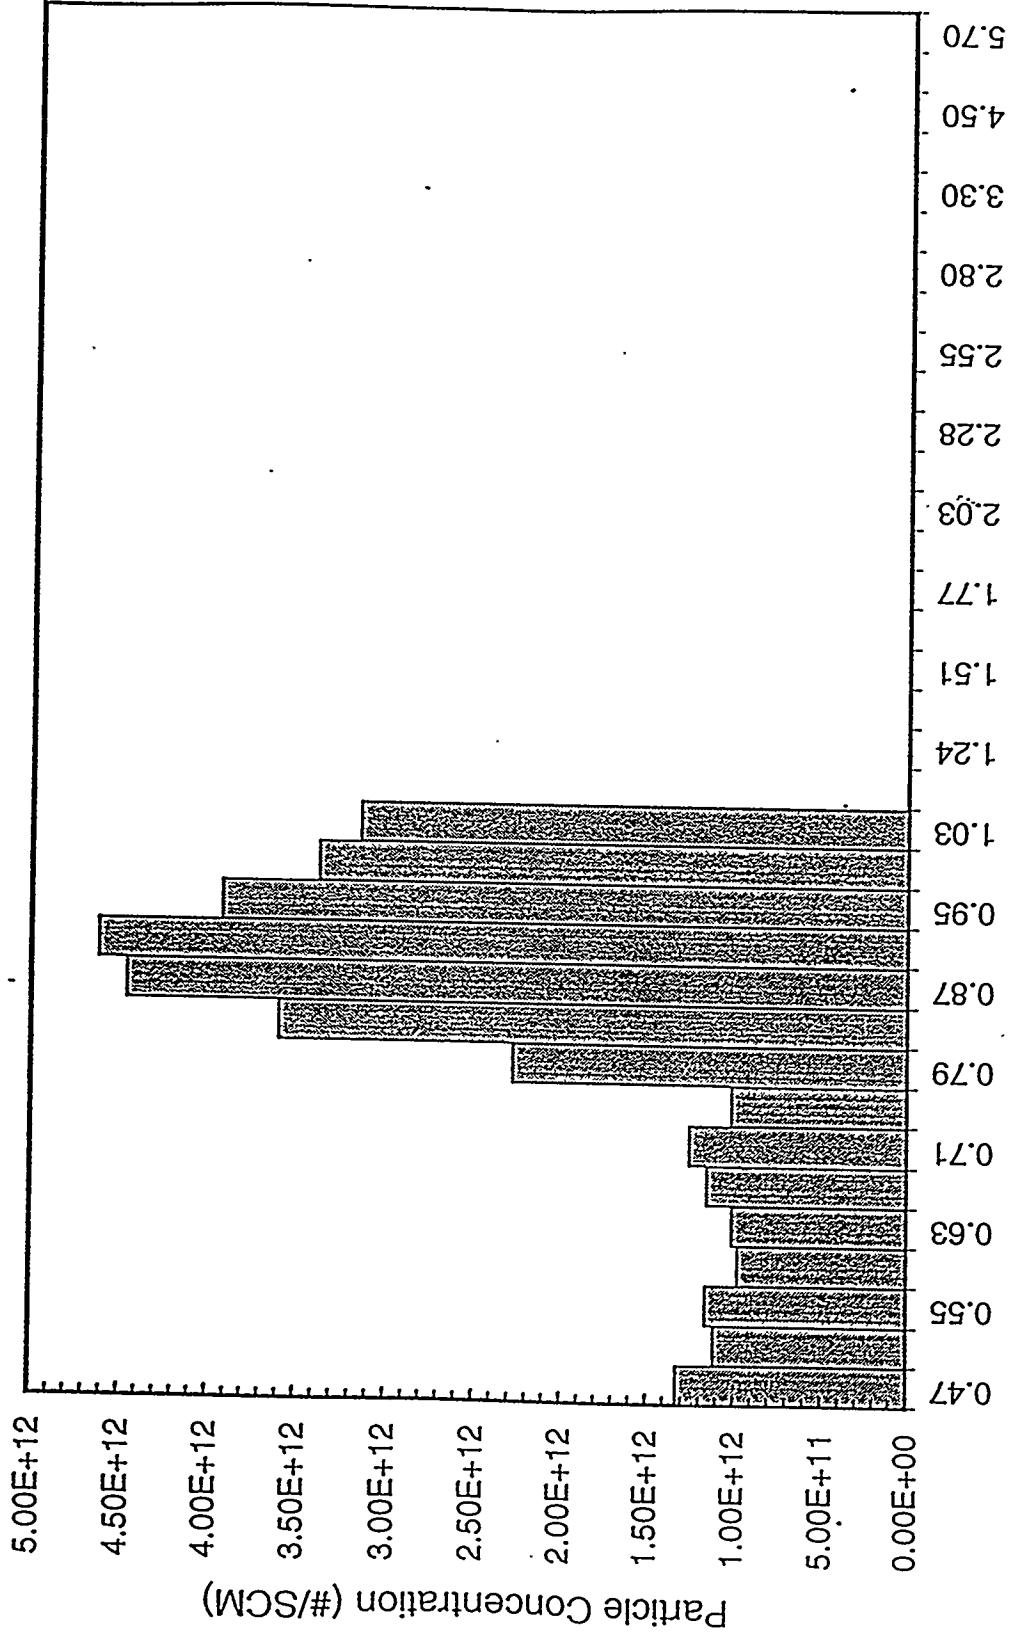


Figure 11b. A 15-minute averaged particle size distribution.

PMs at MGCR Run #10
10/26/94

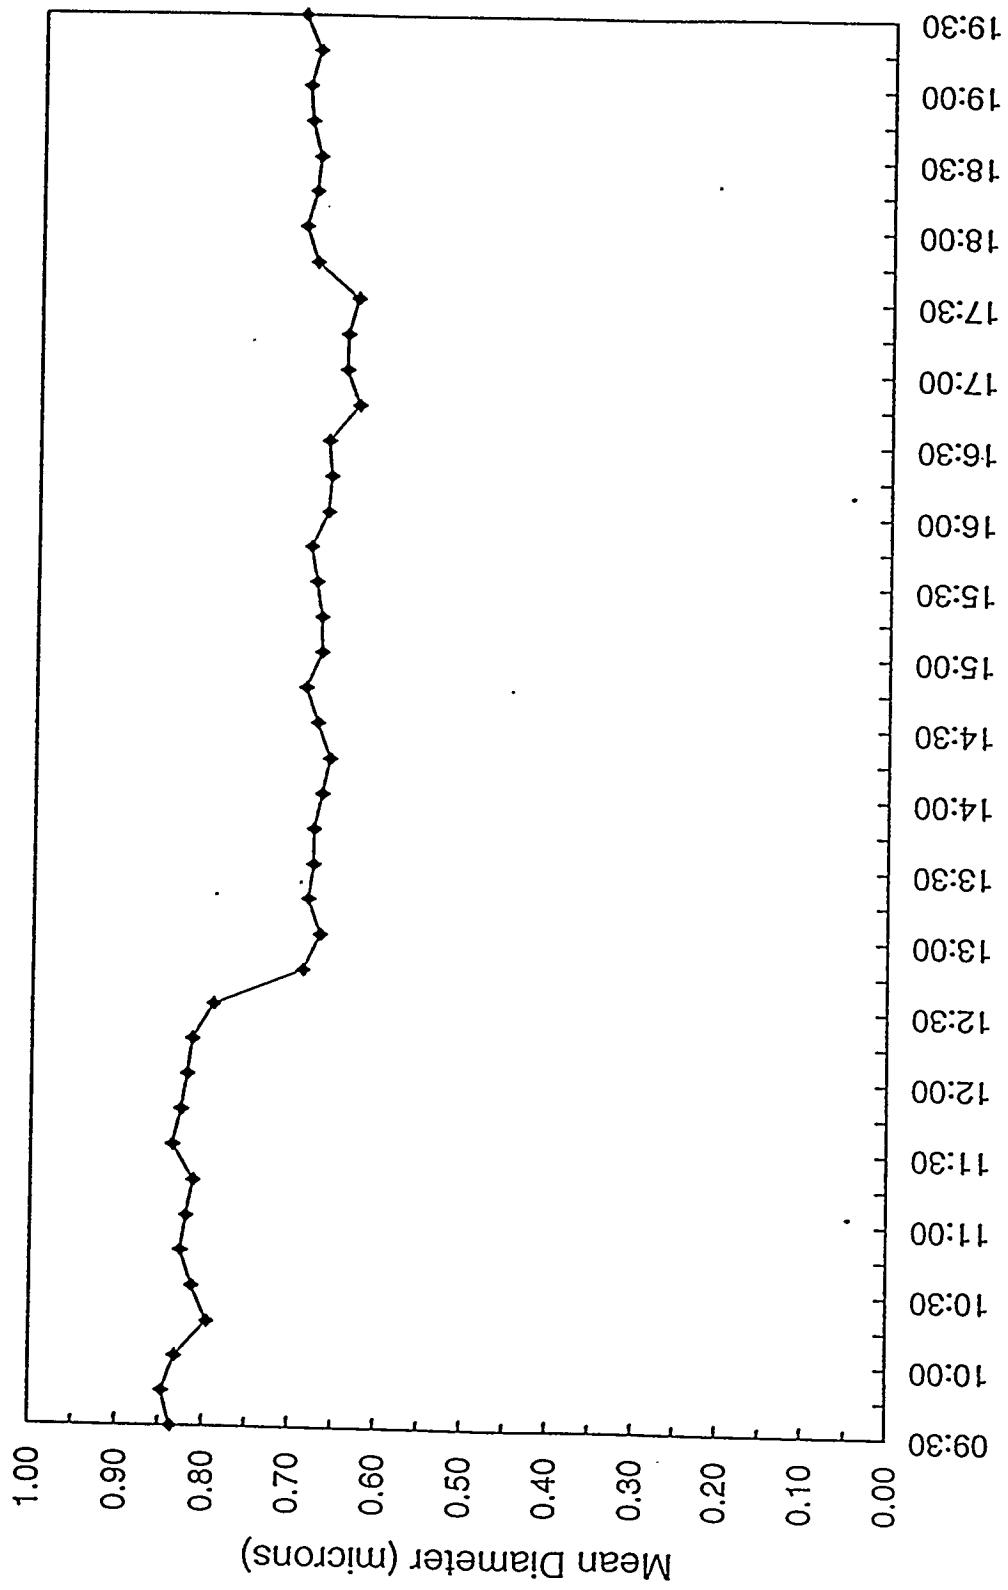


Figure 11c. Ensemble mean particle diameters.

PM's at MGCCR Run #10
10/26/94

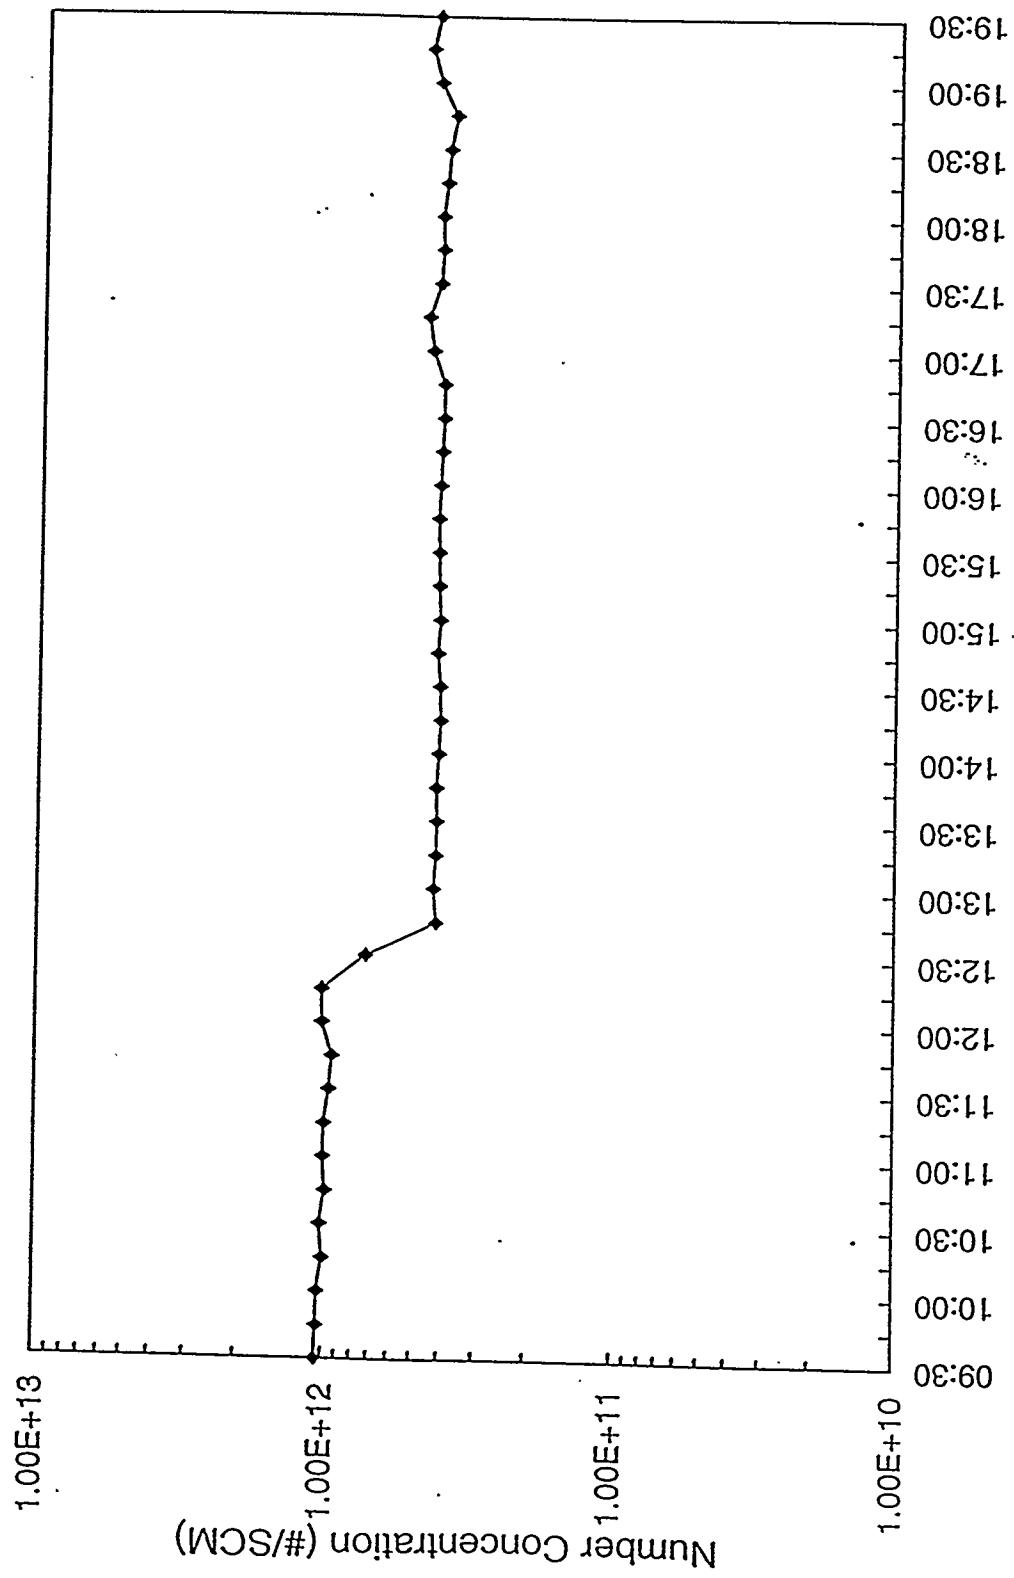


Figure 11d. Ensemble mean particle concentrations.

PMS at MGCR Run #10
10/26/94


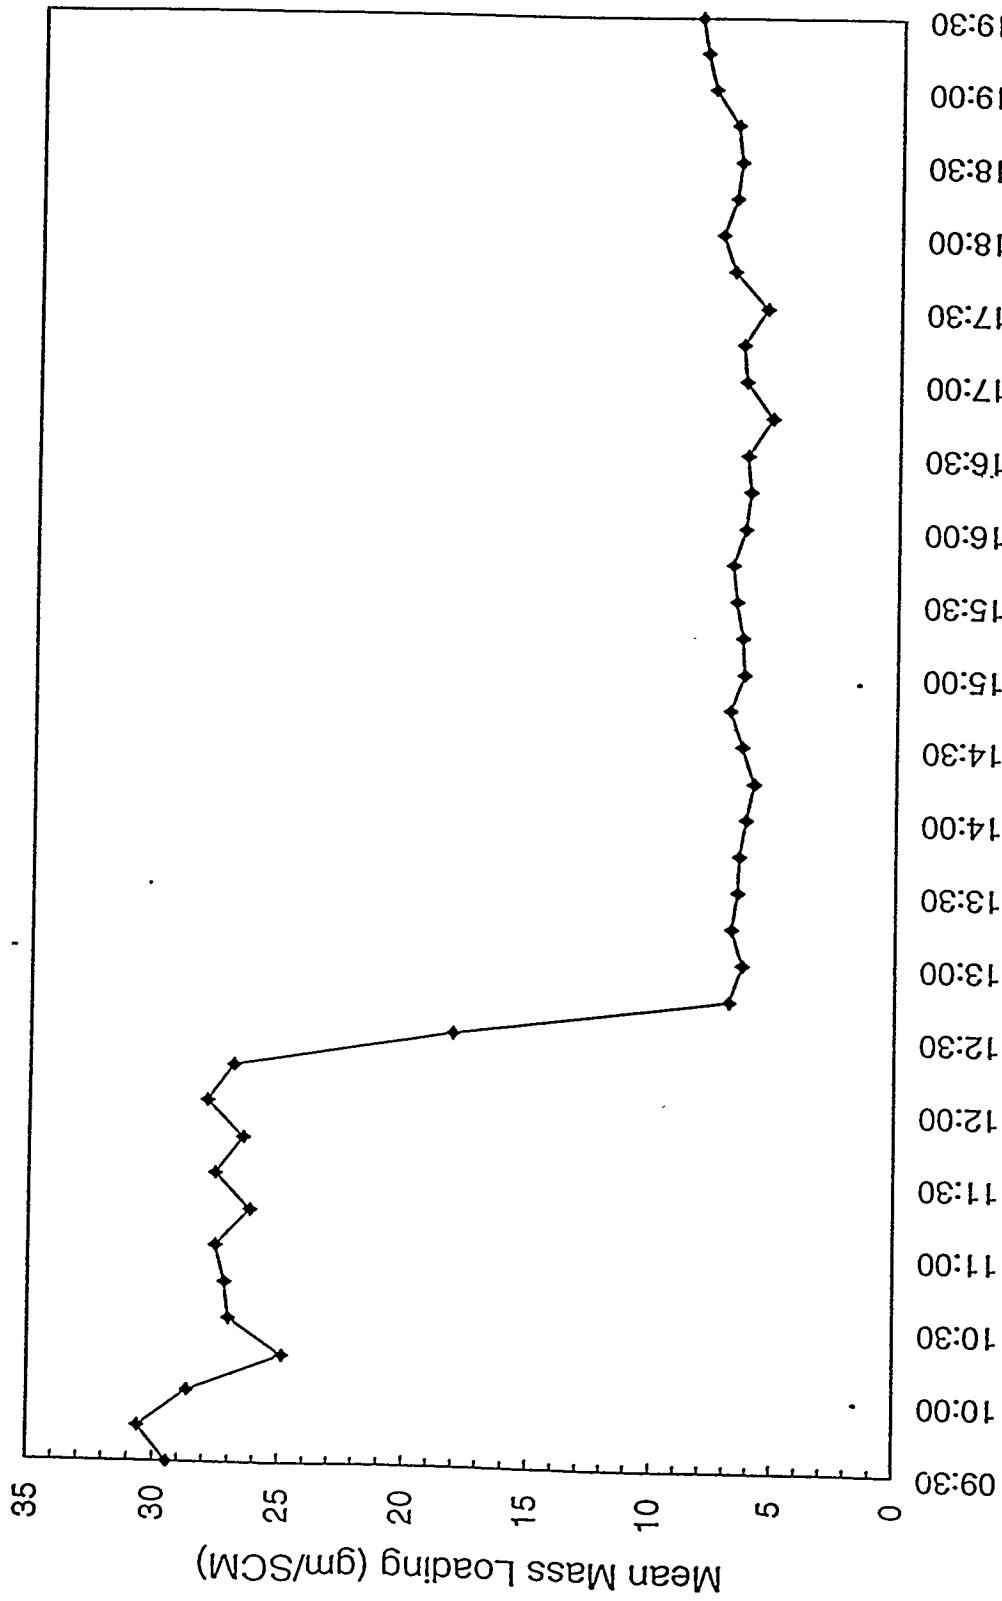


Figure 11e. Ensemble mean mass loadings.

 

APPENDIX 2

DETAILED CHRONOLOGY OF SIGNIFICANT RUN EVENTS



Table 1 . SUMMARY OF MAJOR EVENTS DURING TEST RUN
 (Test No.: 94FBG07)

Test No.: 94FBG07 June 6-15, 1994

(Test No.: 94FBG07)

June 6-15, 1994

<u>Date</u> (<u>Time</u>)	<u>Duration</u>	<u>Description of Events</u>
6/6 (00:00)		
6/6 (02:57) - (14:01)	11 hr 4 min.	<ul style="list-style-type: none"> • Started <u>System Start-up</u> procedure. • Reactor insert with steam side-jets was • Air Preheater ignited. Heated up reactor (TIR-700, -701, -707 & -733, whichever FCV-113& 115 could not provide 7000 scfh obtain the required air flow. • Repaired leaks around FV-221. • DDAS on-line, changed logging rate from crashed 4-5 times.
6/6 (14:01) - (16:10)	2 hr 9 min.	<ul style="list-style-type: none"> • Started <u>Combustion mode</u>.
6/6 (16:10) - (16:46)	36 min.	<ul style="list-style-type: none"> • Purged reactor to reduce O₂ conc. to < air with N₂.
6/6 (16:46) - (18:30)	1 hr 44 min.	<ul style="list-style-type: none"> • Started <u>Gasification mode</u>. a. Convey air at 850 scfh, Reactor air steam at 33 lb/h out of total 55 lb/h, reduced from 400 to 350 scfh, and coal transfer from silo to batch hopper. b. Performed routine coal transfer from silo to batch hopper. c. Performed routine dumping of solids every hour; and purging all vent valves every 4 hours.
6/6 (18:30) - 6/7 (05:38)	11 hr 8 min.	<ul style="list-style-type: none"> • <u>Steady-State #1</u> (with Montana #6). a. Change conditions many times to reduce dump: Increased convey air to 1,080 1,500 scfh; reduced underflow N₂ to points in air preheater and superheat b. TIR-701 reached 1,770°F at 01:40 on

<u>Date</u> <u>(Time)</u>	<u>Duration</u>	<u>Description of Events</u>
		c. Reset the conditions to : Convey Air = 900 scfh, Reactor air = 1,300 scfh; underflow N ₂ = 320 scfh; side steam of 33 lb/h with 50 lb/h total; and coal feed = 70 lbm/h. d. DDAS crashed 2 times.
		e. High temperature excursion to 1,900°F on TIR-701. f. Loss of coal feed at 05:32.
6/7 (05:38) - (15:45)	10 hr 7 min.	• <u>Controlled Shutdown</u> due to loss of coal feed. Cooled reactor from 1,500 to 800°F. • DDAS off-line at 10:25.
6/7 (15:45) - (00:30)	8 hr 45 min.	• Used air chisel to remove clinker from the wall that held the reactor insert in place. The reactor insert dropped out of the reactor at 23:50. • Removed TE-707 and plugged the hole of the housing.
6/8 (00:30) - (05:02)	4 hr 32 min.	• Started <u>System Start-up</u> procedure. • Installed reactor insert with <u>no side-jets</u> .
6/8 (05:02) - (10:40)	5 hr 38 min.	• Ignited air Preheater and incinerator. Heated up reactor to 800°F (TIR-700, -701, -707 & -733, whichever reached first). • DDAS back on-line at 08:00 but crashed once at approx. 09:40.
6/8 (10:40) - (11:45)	1 hr 5 min.	• Started <u>Combustion mode</u> .
6/8 (11:45) - (14:00)	2 hr 15 min.	• Dropped reactor pressure to fix coal plug in feed line.
6/8 (14:00) - (16:20)	1 hr 40 min.	• Restarted <u>Combustion mode</u> .
6/8 (16:20) - (16:32)	12 min.	• Purged reactor to reduce O ₂ conc. to < 3% by replacing reactor air with N ₂ . TIR-700 at 1126°F.

<u>Date (Time)</u>	<u>Duration</u>	<u>Description of Events</u>
6/8 (16:32) - (21:38)	5 hr 6 min.	<ul style="list-style-type: none"> • Started Gasification mode. <ul style="list-style-type: none"> a. Convey air at 850 scfh, reactor air gradually raised from 500 to 1200 scfh, steam at 55 lb/h, underflow N₂ reduced from 400 to 0 scfh (to prevent steam condensation in the bed), and coal feed at 70.2 lb/h. b. Performed routine coal transfer from batch to feed hopper and from silo to batch hopper. c. Performed routine dumping of solids from all lockhoppers every hour; and purging all vent valves and transmitters every 4 hours.
6/8 (21:38) - 6/12 (11:30)	89 hr	<ul style="list-style-type: none"> • Steady-State #2 (with Montana #6 coal). <ul style="list-style-type: none"> a. No underflow dumping due to bad leaks in transition MoGas valve (FV-908). But it caused very low underflow N₂ even with FCV-311/313 wide open. Clinker might have been formed. We fixed the problem with 1200-psig N₂ purge through FV-908. Then, we were able to get underflow N₂ back to 450 scfh. b. Reactor temperature crept up to 1,670°F (TIR-700). Had an excursion to 1,800 (TIR-733) at 02:50 of 6/9. To stop it, we increased steam from 50 to 55 lb/h, reduced reactor air from 1,200 to 1,100 scfh, switched convey air to N₂. At 03:50, all temperatures resumed uniform between 1,282 and 1,477°F. c. From 08:59 to 13:35 of 6/9, increased reactor air gradually to increase bed temperature. At 16:07, TE-700, -701, -702, and -703 read 1,076, 1,514, 1,499, and 1,458. d. At 21:39 of 6/10, another temperature creeping occurred at TE-701 (apprx. 1,816°F). We tuned down the reactor air and increased underflow N₂ flow to bring down TIR-701, but we overshot it to 862°F. e. From 16:13 of 6/11 on, TIR-700 and -701 were very low (apprx. 300°F). We were very sure a clinker was formed in the bottom of the bed.

<u>Date (Time)</u>	<u>Duration</u>	<u>Description of Events</u>
6/12 (11:30) - 6/13 (04:21)	16 hr 51 min.	<ul style="list-style-type: none"> • <u>Controlled Shutdown</u> for MGCR to load sorbent. <ul style="list-style-type: none"> a. Found and <u>fixed</u> the leak in the gas grab sampling system by putting in a check valve in the exit line after the gas grab bottle. b. Cooled off the reactor bottom and bed so that the workers could work on it. Cleaned out the clinker from the insert and bed (8'1" tall from the face of the bottom flange). Feed nozzle was brushed clean. c. Installed TE-707 back for combustion zone temperature. d. Purge all hand valves and push-button purge lines. We got a lot of dust out of the purge line. e. Replaced the McGas valve (FV-908) that had a grooves on the bottom seat with a new one.
6/13 (04:21) - (13:30)	9 hr 9 min.	<ul style="list-style-type: none"> • Started <u>System Start-up</u> procedure. <ul style="list-style-type: none"> a. At 07:40, MGCR decided to scratch their Dry Chloride Removal (DCR) test plan. At 10:15, all chloride doped coal was removed from silo and replaced with regular coal.
6/13 (13:30) - (15:00)	1 hr 30 min.	<ul style="list-style-type: none"> • Start <u>Combustion mode</u>. <ul style="list-style-type: none"> a. Added <u>underflow N₂</u> during this mode.
6/13 (15:00) - (15:10)	10 min.	<ul style="list-style-type: none"> • Purged reactor to reduce O₂ conc. to < 3% by replacing reactor air with N₂.

<u>Date (Time)</u>	<u>Duration</u>	<u>Description of Events</u>
6/13 (15:10) - (17:26)	2 hr 16 min.	<ul style="list-style-type: none"> • Started <u>Gasification mode</u>. a. At the <u>start of this mode</u>, the following condition was set: Convey air at 850 scfh, reactor air at 1105 scfh, steam at 63 lb/h, underflow N₂ at 478 scfh, and coal feed at 70.2 lb/h.
6/13 (17:26) - 6/15 (12:40)	43 hr 14 min.	<ul style="list-style-type: none"> • Steady-State #3 (with Montana #6 coal). a. At 17:20, a different flow configuration was tried: Convey air at 1600 scfh, reactor air at 450 scfh, steam at 54 lb/h, underflow N₂ at 400 scfh and coal feed 70 lb/h. b. Performed routine coal transfer from batch to feed hopper and from silo to batch hopper. c. Performed routine dumping of solids from all lockhoppers every hour; and purging all vent valves and transmitters every 4 hours.
6/15 (12:40) - (24:00)	11 hr 20 min.	• <u>Normal System Shutdown</u> .

Total Gasification Time = 151 hr 74 min.
 Total Steady-State Time = 143 hr 22 min.
 Total No. of Steady-State Periods = 3 (11.13; 89; and 43.23 hours).

Table 1 . SUMMARY OF MAJOR EVENTS DURING TEST RUN
 (Test No. 94FBG08) July 18-27 , 1994

<u>Date (Time)</u>	<u>Duration</u>	<u>Description of Events</u>	
7/18 (00:00)		<ul style="list-style-type: none"> • Started <u>System Start-up</u> procedure: • Reactor insert without side-jets was used (from the last S.S. period of Test Run 94FBG07). • Montana Rosebud #6 coal in silo. 	
7/18 (00:40) -	10 hr 41 min.	<ul style="list-style-type: none"> • Air Preheater ignited. Heated reactor to 800°F. (Based on TIR-700, -701, -707 & -733, whichever one reached first). • Opened HV-503 and FCV-115 to obtain the high air flow. (apprx. 7000 scfh). • Repaired broken flexible coupling at VSI-906. • Set all line heater temperatures to 500°F except Zone 6 & 7 to 1100°F (exits of both cyclones). 	
7/18 (11:21) - (13:10)	1 hr 49 min.	• Started Combustion mode.	
7/18 (13:10) - (13:55)	45 min.	• Purged reactor to reduce O ₂ conc. to < 3% by replacing reactor air with N ₂ .	
7/18 (13:55) - (16:30)	2 hr 35 min.	<ul style="list-style-type: none"> • Started <u>Gasification mode</u>. a. Convey air at 1600 scfh, Reactor air at 460 scfh, under-flow N₂ at 402 scfh, steam at 55 lb/h and coal feed at 69.6 lb/h. b. Performed routine coal transfer from batch to feed hopper and from silo to batch hopper. c. Performed routine dumping of solids from all lockhoppers every hour; and purging all vent valves and transmitters every 4 hours. 	
7/18 (16:30) -	44 hr 15 min.	• <u>Steady State #1</u> (with regular coal for METC-2 Sorbent Test and Filter Test). <ul style="list-style-type: none"> a. Low sample loop flow (FIR-806) - 3.2 scfh - due to crystal -like material built up. Cleaned and flow resumed. b. Sampling frequency: gas grab, detector tube, and condensate every hr., solids for every 4 hours. 	
7/20 (12:45)			

<u>Date (Time)</u>	<u>Duration</u>	<u>Description of Events</u>
7/18 (2355)		c. Mass spec. went off-line numerous times during the run.
		d. MGCR requested to postpone High Cl-coal run for 24 hours. e. MGCR sorbent test had a breakthrough between 7/18 2330 and 7/19 0030. Thus, sampling freq. changed from every hour to every 4 hrs for gas grab, condensate, and filter fines. No more detector tube. Solids for every 12 hours. f. Primary cyclone plugged. Unplugged with purging (bypassed interlock).
7/20 (1245) -	16 hr	<u>Steady-State #2</u> (with high chloride coal for Dry Chloride Removal (DCR) Test). a. Continuous monitoring pH and Cl- content in condensate from 7/20 1130 to 7/21 0630: pH dropped from 9.3 to 8.6; and Cl- increased irregularly from < 10 ppm to 250 ppm.
7/21 (0445)		<u>Steady-State #3</u> (with regular coal to continue Filter Test). a. Operating Conditions: Convey air 1600 scfh @66°F, Reactor air 530 scfh @940°F, steam 52 lb/h @950°F, underflow N ₂ 400 scfh @495°F, coal @30 rpm (70 lb/h). b. In the underflow dump, occasionally found small pieces of clinkers. c. Neotronics personal monitors lost SO ₂ detecting capability. d. ES&H discovered gas leaked into B12 through the space around a pipe penetrating into the building. Did not know where was the source. Gas had 281 ppm CO and 9.5 ppm H ₂ S. The space was temporarily patch with insulation material. The source could be the baghouse, leaking from its top. e. Found a hole in the vent line above HV-950 and temporarily plug it with a screw. f. MGCR lost all flow from FBG through FT-501. Switched to FCV-755. For 15 min. from 2108, there was a large pressure fluctuation on the reactor and manifold. PCV-756 slammed open and shut real bad. Had instrumentation tech. change the programming of the valve.
7/21 (0445) -	139 hr 50 min.	
7/21 (1155)		
7/23 (0035)		
7/25 (0655)		
7/26 (2102)		

<u>Date (Time)</u>	<u>Duration</u>	<u>Description of Events</u>
7/27 (00:35) - (15:00)	14 hr 25 min.	<ul style="list-style-type: none"> • Normal System Shutdown due to loss of coal feed. • Dropped the reactor bottom and found no clinkers adhered on the reactor wall and the insert. • DDAS off-line at 13:30.

Total Gasification Time = 202 hr 40 min.
 Total No. of Steady State Periods = 3 (44.25, 16, 139.83 hours). Total Steady State Time = 200 hr 5 min.

Table 1 . SUMMARY OF MAJOR EVENTS DURING TEST RUN
 (Test No. 94FBG09) September 12-16, 1994

<u>Date (Time)</u>	<u>Duration</u>	<u>Description of Events</u>
9/12 (00:00)		<ul style="list-style-type: none"> • Started <u>System Start-up</u> procedure. • Reactor insert without side-jets was used (from 94FBG08). • Montana Rosebud #7 coal (1,950 lbm) loaded in silo.
9/12 (00:10) - (14:56)	14 hr 46 min.	<ul style="list-style-type: none"> • Air Preheater ignited. Heated reactor to 800°F. (Based on TIR-700, -701, -707 & -733, whichever one reached first). • Opened HV-503 and FCV-115 to obtain the high air flow (apprx. 4500 scfh max. vs 7,000 scfh max. in 94FBG08). • Set all line heater temperatures to 500°F except Zone 6 & 7 to 1100°F (exits of both cyclones).
9/12 (14:56) - (16:08)	1 hr 12 min.	<ul style="list-style-type: none"> • Started <u>Combustion mode</u>. a. Raised the reactor temperature in 3 stages: 1,045 - 1,300 - 1,400 - 1,600°F).
9/12 (16:08) - (16:22)	14 min.	<ul style="list-style-type: none"> • Purged reactor to reduce O₂ conc. to < 3% by replacing reactor air with N₂.
9/12 (16:22) - (assumed) 9/12 (16:52) - (16:52)	30 min.	<ul style="list-style-type: none"> • Started <u>Gasification mode</u>. a. Convey air at 1600 scfh, Reactor air at 525 scfh, underflow N₂ at 402 scfh, steam at 58 lb/h and Montana #7 coal fed at 70 lb/h (air/coal=2.32; steam/coal=0.83). b. Performed routine coal transfer from batch to feed hopper and from silo to batch hopper. c. Performed routine dumping of solids every hour except underflow every 30 min. and 2nd cyclone every 6 hours; and purging all vent valves and transmitters every 4 hours.
9/12 (16:52) - 9/13 (06:15)	13 hr 23 min.	<ul style="list-style-type: none"> • Steady State #1 (with Montana #7 coal for METC-2 Sorbent Test and Filter Test with an air/coal of 2.32). <ul style="list-style-type: none"> a. Gas alarm went off twice (18:39 and 19:06) due to gas leak from the transition valve when dumping secondary cyclone. b. Sampling frequency: gas grab, detector tube and condensate every hr. until MGCR sorbent breakthrough, then every 4 hours; solids every 2 hours except cyclone every 12 hours.

<u>Date (Time)</u>	<u>Duration</u>	<u>Description of Events</u>
9/13 (06:15) - (18:00)	11 hr 45 min.	<ul style="list-style-type: none"> c. At 18:29, switched mass spec. (707) from FBG to MGCR. d. Moisture contents in product gas = 12.3, 10.3 and 10.7%wt.
9/13 (18:00) - 9/14 (10:22)	16 hr 22 min.	<ul style="list-style-type: none"> • <u>Steady State #2</u> (with Montana #7 coal for METC-2 Sorbent Test, Filter Test and Gain Matrix Test with an increase of air/coal from 2.32 to 2.65) <ul style="list-style-type: none"> a. At 06:15, started to increase reactor air from 525 to 825 scfh in 3 increments of 100 scfh. b. Gas alarm in alley read 2ppm SO₂ and PEL light on at 12:25. c. Mass spec. switched from MGCR to FBG at 12:42. d. At 11:45, loaded 1,120 lbm of Cl- doped Montana #6 coal into silo. e. From 11:45-11:47, took DDAS off line for mass spec. (707). • <u>Steady State #3</u> (with 3% chloride doped Montana Rosebud #6 coal for DCR Test, Filter Test and Gain Matrix Test with an air/coal of 2.87). <ul style="list-style-type: none"> a. At 18:03, raised reactor air from 825 to 1,025 in 4 increments of 50, 50, 25 and 25 scfh. At 23:13, reactor air reached to 1,025. b. Moisture Content in product gas during this period: 13.8, 12.7 and 10.4%wt. c. At 02:00, loaded 520 lbm of Montana #7 coal into silo. d. At 06:10, increased underflow N₂ from 400 to 500 scfh. e. At 10:20, loaded 740 lbm of Montana #7 coal into silo. f. Gas sample changed to every 4 hours; no detector tube. g. Moisture contents in product gas = 13.8, 12.7, 10.4 and 8.7%wt.
9/14 (10:22) - (19:27)	9 hr 5 min.	<ul style="list-style-type: none"> • <u>Steady State #4</u> (with Montana #7 coal for Gain Matrix Test). <ul style="list-style-type: none"> a. At 11:21 and 12:21, loaded a total of 1,440 lbm of Montana #7 coal into silo. b. From 13:25-13:27, took DDAS off line to change strategy so that mass spec. signal goes to totalizer and an alarm. c. At 16:10, lowered underflow N₂ from 500 to 400 scfh. d. At 17:16, gas alarm activated by radio. e. At 18:44, load 325 lbm of Montana #7 coal into silo.

<u>Date (Time)</u>	<u>Duration</u>	<u>Description of Events</u>
9/14 (19:27) - 9/15 (06:10)	10 hr 43 min.	<p>f. Moisture Contents of product gas = 8.7 and 8.3 %wt.</p> <ul style="list-style-type: none"> • <u>Steady State #5</u> (with Montana Rosebud #7 coal for Gain Matrix Test with an increase of coal feed rate from 70 to 80 lb/hr, resulting in a decrease of air/coal of 2.5). <ul style="list-style-type: none"> a. At 00:29 and 05:40, loss of coal feed during coal transfer into feed hopper and recovered with emergency N₂ (FV-409). b. Moisture Contents of product gas = 9, 10, 9.8 %wt.
9/15 (06:10) - 9/15 (21:12)	15 hr 2 min.	<p>• <u>Steady State #6</u> (with Montana Rosebud #7 coal for Gain Matrix Test with an increase of air/coal of 2.87).</p> <ul style="list-style-type: none"> a. At 06:10, started to increase reactor air from 1,025 to 1,400 scfh in 7 increments of 50 scfh and last increment of 25 scfh. At 09:55, reactor air reached to 1,400 scfh. b. From 09:43-09:45, took DDAS off line to update the mass spec. alarm. c. At 16:06, decreased reactor air to 1,025 scfh and coal feed to 70 lb/h. d. At 17:25, loaded silo with 810 lbm of coke breeze. e. Moisture Contents of product gas = 9.1, 10.3 and 8.8 %wt.
9/15 (21:12) - 9/16 (07:00)	9 hr 48 min.	<p>• <u>Steady State #7</u> (with Coke Breeze at 70 lbm/hr and an air/coke of 2.87)</p> <ul style="list-style-type: none"> a. At 22:47, discovered old calibration curve for coke breeze, i.e., 30 rpm=72 lbm/hr of coke breeze. b. At 00:53, loaded 600 lbm of Illinois #6 coal into silo. c. At 01:05, reduced underflow N₂ from 500 to 475 scfh; at 01:10, reduce it further to 450 scfh. d. At 01:25, turned off air preheater to prepare for cooler reactor air for running caking (bituminous) coal. e. At 02:10, decreased reactor air from 1,025 to 1,000 scfh and increased underflow N₂ from 450 to 500 scfh. f. At 04:59, increased reactor air from 1,000 to 1,025 scfh. g. At 05:45, batch hopper is empty; then loaded Illinois #6 coal from silo to batch hopper. h. From 05:50 to 06:16, increased reactor air from 1,025 to 1,200 scfh in an increments of 25 scfh and 3 increments of 50 scfh.

<u>Date (Time)</u>	<u>Duration</u>	<u>Description of Events</u>
		<ul style="list-style-type: none"> i. At 06:01, reduce underflow N₂ from 500 to 475 scfh; at 06:11, reduce it to 460 scfh; and at 06:47, further reduced to 440 scfh. j. Moisture Contents of product gas = 10.4 and 9.2 %wt.
9/16 (07:00) - (14:00)	7 hr	<ul style="list-style-type: none"> • <u>Steady State #8</u> (with Illinois #6 coal) <ul style="list-style-type: none"> a. From 07:02 to 07:25, reduced reactor air from 1,200 to 1,150 scfh, and underflow N₂ further down to 400 scfh. b. Moisture Contents of product gas = 13, 9.5 and 8.9 %wt.
9/16 (14:00) - (24:00)	10 hr	<ul style="list-style-type: none"> • <u>Normal System Shutdown</u> as scheduled. <ul style="list-style-type: none"> a. Changed convey and reactor air to N₂. b. Turned off coal feeder and N₂ preheater. c. Bypassed steam from reactor. d. Weighed and secured all barrels of solids. e. Shut off portable boiler. f. Transferred all solids from silo through batch into feed hopper. g. Blew out all vent lines with HV-950 for 10 sec. h. Shut all N₂ and sir header valves. i. Removed the center (3/4") feed nozzle from reactor bottom. j. Calibrated coal feeder ("A") with Illinois #6 coal. • Dropped the reactor bottom and found no clinkers adhered on the reactor wall and the insert.
9/19 Morning		

Total Gasification Time = 93 hr 38 min.
 Total No. of Test Periods = 8 (13.38, 11.75, 16.37, 9.08, 10.72, 15.03, 9.8, and 7 hours).

Table 1. SUMMARY OF MAJOR EVENTS DURING TEST RUN
 (Test No. 94FBG10)

(Test No.: 94FBG110) October 24-28, 1994

<u>Date (Time)</u>	<u>Duration</u>	<u>Description of Events</u>
10/24 (00:00)	11 hr	<ul style="list-style-type: none"> • <u>Test Period #1</u> (Heat-Up of the system) <ul style="list-style-type: none"> a. Started System Start-up procedure. b. Reactor insert with side-jets was us c. Montana #7 coal (3,500 lbm) loaded d. Air Preheater ignited. Heated react e. Set cone N₂ to 50 scfh (FIR-311) and to 350 scfh with underflow N₂ preheat f. Heated up reactor faster at lower pr g. Set all line heater temperatures to to 1100°F (exits of both cyclones). h. At 07:45, reactor pressure was raise bottom temperatures reached to 750°F i. At 08:30, fixed steam leak at PCV-22 line. Another small leak was found
	2 hr	<ul style="list-style-type: none"> • Started <u>Combustion mode</u>. Raised the reactor temperature in 3 sta 1,400 - 1,600°F).
10/24 (11:00) - (13:00)	46 min.	<ul style="list-style-type: none"> • Purged reactor to reduce O₂ conc. to <
10/24 (13:00) - (13:46)	1 hr 14 min.	<ul style="list-style-type: none"> • Started <u>Gasification mode</u>. a. Convey air at 1600 scfh, Reactor air at 50 scfh and underflow N₂ at 350 s and Montana #7 coal fed at 70 lb/h (Steam/Coal (daf) = 0.83). b. Performed routine coal transfer from and from silo to batch hopper. c. Performed routine dumping of solids underflow every 30 min. and 2nd cycl
10/24 (13:46) - (15:00)		<ul style="list-style-type: none"> purging all vent valves and transmit

<u>Date (Time)</u>	<u>Duration</u>	<u>Description of Events</u>
10/24 (15:00) - (23:00)	8 hr	<ul style="list-style-type: none"> • <u>Test Period #2</u> (Filled bed with an Air/Coal (daf) of 3.3 and Steam/Coal (daf) at 0.83). <ul style="list-style-type: none"> a. At 15:20, mass spec. (707) was turned on for MGCR. b. At 16:30, MGCR came on-line. c. Rupture disk 753A was blown and replaced with ESS&H personnel present (CO on 3rd floor of the cell = 9ppm). d. Small fire around the overflow pipe on the 2nd level of cell was found and extinguished. e. Sampling frequency: gas grab, detector tube and condensate every hr. until MGCR sorbent breakthrough, then every 4 hours; solids every 2 hours except cyclone at the end of each test period (6 or 12 hours). f. Averaged Moisture Content in product gas = 9.4 %wt. g. DDAs was down twice.
10/24 (23:00) - 10/25 (05:00)	6 hr	<ul style="list-style-type: none"> • <u>Test Period #3</u> (Bed stabilization with Montana #7 coal for ZT-04 Sorbent Test, Filter Test and test matrix with an increase of reactor air to 1,000 scfh and cone N₂ to 100 scfh, and a decrease of steam to 55 lb/h and underflow N₂ to 300 scfh). <ul style="list-style-type: none"> a. Needed to purge the overflow line frequently to unplug it. b. Mass spec. (707) went off-line several times. c. Between 00:00 and 01:00, there was a breakthrough on ZT-04. d. Averaged Moisture Content in product gas = 8.9 %wt.
10/25 (05:00) - (17:00)	12 hr	<ul style="list-style-type: none"> • <u>Test Period #4</u> (with Montana #7 coal for test matrix with an increase of cone N₂ to 150 scfh). <ul style="list-style-type: none"> a. Needed to purge the overflow line frequently to unplug it. b. Mass spec. (707) went off-line several times. c. At 14:40, MGCR called to shut off mass spec. (707). d. At 16:46, reactor temperatures were: 927 (TIR-700), 1242 (-701), 1,568 (-701), 903 (-703), and 1,010°F (-733). e. Averaged Moisture Content in product gas = 7.4 %wt.

<u>Date</u> <u>(Time)</u>	<u>Duration</u>	<u>Description of Events</u>
10/25 (17:00) - 10/26 (05:00)	12 hr	<ul style="list-style-type: none"> • <u>Test Period #5</u> (with Montana #7 coal for test matrix with cone N₂ reset at 50 scfh). <ul style="list-style-type: none"> a. At 18:20, ES&H personnel accompanied one technician and shift engineer to check the CO level at the 2nd level, which hit 35 ppm. Needed to insulate the overflow pipe. b. Needed to purge the overflow line frequently to unplug it. c. Averaged Moisture Content of product gas = 7.0 %wt.
10/26 (05:00) - (11:00)	6 hr	<ul style="list-style-type: none"> • <u>Test Period #6</u> (with Montana #7 coal for test matrix with an increase of cone N₂ to 100 scfh). <ul style="list-style-type: none"> a. At 05:45, loaded 1,190 lbm of Cl- doped Montana #6 coal into silo. b. Averaged Moisture Content of product gas = 7.2 %wt.
10/26 (11:00) - 10/26 (23:00)	12 hr	<ul style="list-style-type: none"> • <u>Test Period #7</u> (with 3% chloride doped Montana #6 coal for DCR Test, Filter Test and test matrix with an Air/Coal (daf) of 3.82 and Steam/Coal (daf) of 0.83). <ul style="list-style-type: none"> a. At 16:14, reactor temperatures were: 1,027 (TIR-700), 1,277 (-701), 1,630 (-702), 940 (-903) and 1,027°F (-733). b. At 00:45, loaded 3,640 lb of Montana #7 coal into silo. c. Averaged Moisture Content of product gas = 8.3 %wt.
10/26 (23:00) - 10/27 (03:00)	4 hr	<ul style="list-style-type: none"> • <u>Test Period #8</u> (with 3% chloride doped Montana #6 coal for DCR Test, Filter Test and test matrix with an Air/Coal (daf) of 3.65 and Steam/Coal (daf) of 0.81). <ul style="list-style-type: none"> a. Reduced the reactor air flow to 940 scfh according to the test matrix planned.
10/27 (03:00) - (15:00)	12 hr	<ul style="list-style-type: none"> • <u>Test Period #9</u> (with Montana #7 coal for test matrix with a decrease of reactor air to 940 scfh. Air/Coal (daf) was 3.12 and steam/coal (daf) was 0.74) <ul style="list-style-type: none"> a. CO gas alarm in cell at 40 ppm. b. MGCR was off-line from 13:16 to 13:29. c. Averaged Moisture Content of product gas = 8 %wt.
10/27 (15:00) - (21:00)	6 hr	<ul style="list-style-type: none"> • <u>Test Period #10</u> (with Montana #7. coal for test matrix with an increase of reactor air to 1,000 scfh, Air/Coal (daf) = 3.17 and Steam/Coal (daf) of 0.85)

Date (Time)

Description of Events

<u>Duration</u>	<u>Description of Events</u>
10/27 (21:00) - 10/28 (09:00)	<ul style="list-style-type: none">a. At 19:16, the Neotronics monitor carried by a technician detected 15 ppm CO and ES&H personnel was called in but detected no leak around the baghouse.b. Averaged Moisture Content in product gas = 9 %wt.
12 hr	<ul style="list-style-type: none">• <u>Test Period #11</u> (with Montana #7 coal for test matrix with an increase of reactor pressure (PIR-713) to 440 psig)<ul style="list-style-type: none">a. At 23:12, had problems with the steam flow and gas leak in cell 1 (getting worse). Thus, reduced reactor pressure back to 425 psig.b. At 00:10, increased cone N₂ from 100 to 200 scfh (an additional study in the Test Matrix).c. At 07:20, discovered steam flow creeping up from 55 to 70 lb/h. Reduced to 55 lb/h, but it crept back up 60 lb/h within 10 min. Again reduced it to 58 lb/h but discovered TIR-702 creeping up to 1,698°F. Stopped reducing steam and watch TIR-702 closely.d. Averaged Moisture Content of product gas = 7.2 %wt.
10/28 (09:00) - (13:30)	<ul style="list-style-type: none">• <u>Test Period #12</u> (with Montana #7 coal for test matrix with a decrease of reactor pressure to 400 psig)<ul style="list-style-type: none">a. At 09:00, CO alarm on 3rd level in cell went off at 35 ppm.b. At 09:03, reduced reactor pressure down to 400 psig and cone N₂ flow from 200 to 100 scfh, keeping underflow N₂ at 300 scfh, causing the reactor pressure to swing for about 10 min. before it stabilized at 400 psig.c. At 09:05, the bed slumped (PDIR-706) which stopped the underflow N₂ about 15 min. The product gas flow also varied between 2,000 to 9,000 scfh during this 15 min.d. At 09:30, steam flow declined from 62 to 30 lb/h in 35 min. and raised back to 58 lb/h afterward.e. At 10:35, MGCR got off-line to remove sorbent and switch filter vessels and clean the plugged incinerator lines.f. At 10:50, TIR-700 went up to 1,962°F. Reduced reactor air to 950 scfh and increase steam to 70 lb/h. Brought reactor pressure down to 425 psig to alleviate the overheating problem but failed.g. Averaged Moisture Content of product gas = 9 %wt.

<u>Date (Time)</u>	<u>Duration</u>	<u>Description of Events</u>
10/28 (13:30) - 10/29 (08:00)	18 hr 30 min.	<ul style="list-style-type: none"> • Quick Controlled Shutdown (due to clinker formation and completely plugging in overflow line) <ul style="list-style-type: none"> a. Changed convey and reactor air to N₂. b. Turned off coal feeder and N₂ preheater. c. Bypassed steam from reactor. d. Weighed and secured all barrels of solids. e. Shut off portable boiler and incinerator. f. Transferred all solids from silo through batch into feed hopper. g. Blew out all vent lines with HV-950 for 10 sec. h. Shut all N₂ and air header valves. i. Removed the center (3/4") feed nozzle from reactor bottom. j. Calibrated coal feeder ("A") with Montana #7 coal. k. Dropped the reactor bottom and found a few clinkers adhered on the reactor wall and filled up the insert.
		<p>Total Gasification Time = 95 hr 44 min. Entire Test Period = 128 hrs.</p> <p>Test Matrix Time = 94 hr 30 min. No. of Test Periods = 11</p>



APPENDIX 3

DAILY PROCESS VARIABLE PLOTS




The following trend charts were created for runs 94MGC07 through 94MGC10. Although the charts contain several process variables, only FIR-501, TIR-248, TIR-224, PIR-247, PIR-458 and, PDIR- (also shown as PDT- or PIR-) 155 and 459 are relevant. The table below provides a description of each of these process variables.

<u>Process Variable</u>	<u>Description</u>
FIR-501	Cumulative syngas volumetric flow rate to the filtration vessel and the particle measurement system
TIR-248	Inlet gas temperature of the filtration vessel
TIR-224	Outlet gas temperature of the filtration vessel
PIR-247	Inlet gas pressure of the filtration vessel
PIR-458	Filter blowback pressure
PDIR-155	Differential pressure of the filtration vessel
PDIR-459	Differential pressure of the filter

All other process variables may be referenced through the process and instrumentation diagrams provided.

 
Since the needs of the project have changed somewhat from run to run, the trend charts have also changed somewhat. However, these changes are not major ones and the charts have been separated by run number and arranged in the order listed above for convenience.




94MGC07
(06/06/94 - 06/15/94)




MGCR INLET AND EXIT FLOWS
94MGC07 - 06/06/94

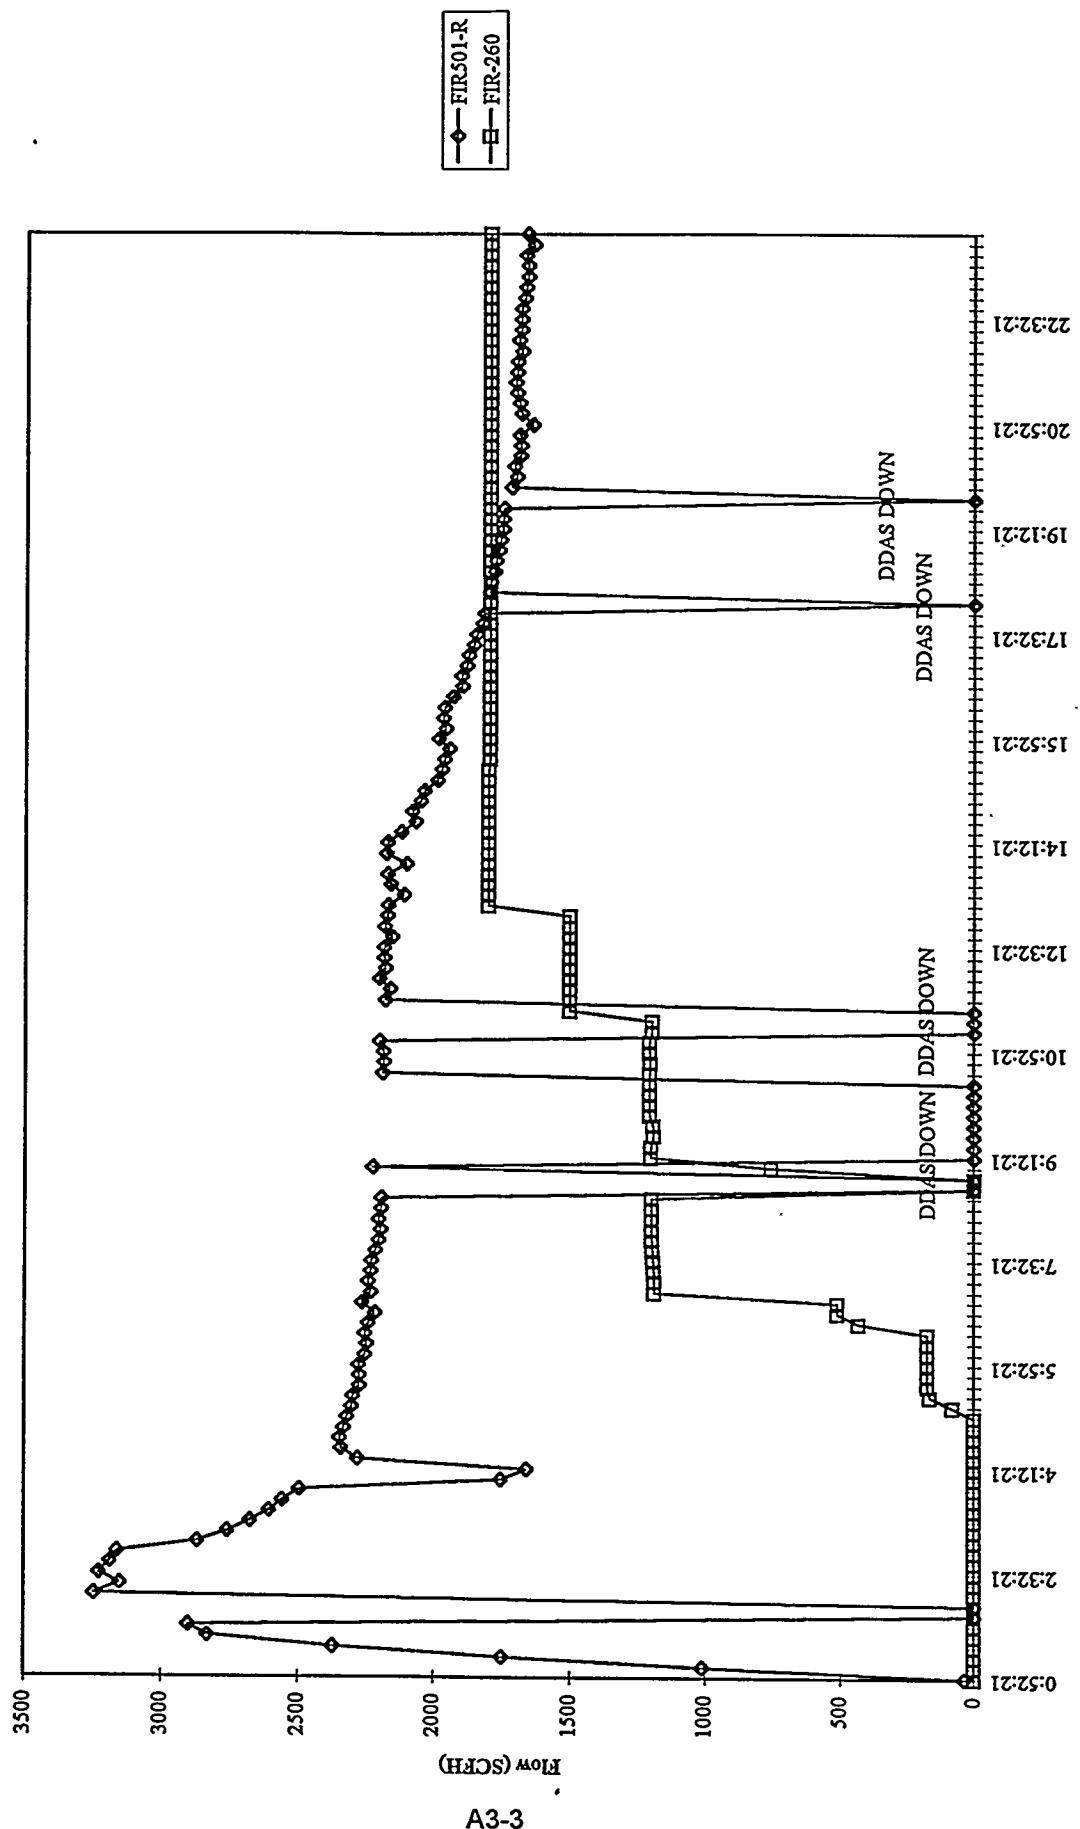


MGCR INLET AND EXIT FLOWS
94MGC07 - 06/07/94

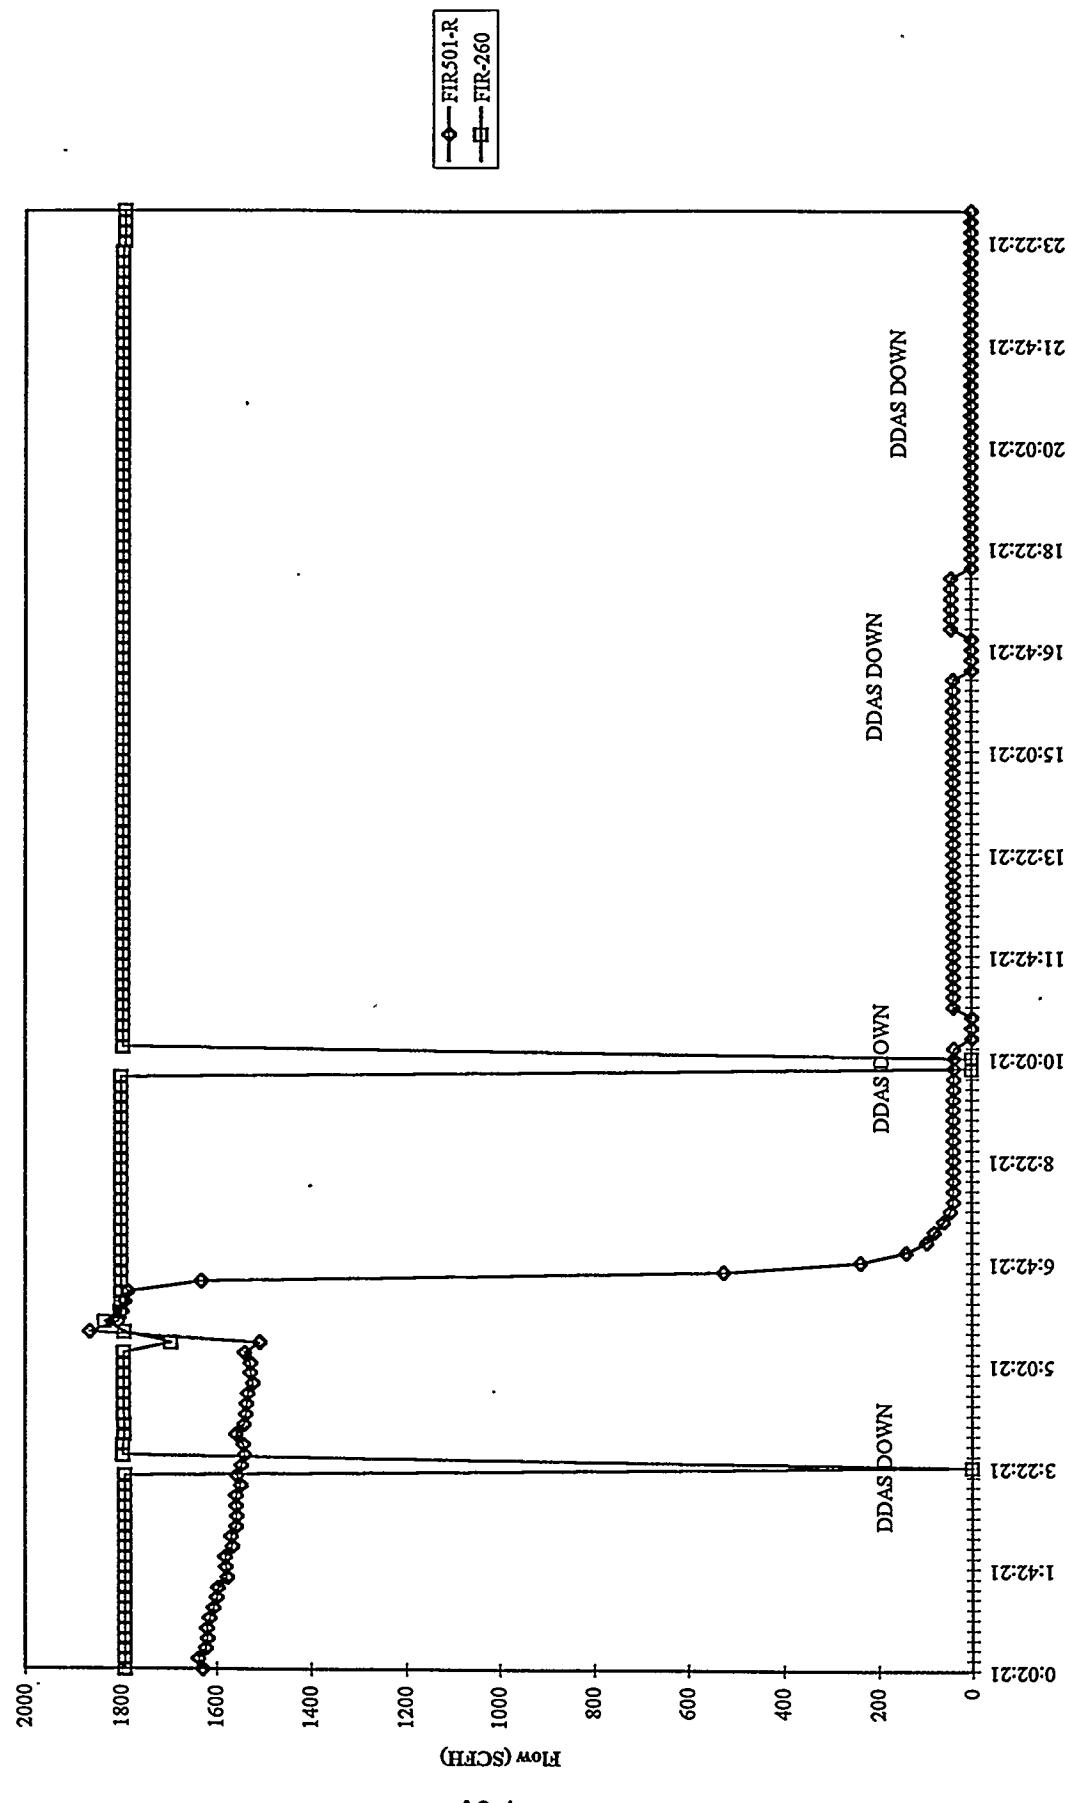


MGCR INLET AND EXIT FLOWS
94MGC07 - 06/08/94

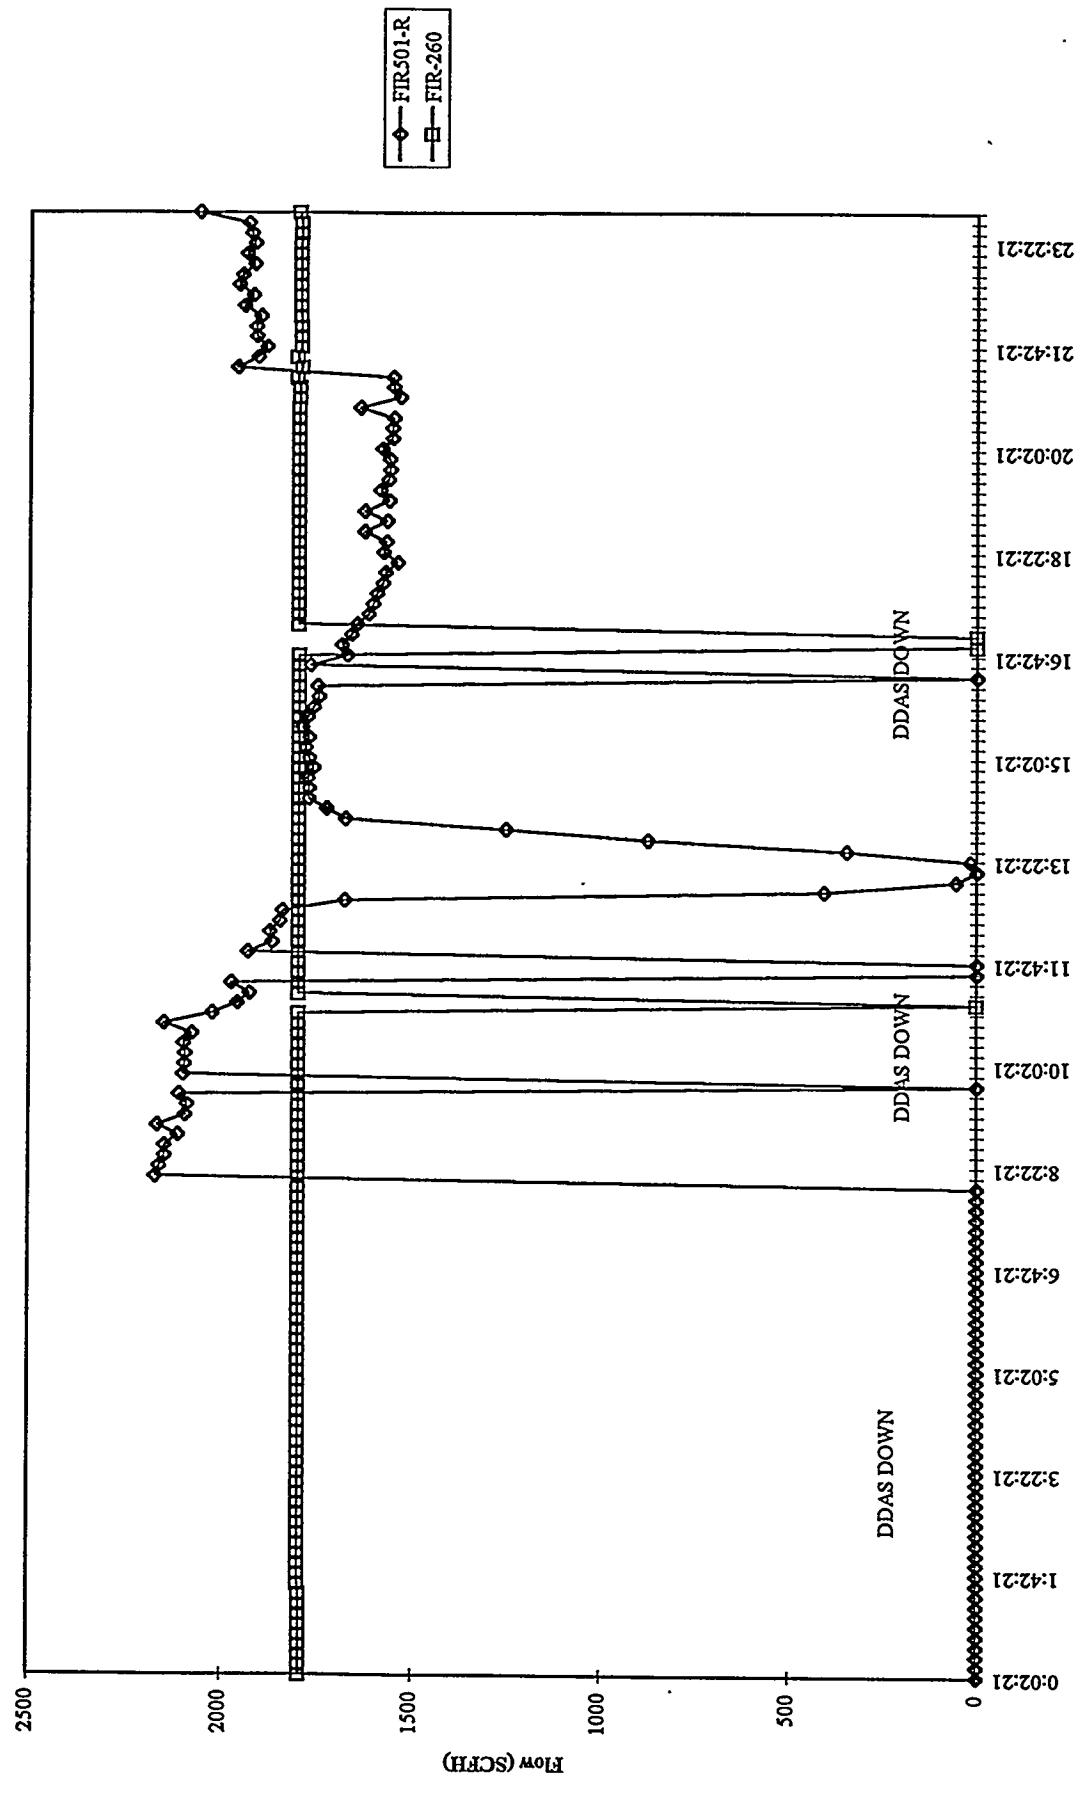

MGCR INLET AND EXIT FLOWS
94MGC07 - 06/09/94

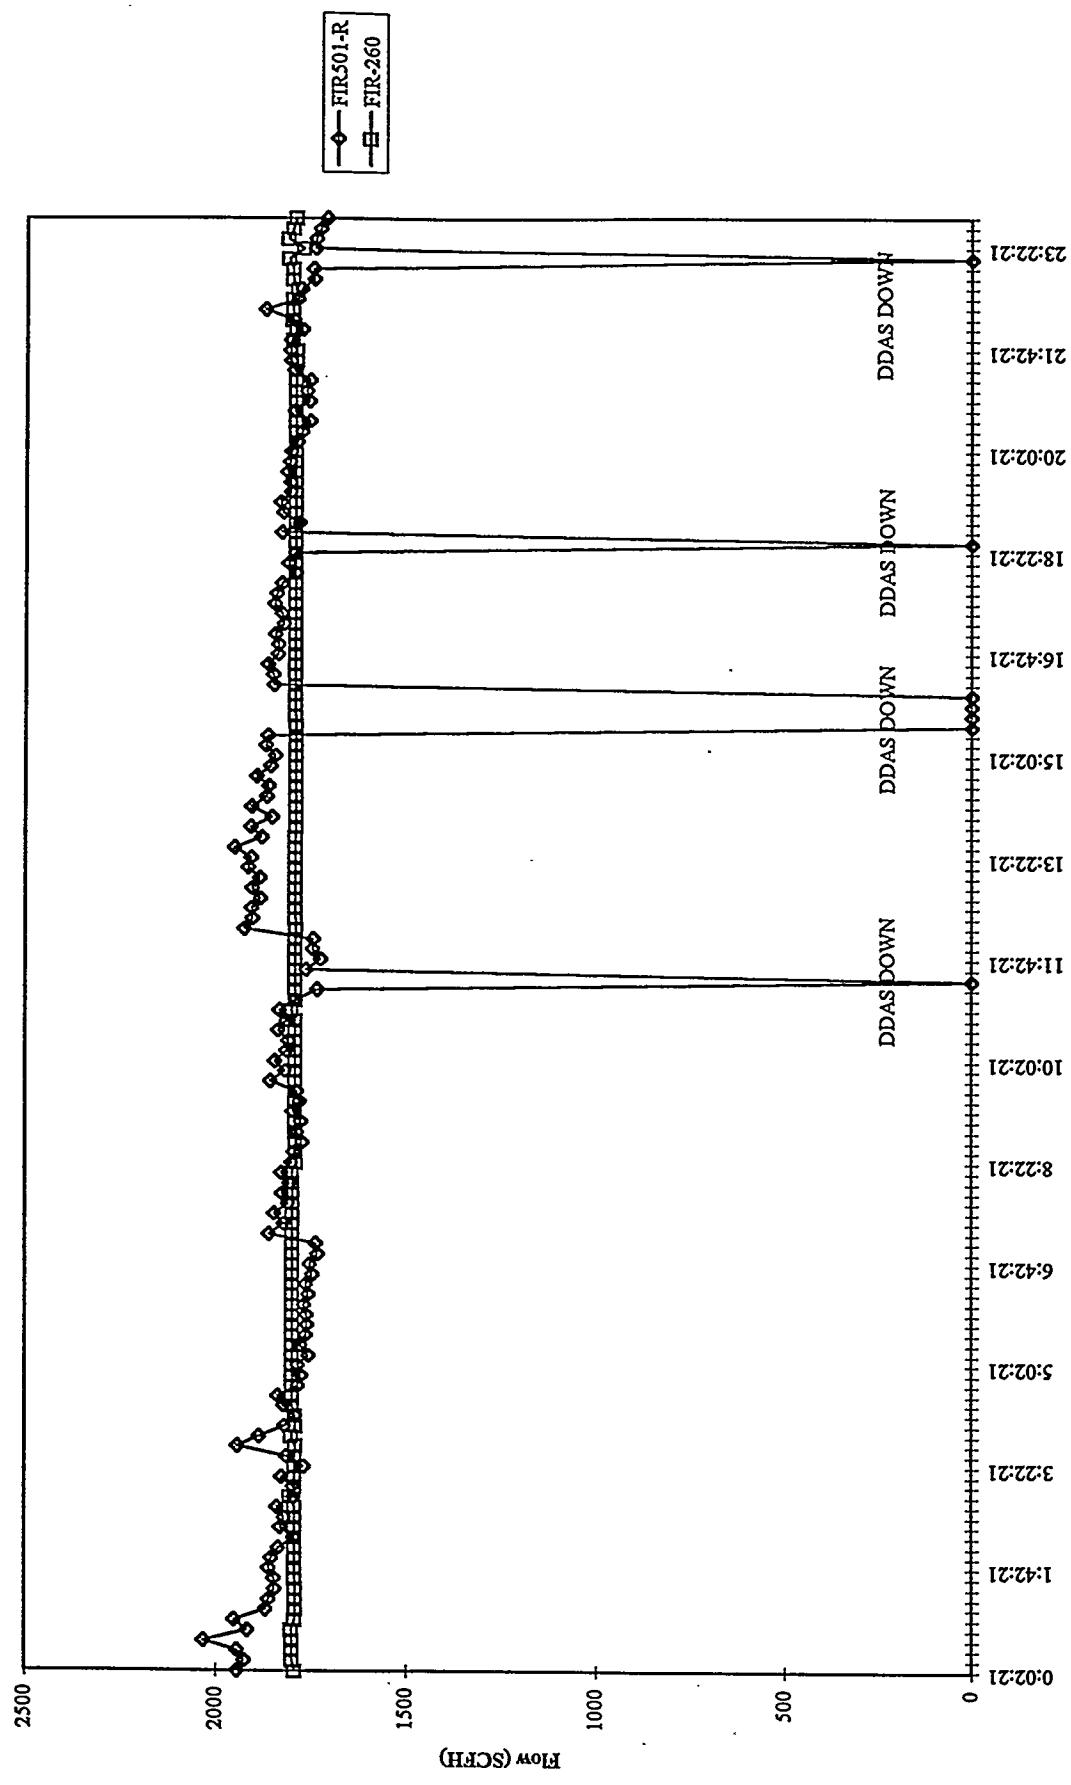


MGCR INLET AND EXIT FLOWS
94MGC07 - 06/10/94

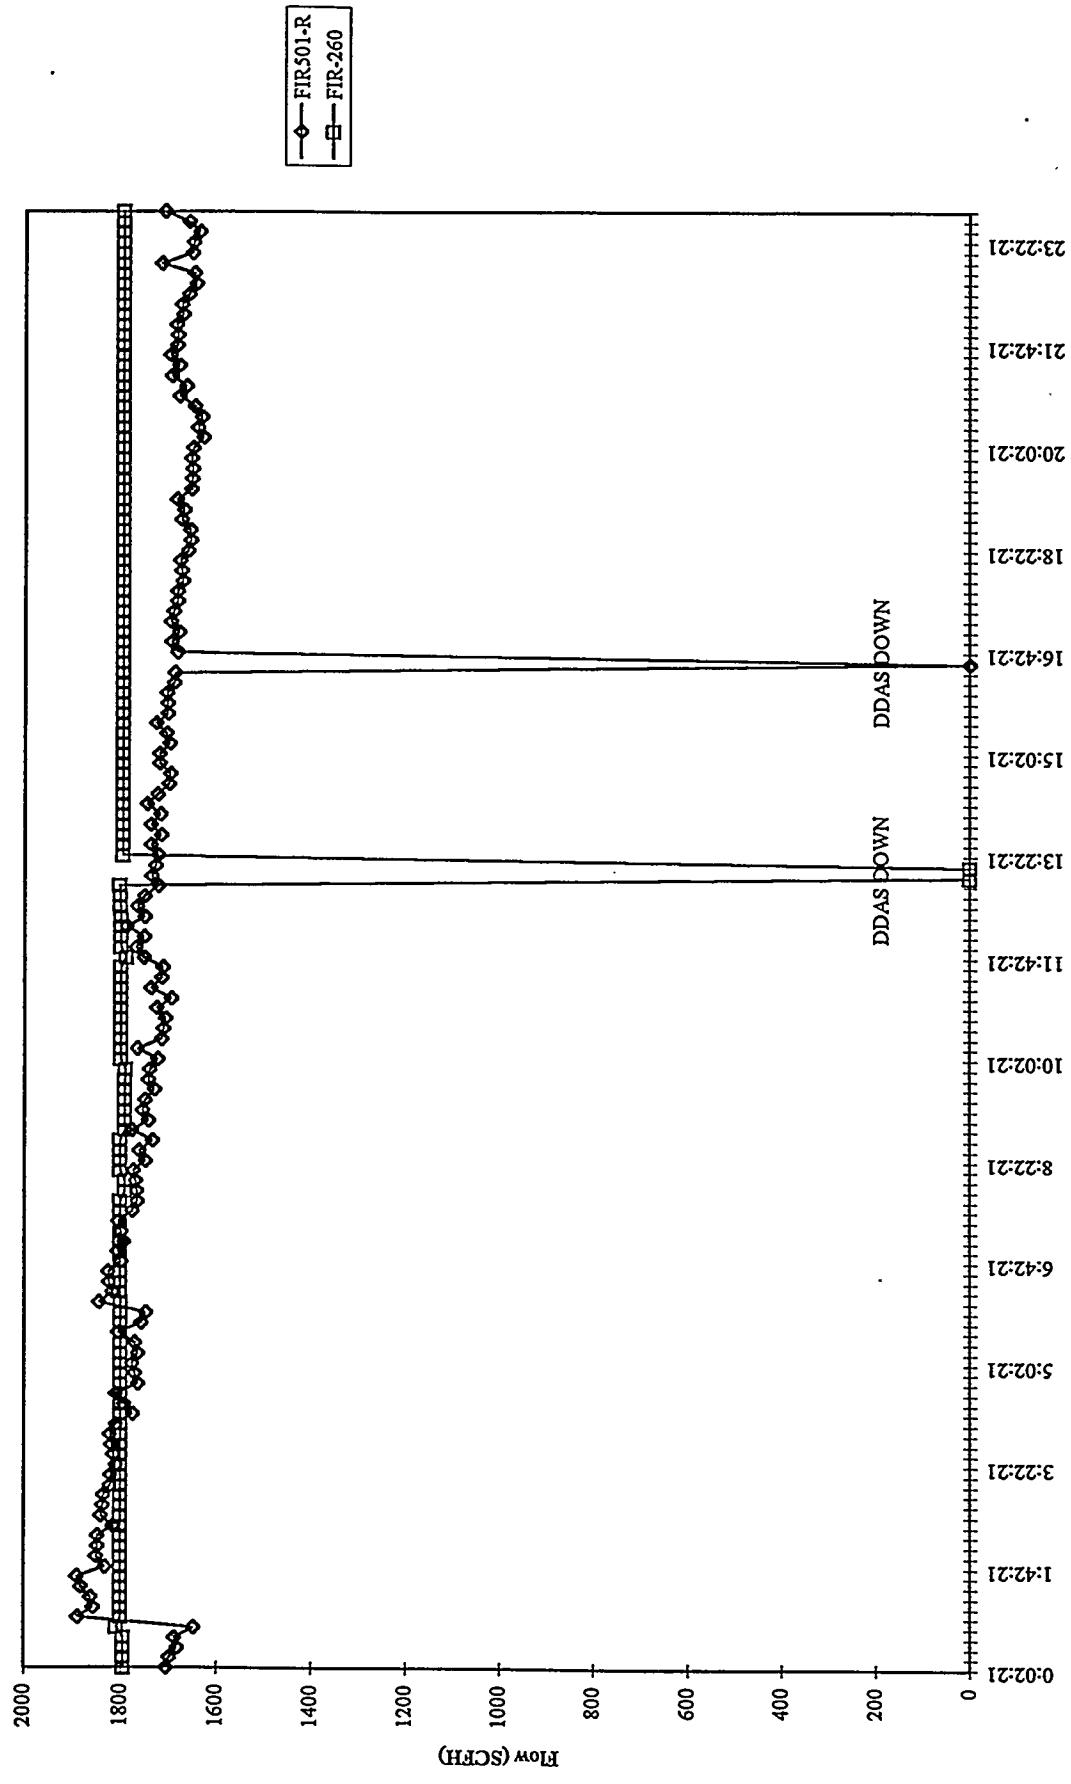


A3-7


MGCR INLET AND EXIT FLOWS
94MGC07 - 06/11/94

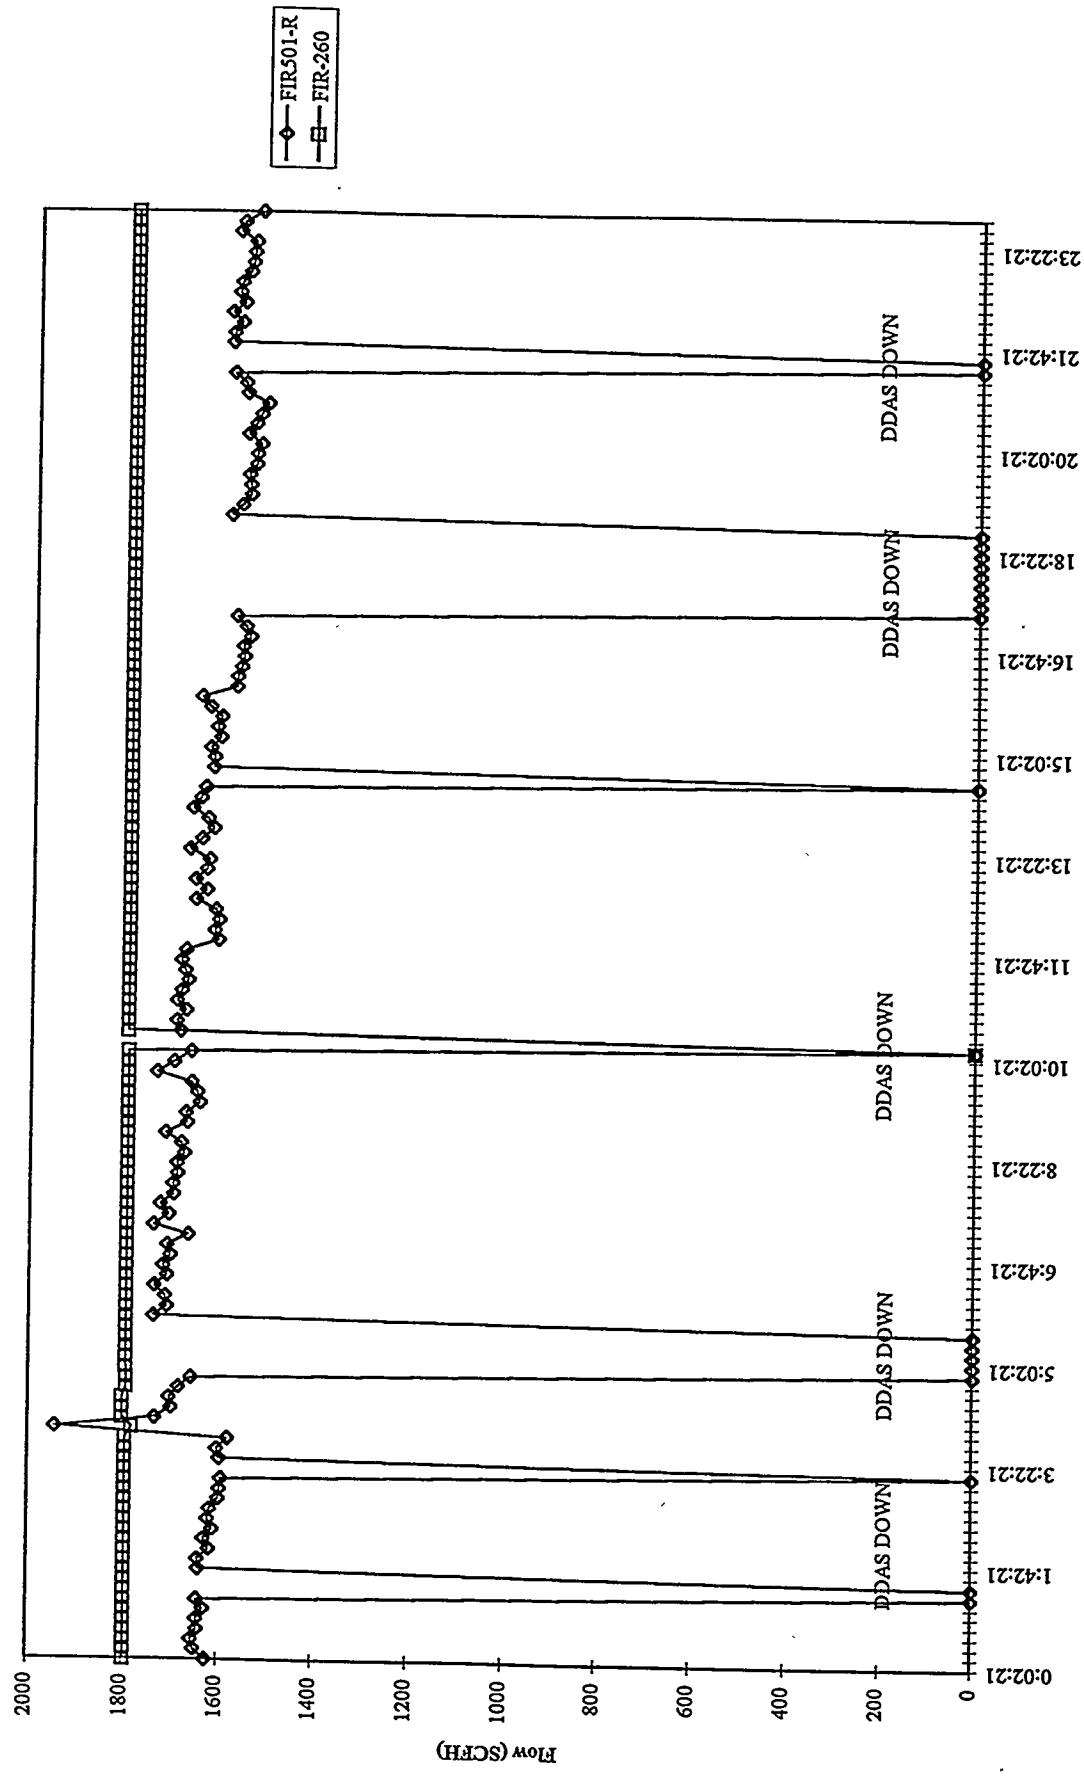

MGCR INLET AND EXIT FLOWS
94MGC07 - 06/12/94

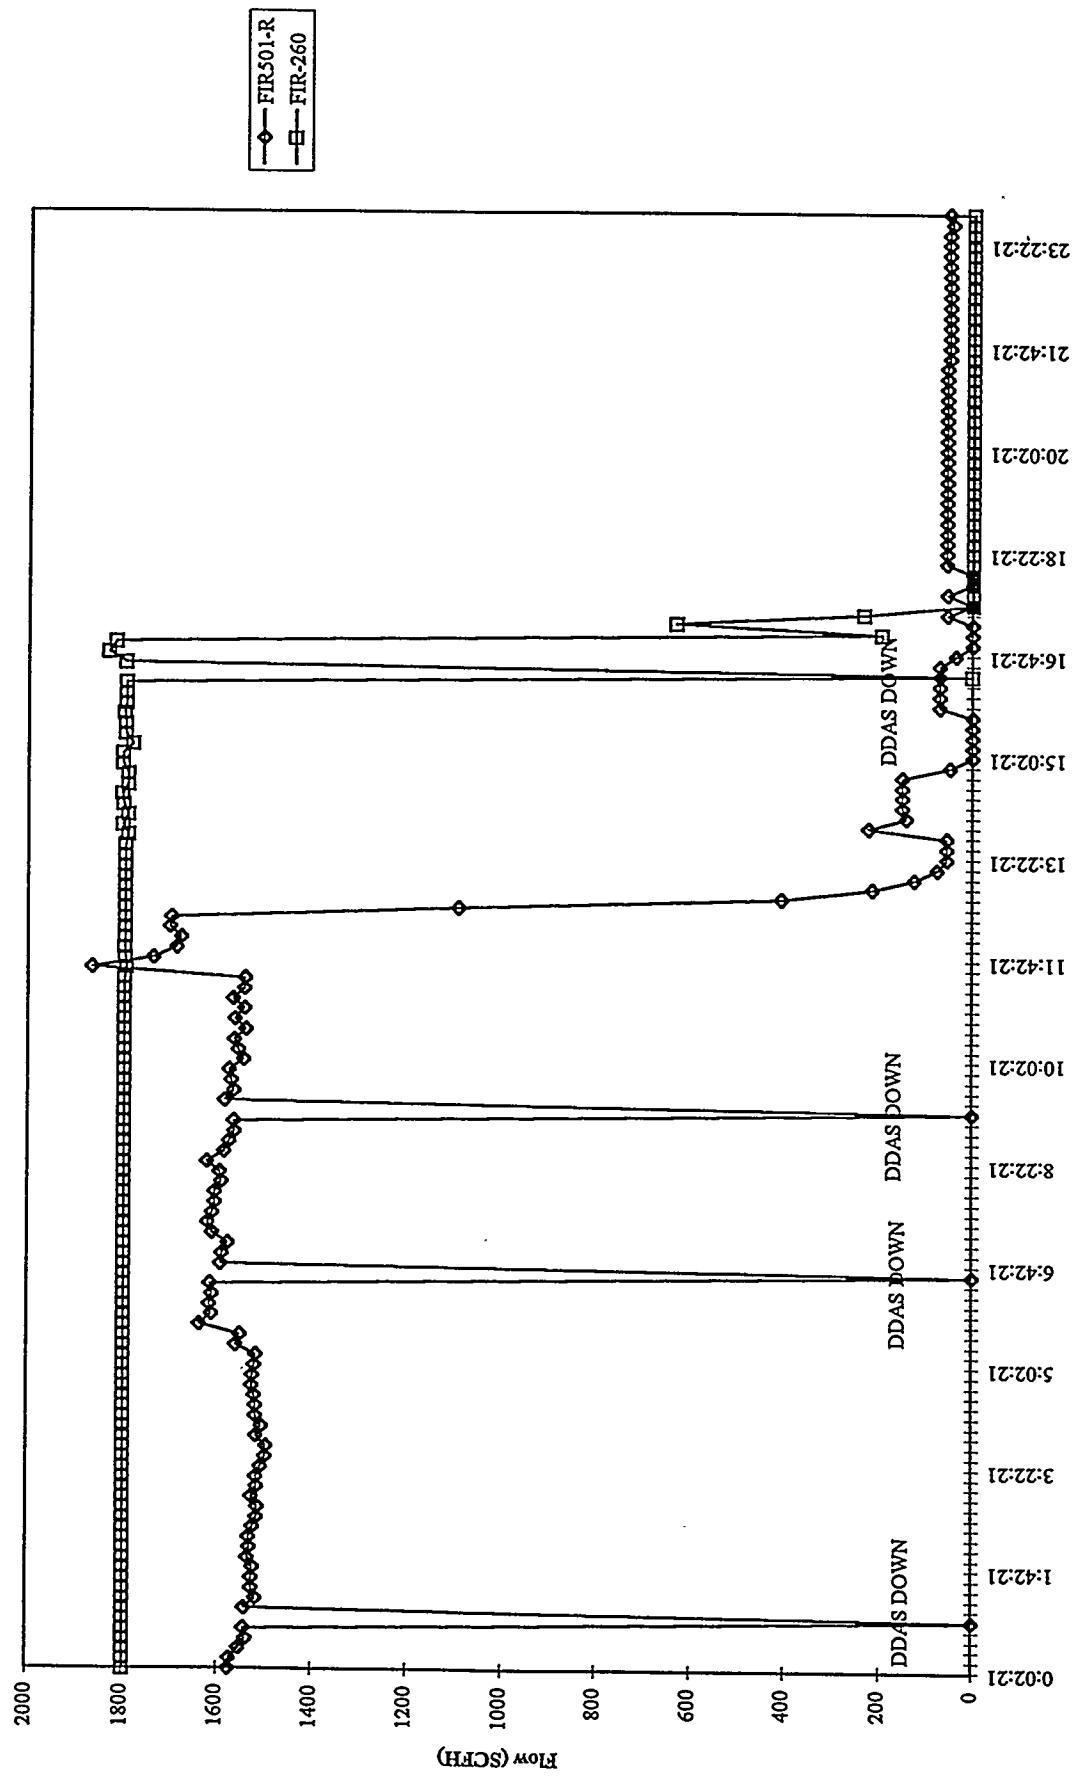


MGCR INLET AND EXIT FLOWS
94MGC07 - 06/13/94

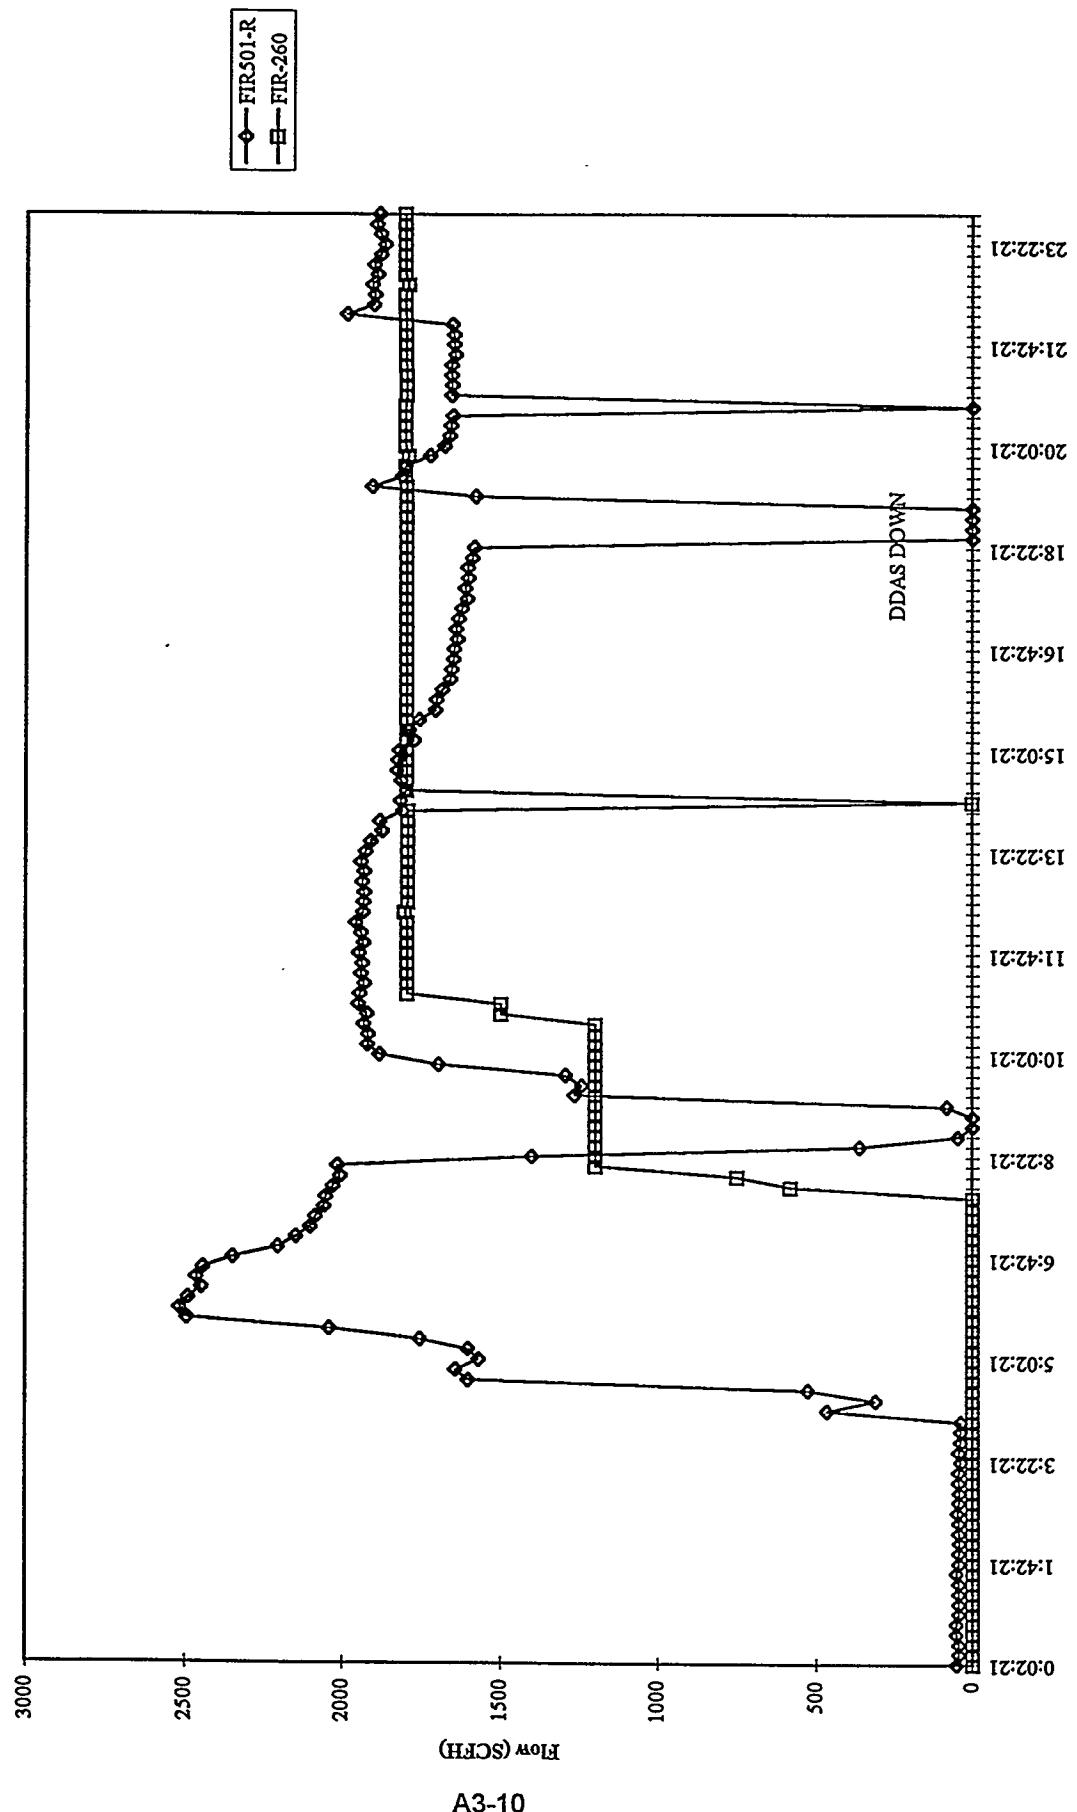


A3-10

MGCR INLET AND EXIT FLOWS
94MGC07 - 06/14/94

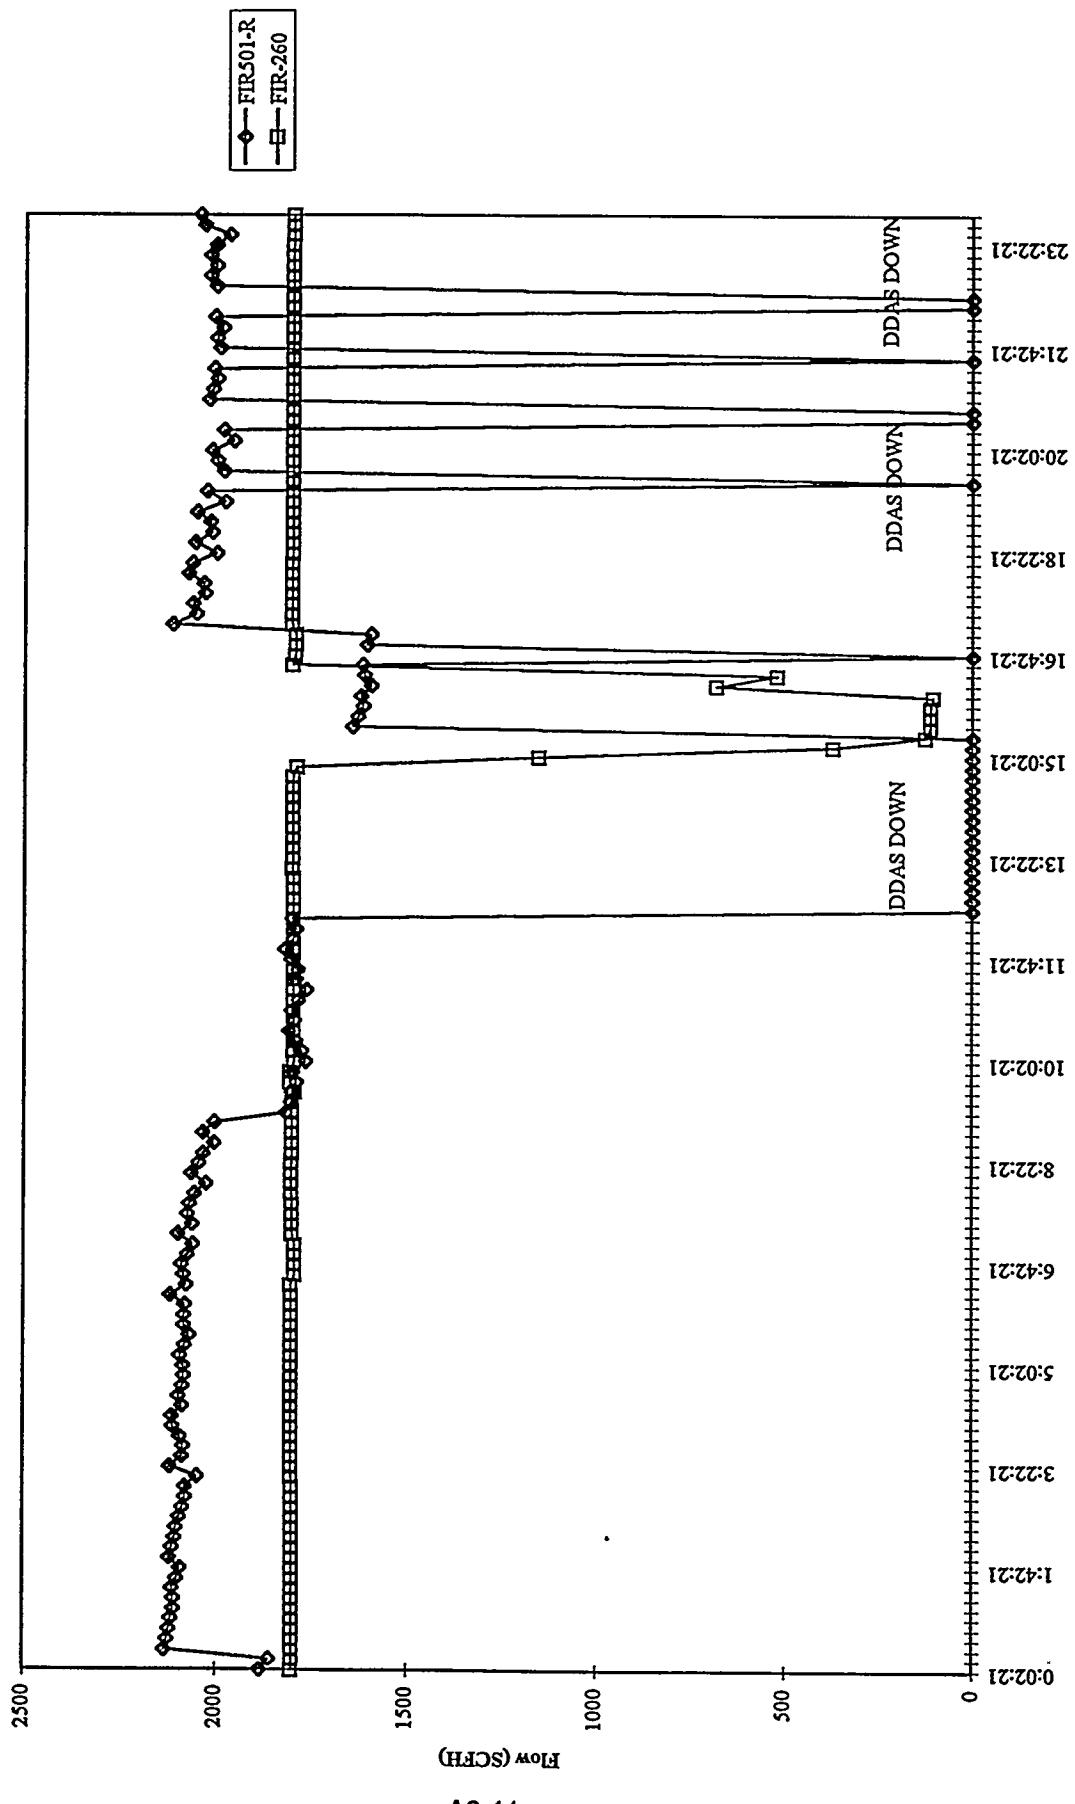


MGCR INLET AND EXIT FLOWS
94MGC07 - 06/15/94

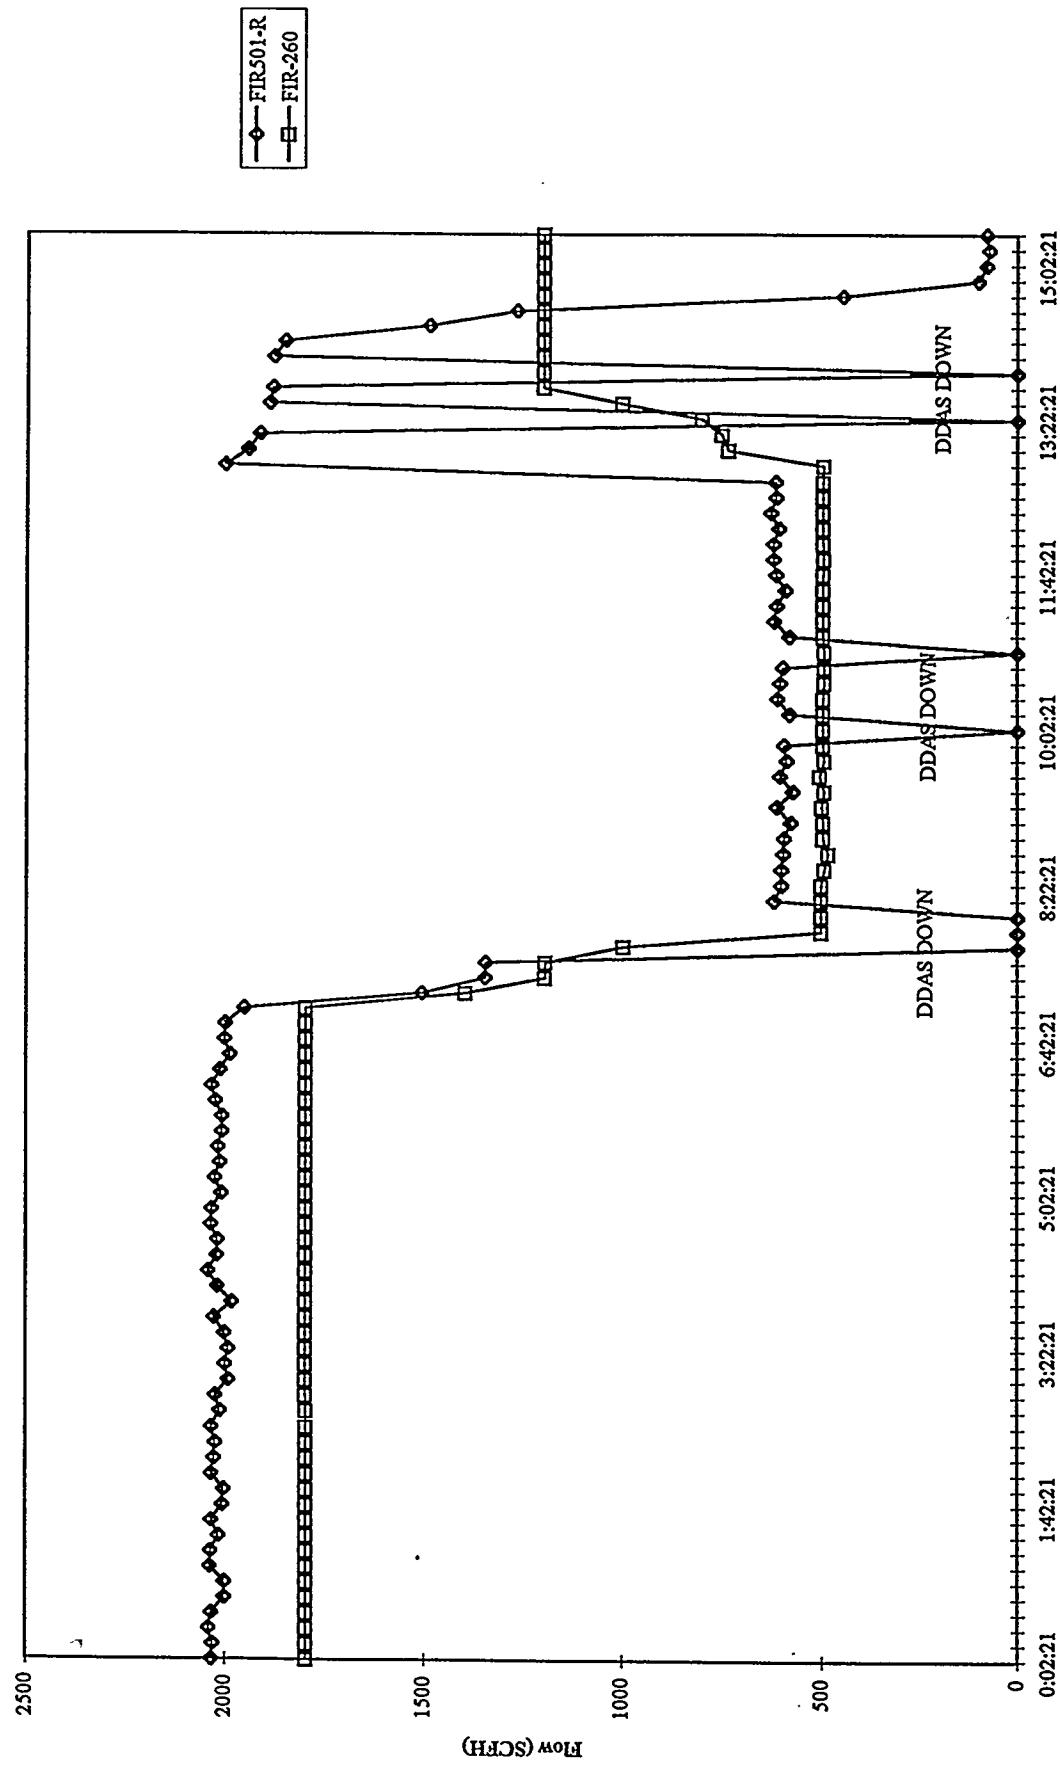


A3-12


MGCR PROCESS GAS LINE TEMPERATURES
94MGC07 - 06/06/94

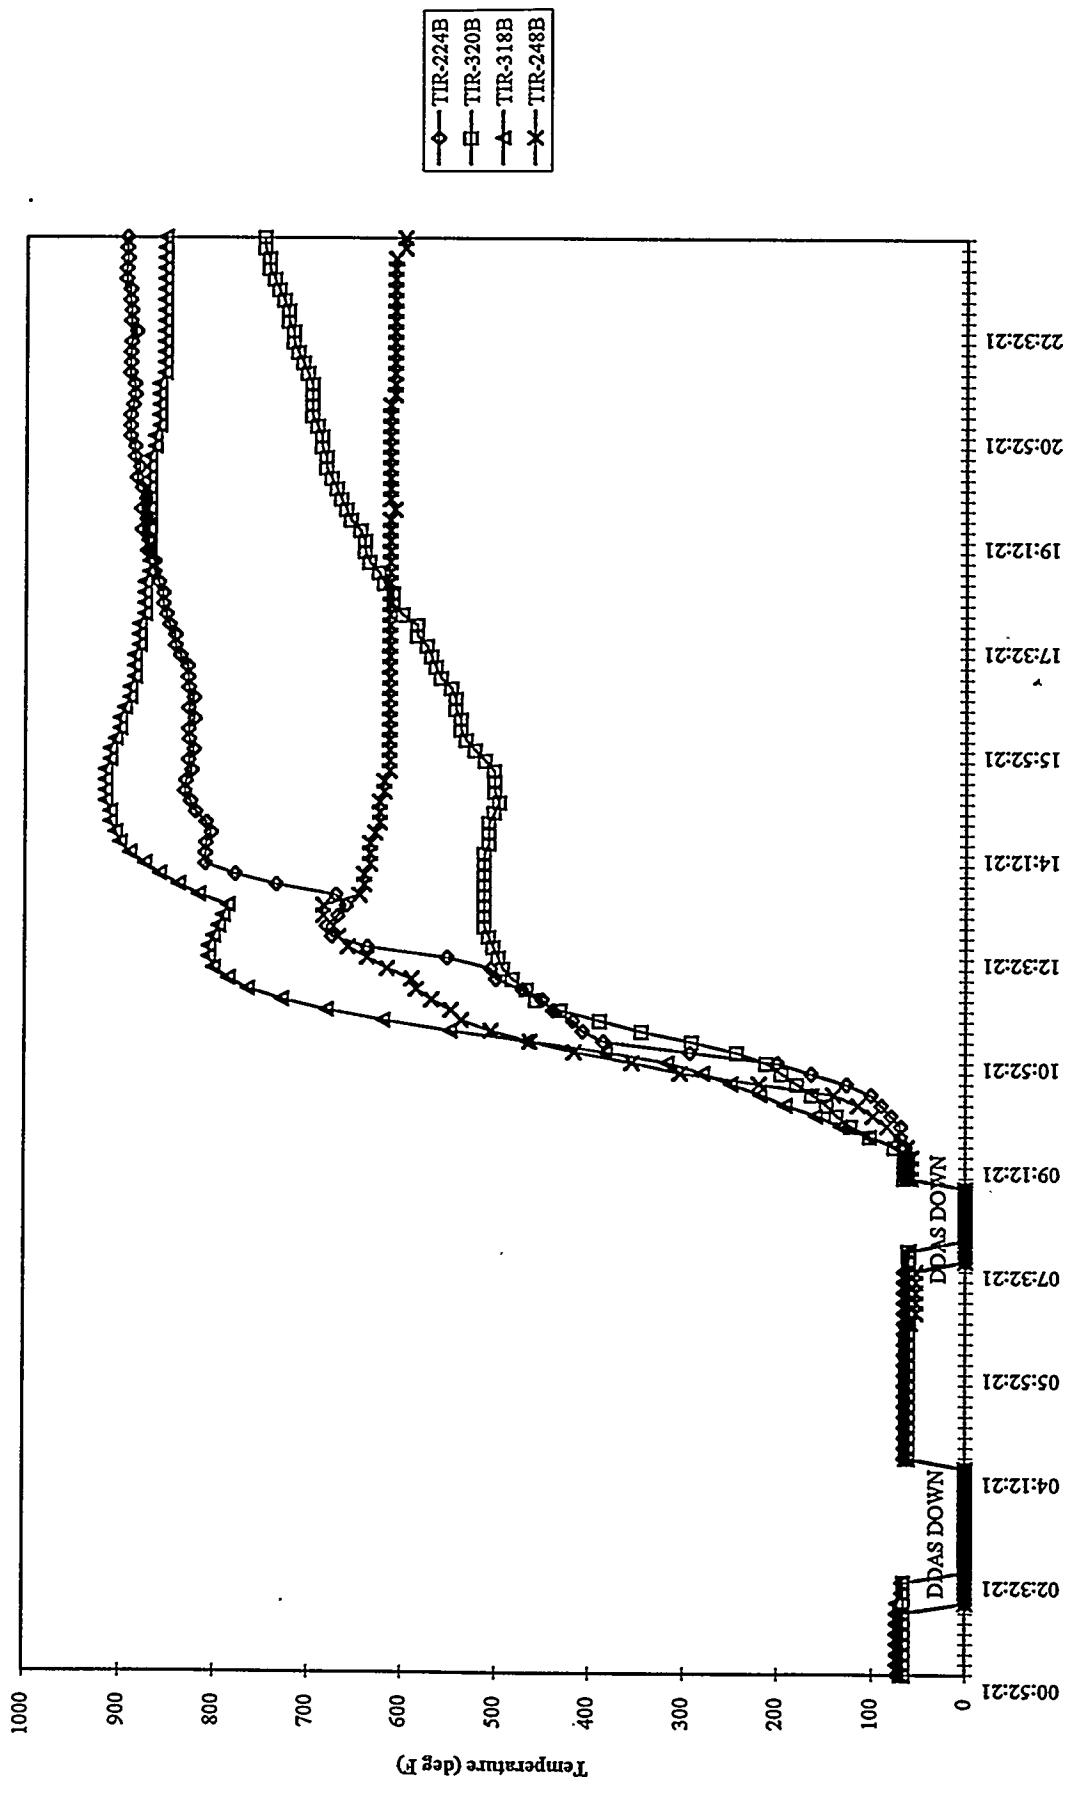


MGCR PROCESS GAS LINE TEMPERATURES
94MGC07 - 06/07/94

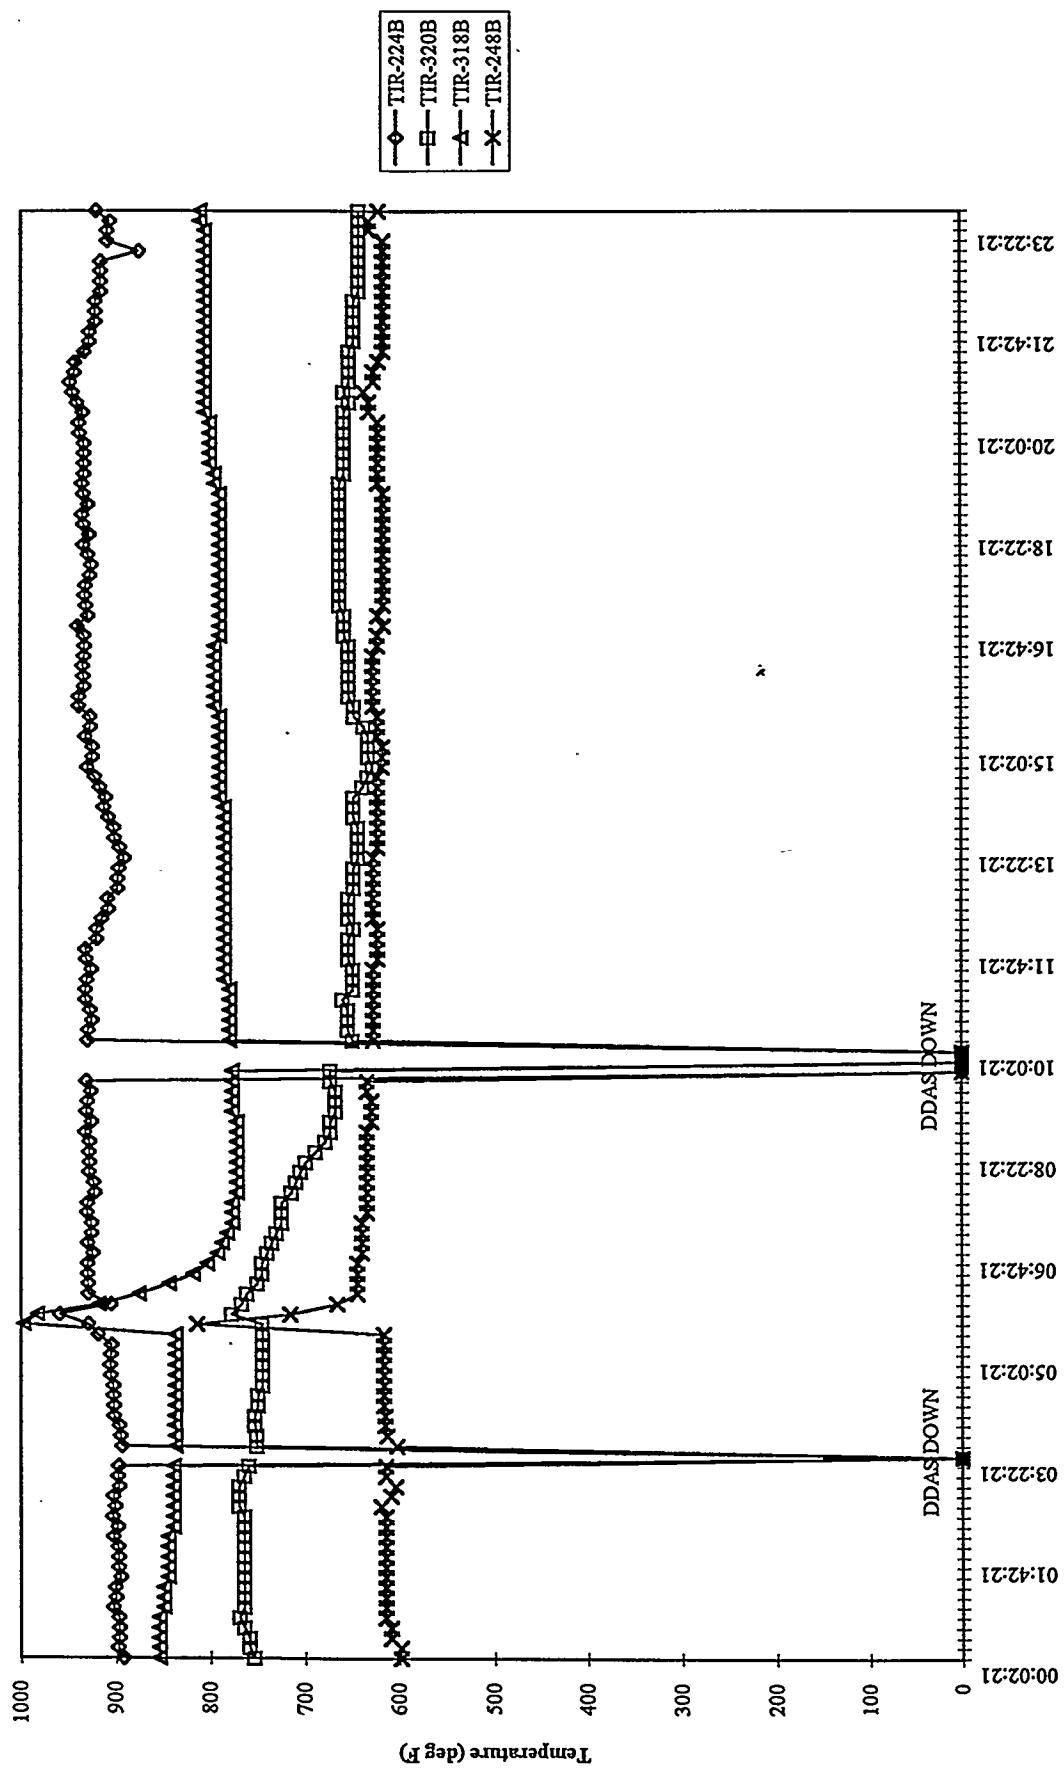


MGCR PROCESS GAS LINE TEMPERATURES
94MGC07 - 06/08/94

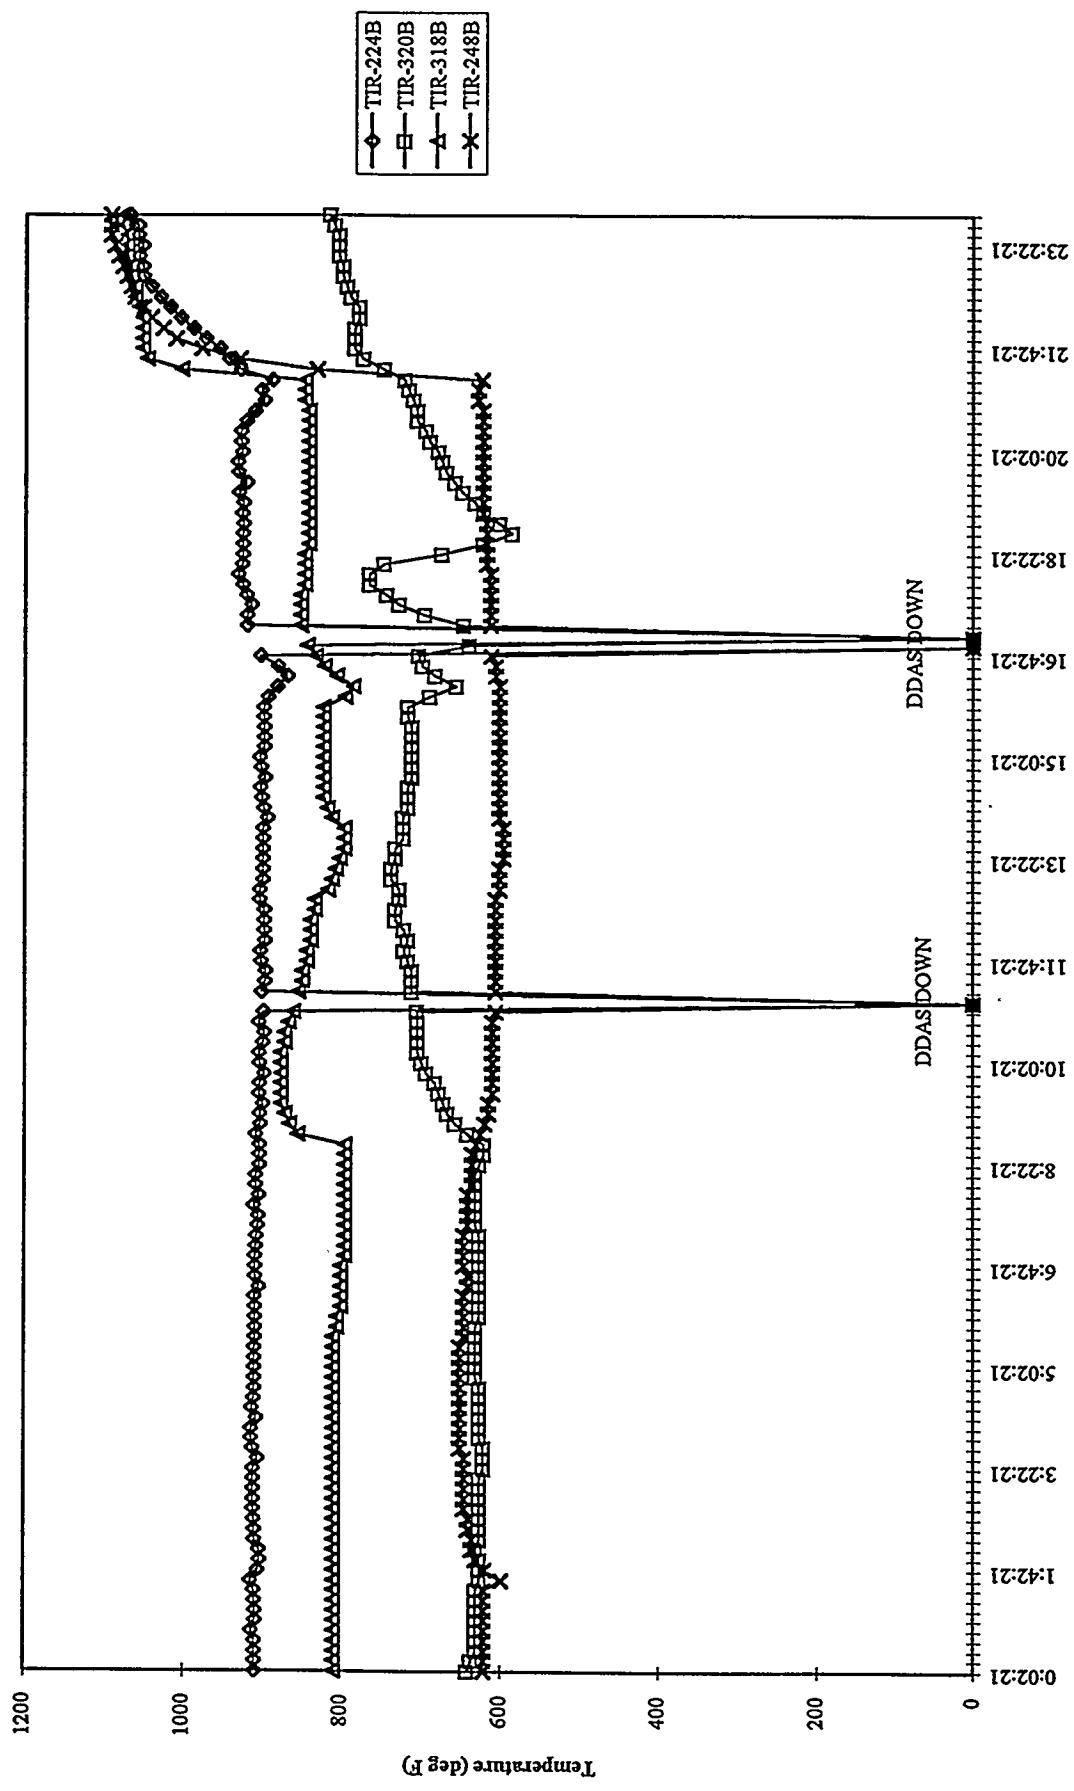


MGCR PROCESS GAS LINE TEMPERATURES
94MGC07 - 06/09/94

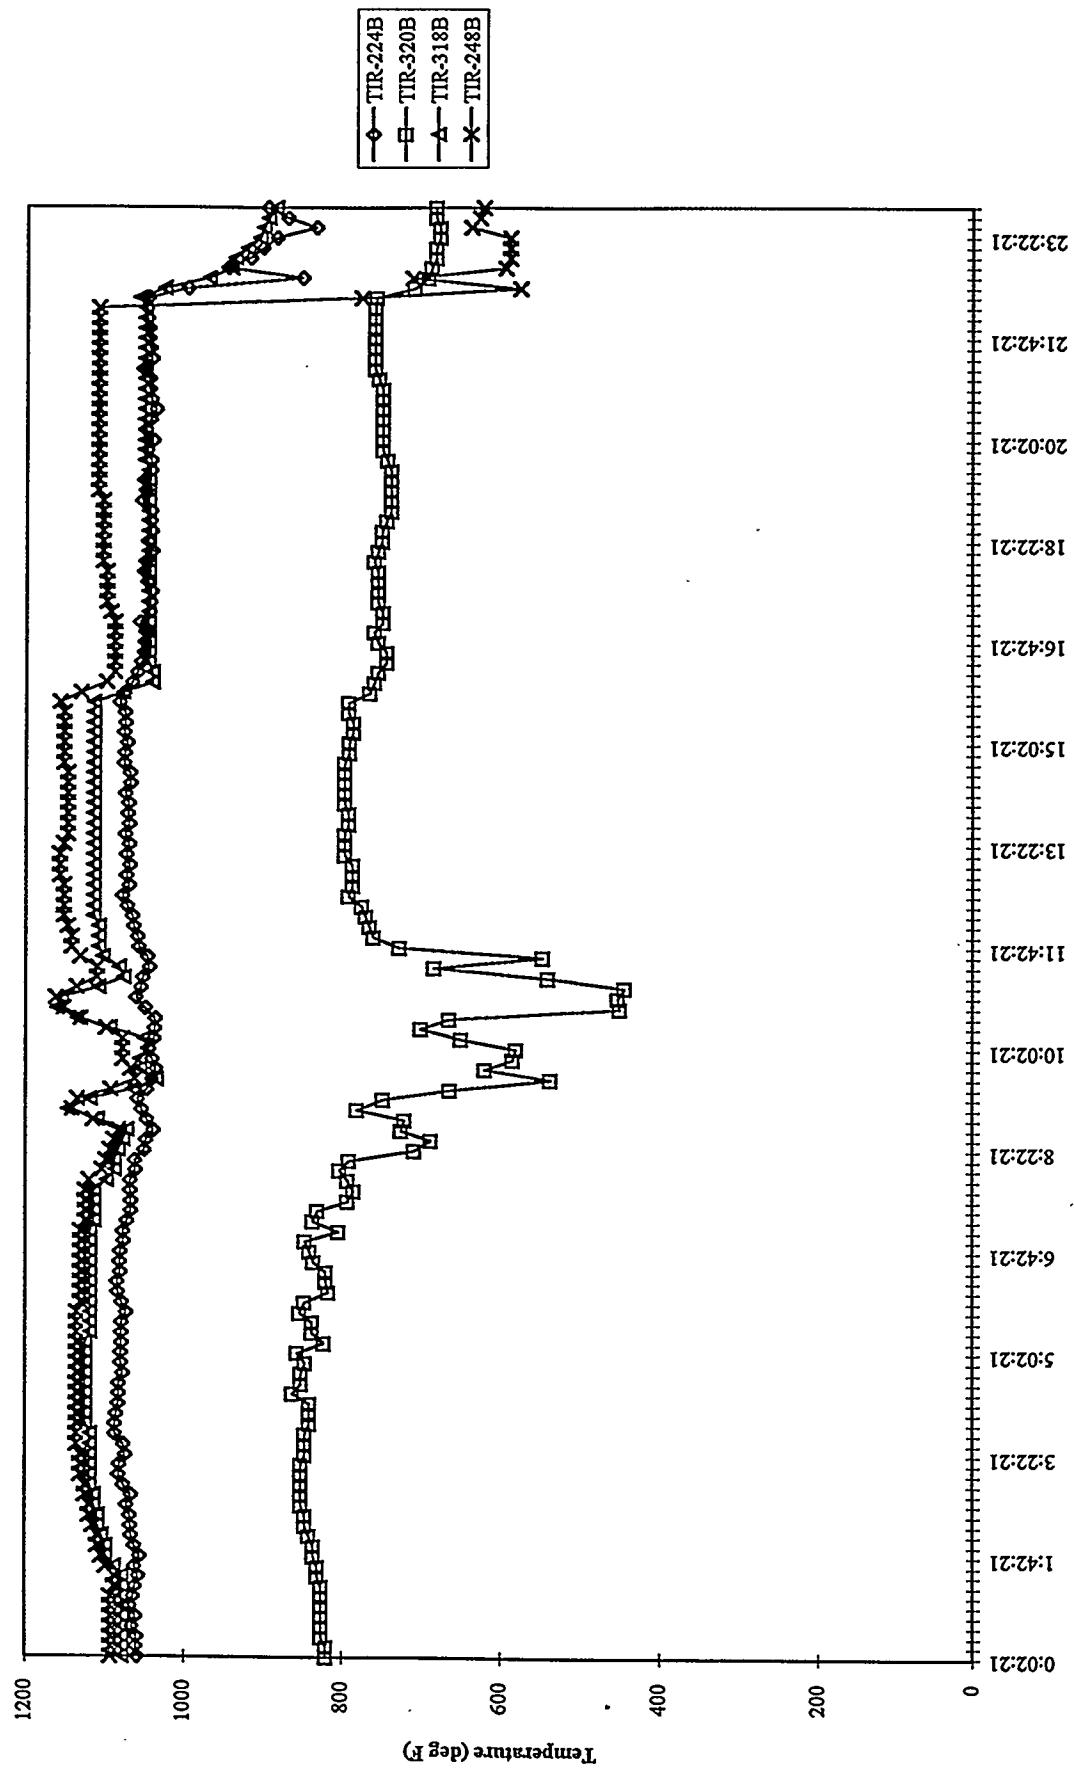


MGCR PROCESS GAS LINE TEMPERATURES
94MGC07 - 06/10/94

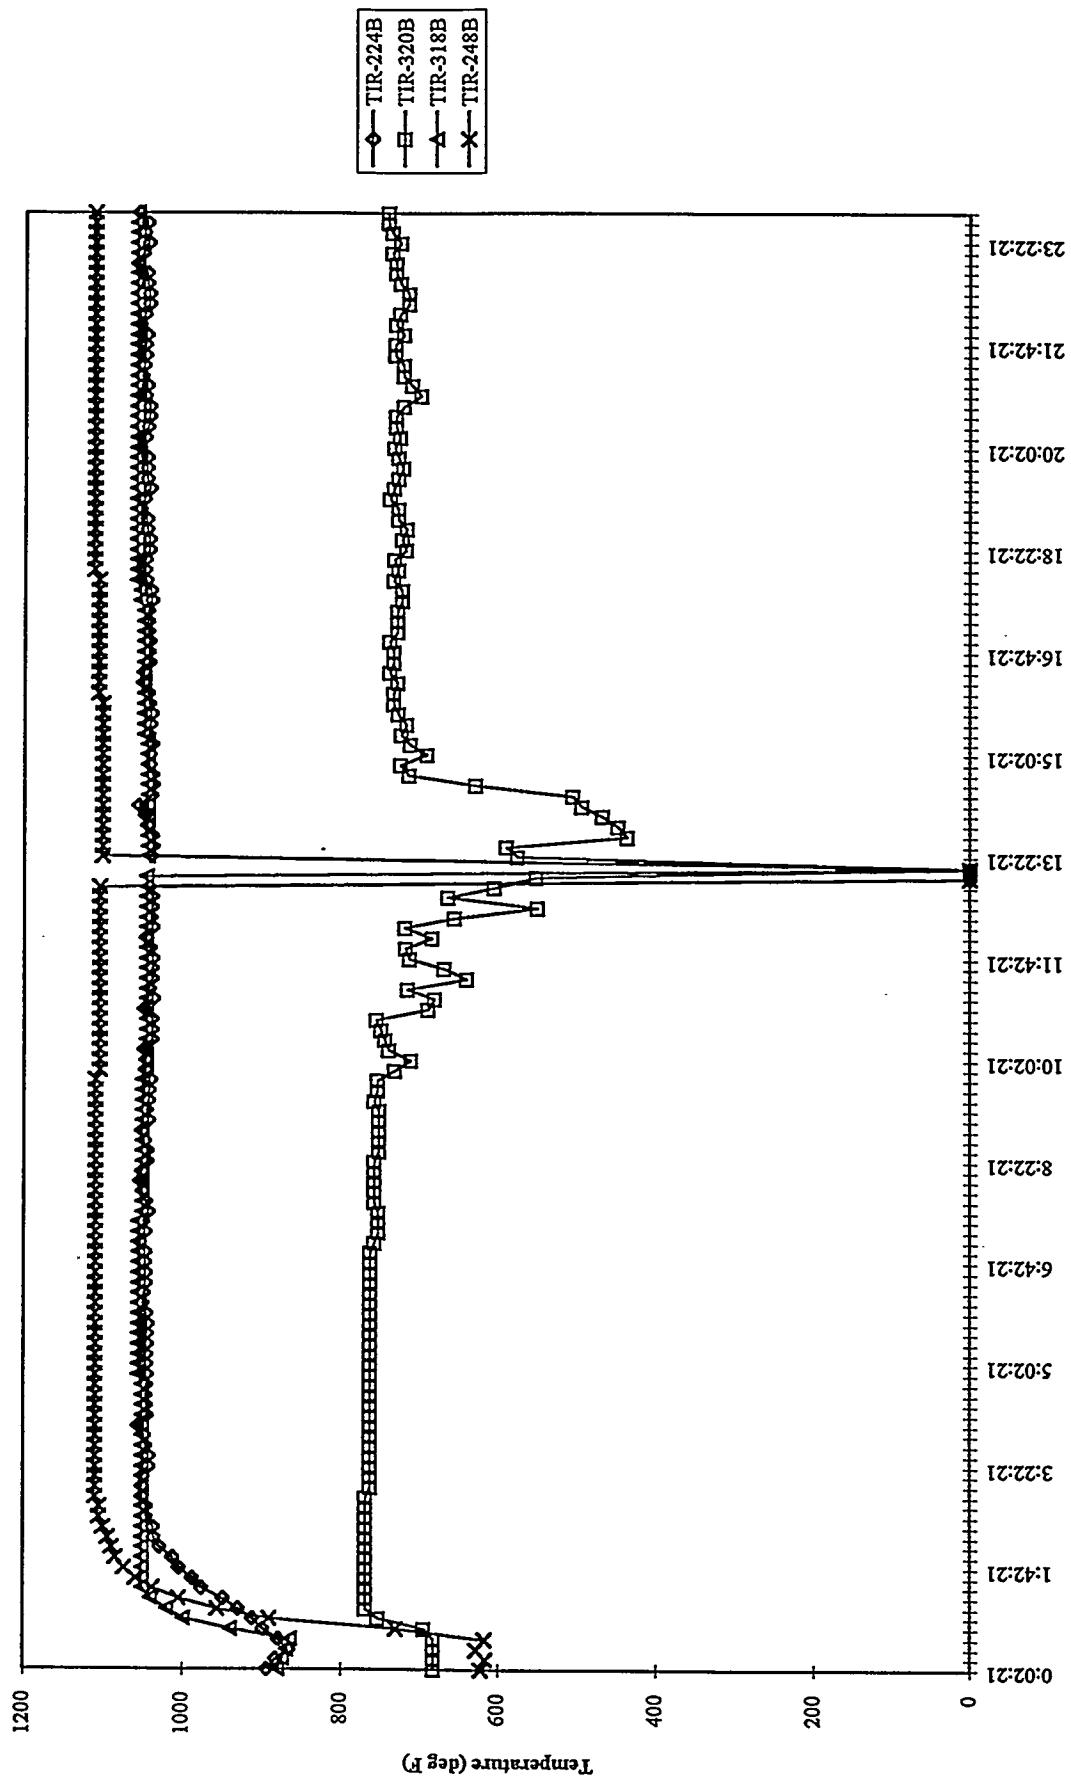


MGCR PROCESS GAS LINE TEMPERATURES
94MGC07 - 06/11/94

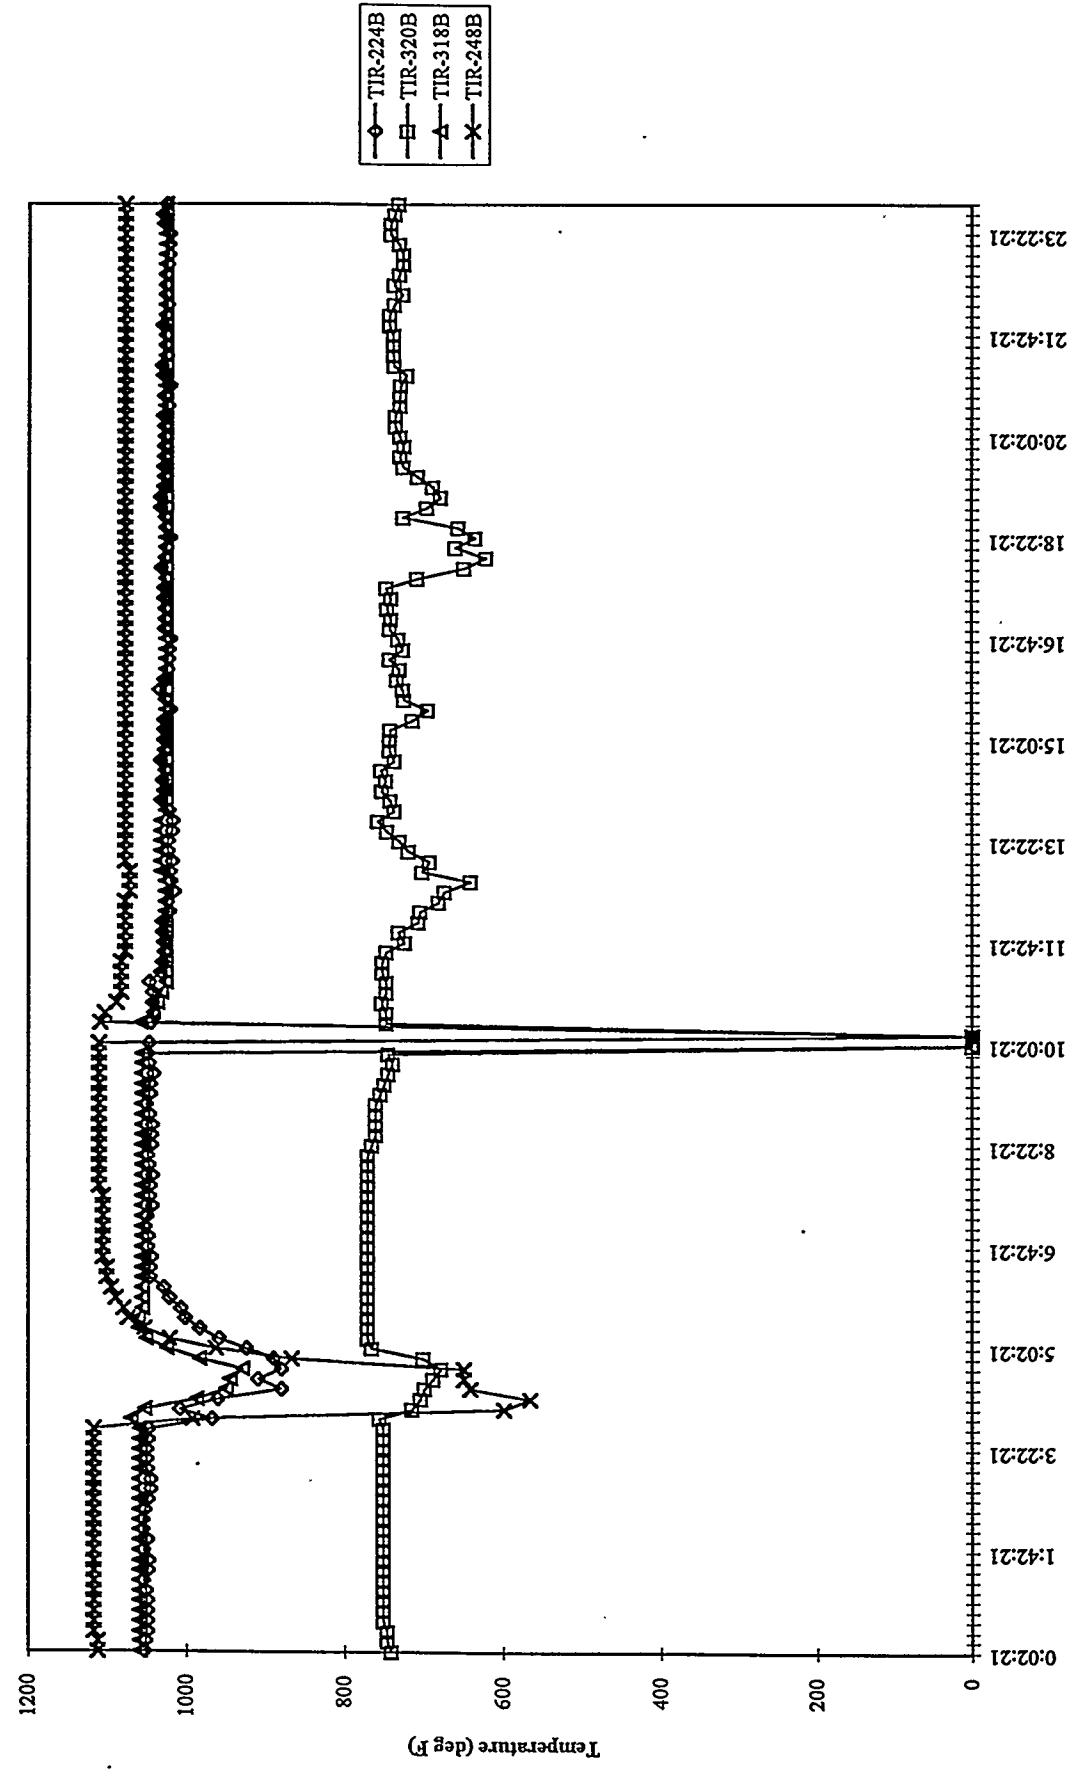


MGCR PROCESS GAS LINE TEMPERATURES
94MGC07 - 06/12/94

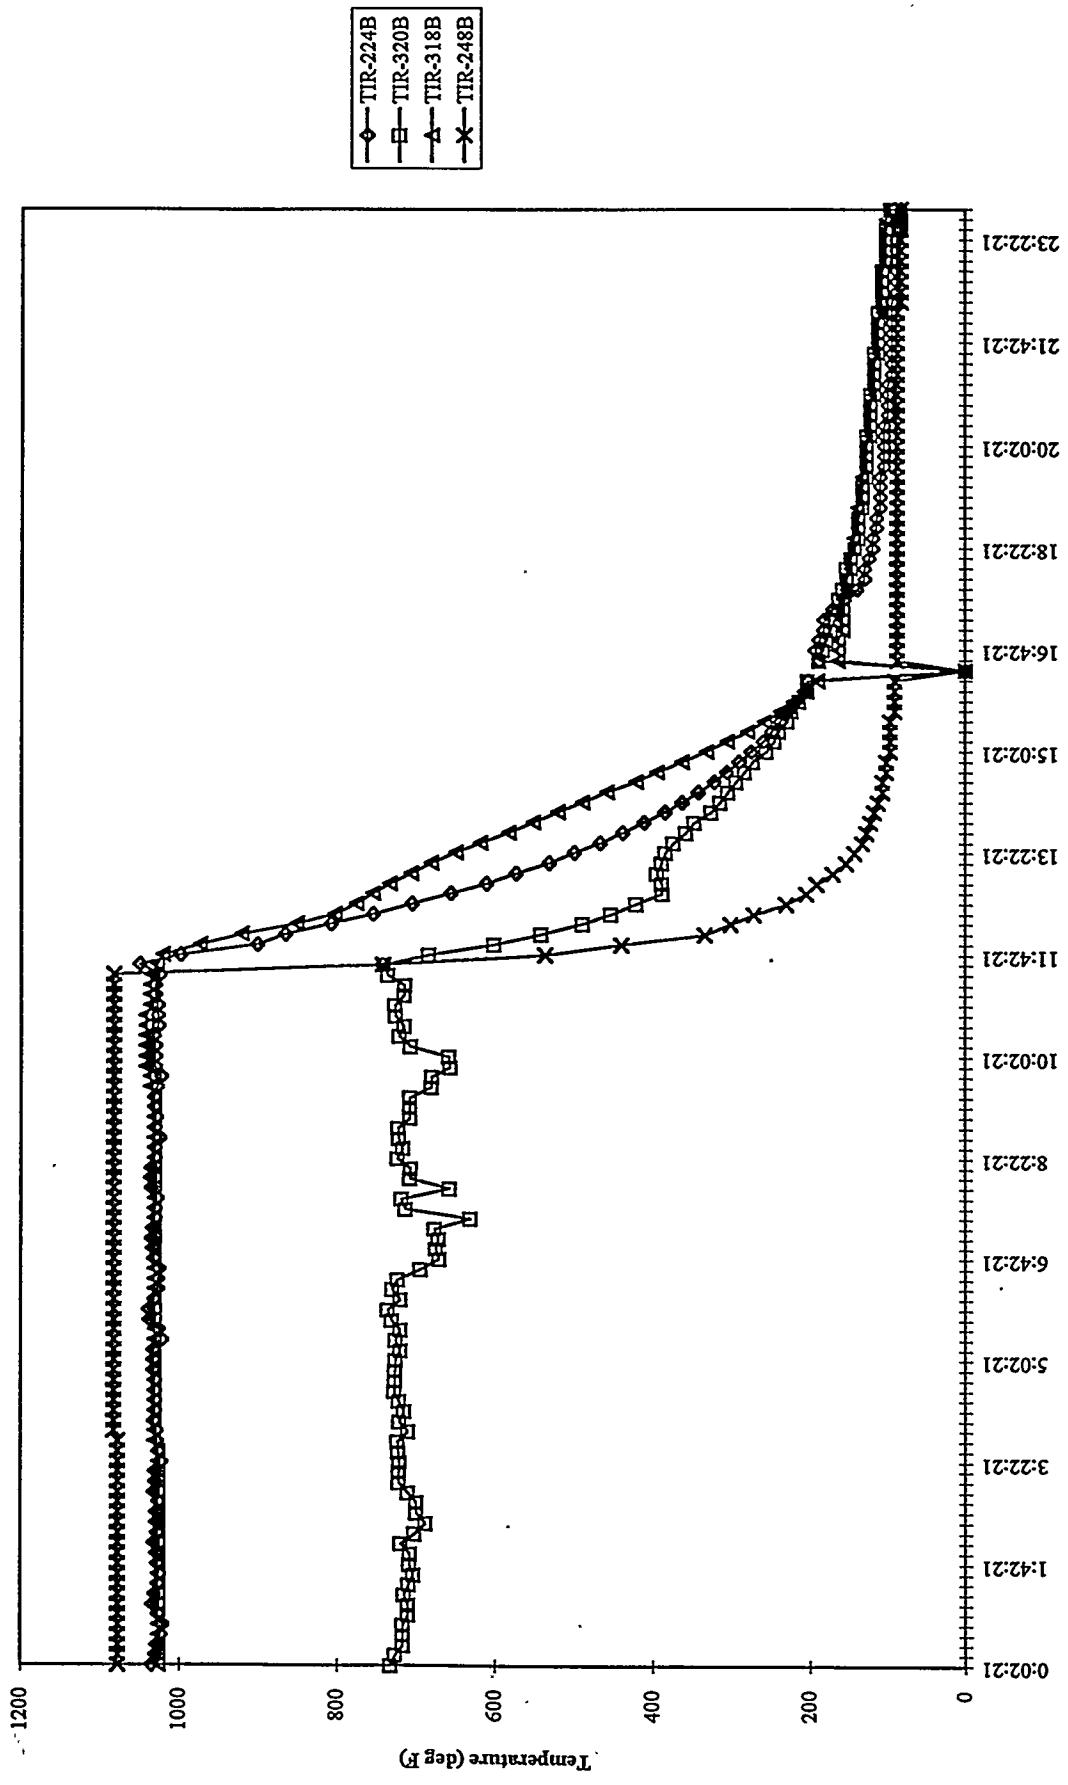


MGCR PROCESS GAS LINE TEMPERATURES
94MGC07 - 06/13/94

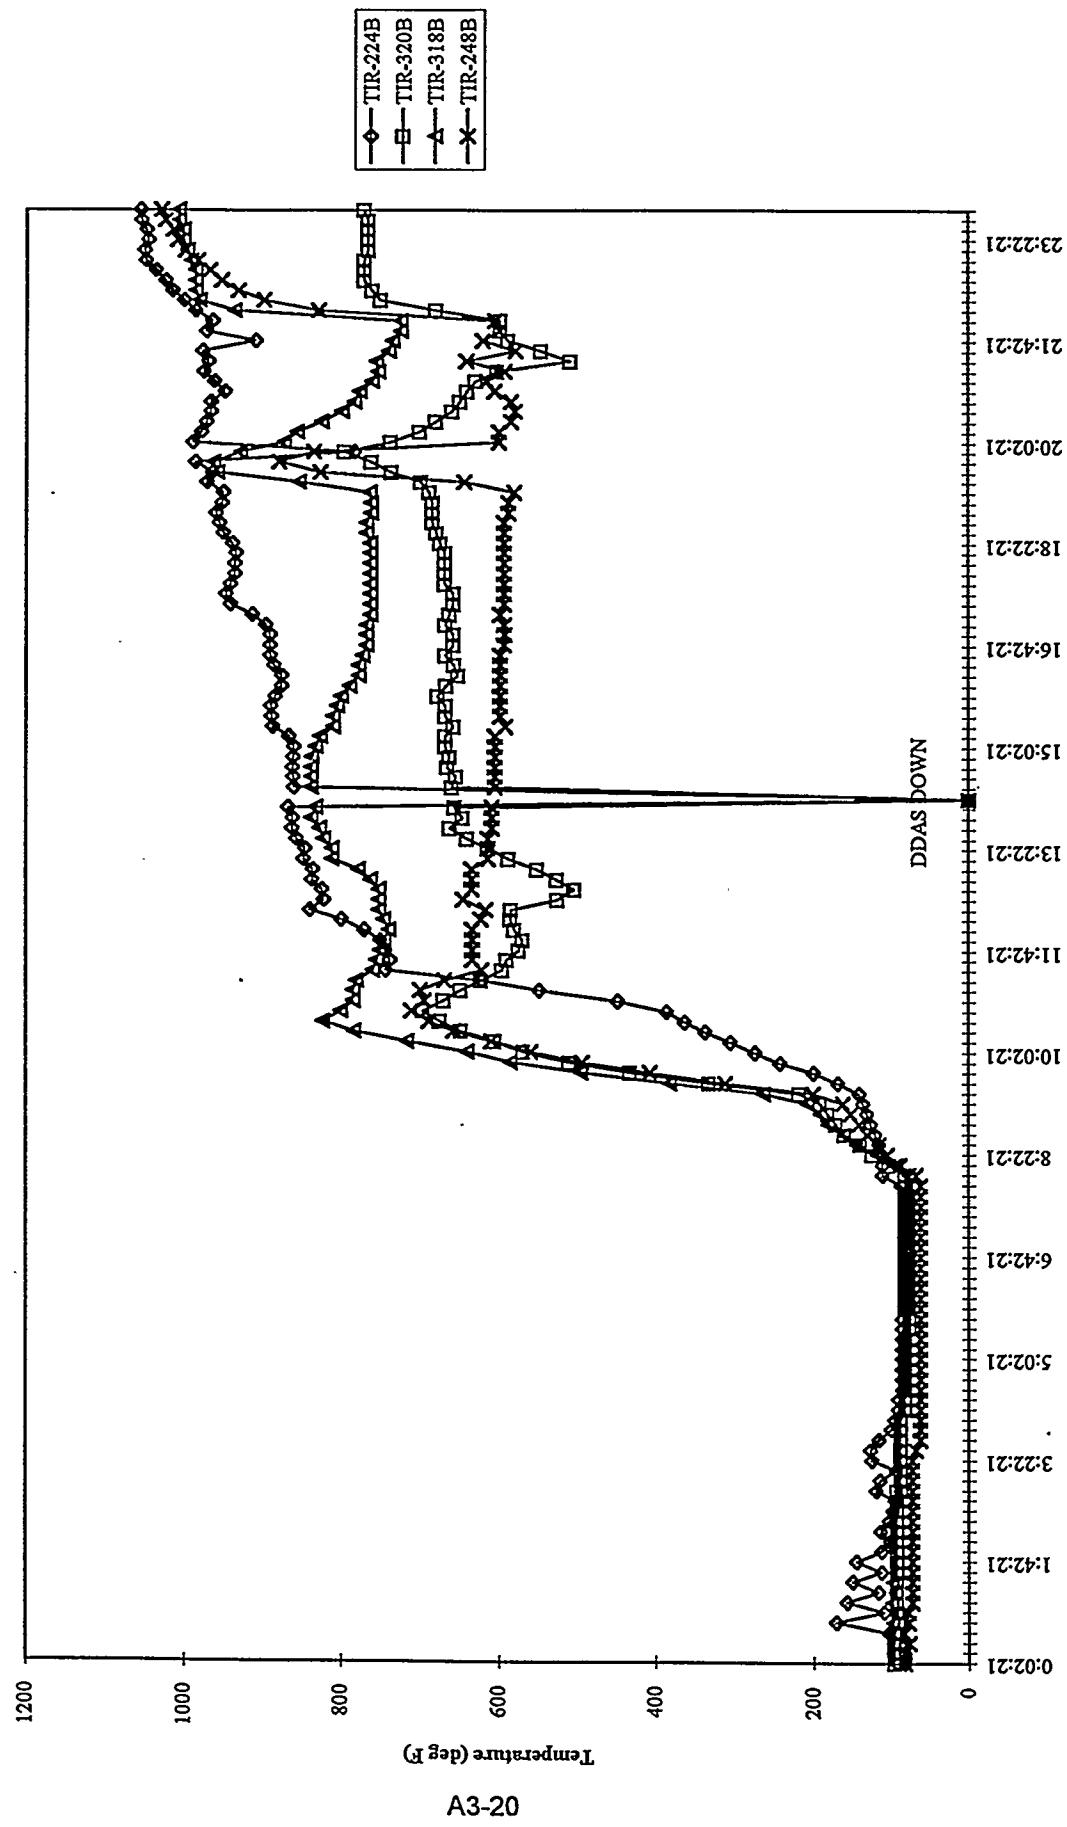


MGCR PROCESS GAS LINE TEMPERATURES
94MGC07 - 06/14/94

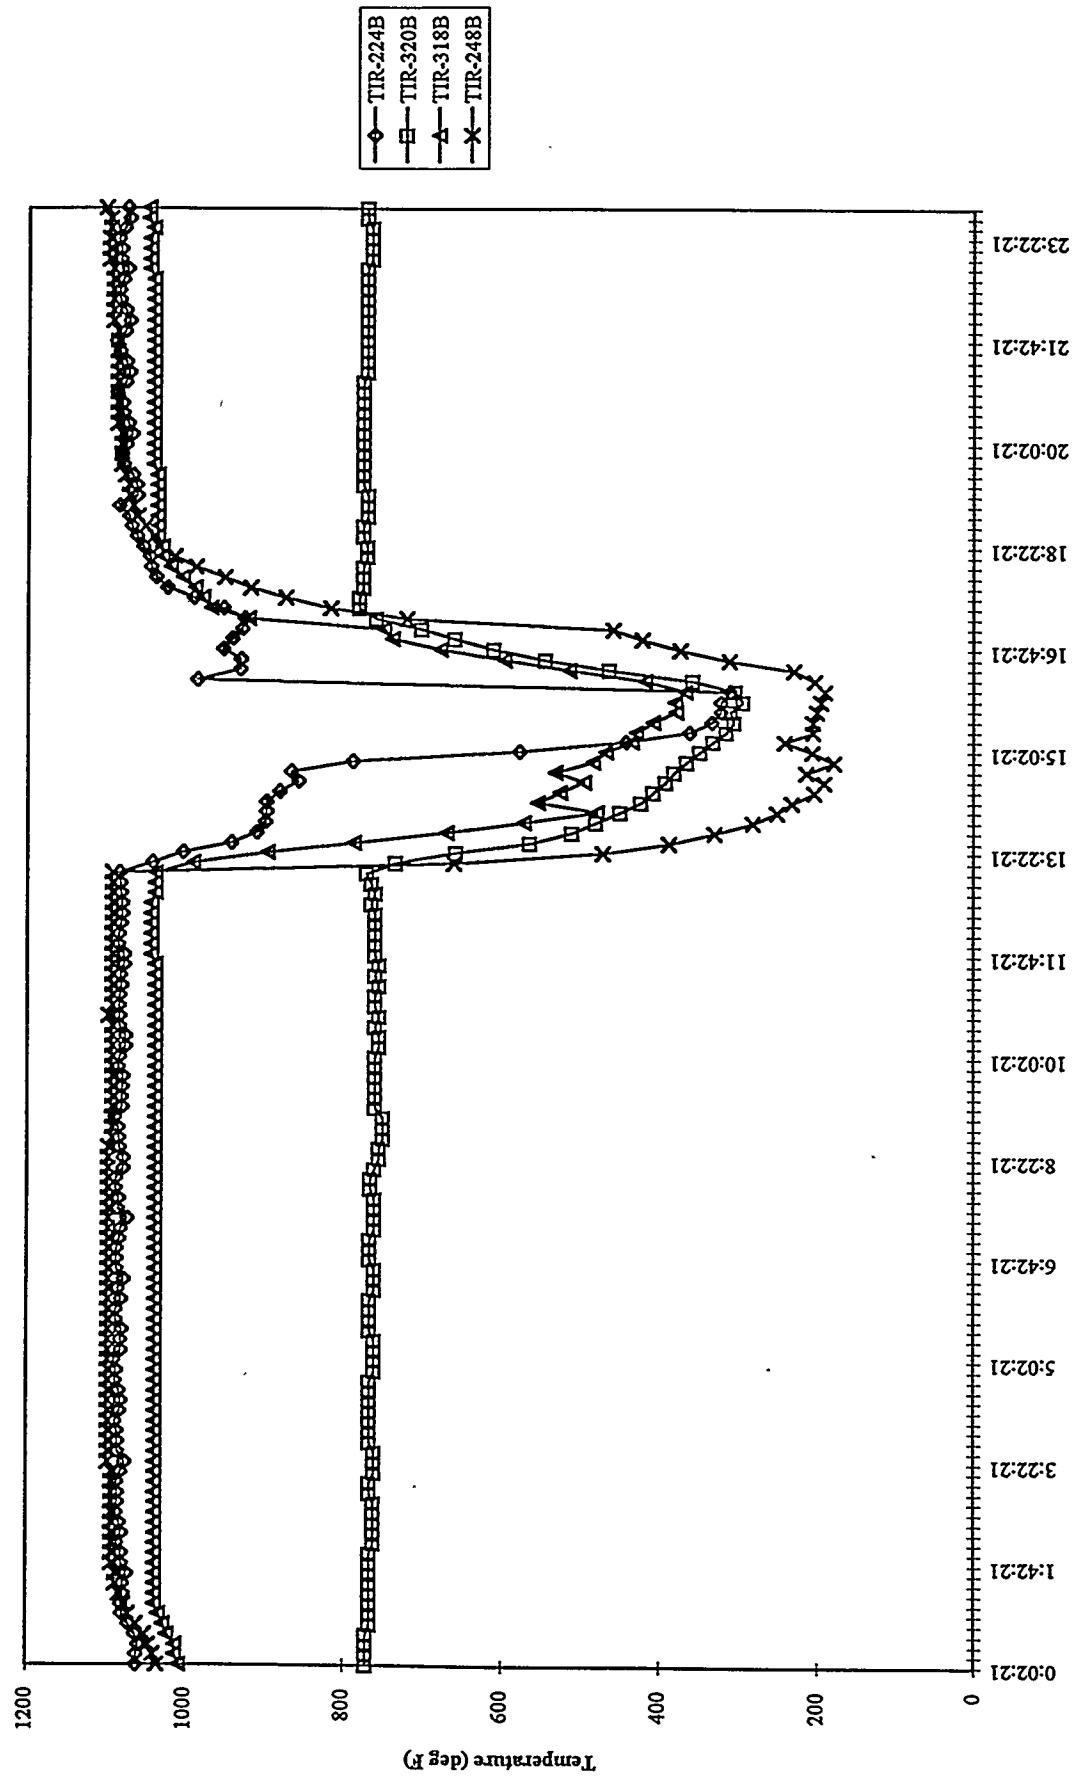


MGCR PROCESS GAS LINE TEMPERATURES
94MGC07 - 06/15/94

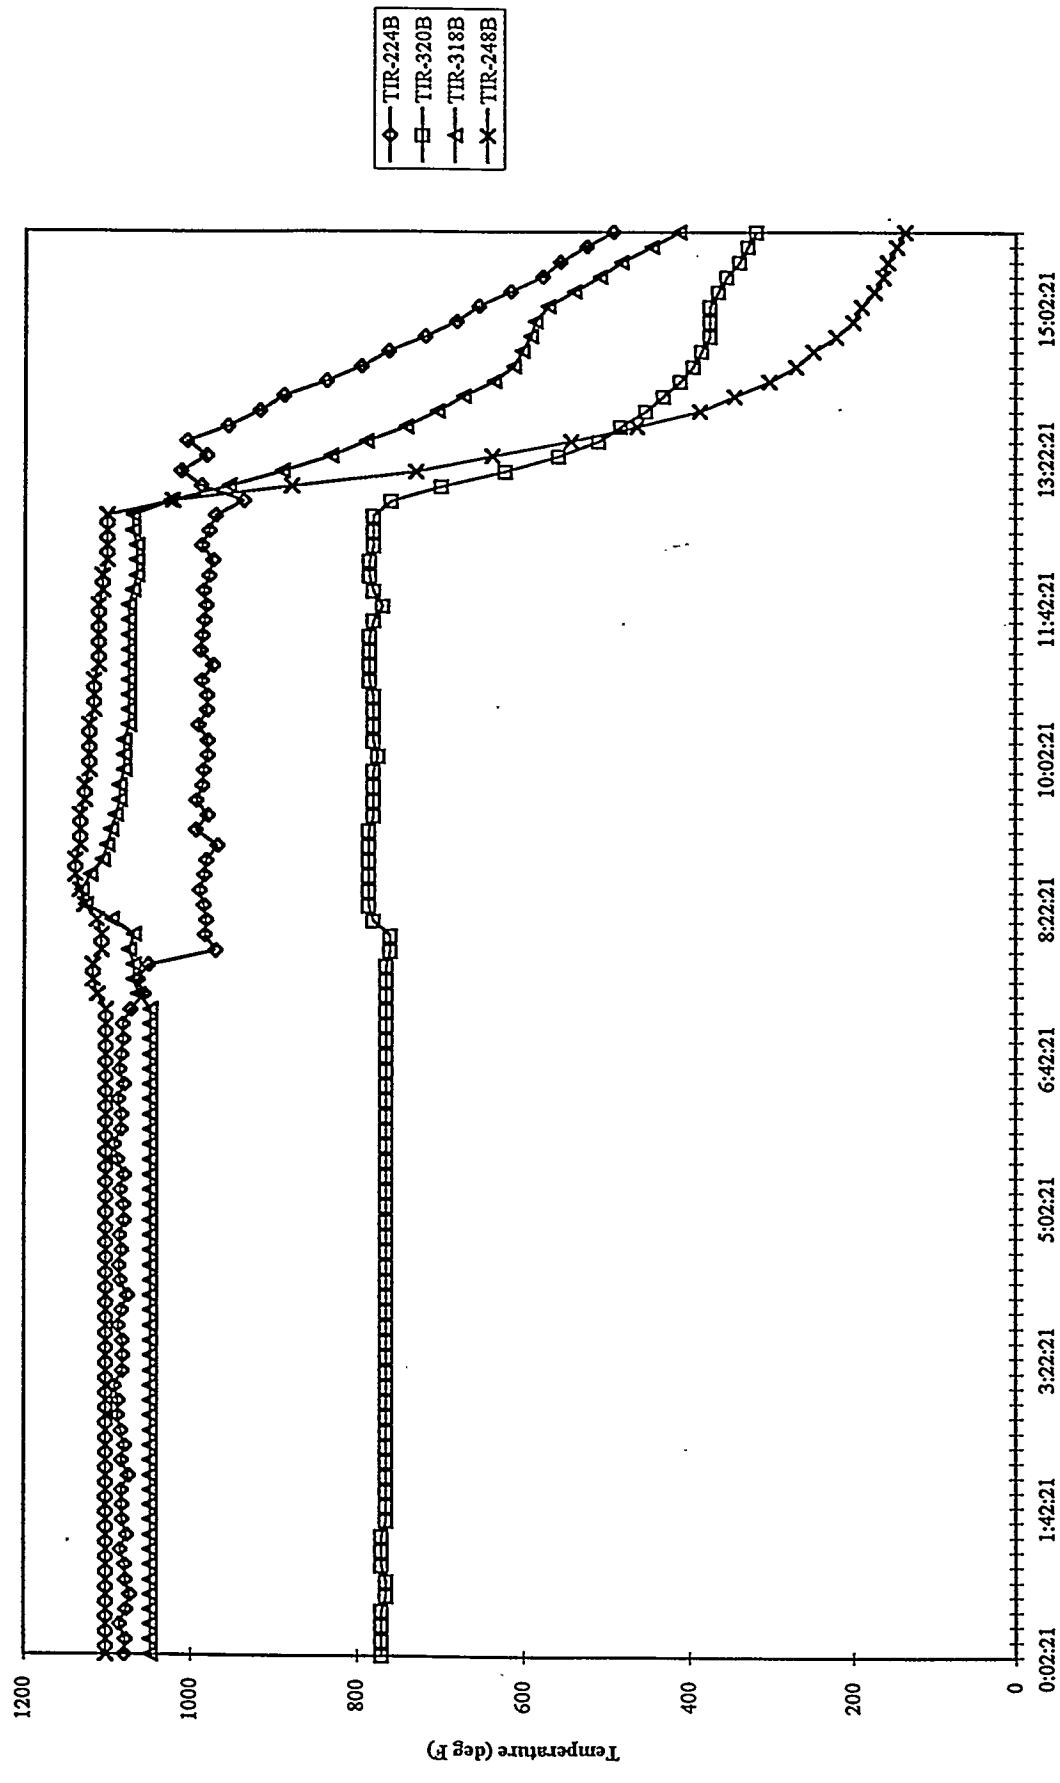

FBG & MGCR PROCESS PRESSURES
94FBCG07 - 94MGC07 - 06/06/94

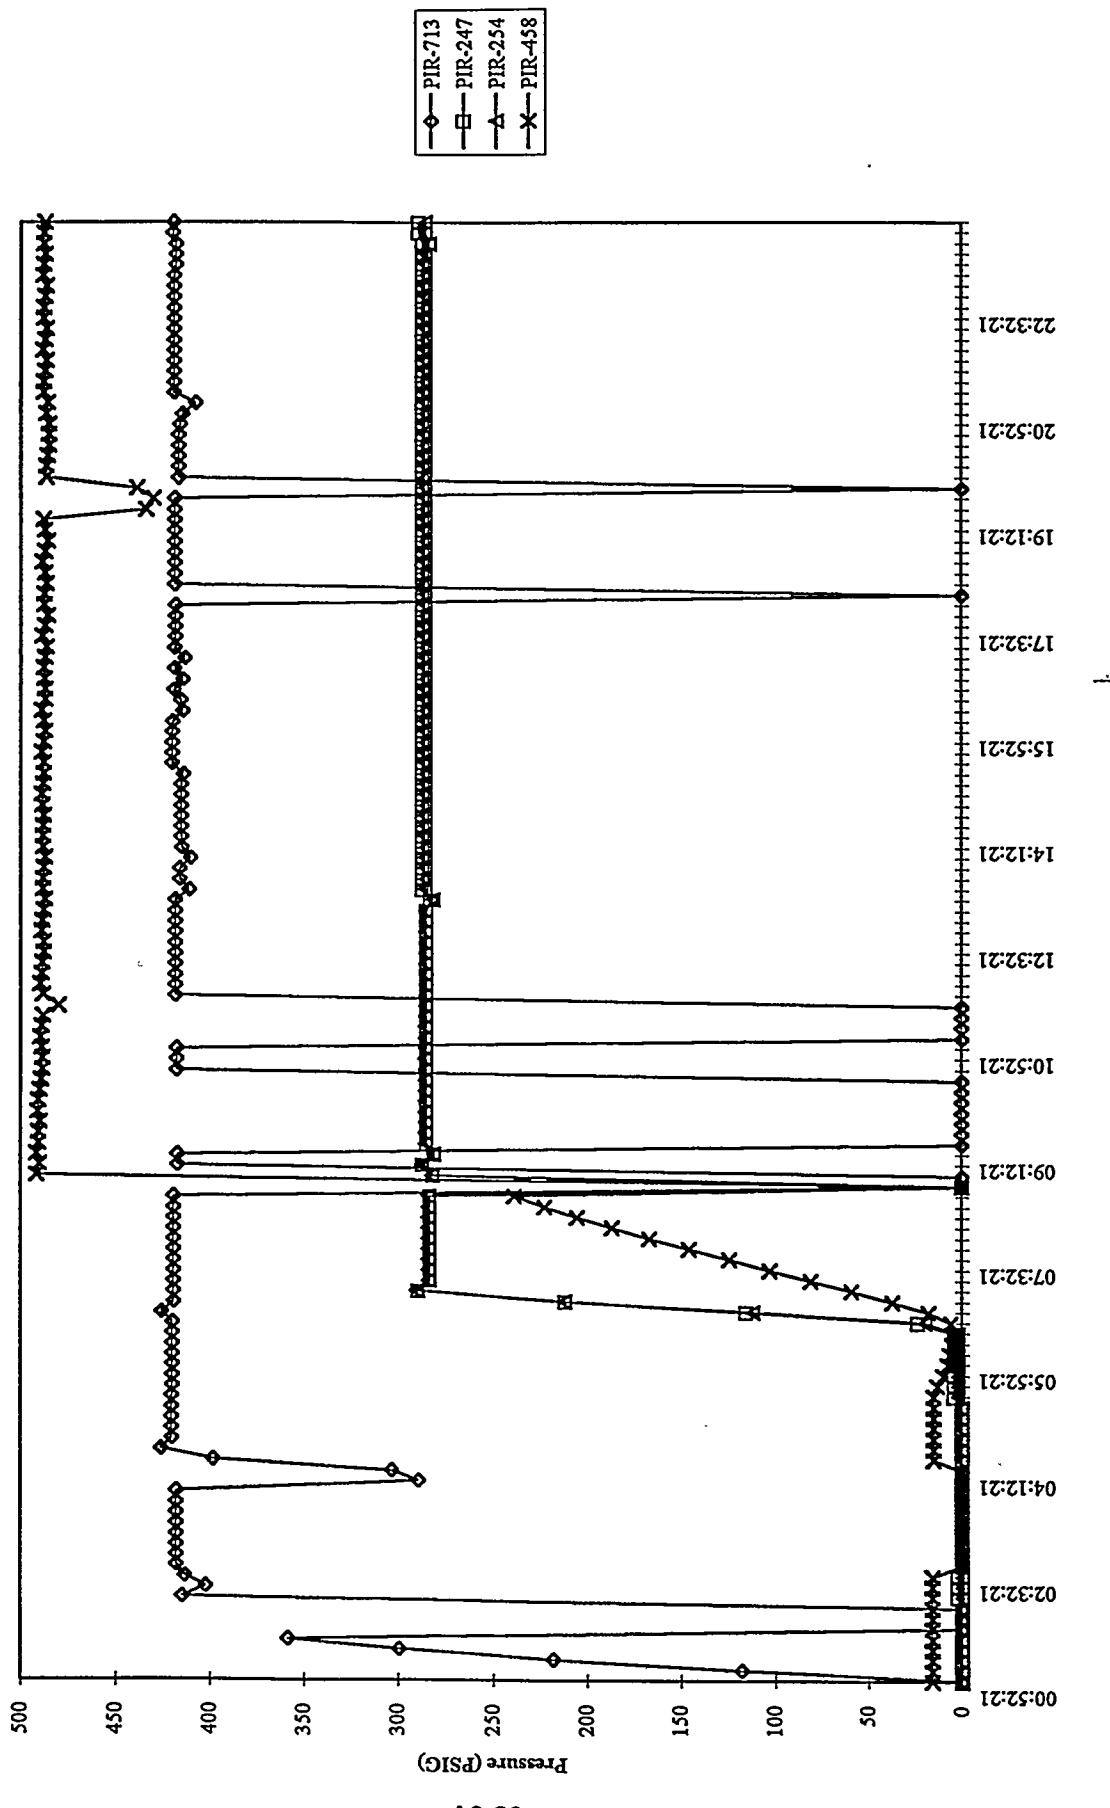

FBG & MGCR PROCESS PRESSURES
94FBG07 - 94MGC07 - 06/07/94

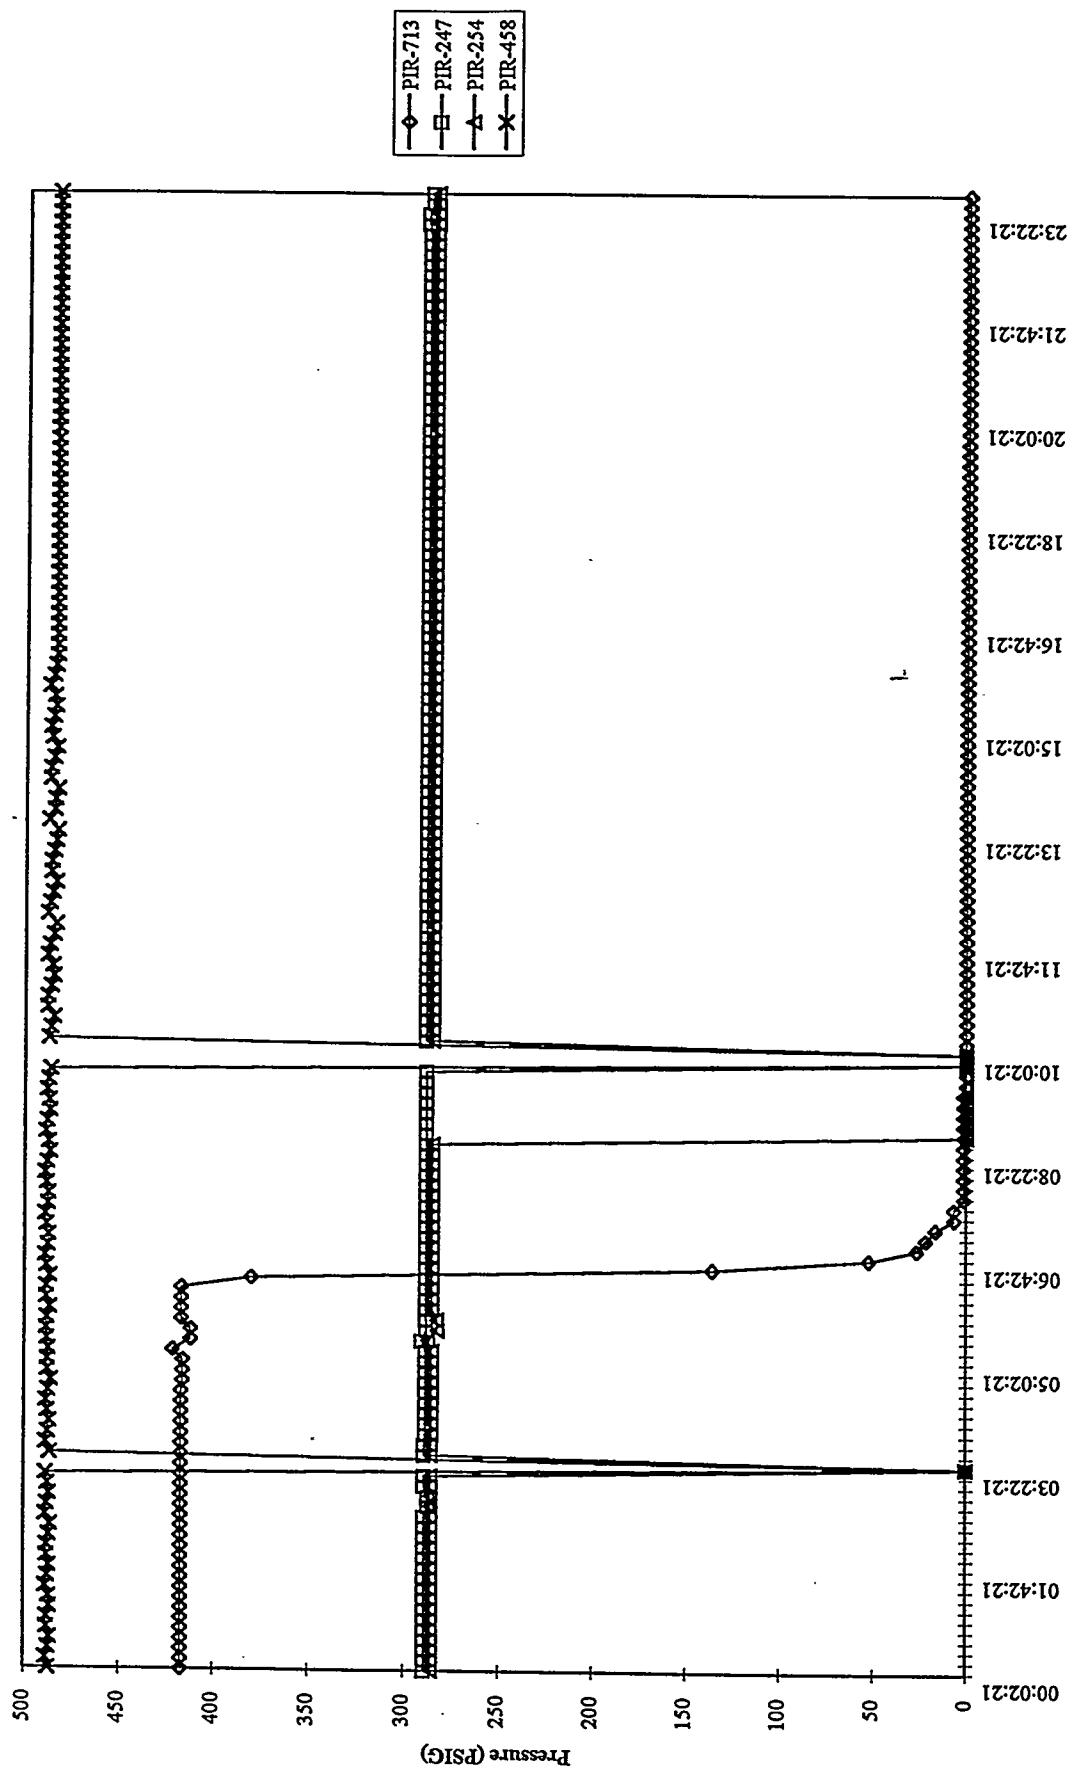

FBCG & MGCR PROCESS PRESSURES
94FBCG07 - 94MGC07 - 06/08/94

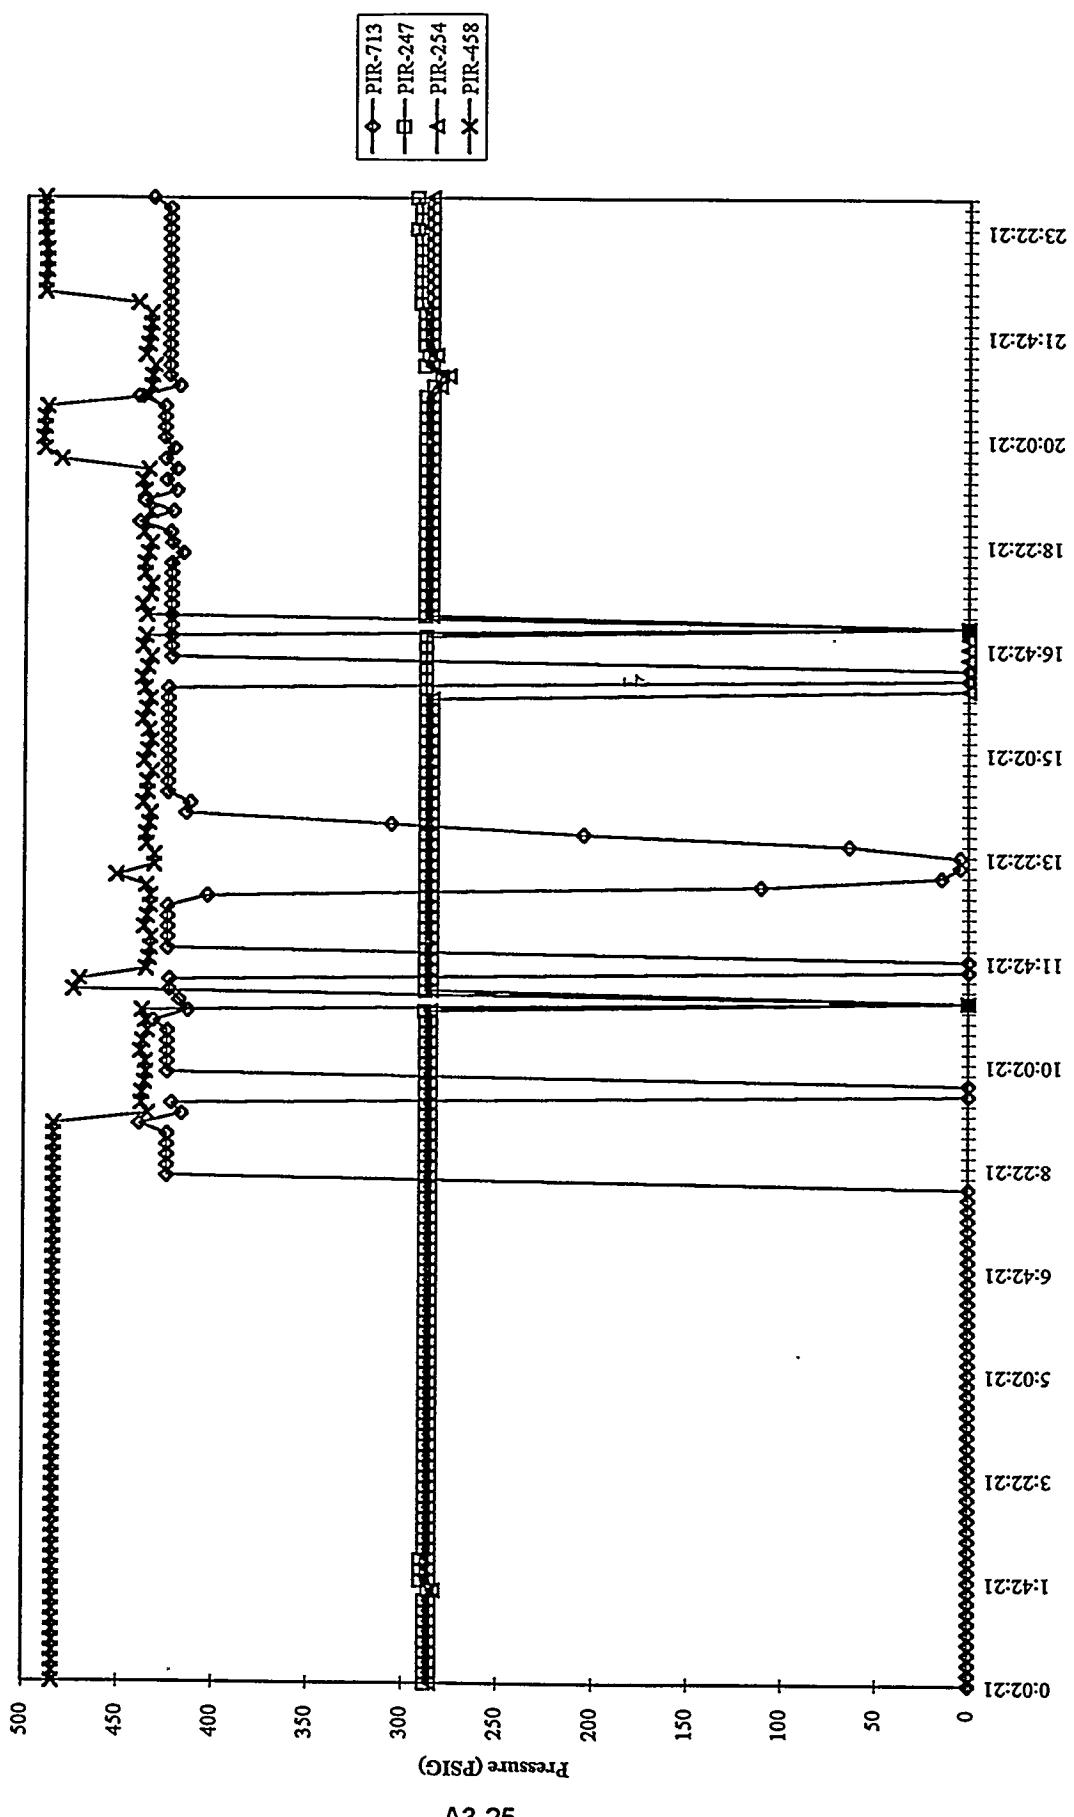


Chart1 (4)

FBG & MGCR PROCESS PRESSURE
RUN 07, 06/09/94

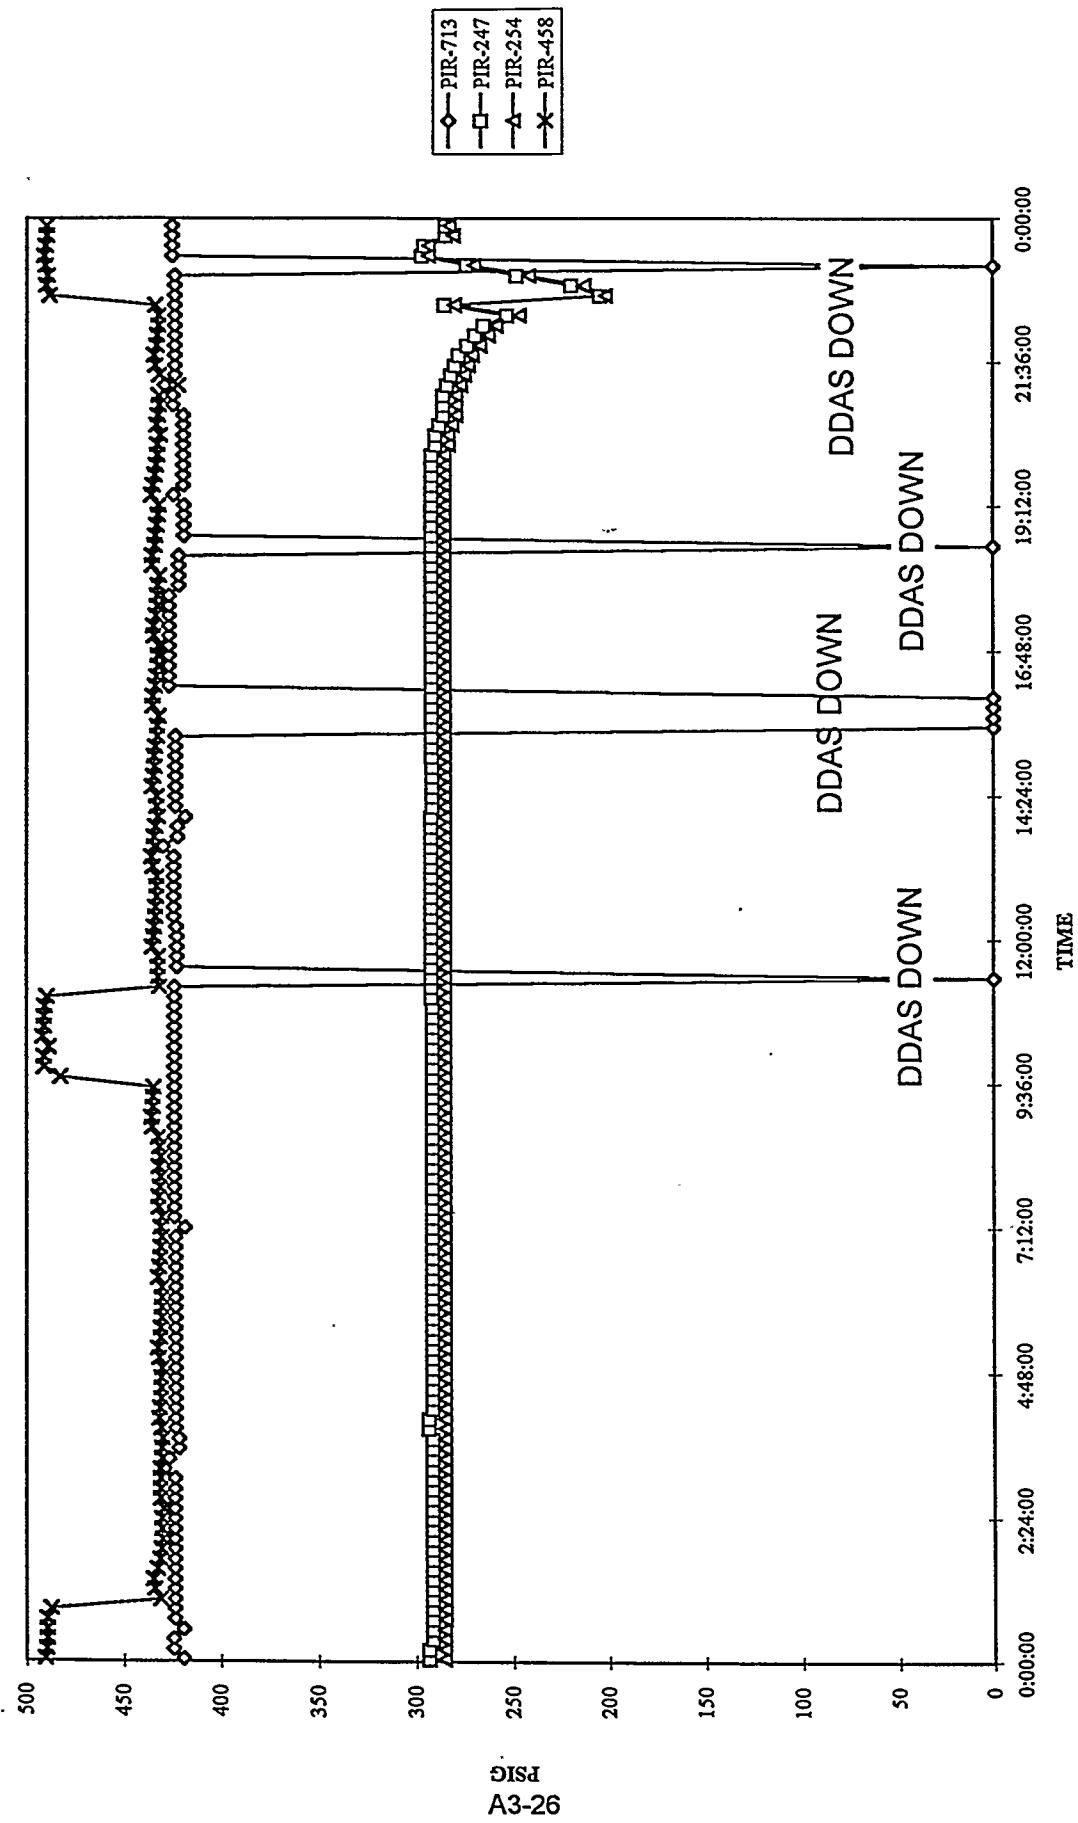


Chart1 (5)

FBG & MGCR PROCESS PRESSURE
RUN 07, 06/10/94


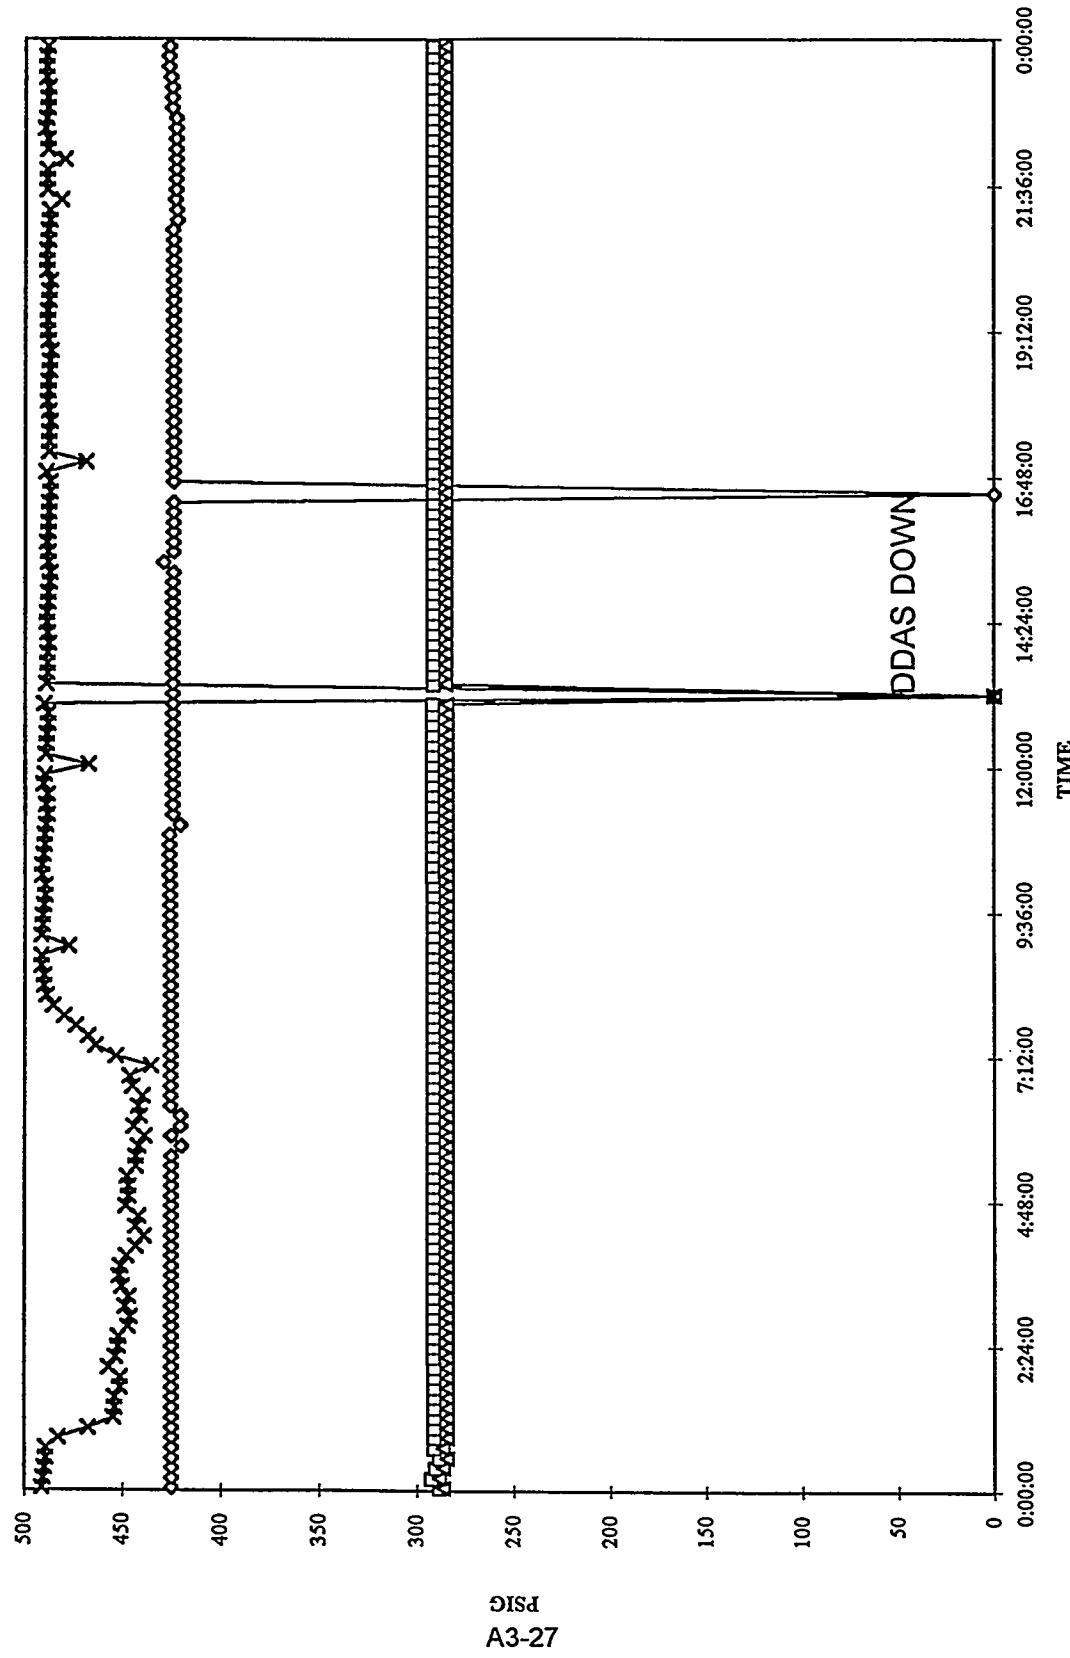



Chart1 (6)

FBG & MGCR PROCESS PRESSURE
RUN 07, 06/11/94

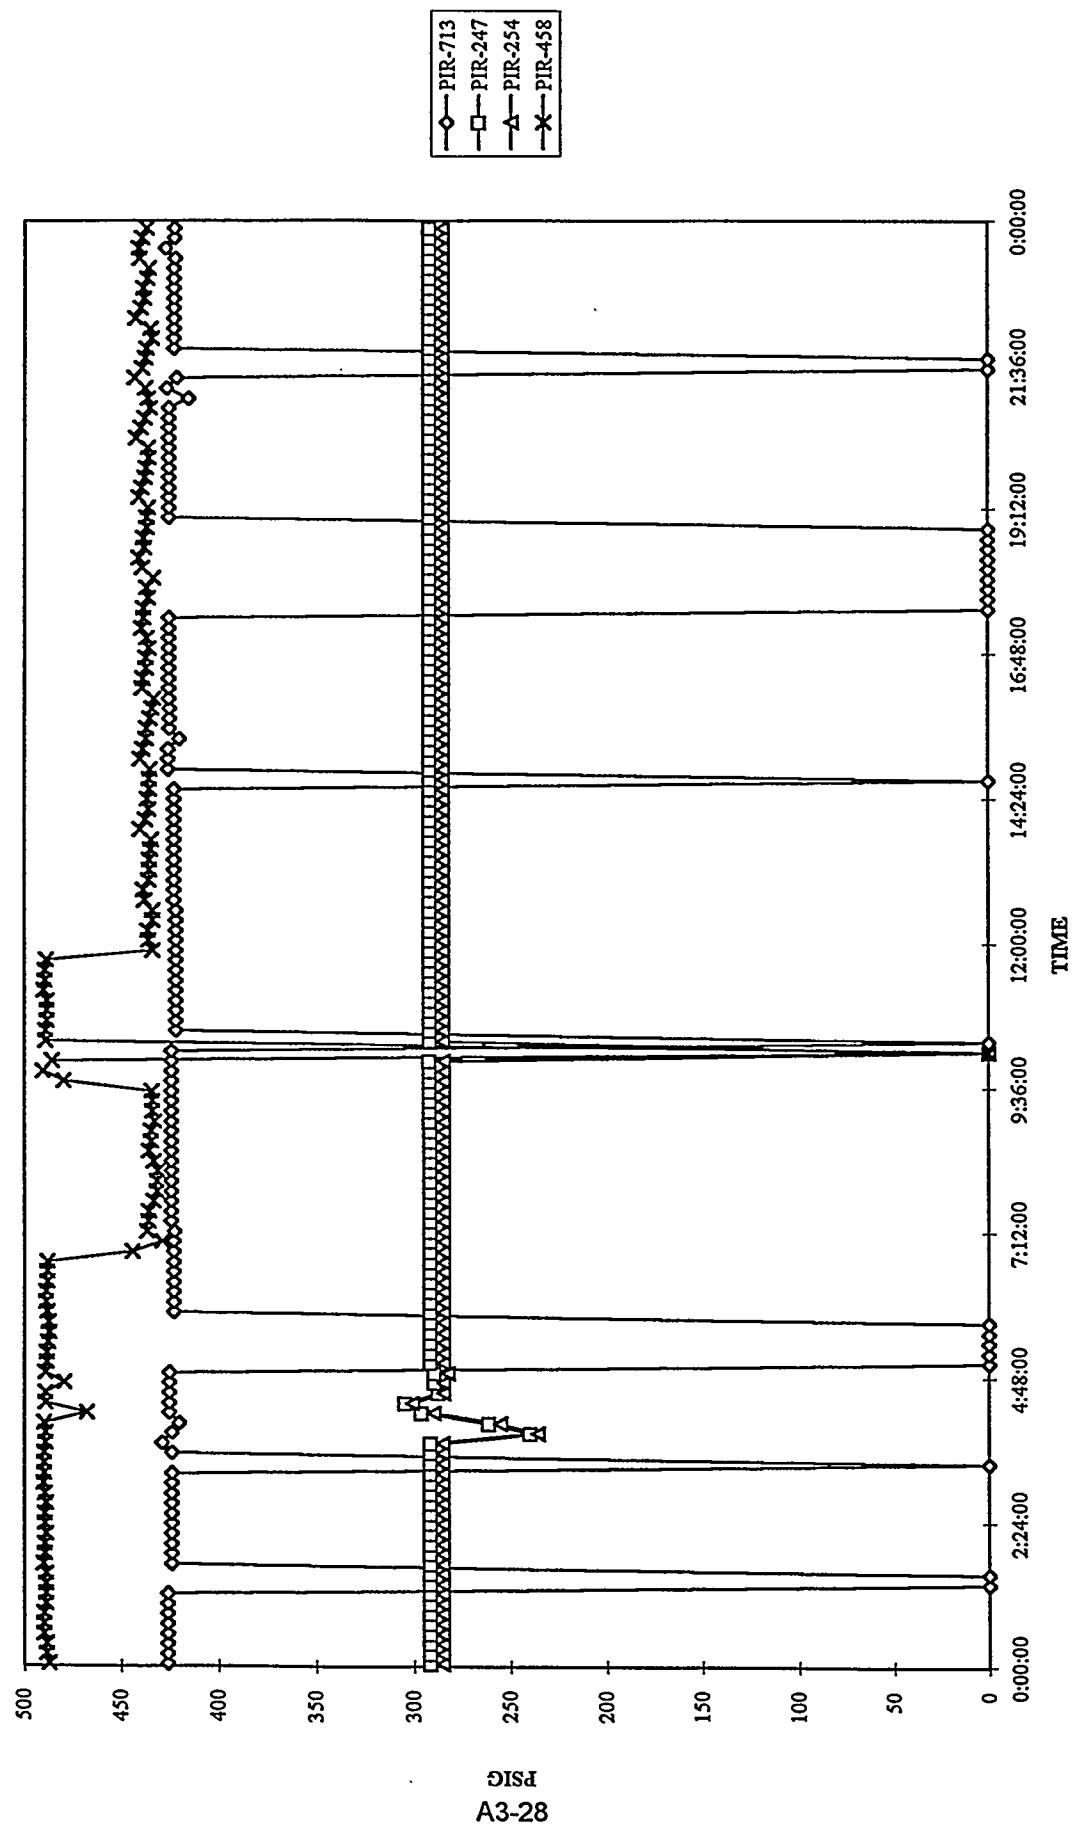


PSIG
A3-28


U:\DATA\111\RUN07
FBG & MGCR PROCESS PRESSURE
RUN 07, 06/12/94

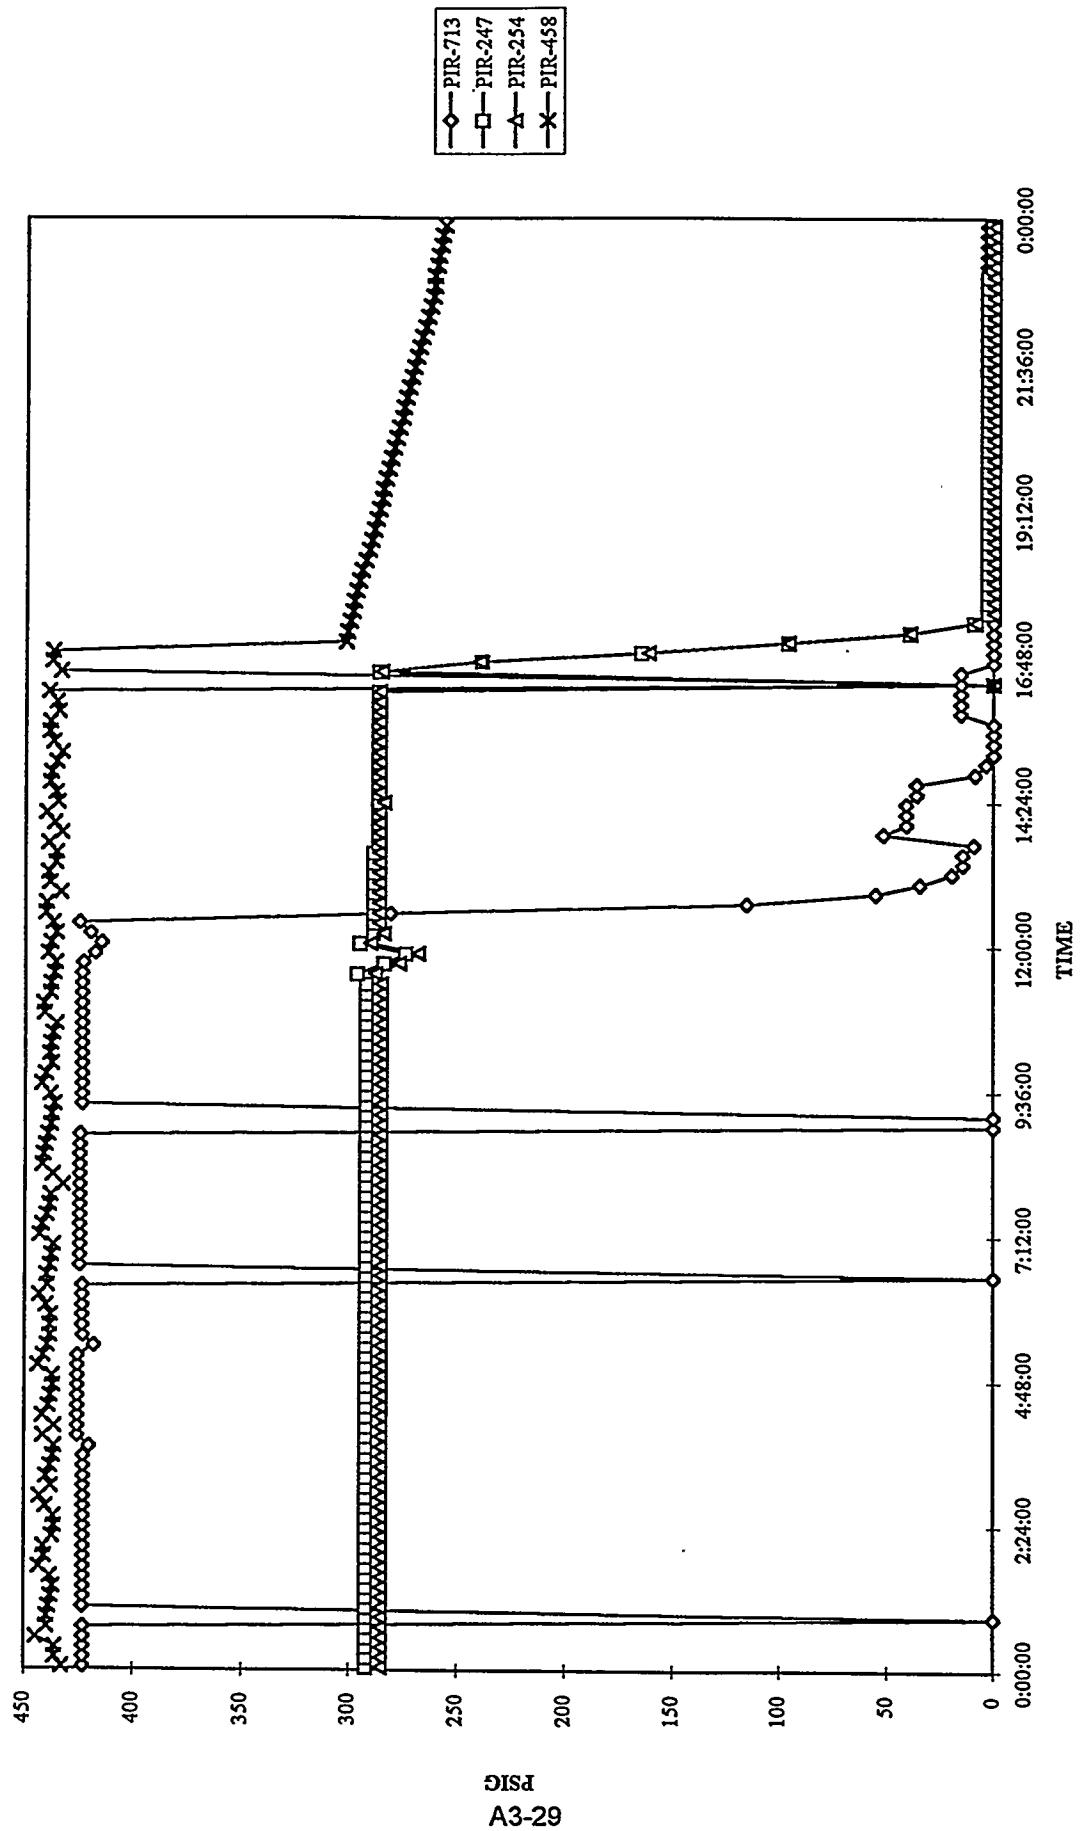


FBG & MGCR PROCESS PRESSURES
94FBG07 - 94MGC07 - 06/13/94

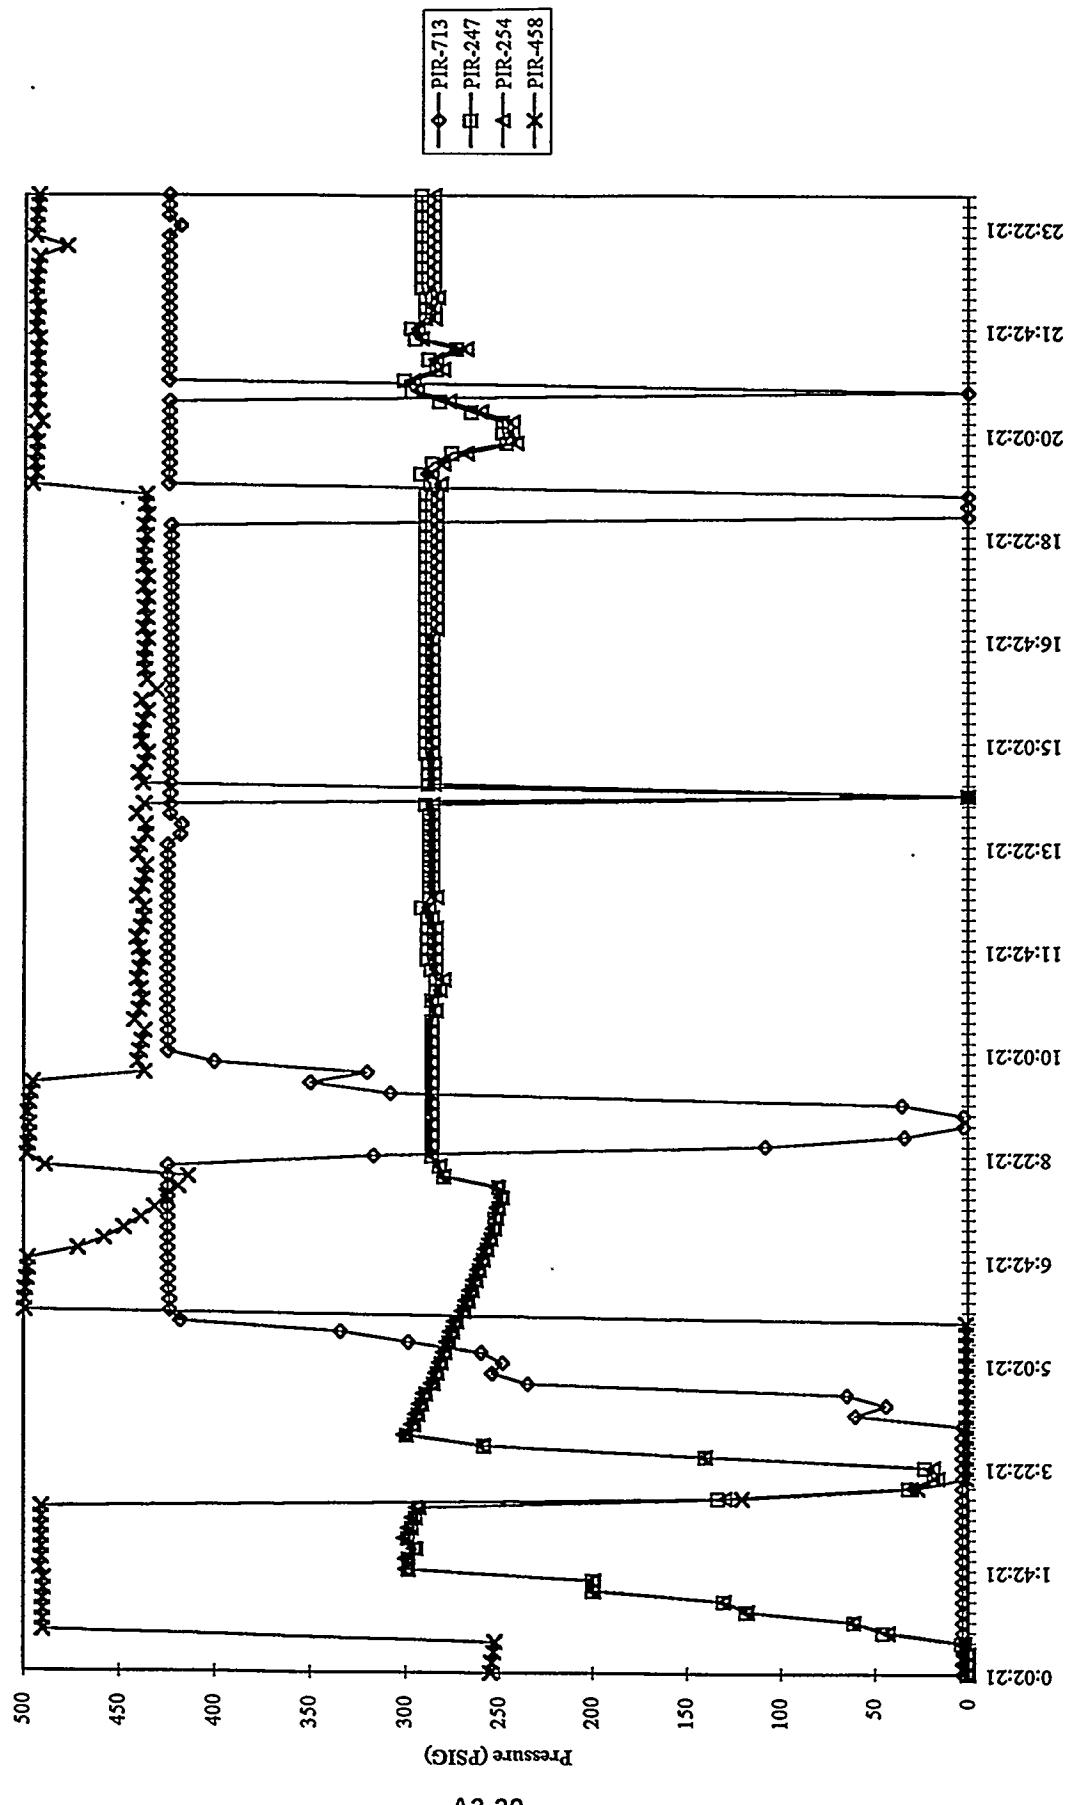


FBG & MGCR PROCESS PRESSURES
94FBCG07 - 94MGC07 - 06/14/94

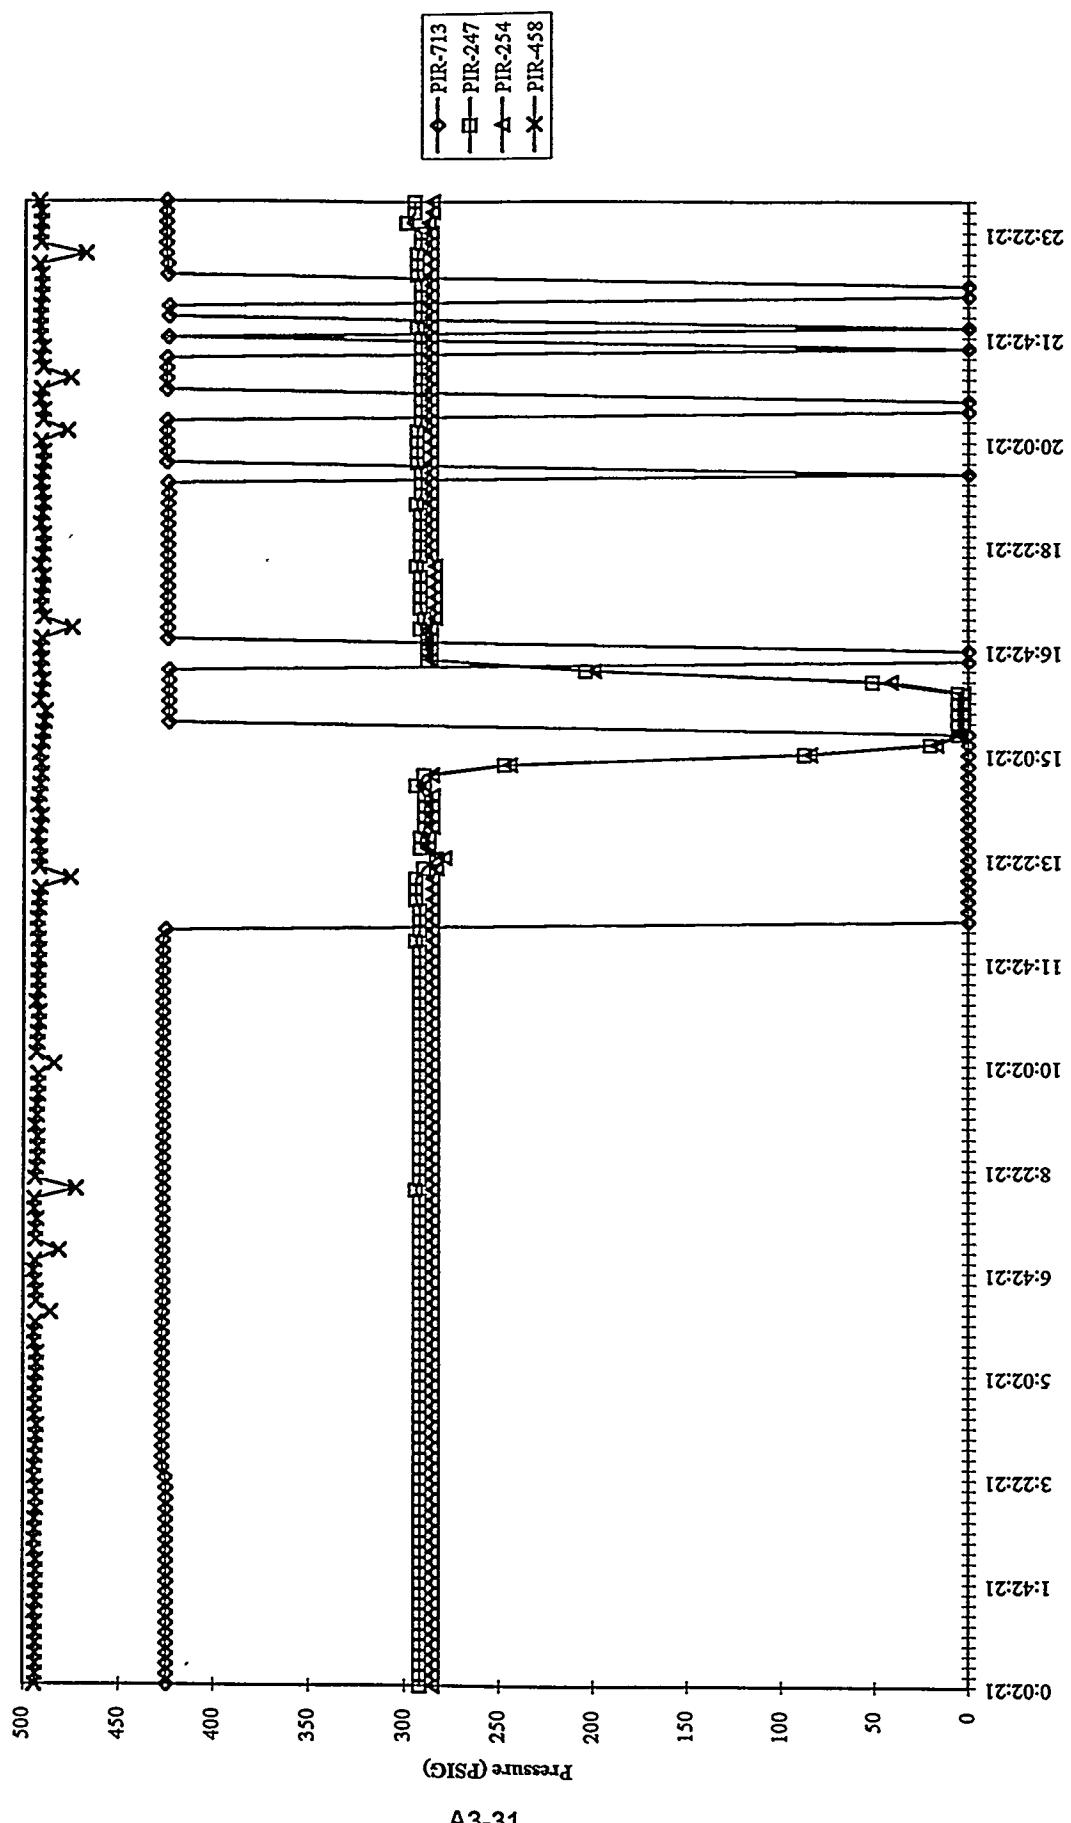


FBG & MGCR PROCESS PRESSURES
94FBG07 - 94MGC07 - 06/15/94

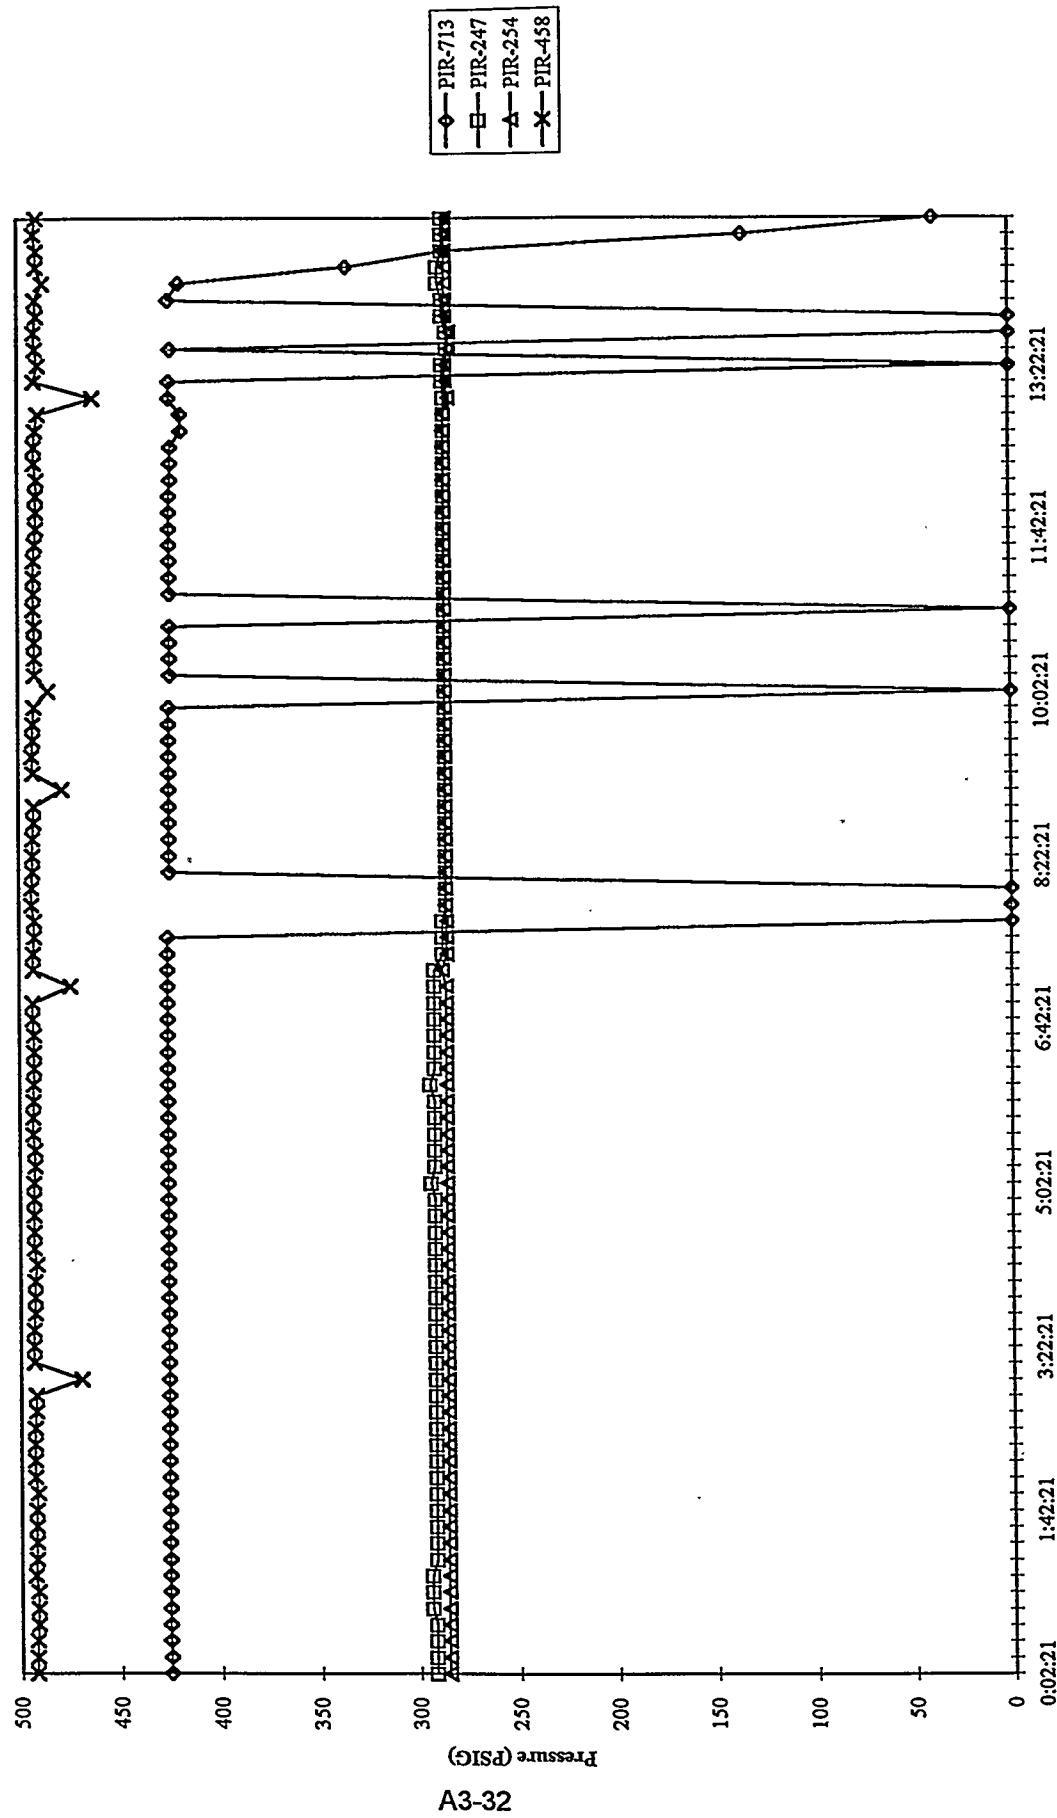


MGCR F-100 DIFFERENTIAL PRESSURE
94MGC07 - 06/06/94

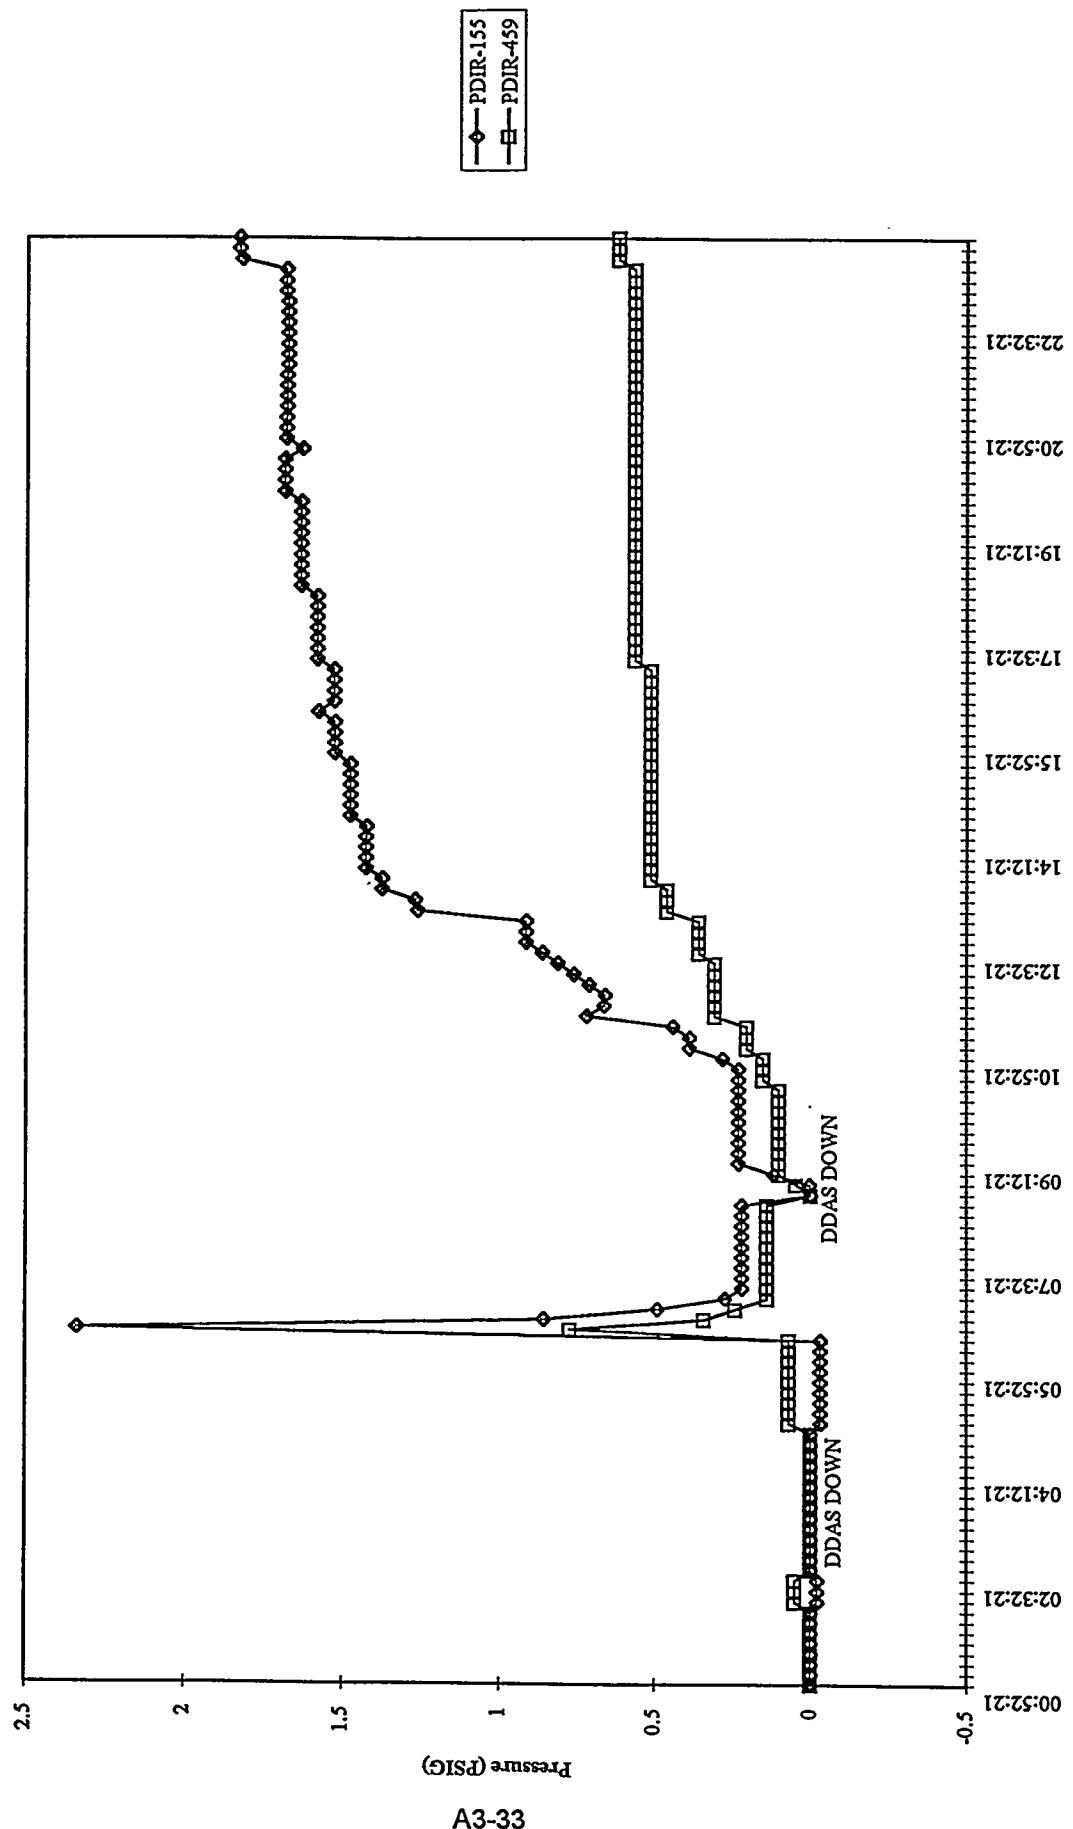


MGCR F-100 DIFFERENTIAL PRESSURE
94MGC07 - 06/07/94

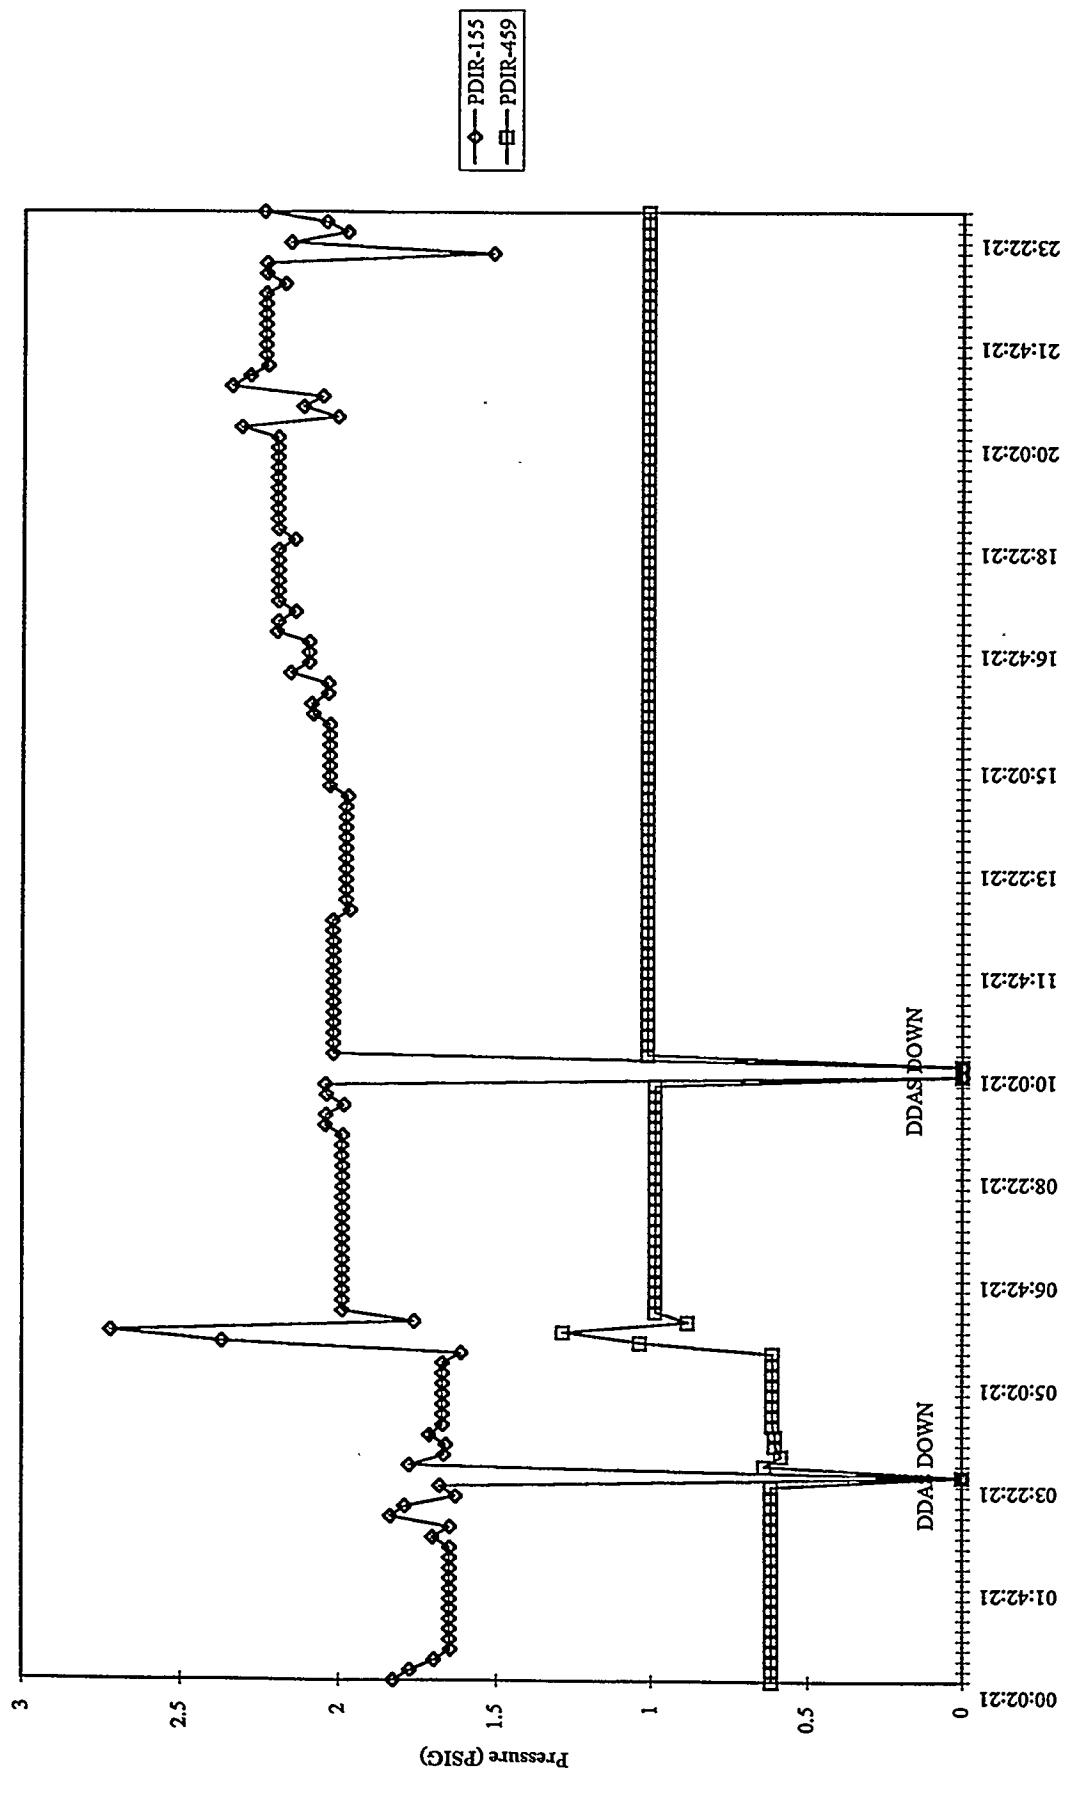


MGCR F-100 DIFFERENTIAL PRESSURE
94MGC07 - 06/08/94

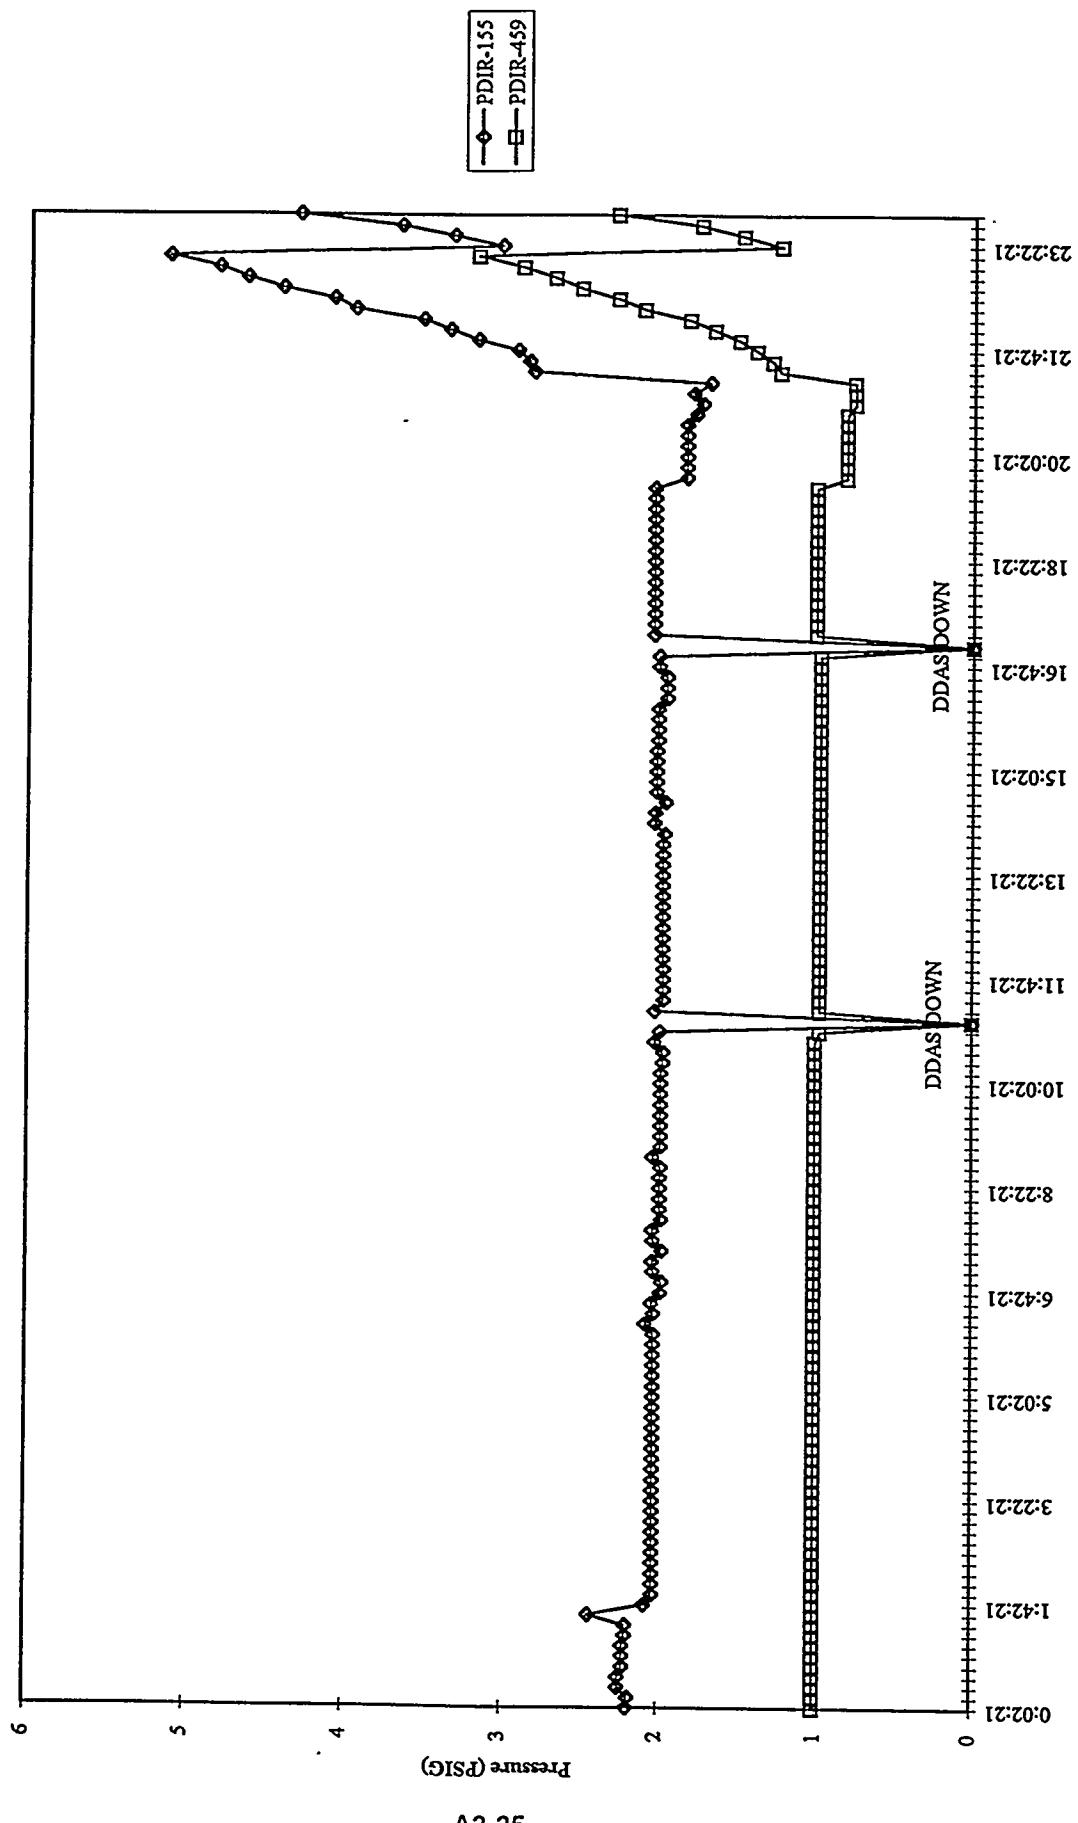


MGCR F-100 DIFFERENTIAL PRESSURE
94MGC07 - 06/09/94

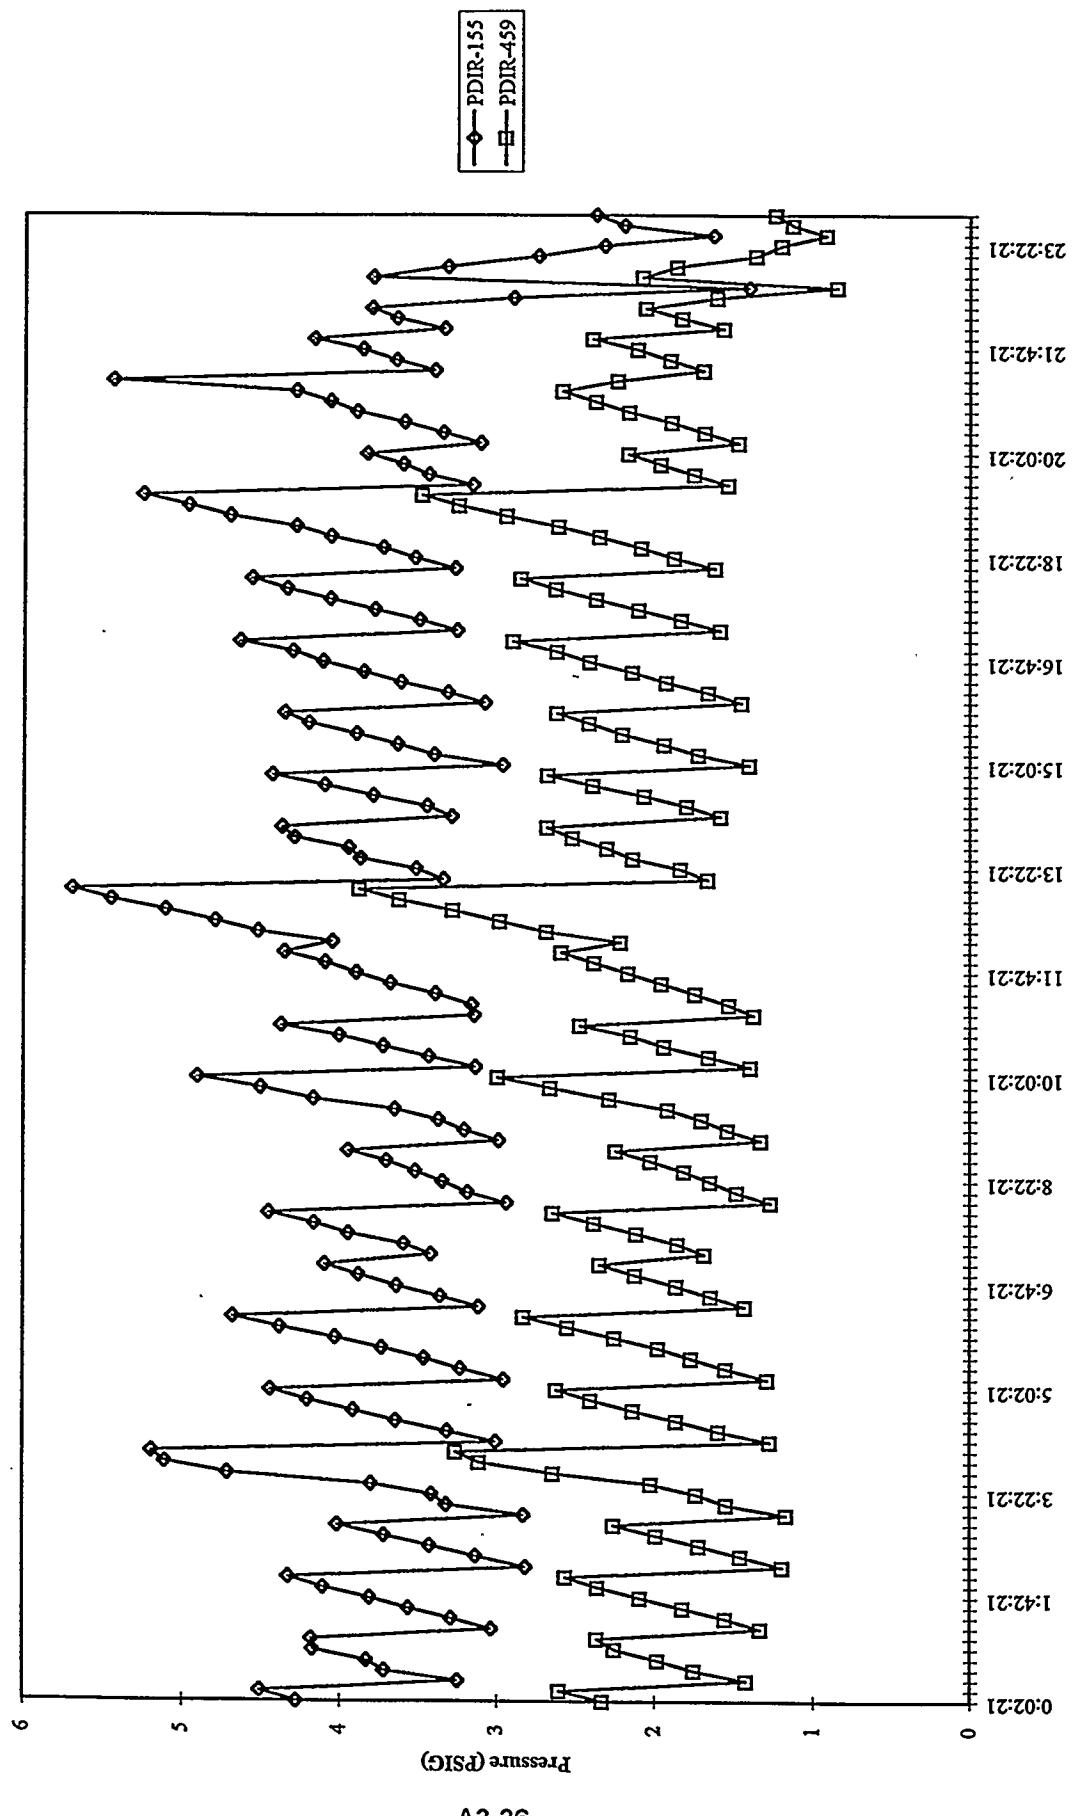


MGCR F-100 DIFFERENTIAL PRESSURE
94MGC07 - 06/10/94

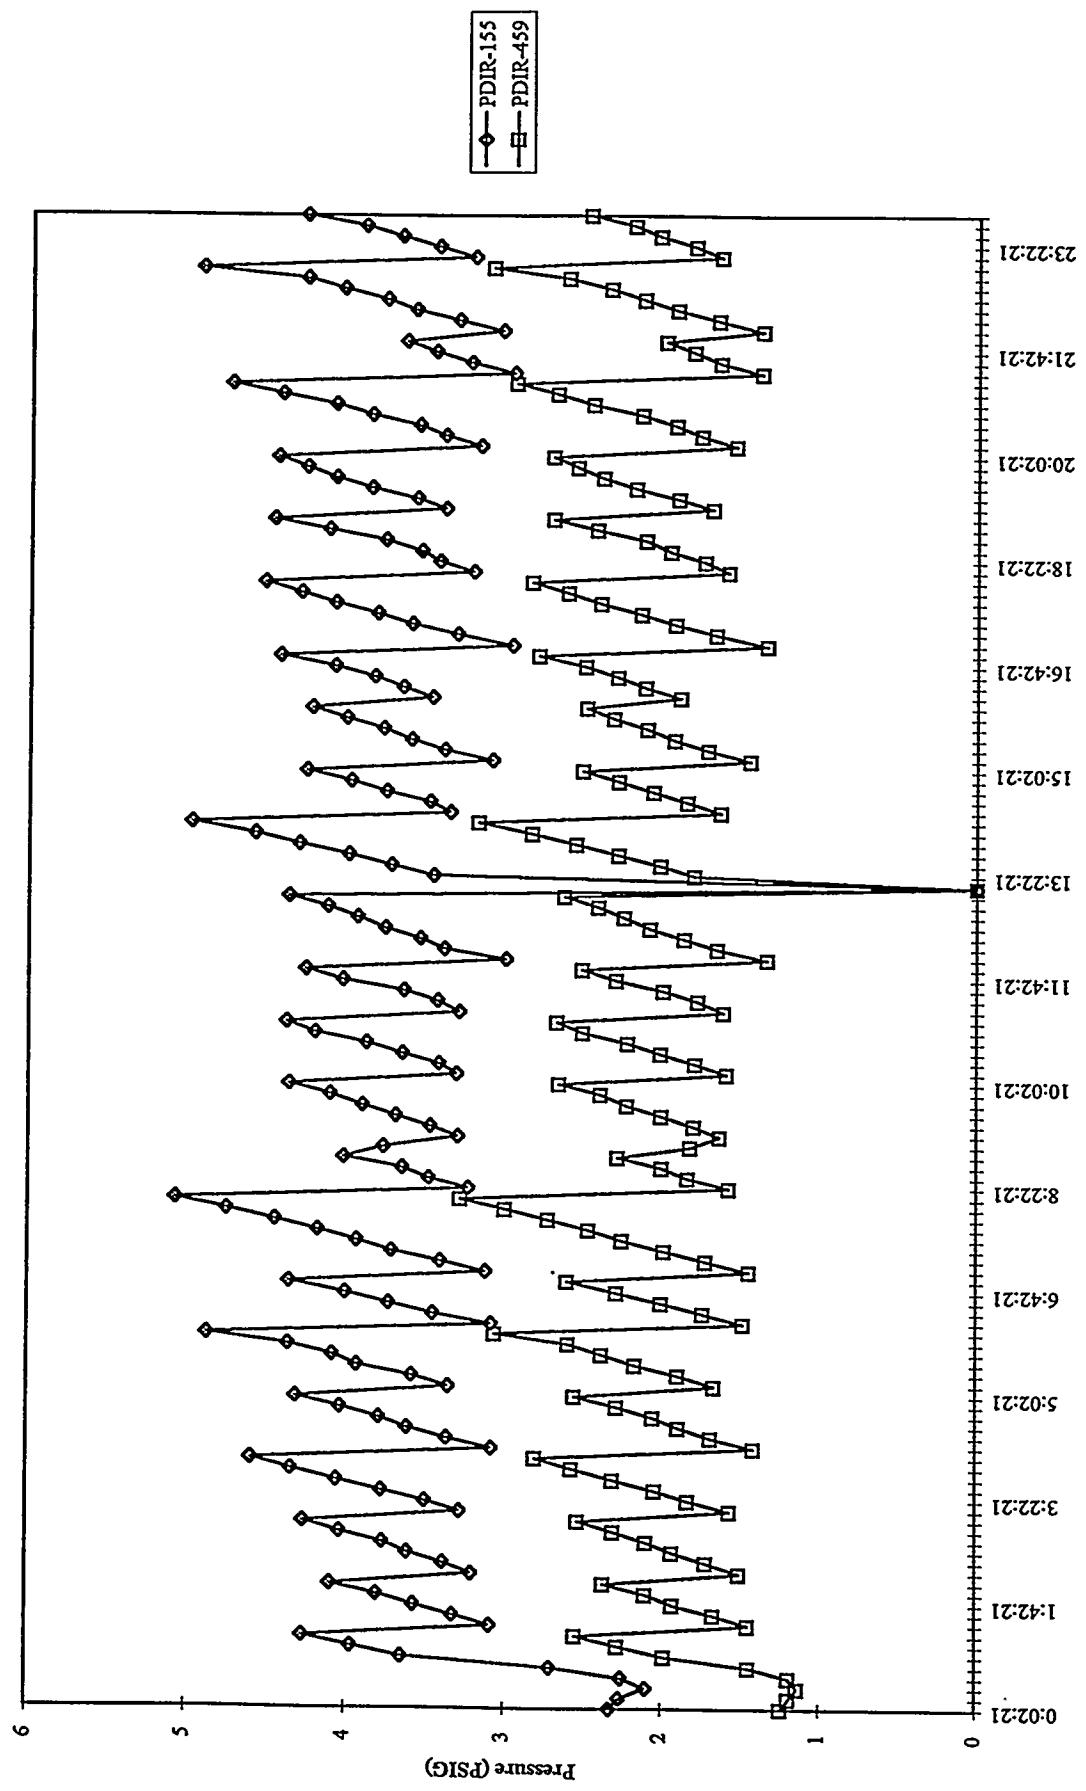


MGCR F-100 DIFFERENTIAL PRESSURE
94MGC07 - 06/11/94

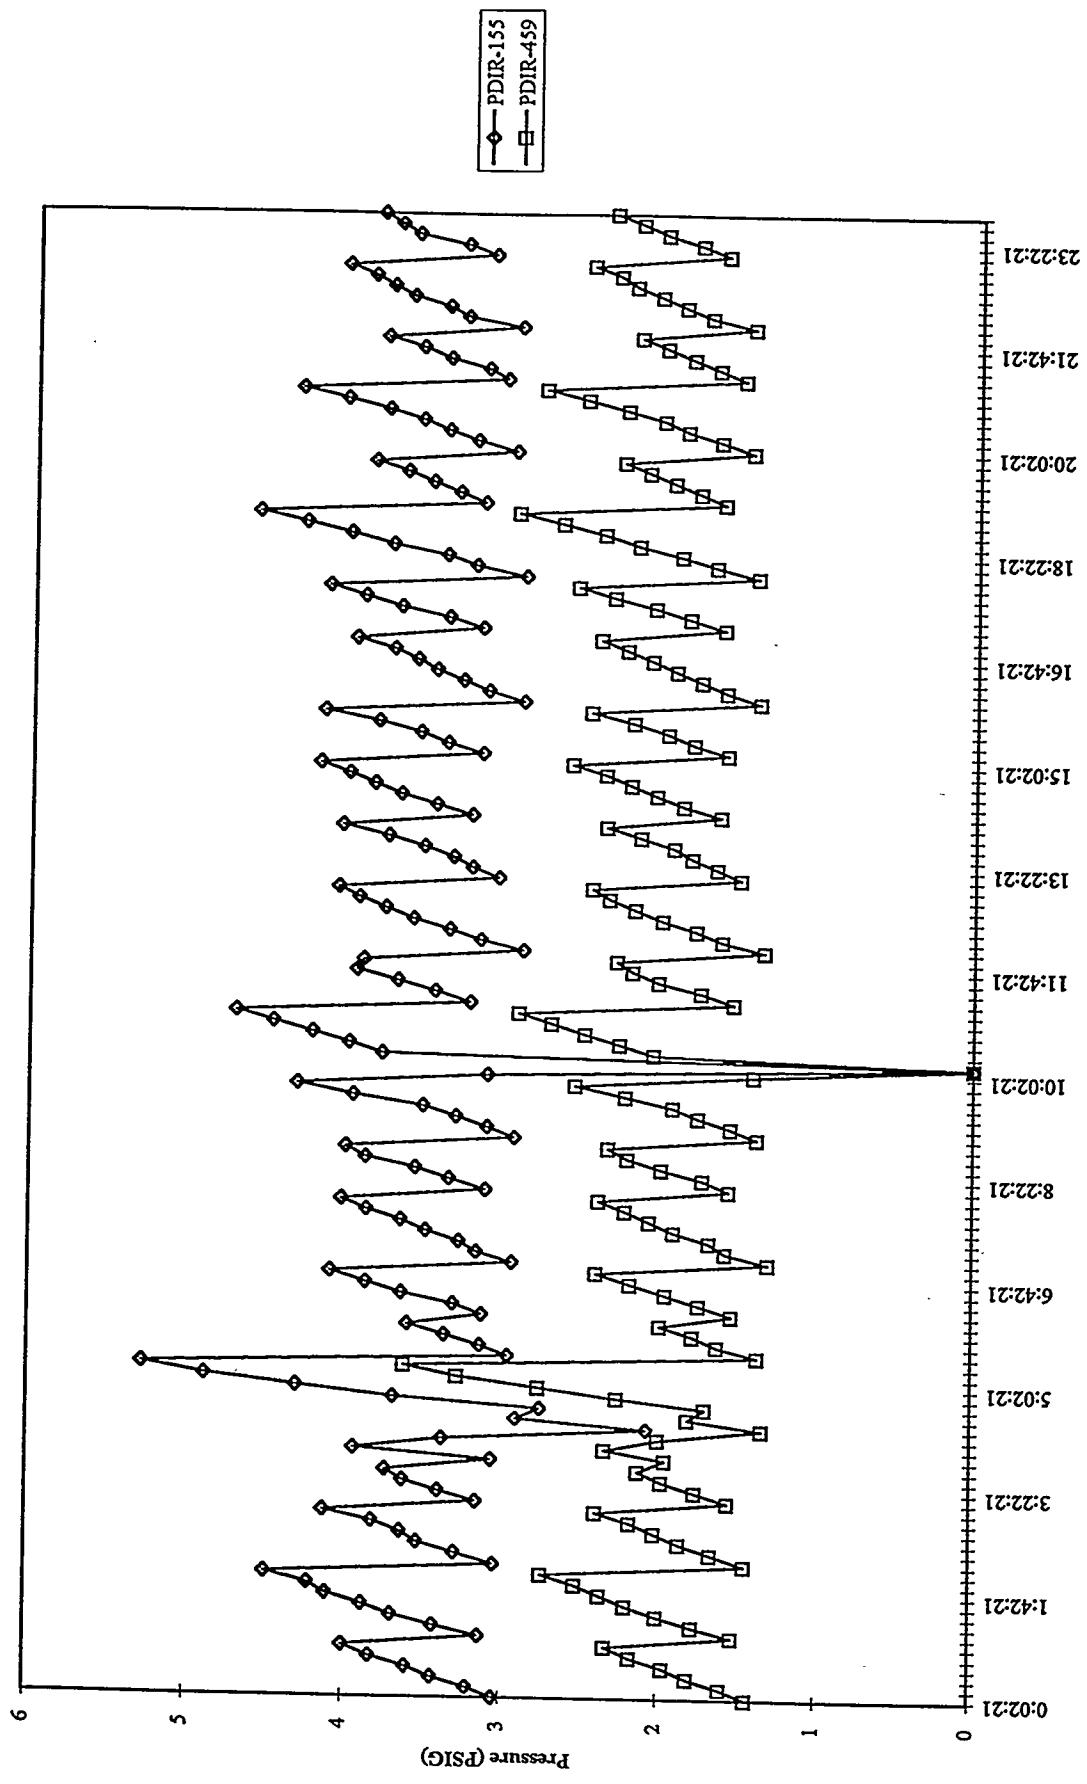


MGCR F-100 DIFFERENTIAL PRESSURE
94MGC07 - 06/12/94

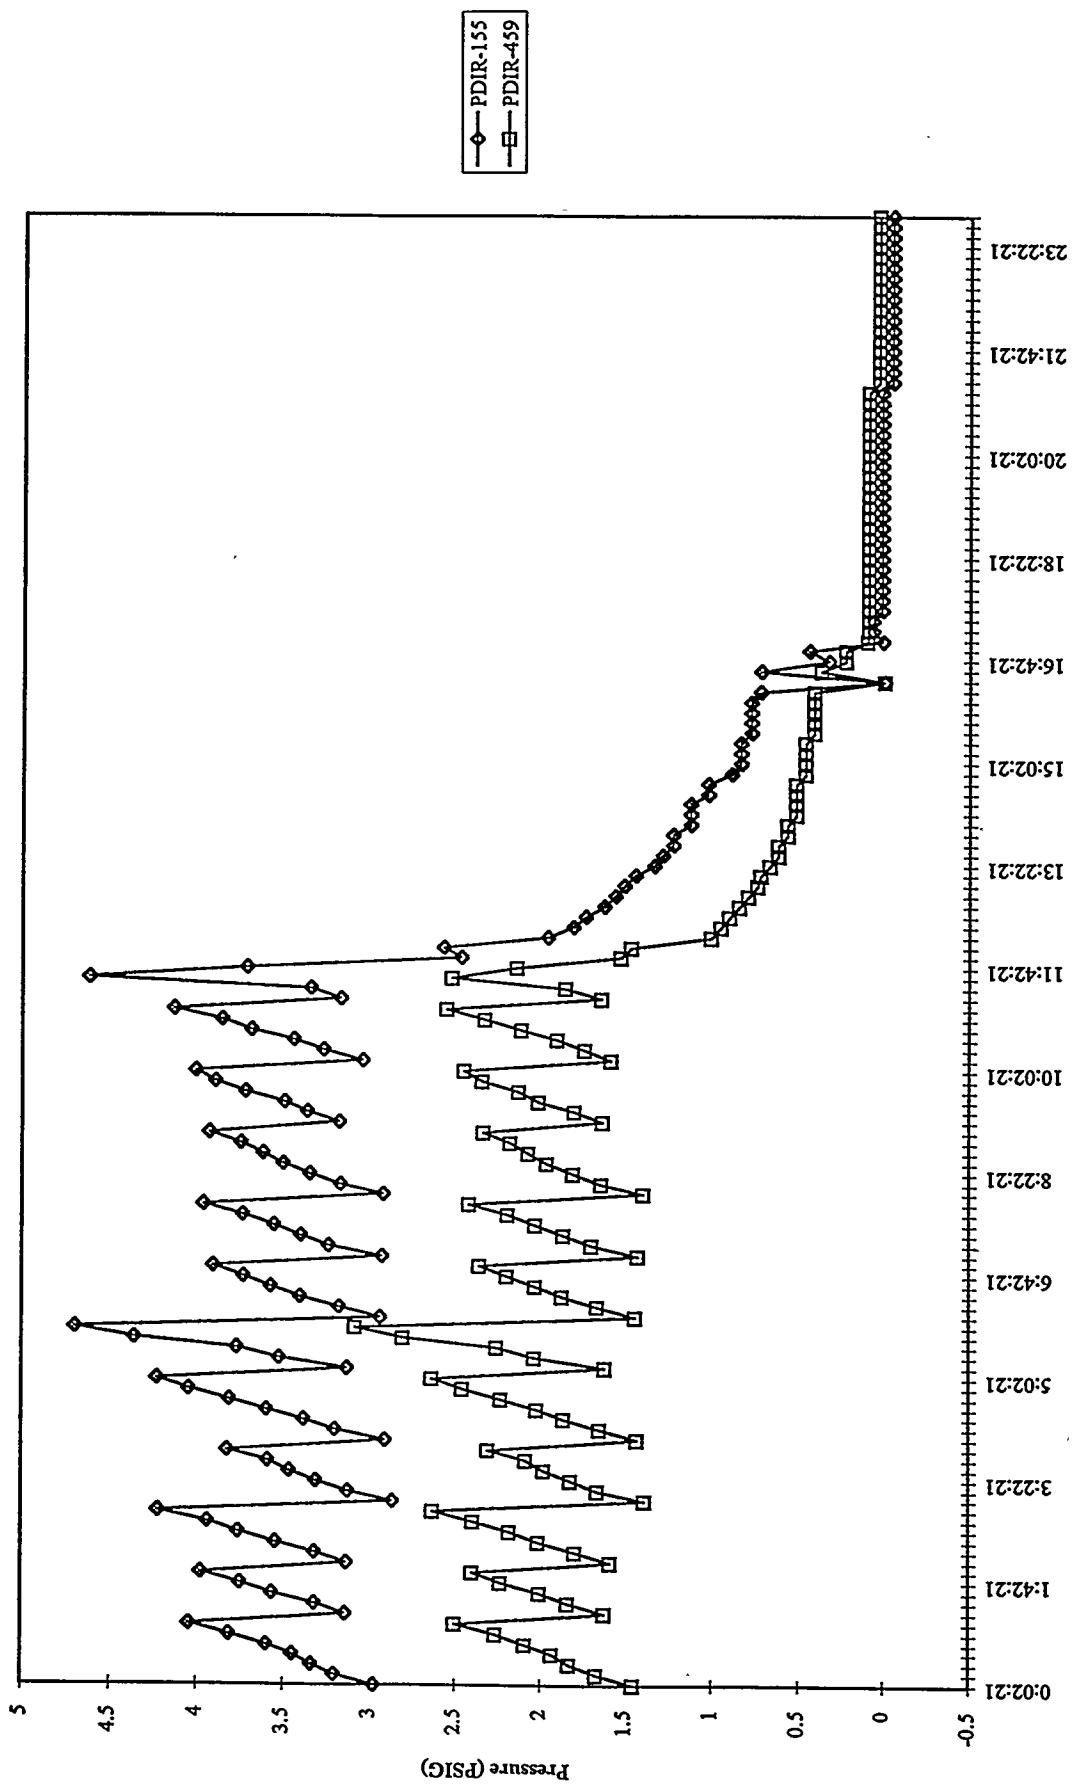


MGCR F-100 DIFFERENTIAL PRESSURE
94MGC07 - 06/13/94

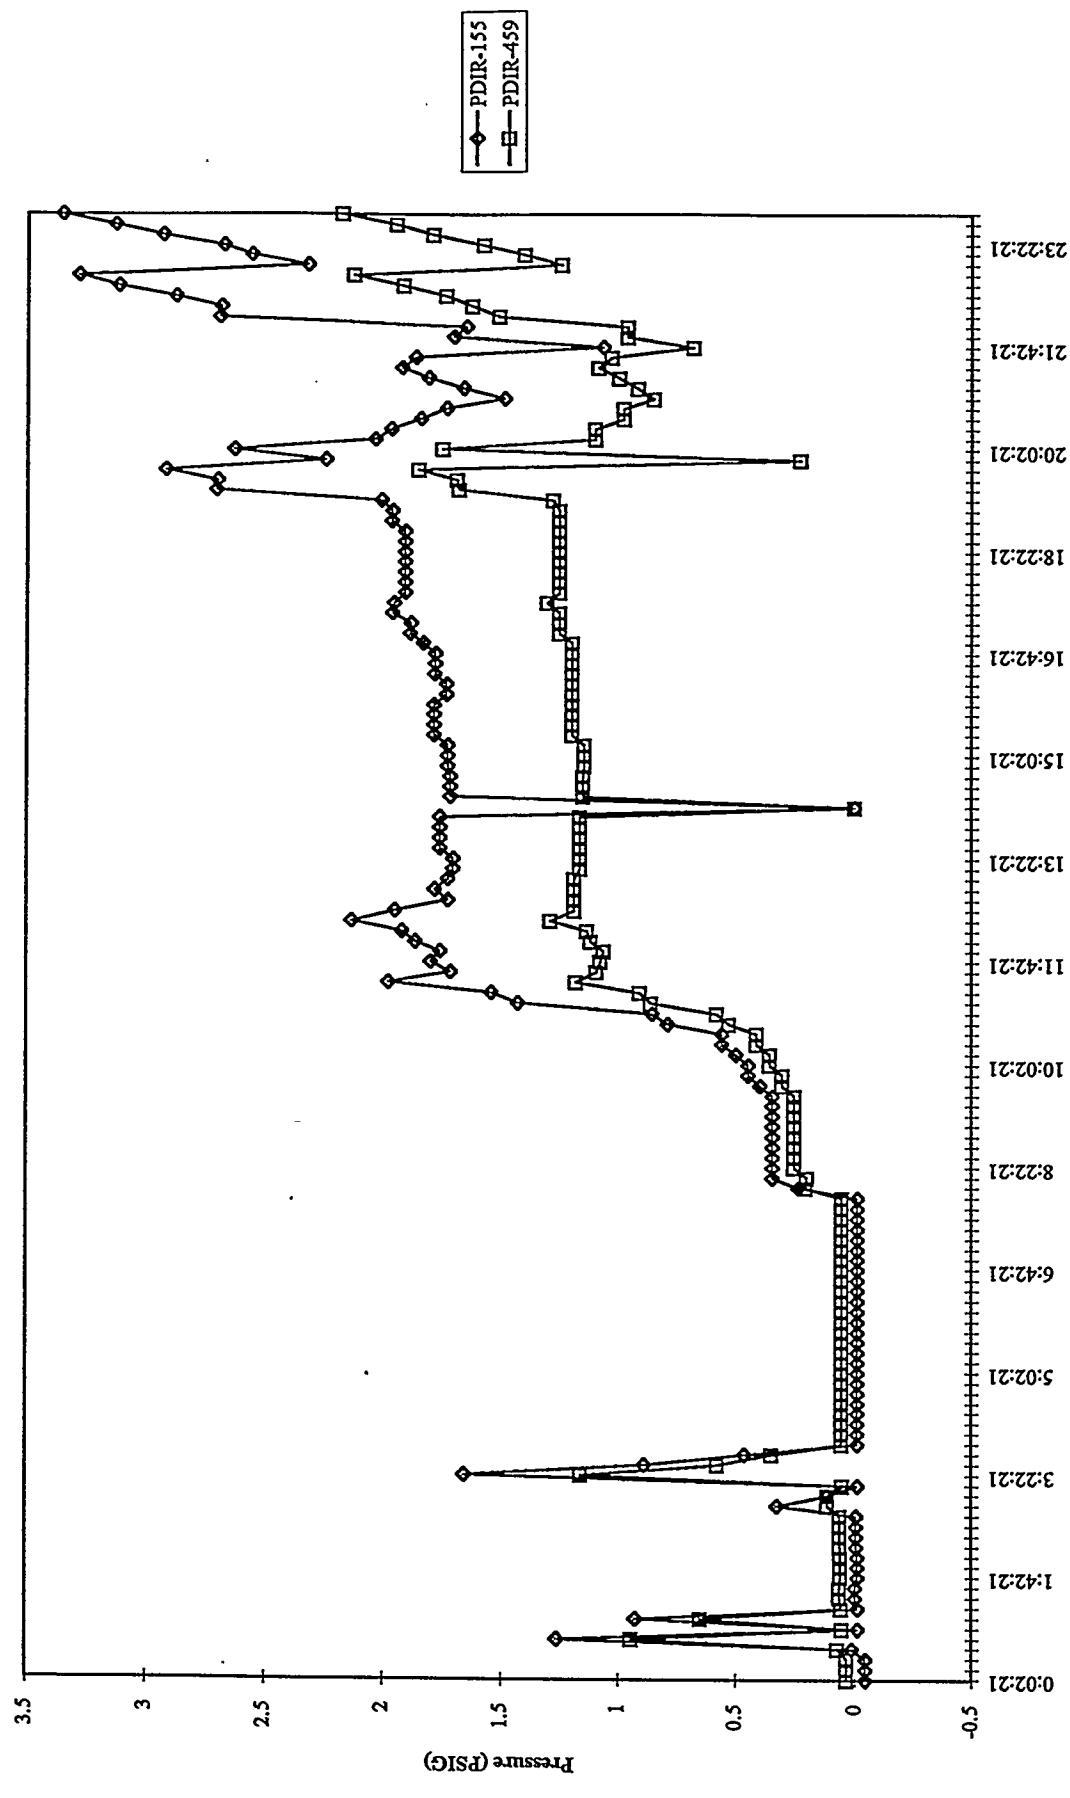

MGCR F-100 DIFFERENTIAL PRESSURE
94MGC07 - 06/14/94

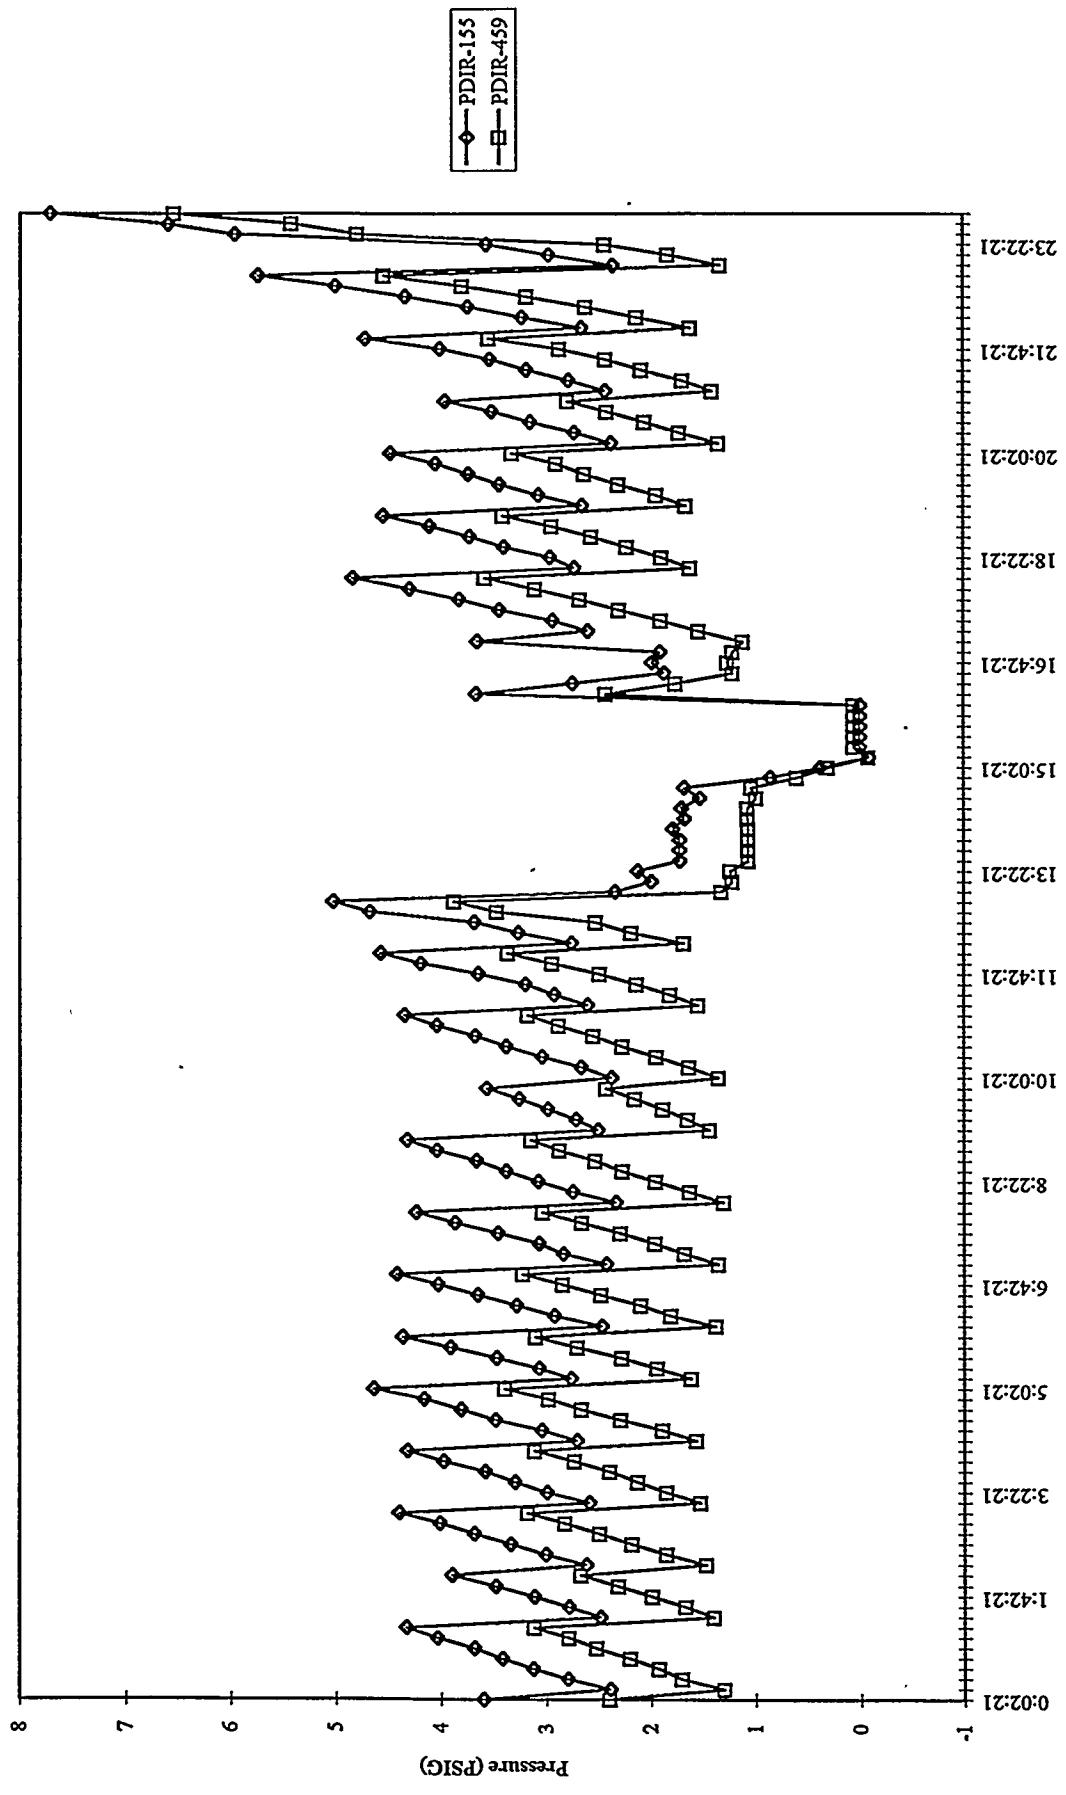

MGCR F-100 DIFFERENTIAL PRESSURE
94MGC07 - 06/15/94

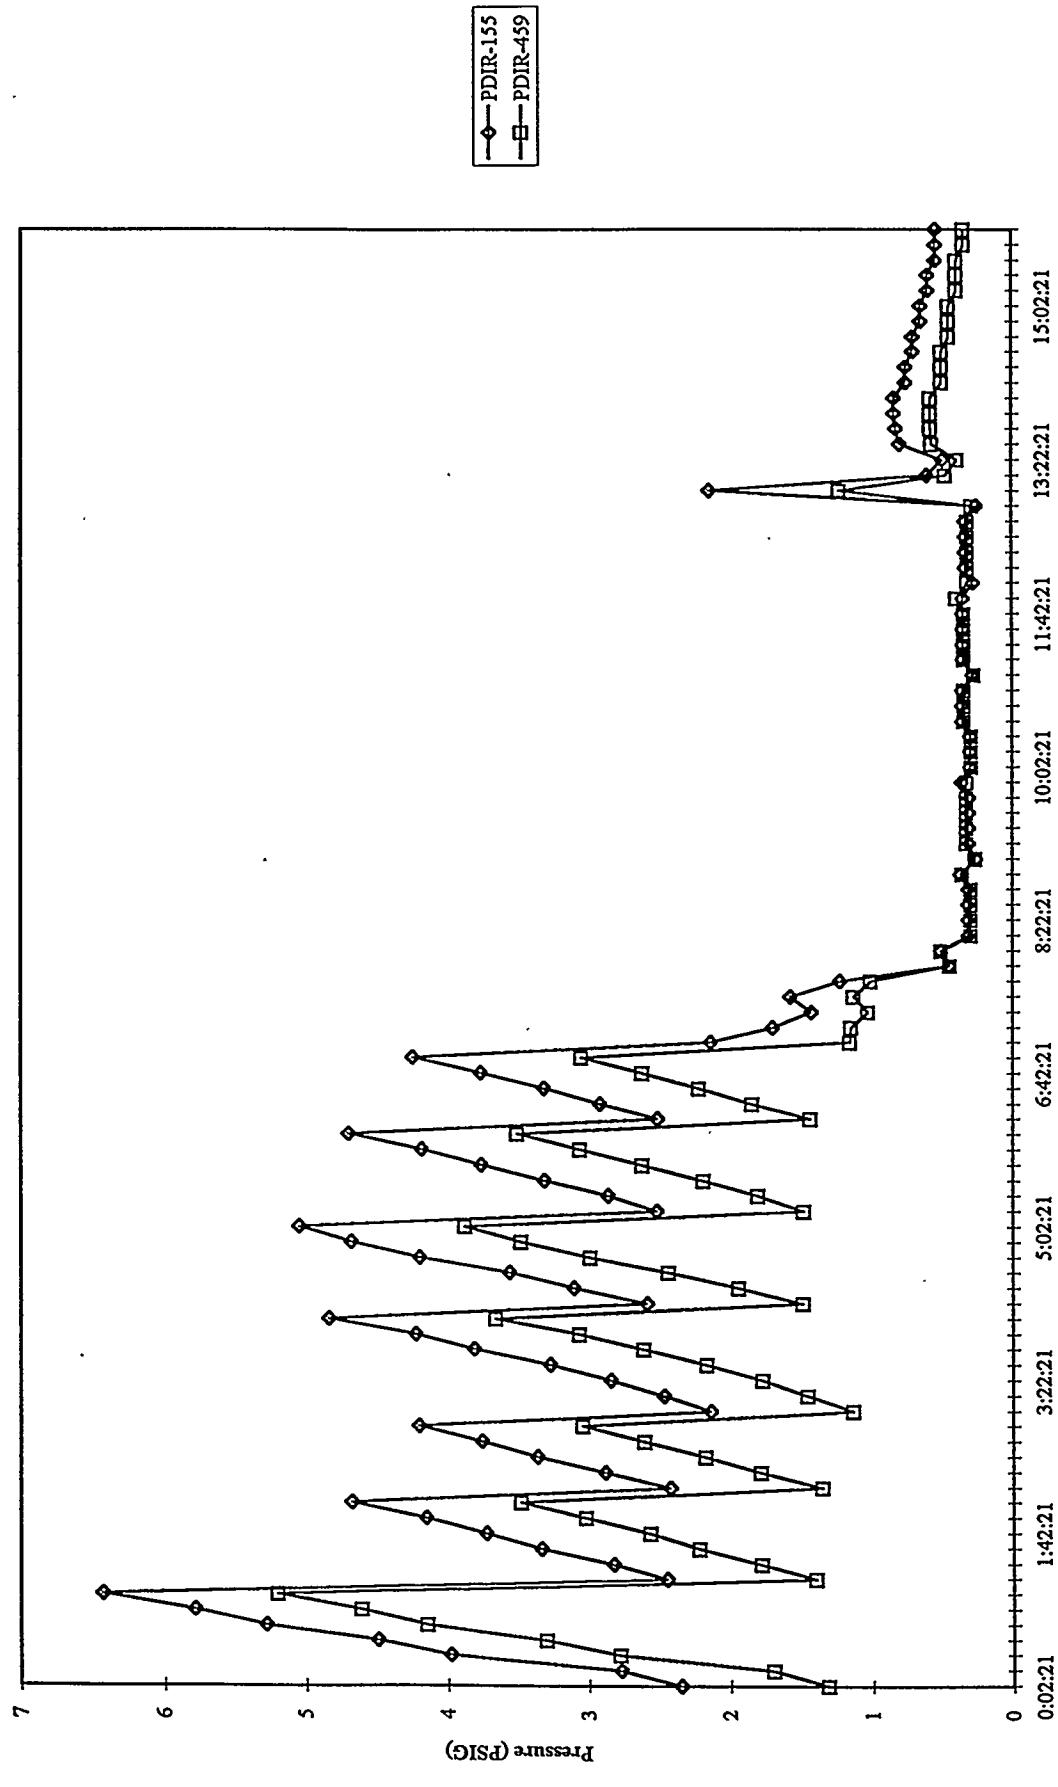


A3-42


94MGC08
(07/18/94 - 07/27/94)




MGCR Inlet and Exit Flows
Run 94MGCR08, 07/18/94

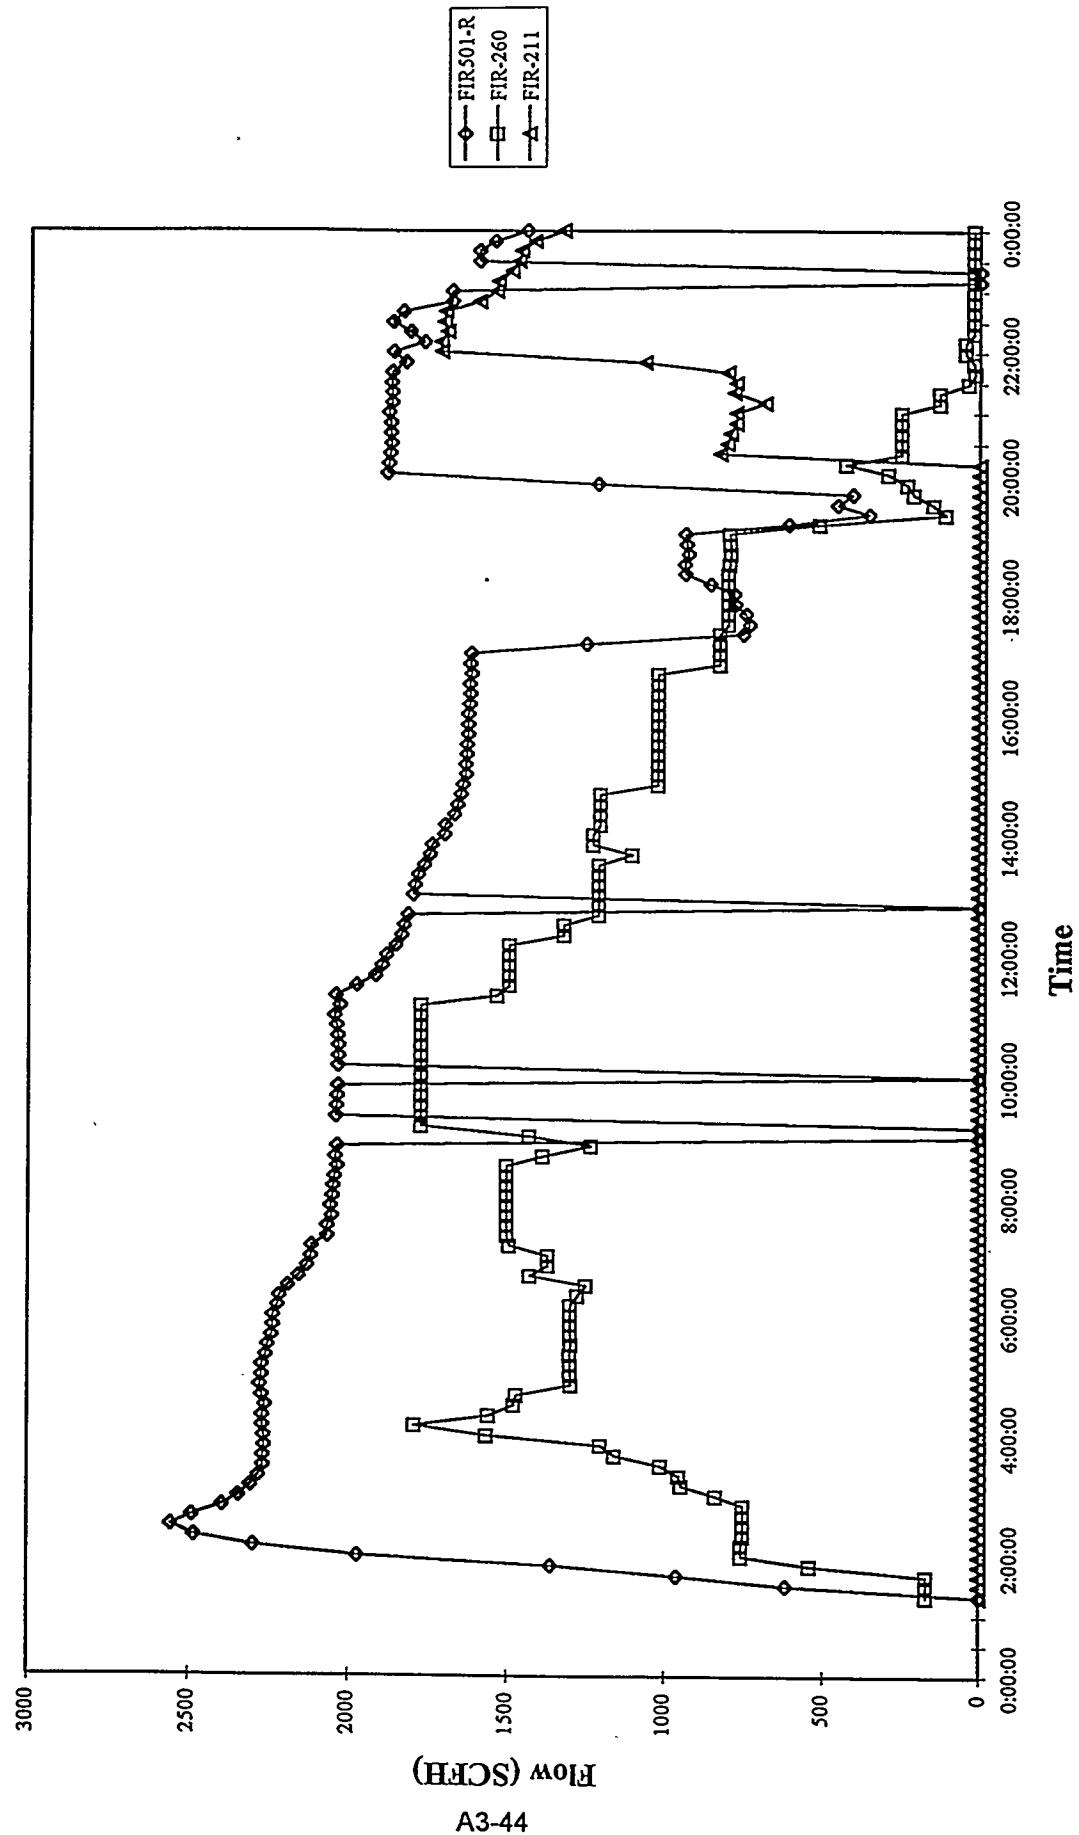


MGCR Inlet and Exit Flows
Run 94MGC08, 07/19/94

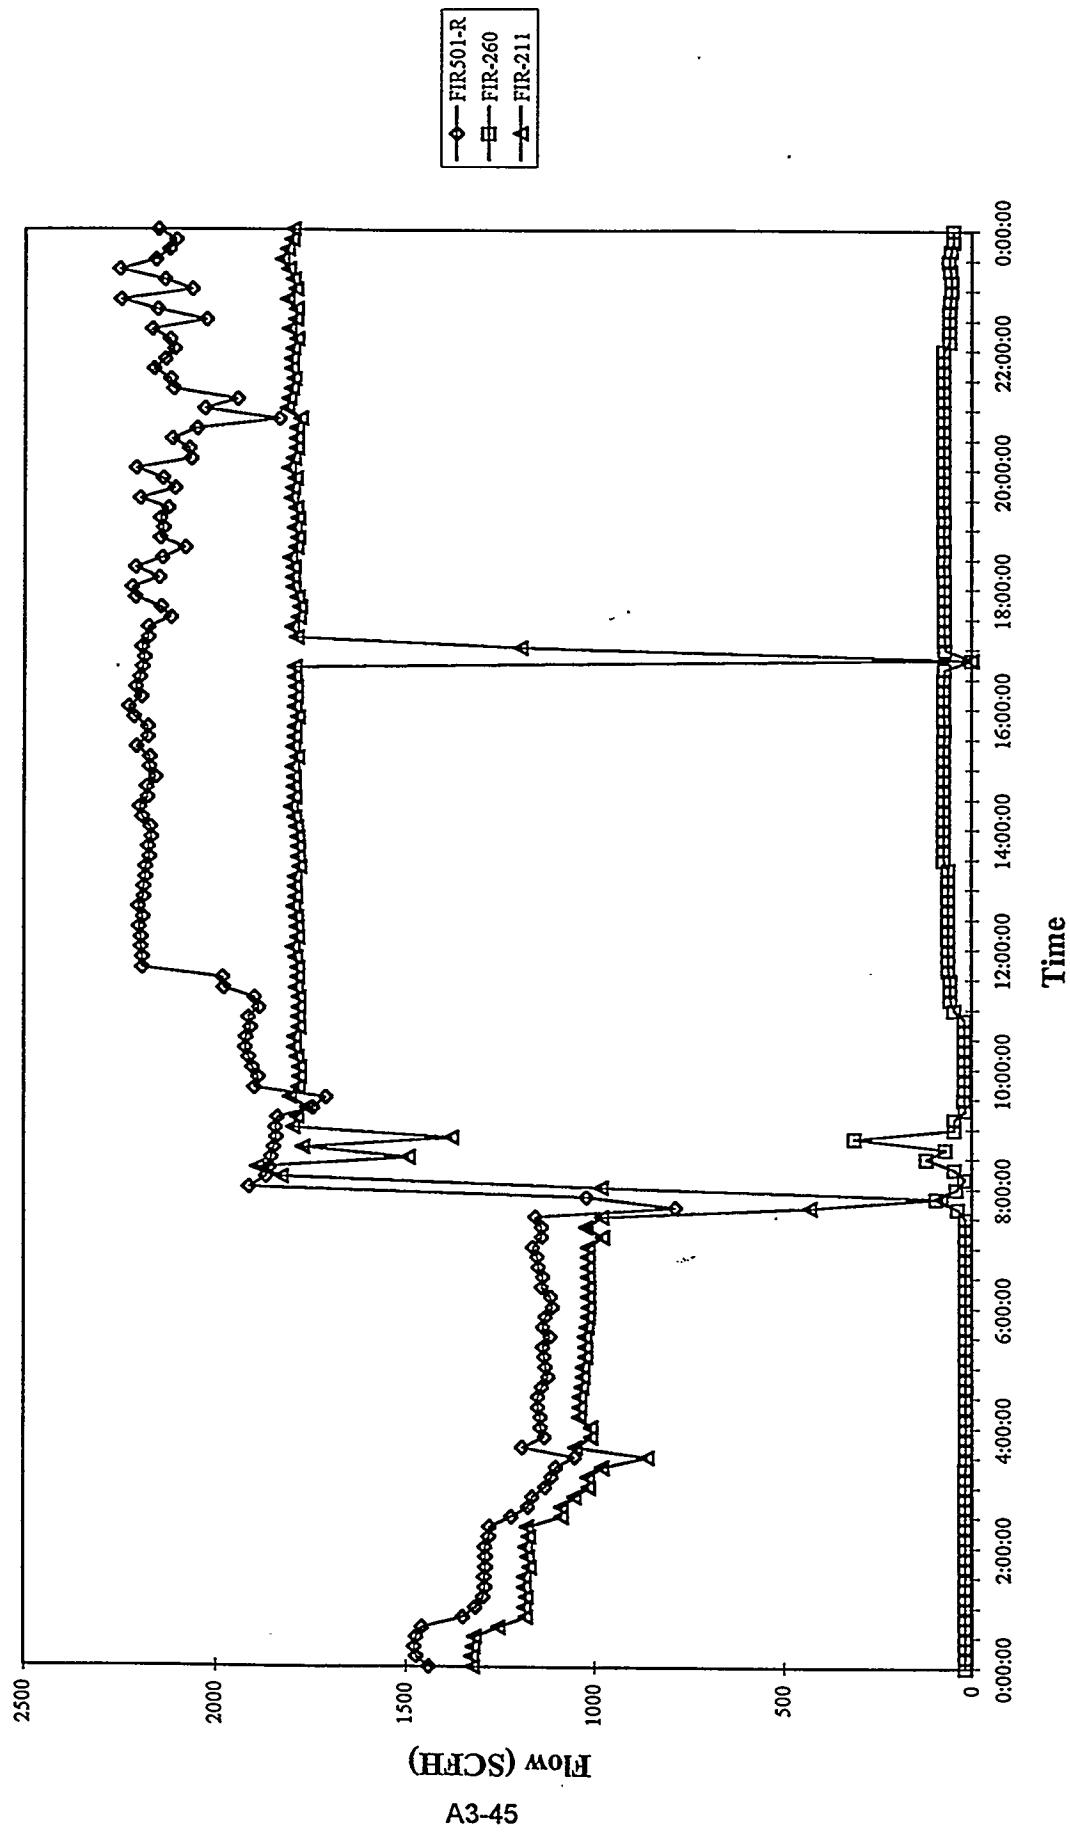


MGCR Inlet and Exit Flows
Run 94/MGC08, 07/20/94

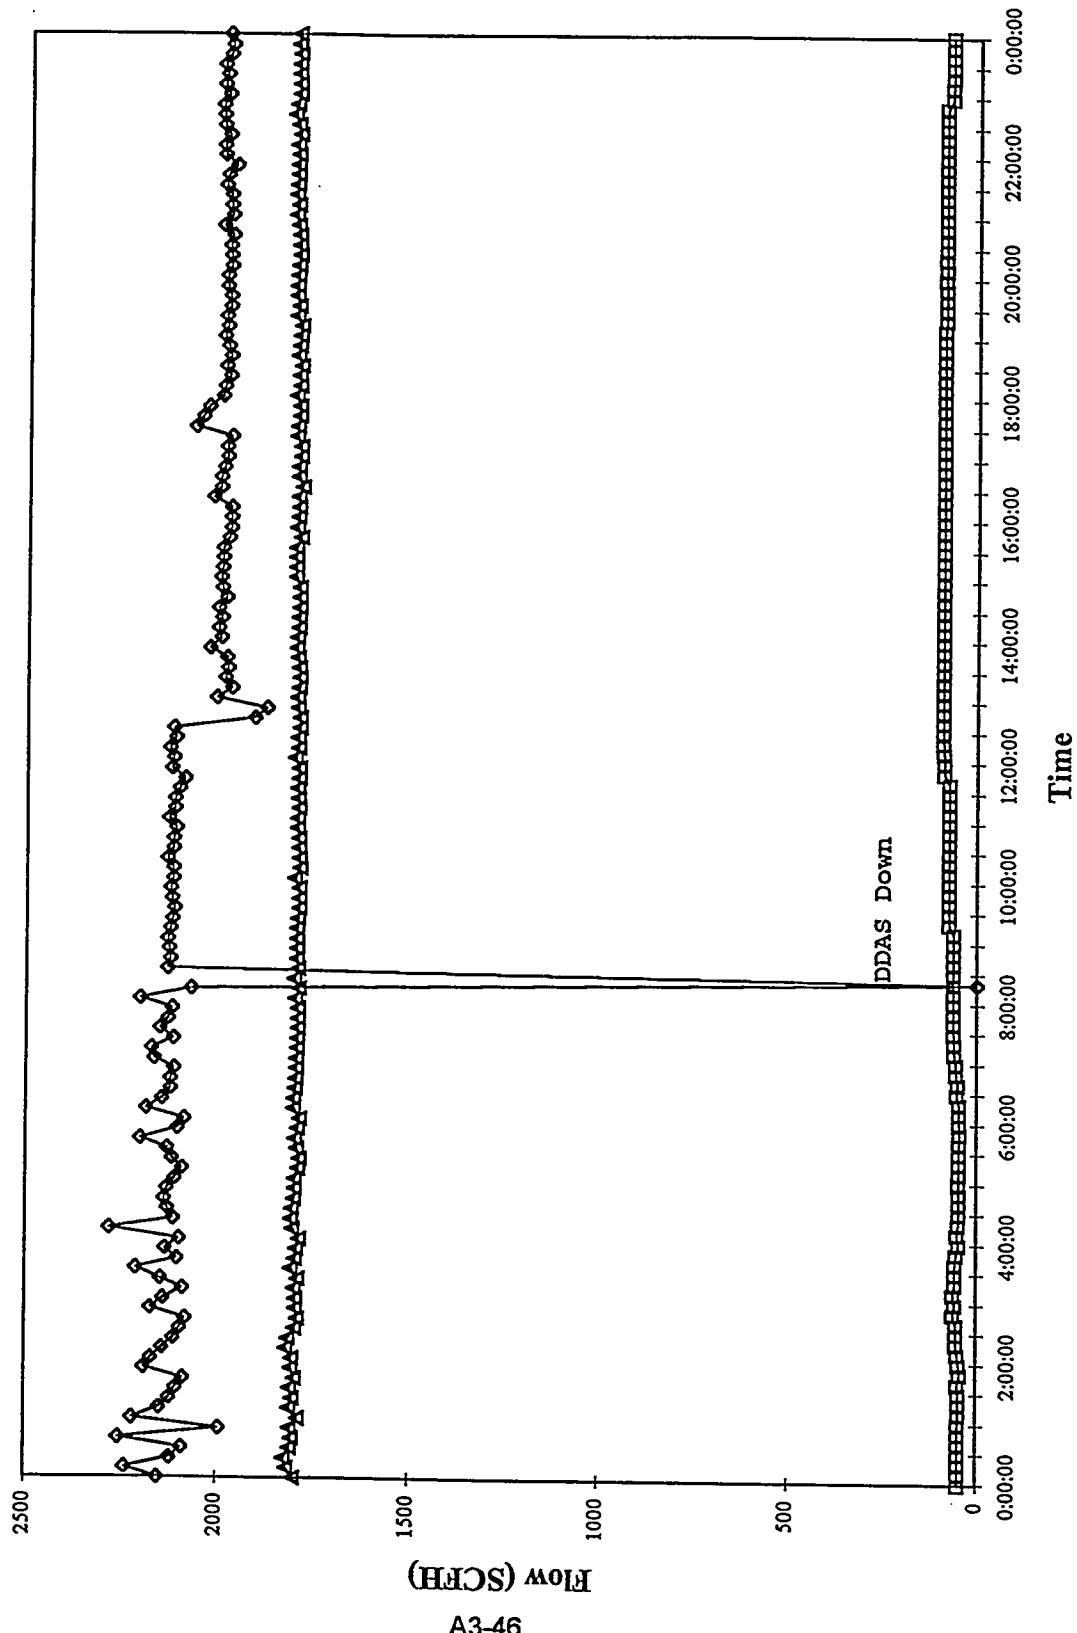


MGCR Inlet and Exit Flows
Run 94MGC08, 07/21/94

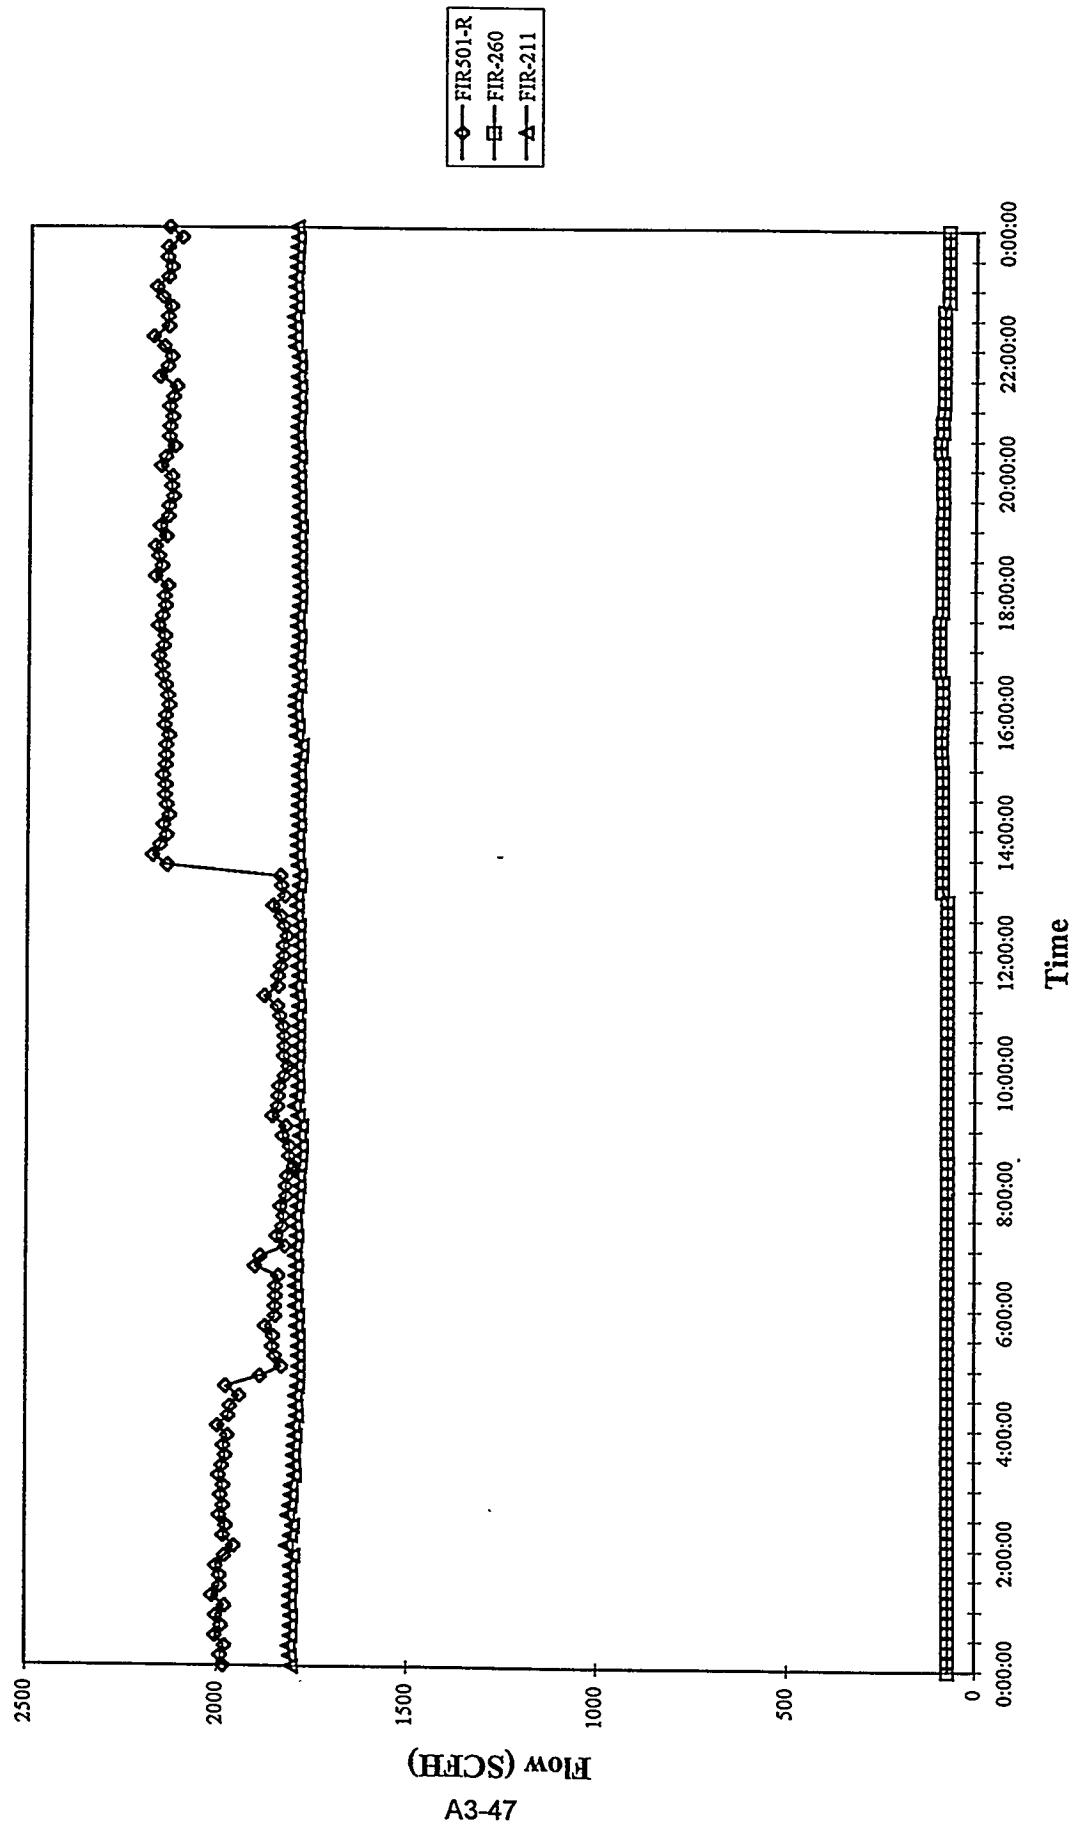


MGCR Inlet and Exit Flows
Run 94MGC08, 07/22/94

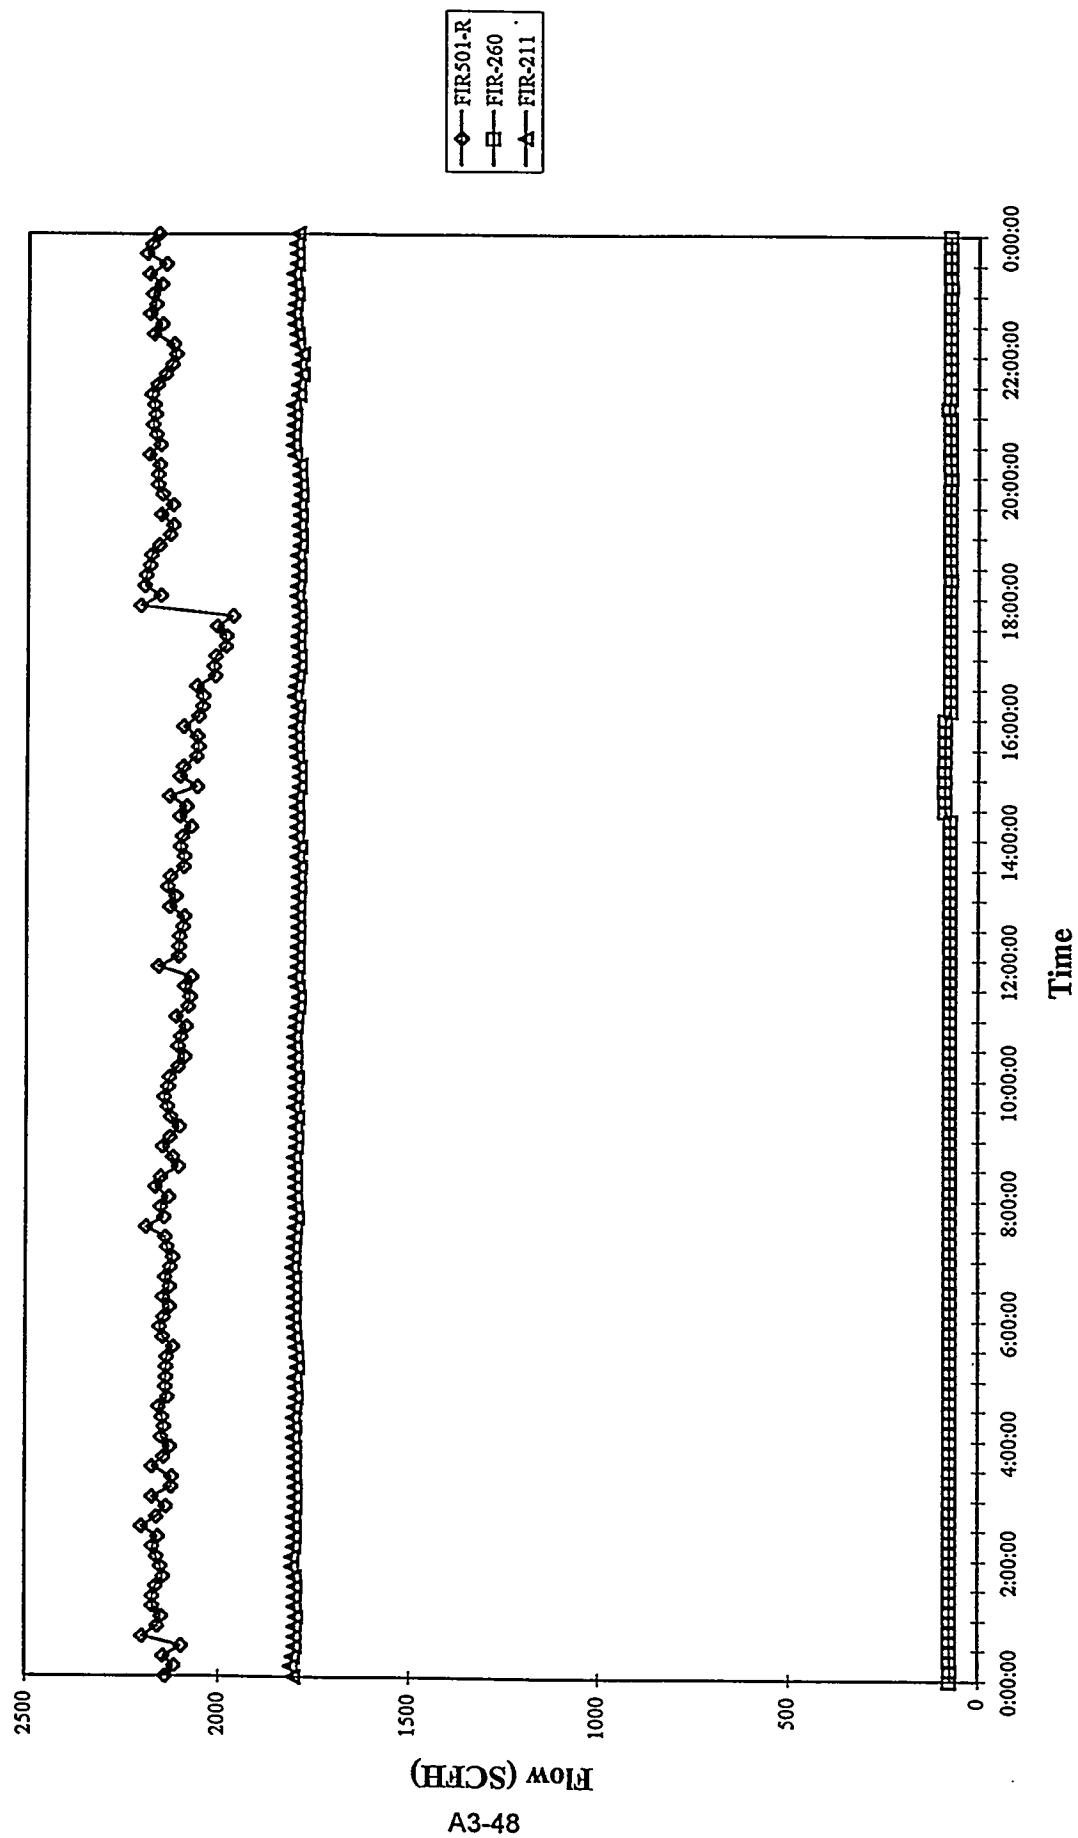


MGCR Inlet and Exit Flows
Run 94MGC08, 07/23/94

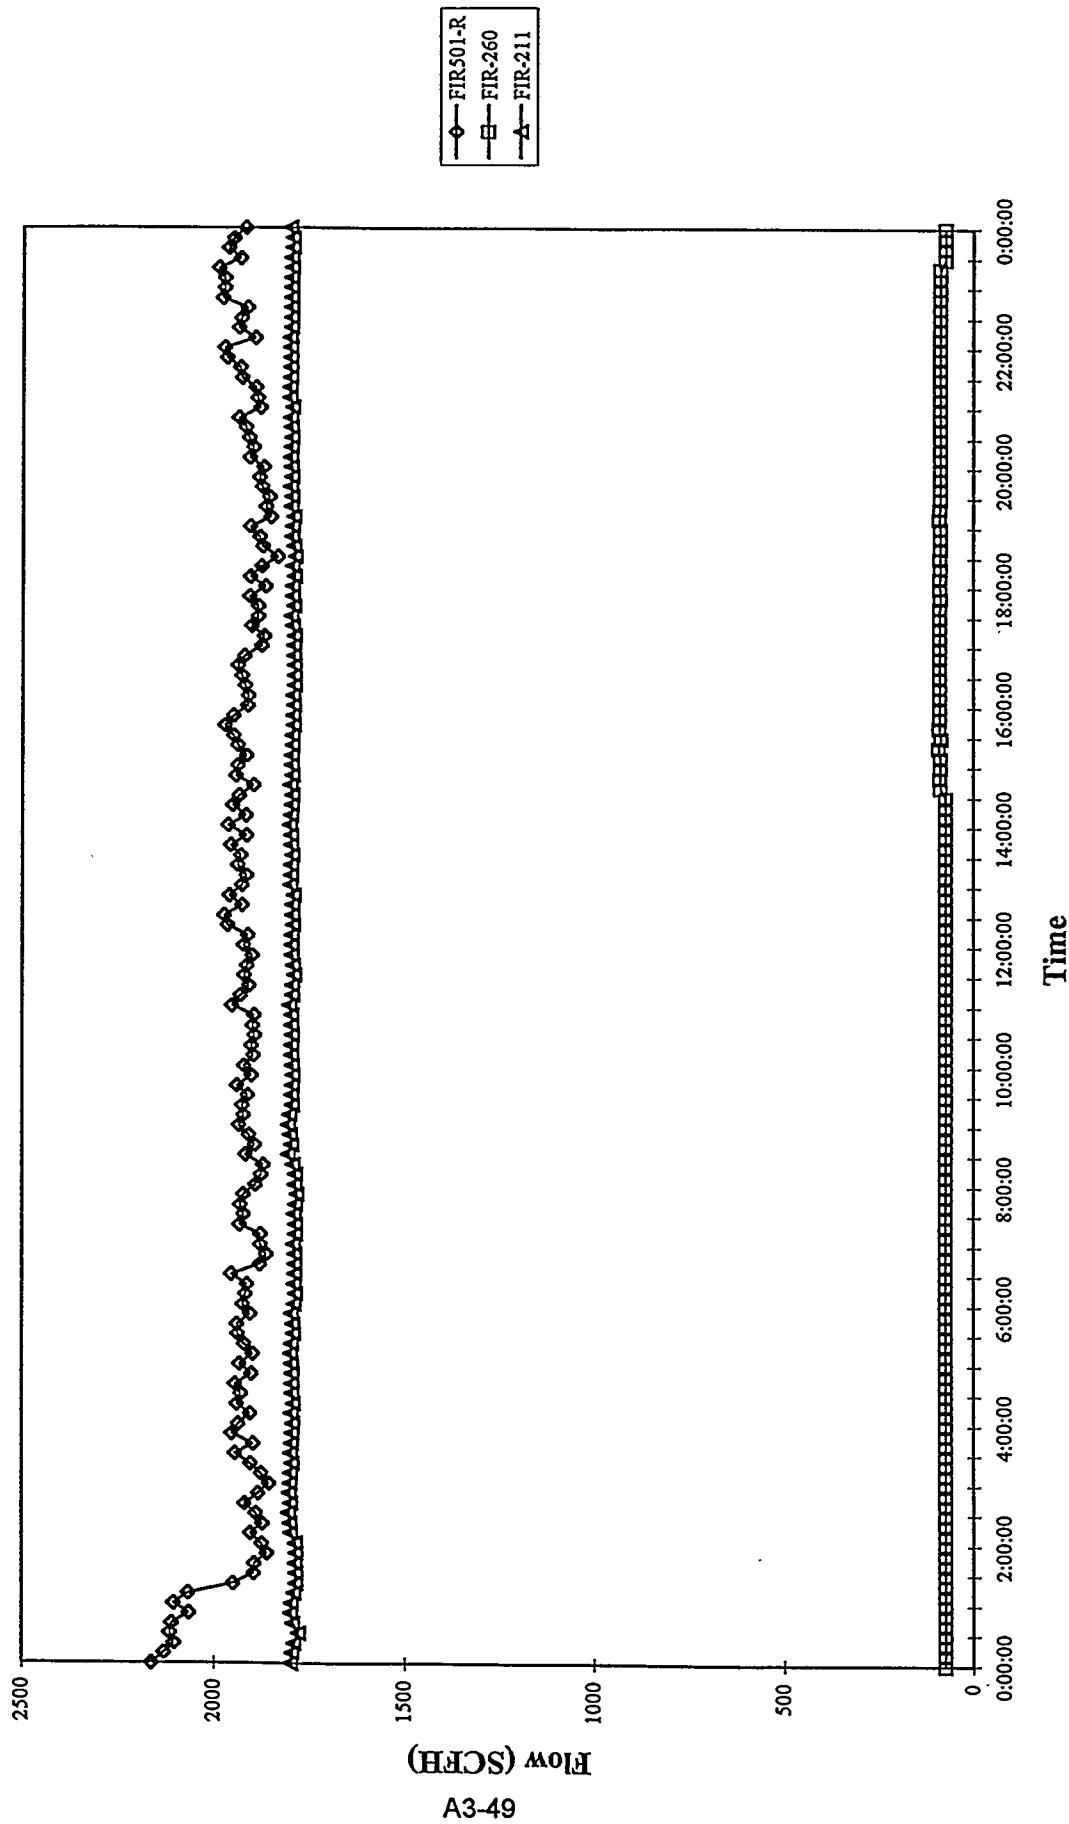

MGCR Inlet and Exit Flows
Run 94MGCR08, 07/24/94

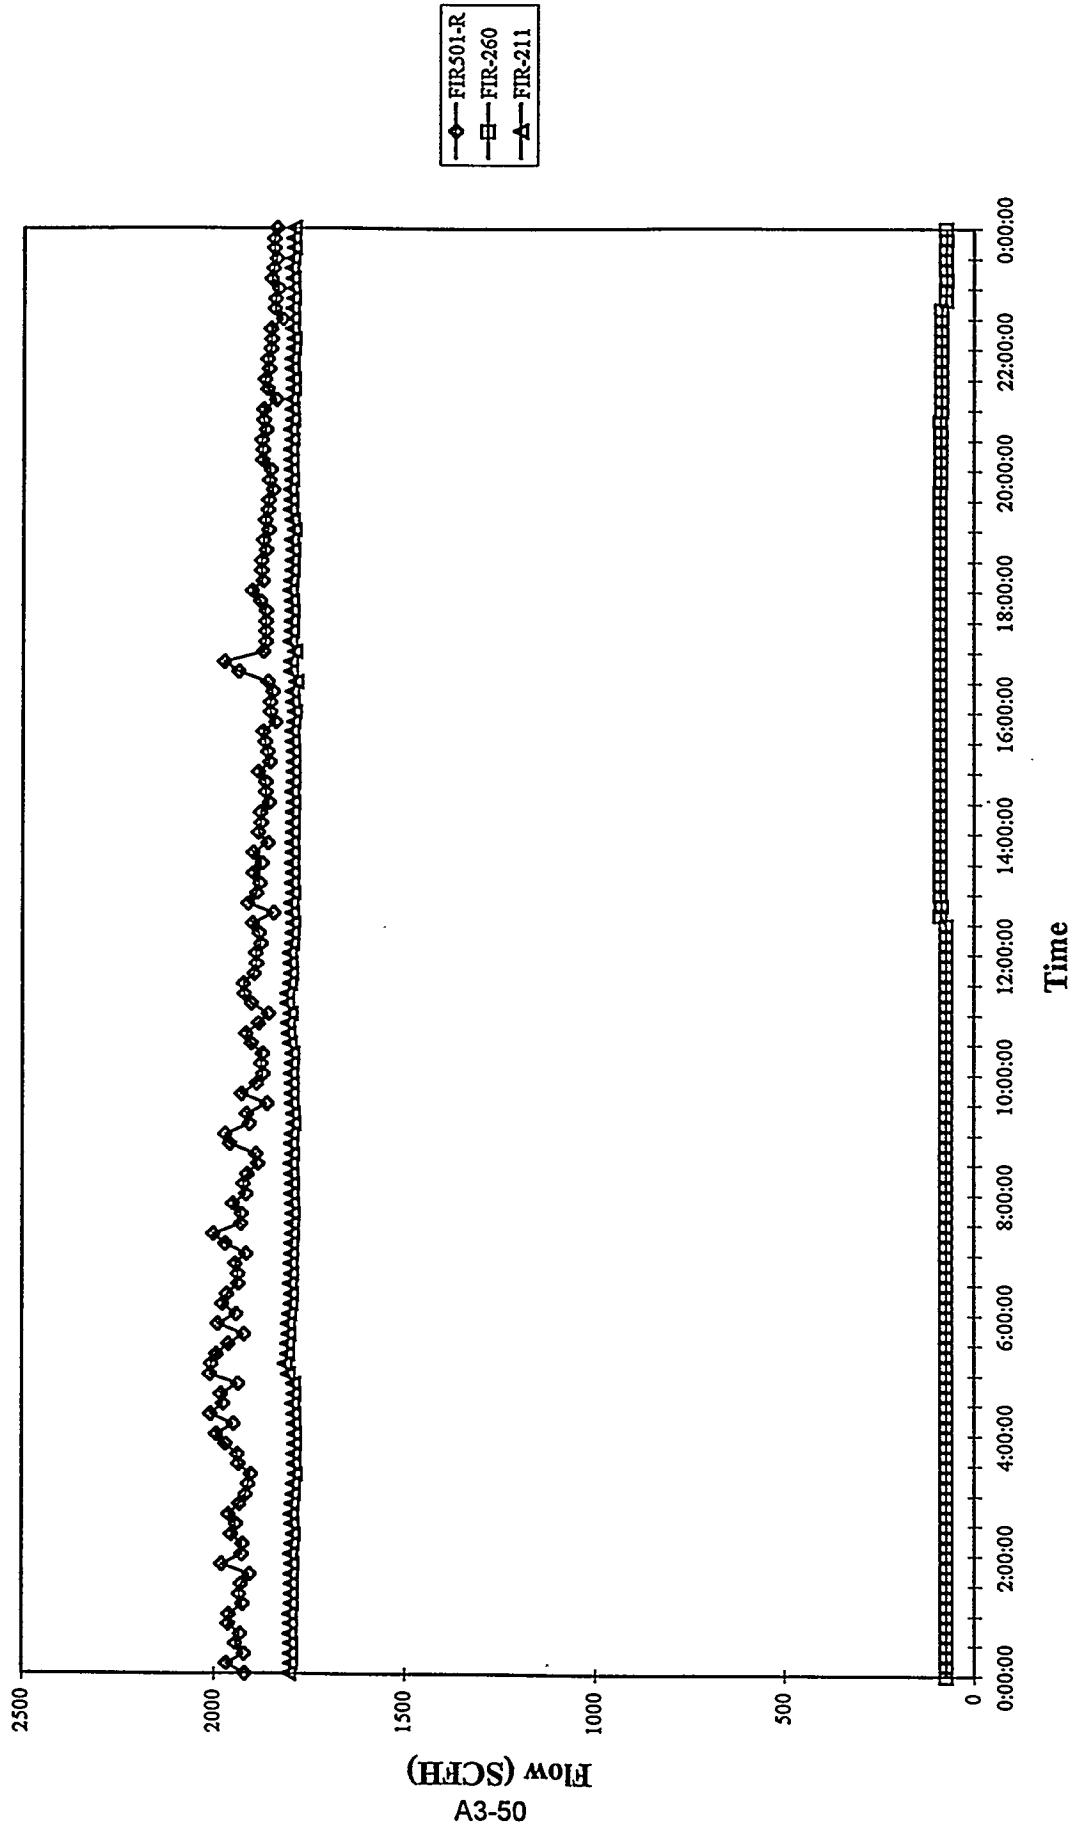


MGCR Inlet and Exit Flows
Run 94MGC08, 07/25/94

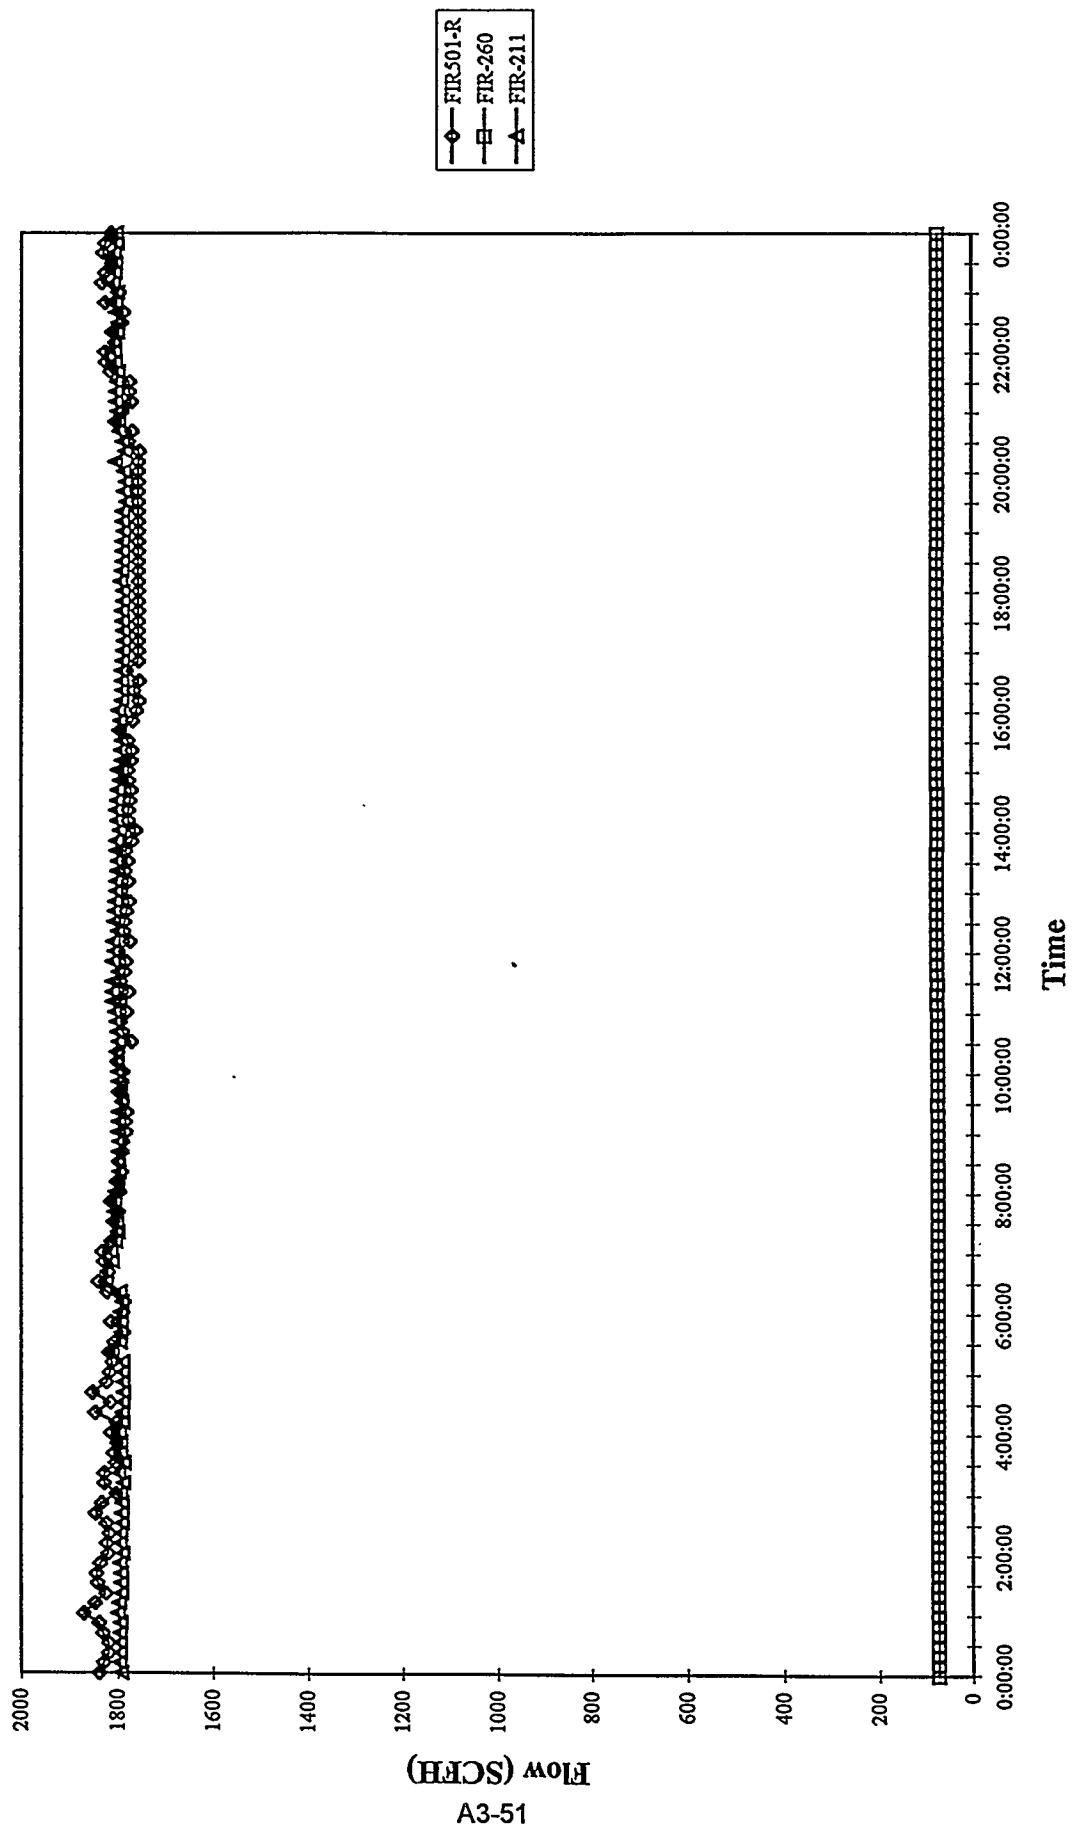


Flow (SCFH)

A3-51


MGCR Inlet and Exit Flows
Run 94MGC08, 07/26/94

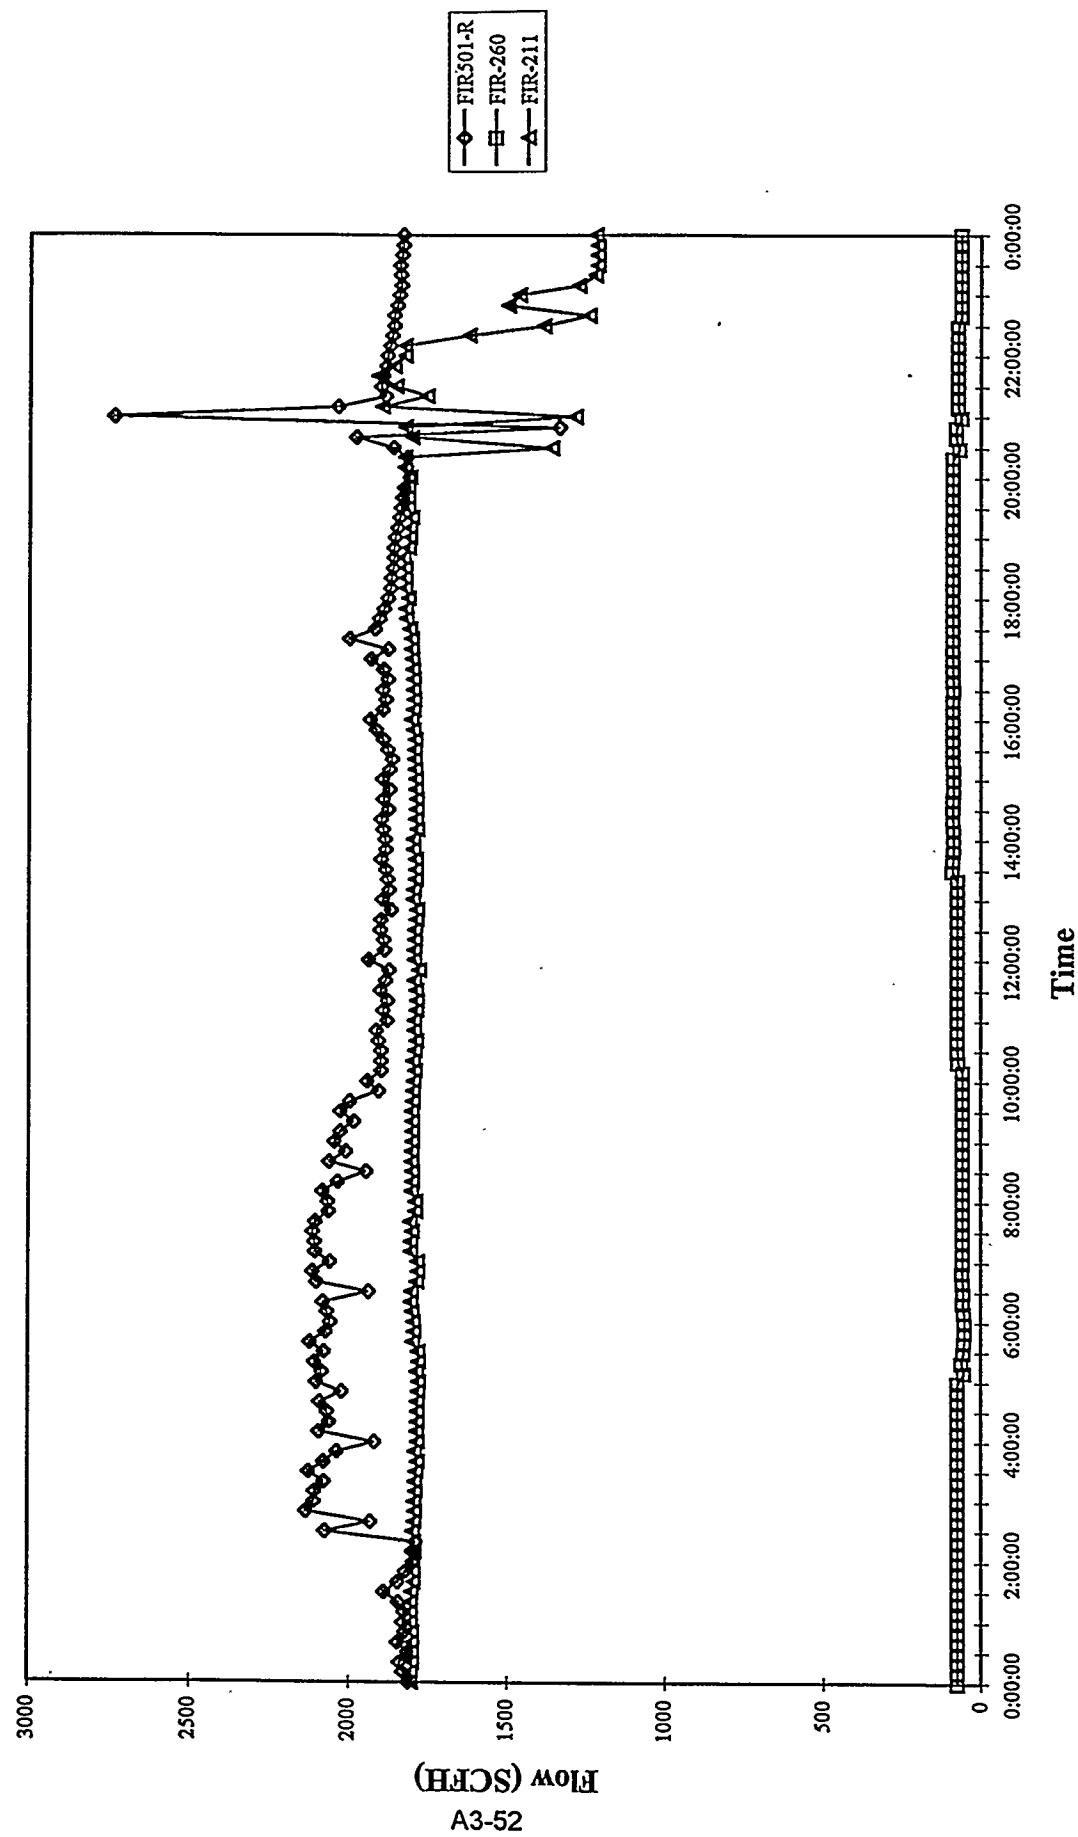


MGCR Inlet and Exit Flows
Run 94MGC08, 07/27/94

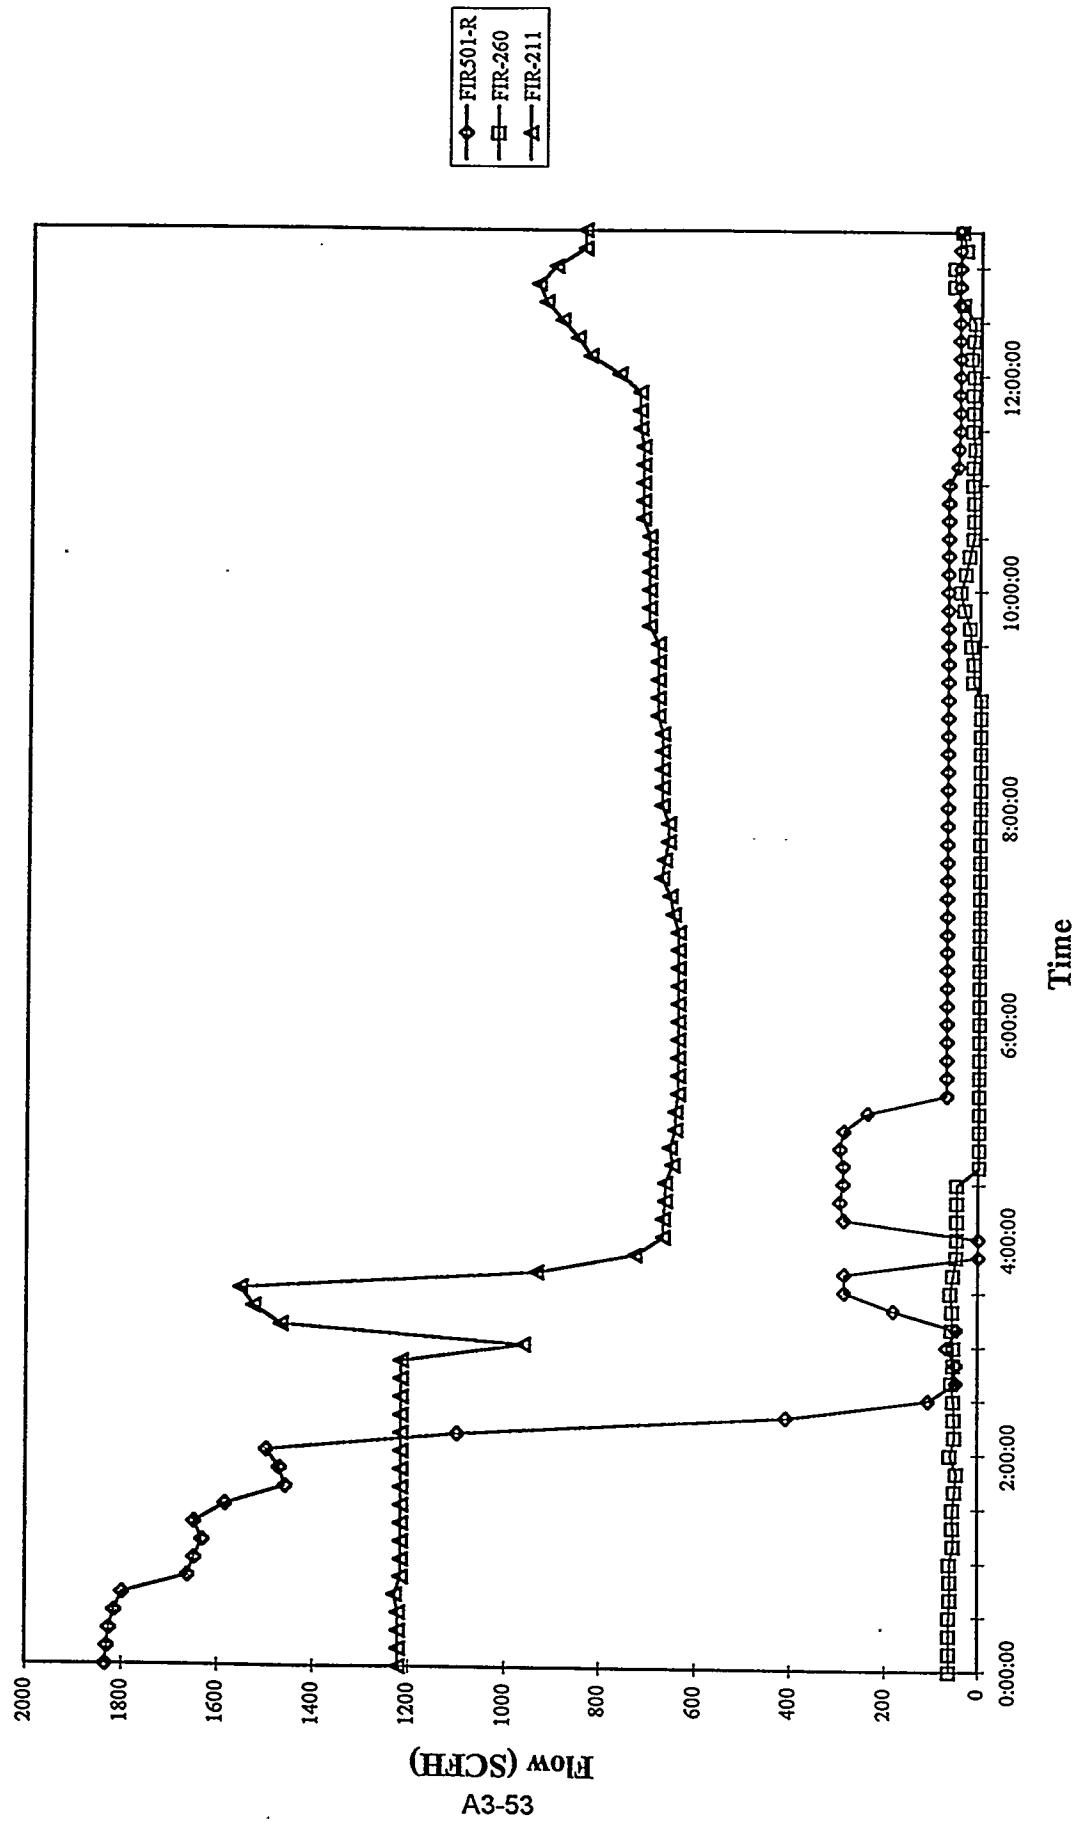

MGCR Process Gas Line Temperatures
Run 94MGC08, 07/18/94

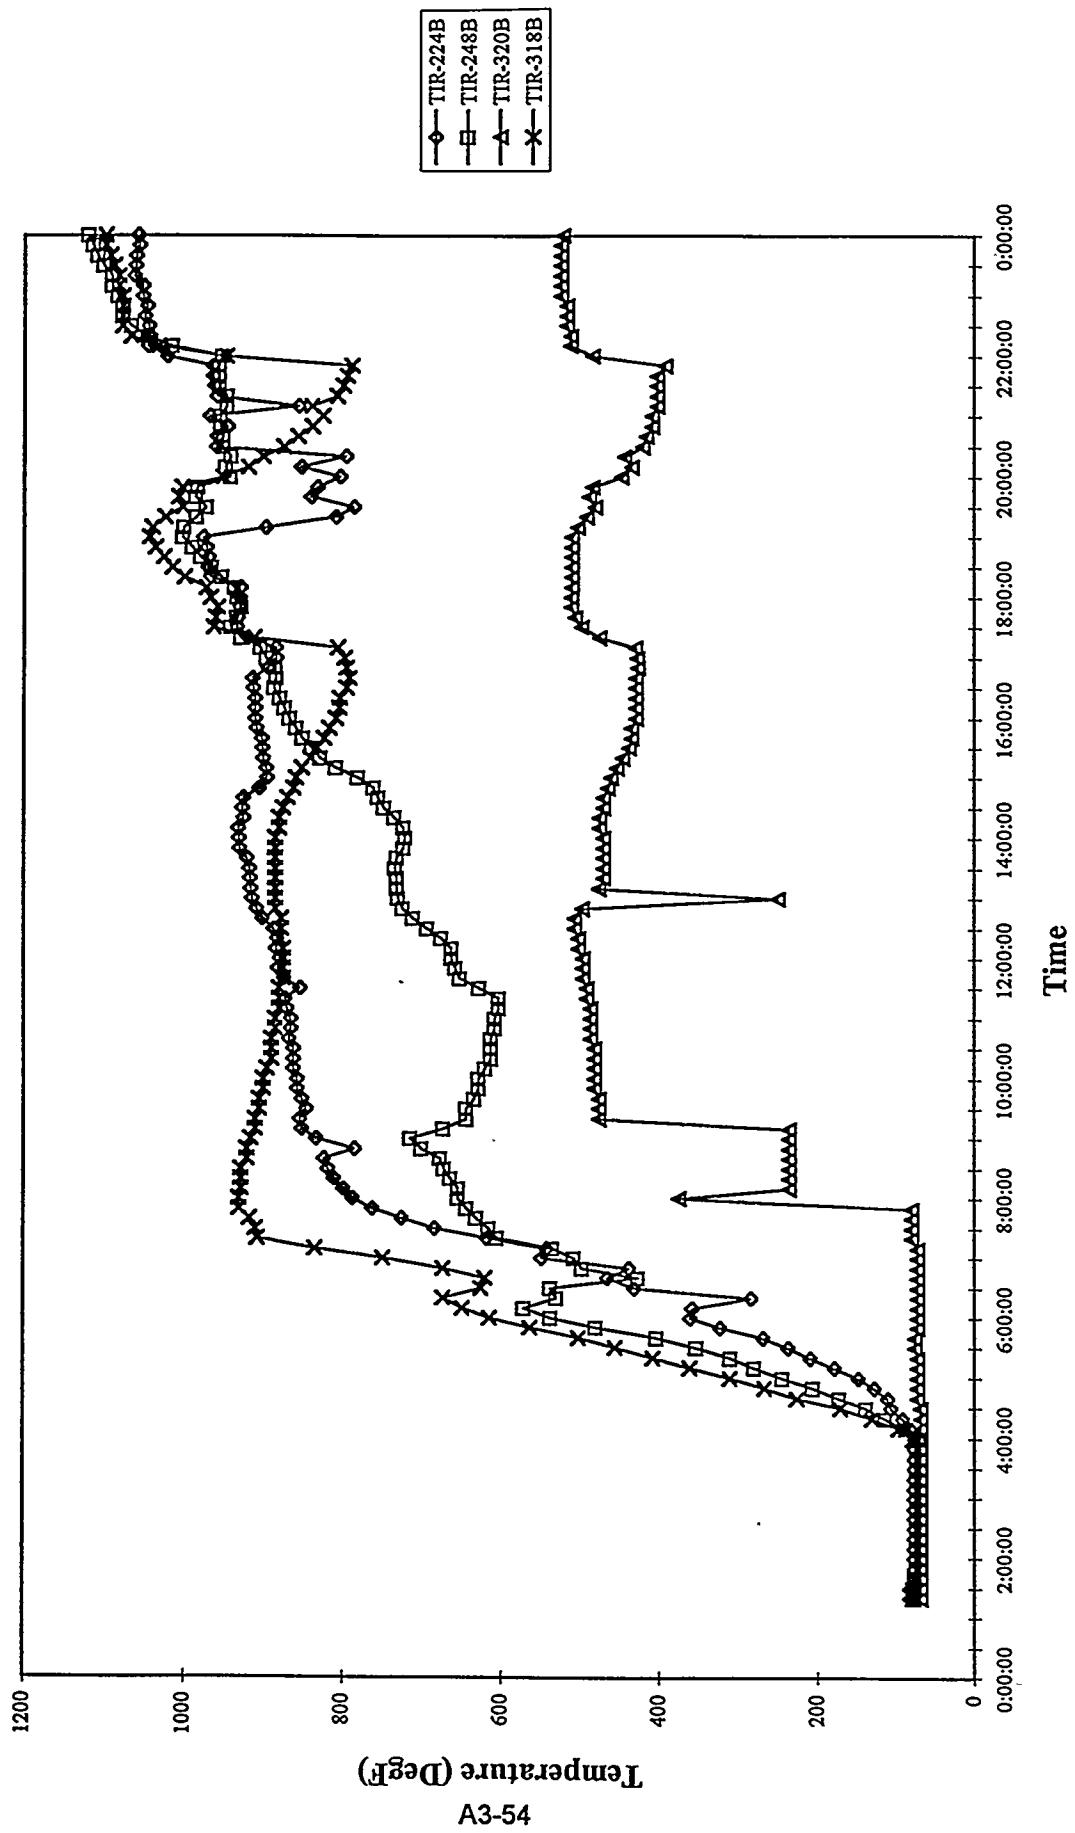


MGCR Process Gas Line Temperatures
Run 94MGC08, 07/19/94

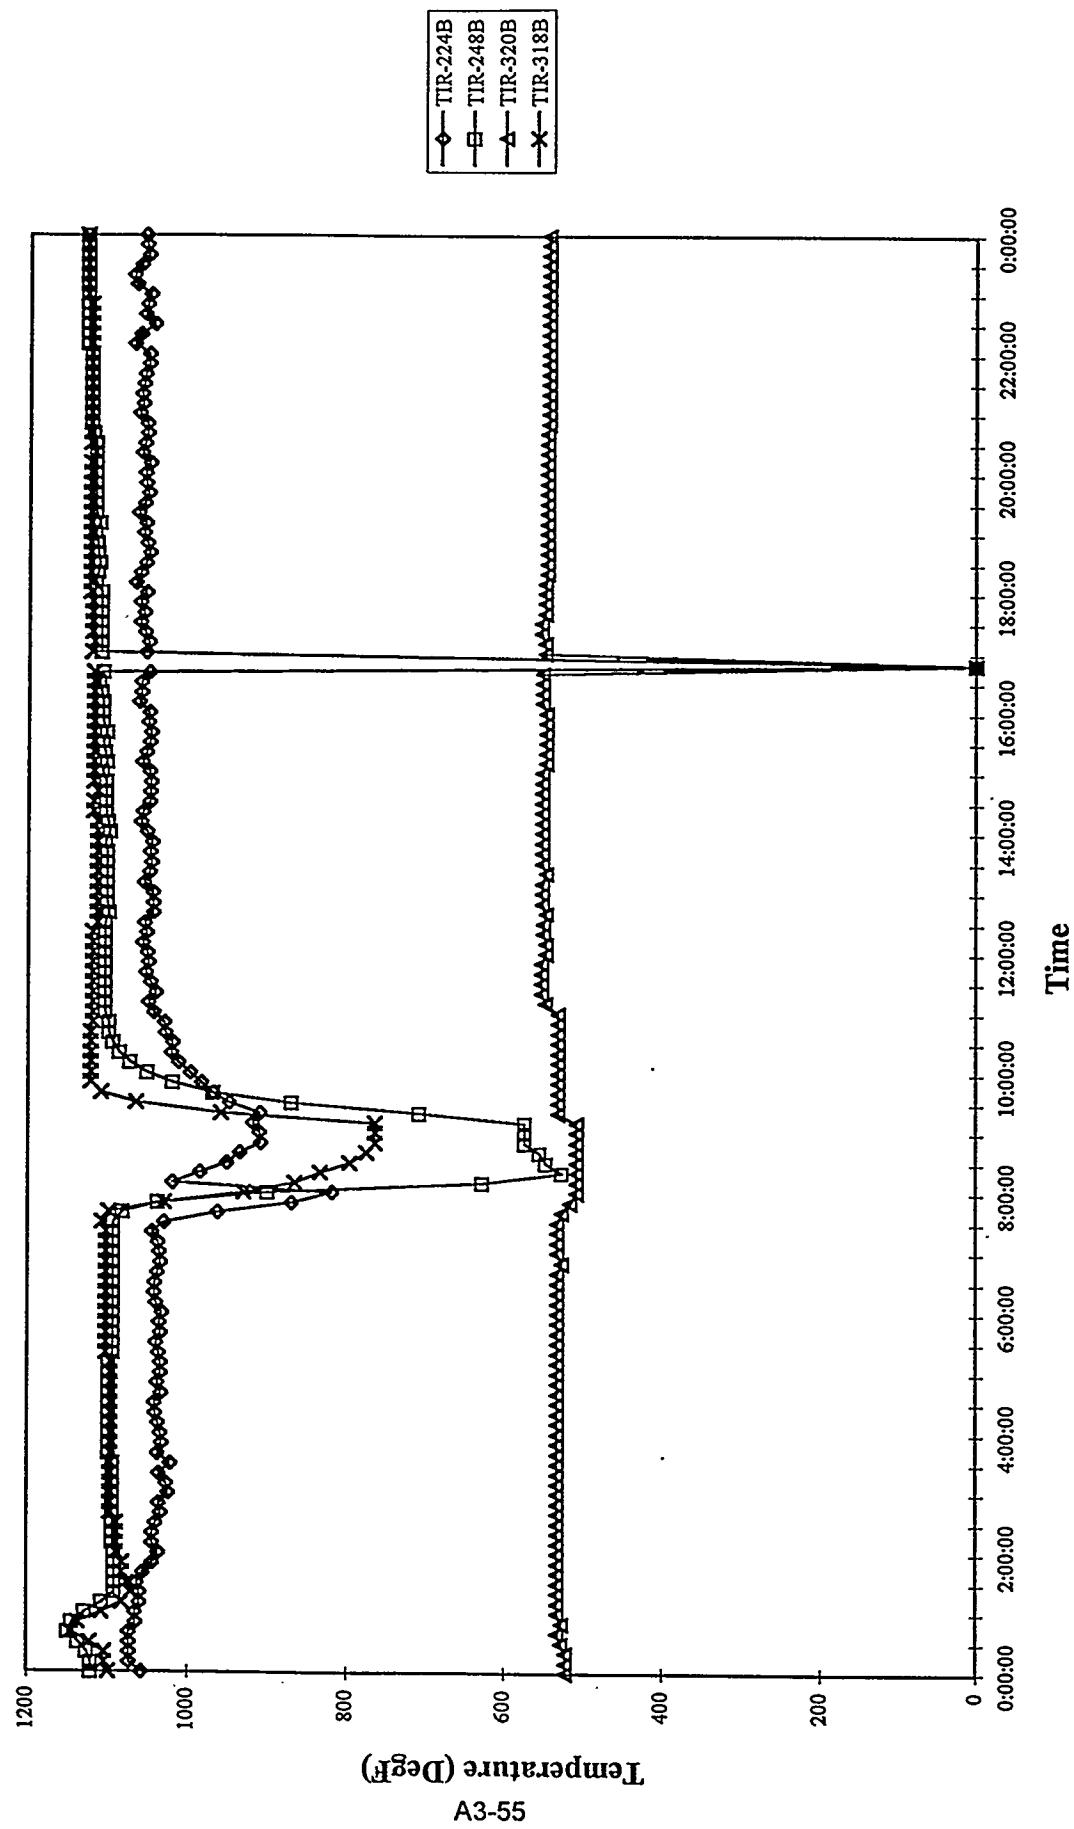

Temperature (Degree)

A3-55


MGCR Process Gas Line Temperatures
Run 94MGC08, 07/20/94

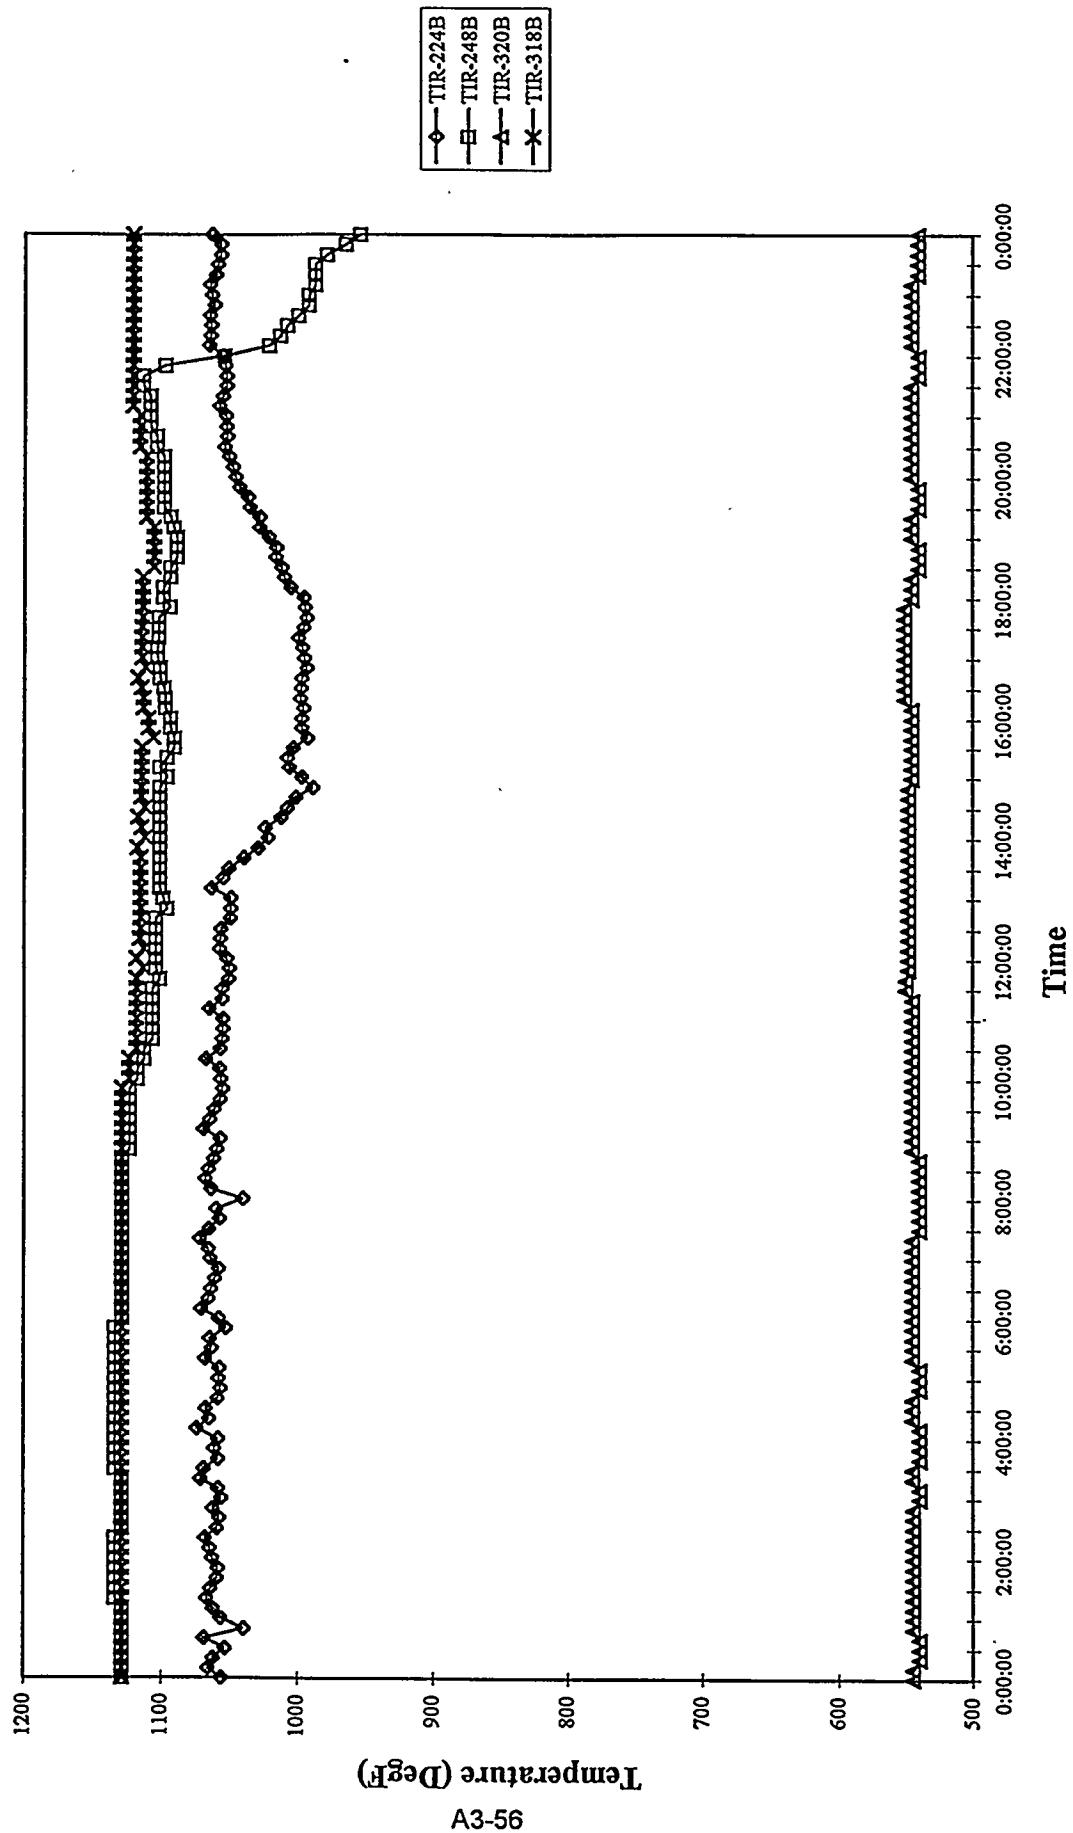


Temperature (Degree F)

A3-56

MGCR Process Gas Line Temperatures
Run 94MGC08, 07/21/94

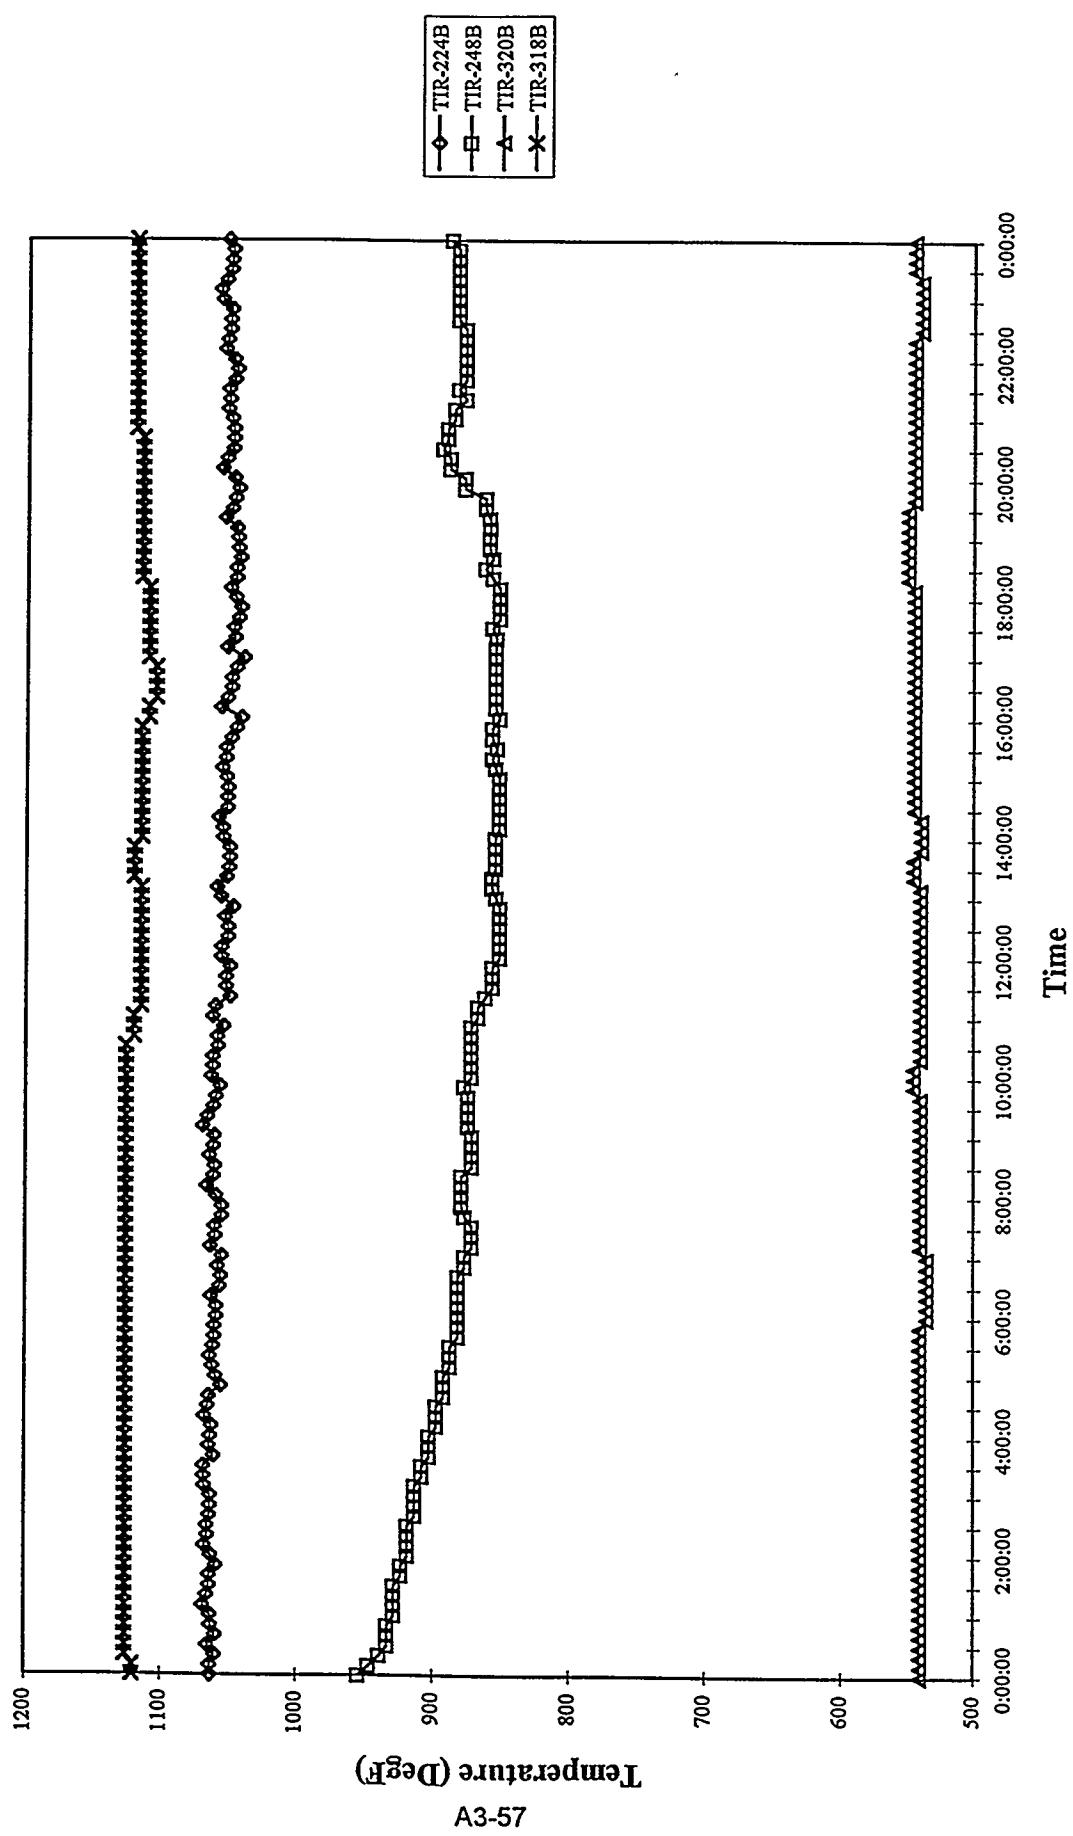


MGCR Process Gas Line Temperatures
Run 94MGC08, 07/22/94

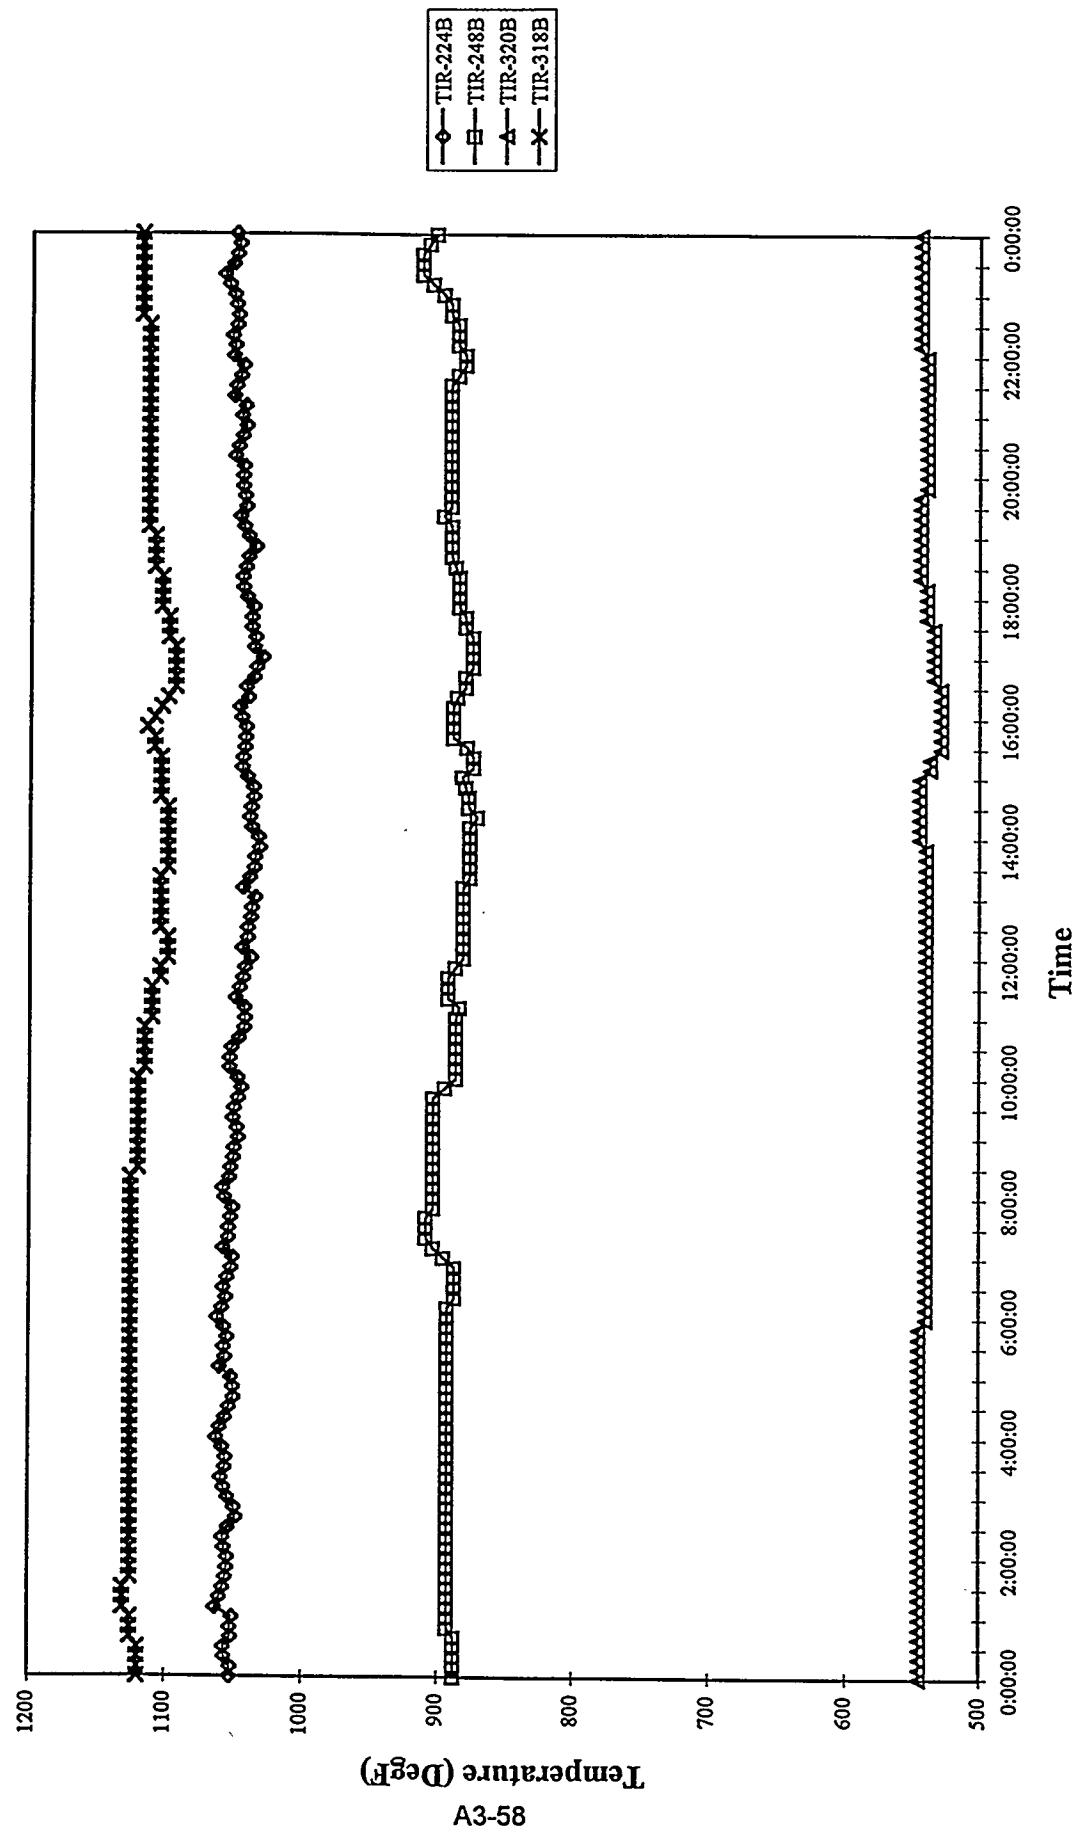


Temperature (Degree F)

A3-58


MGCR Process Gas Line Temperatures
Run 94MGC08, 07/23/94

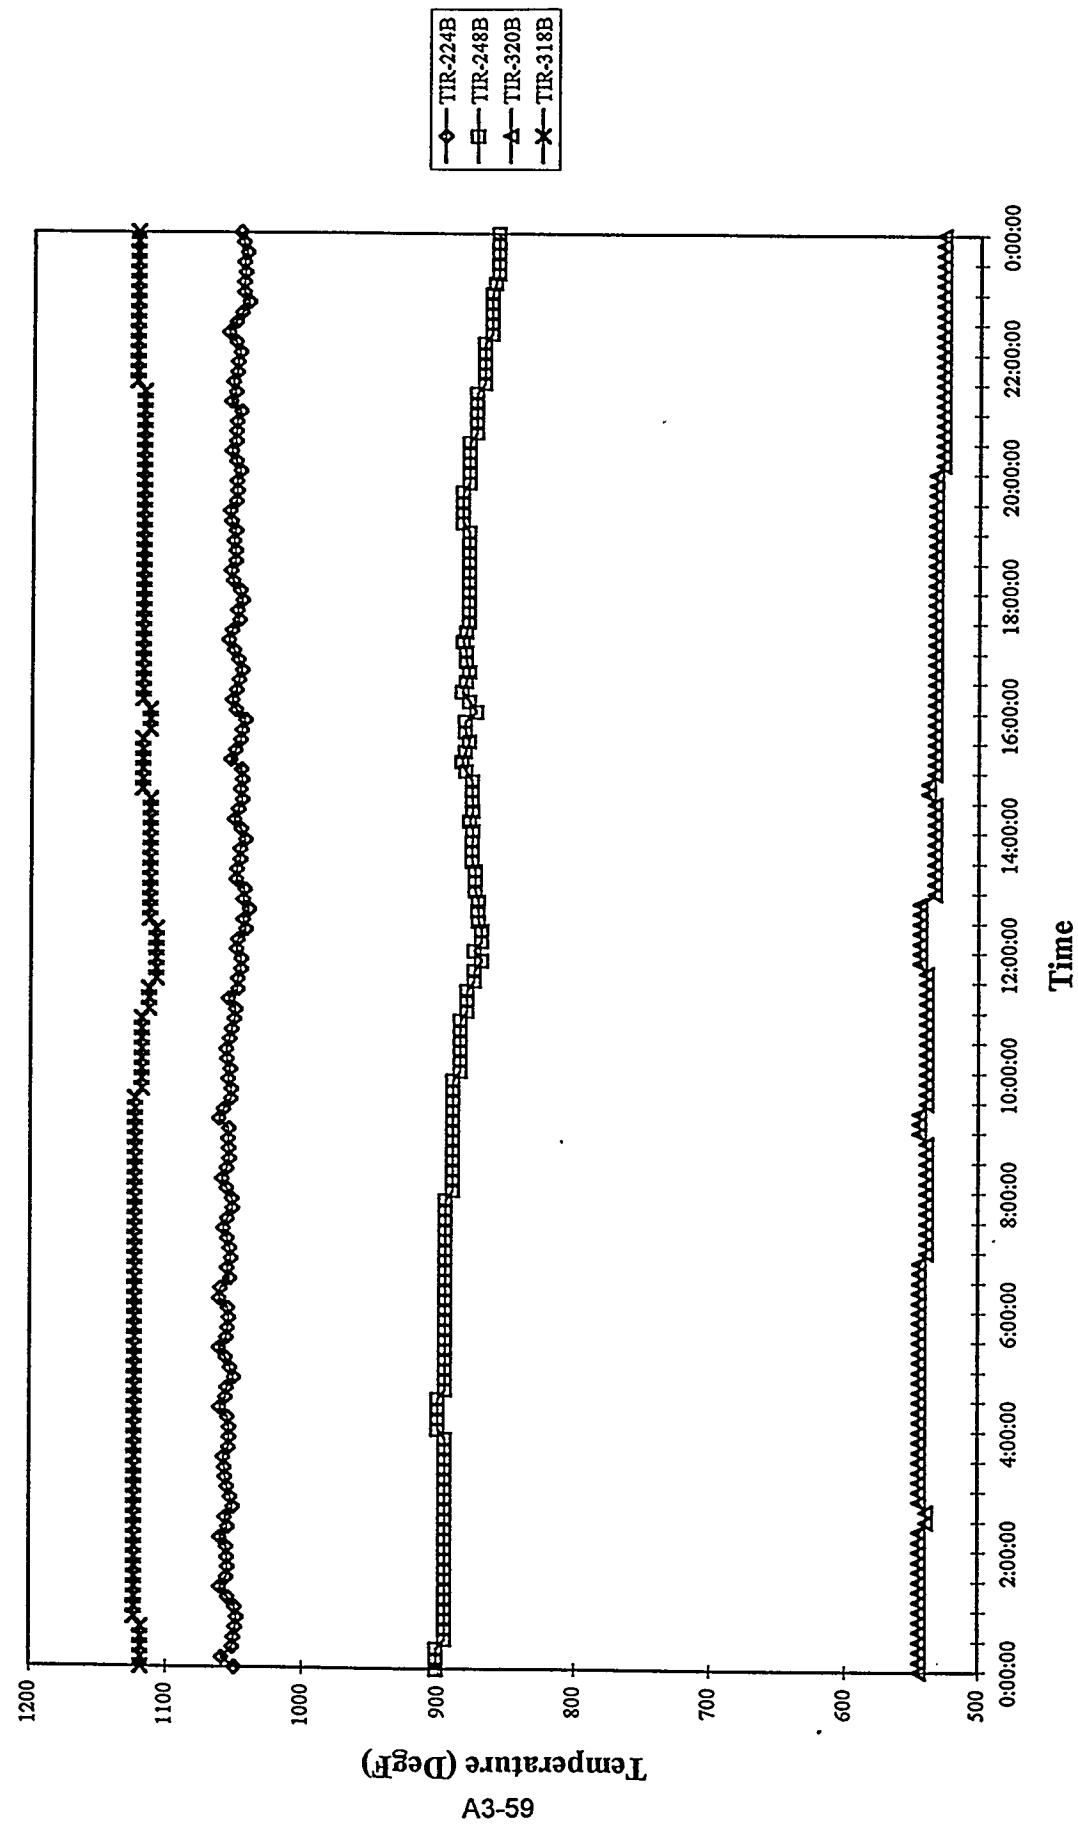


MGCR Process Gas Line Temperatures
Run 94MGC08, 07/24/94

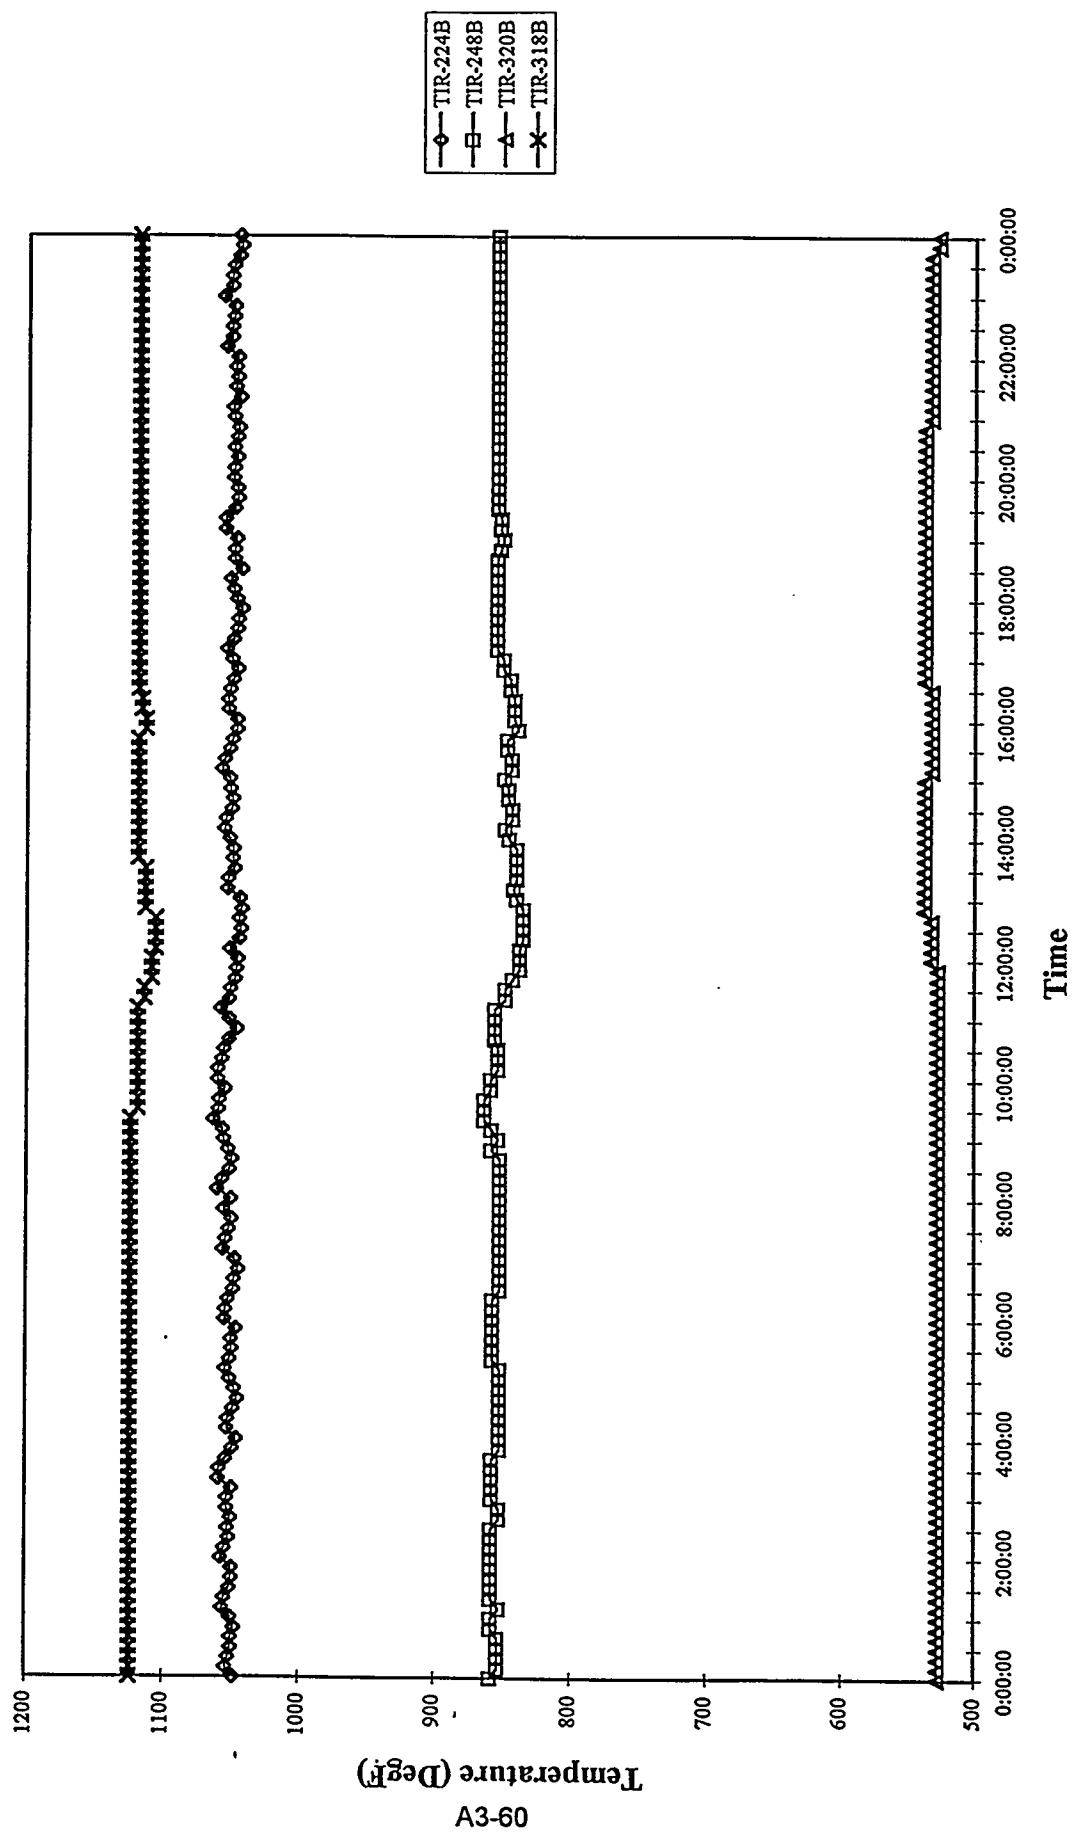


MGCR Process Gas Line Temperatures
Run 94MGC08, 07/25/94

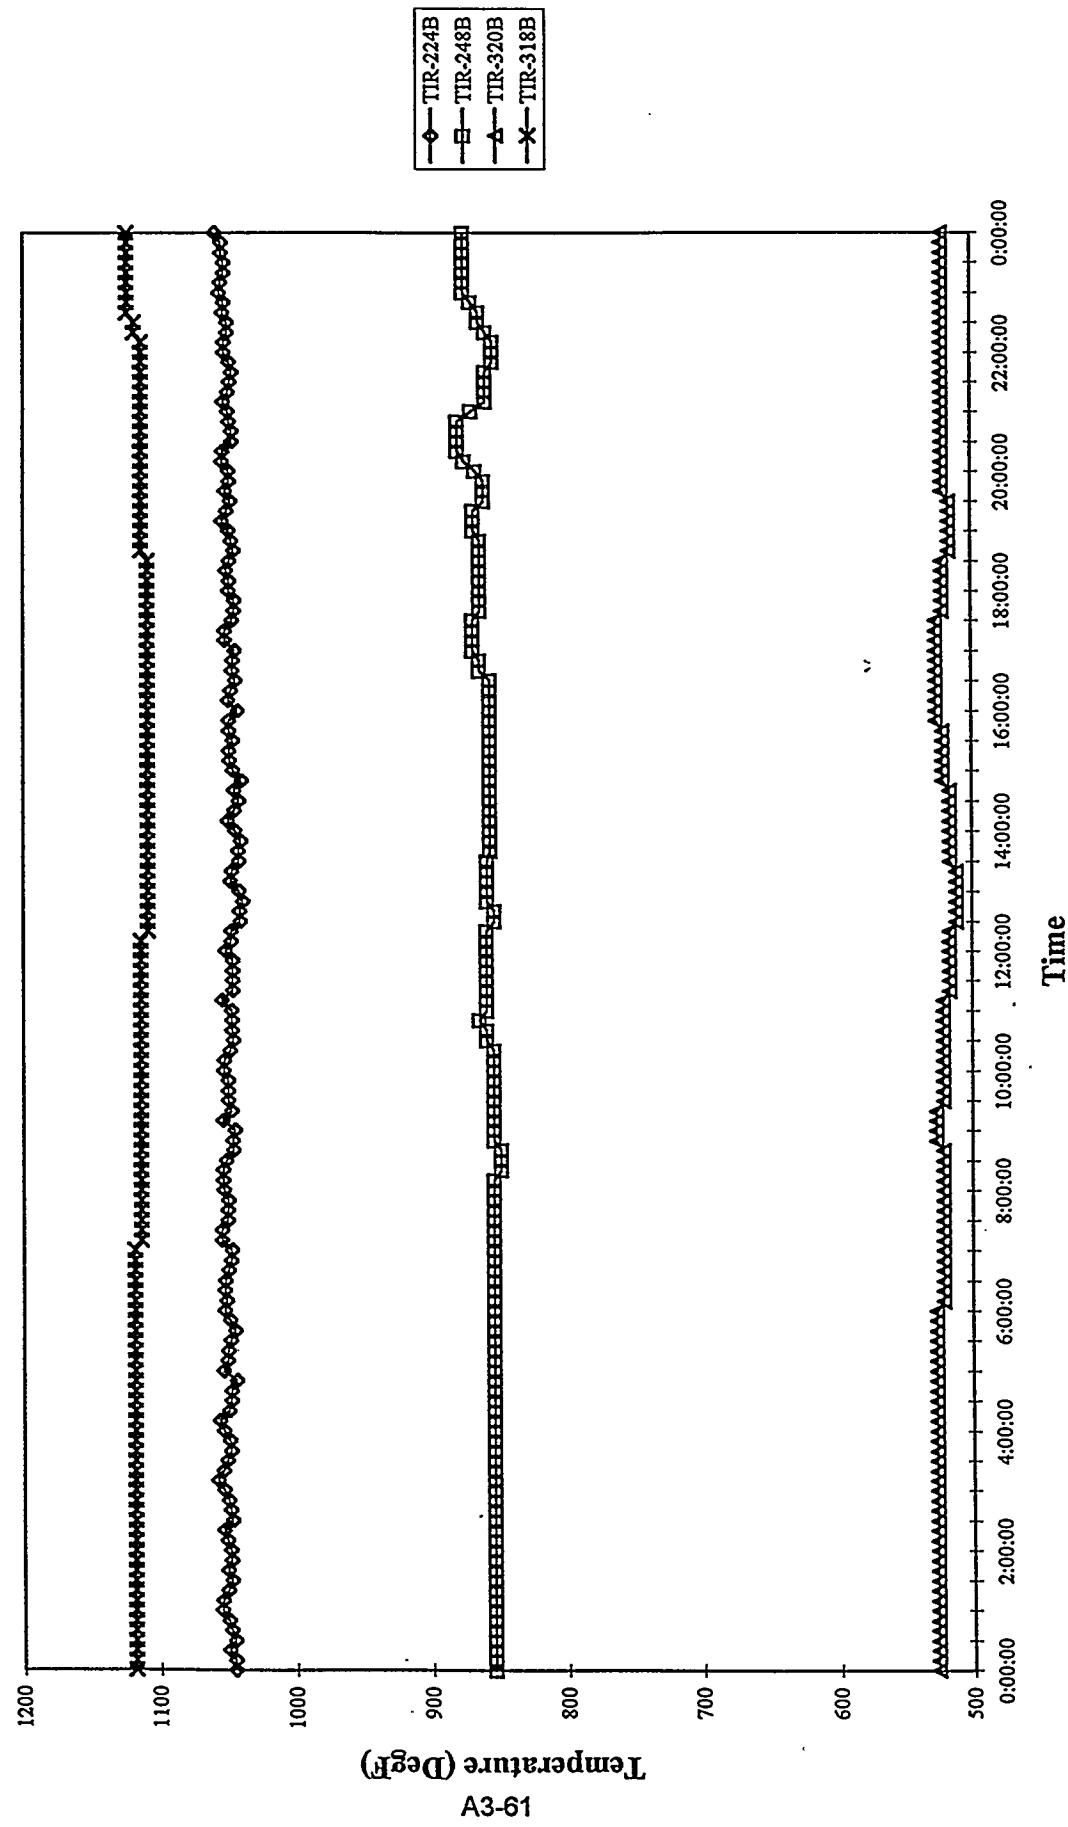


MGCR Process Gas Line Temperatures
Run 94MGC08, 07/26/94

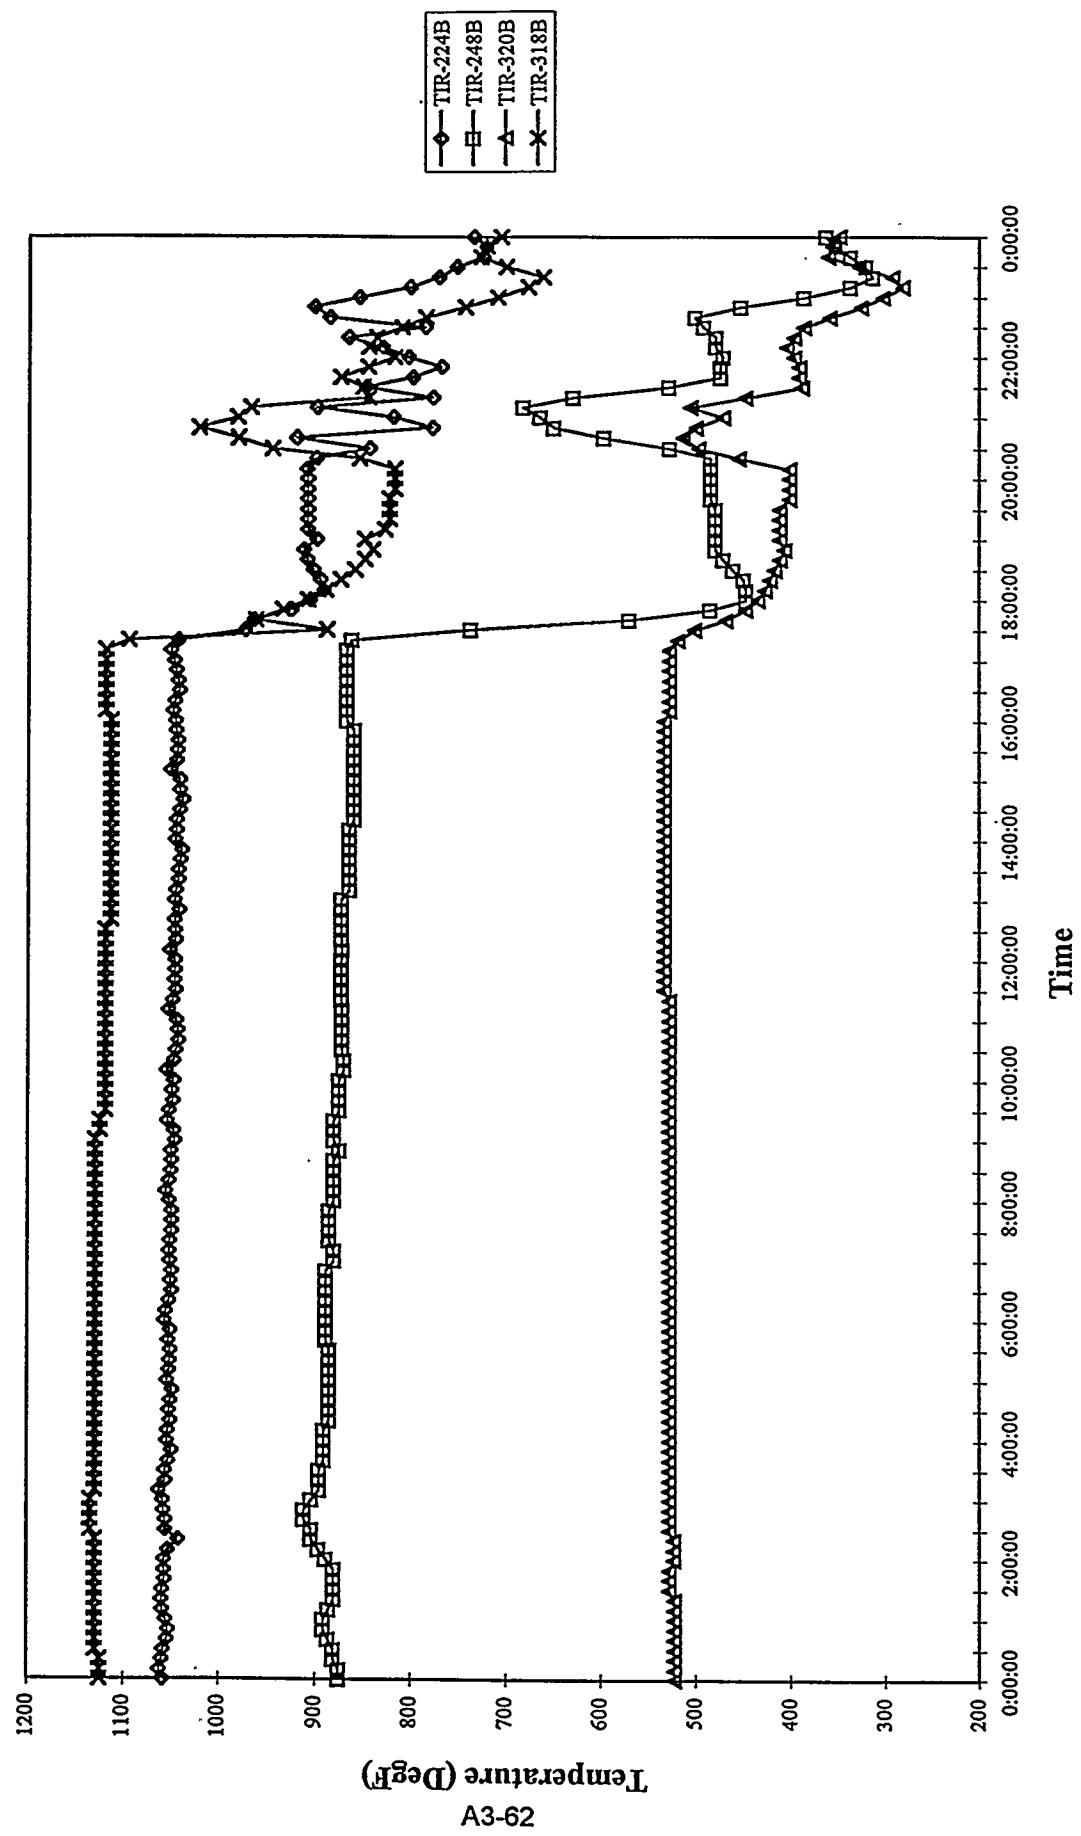


MGCR Process Gas Line Temperatures
Run 94MGC08, 07/27/94

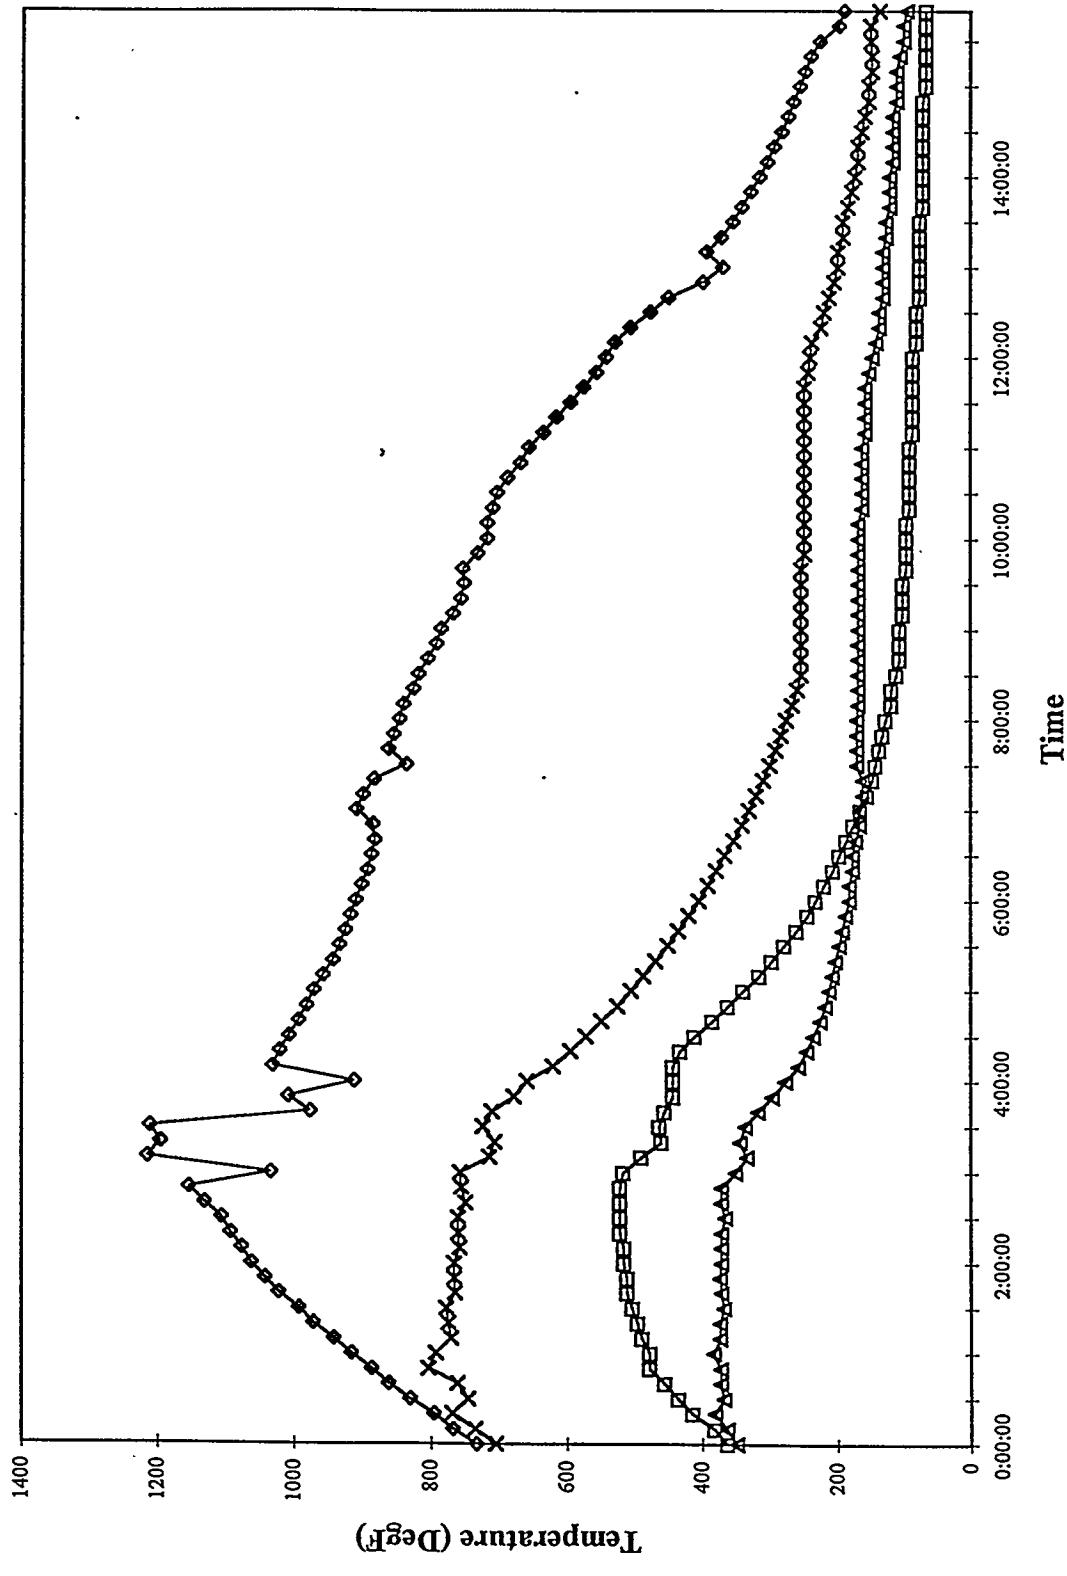


MGCR and FBG Process Pressures
Run 94MGC08, 07/18/94

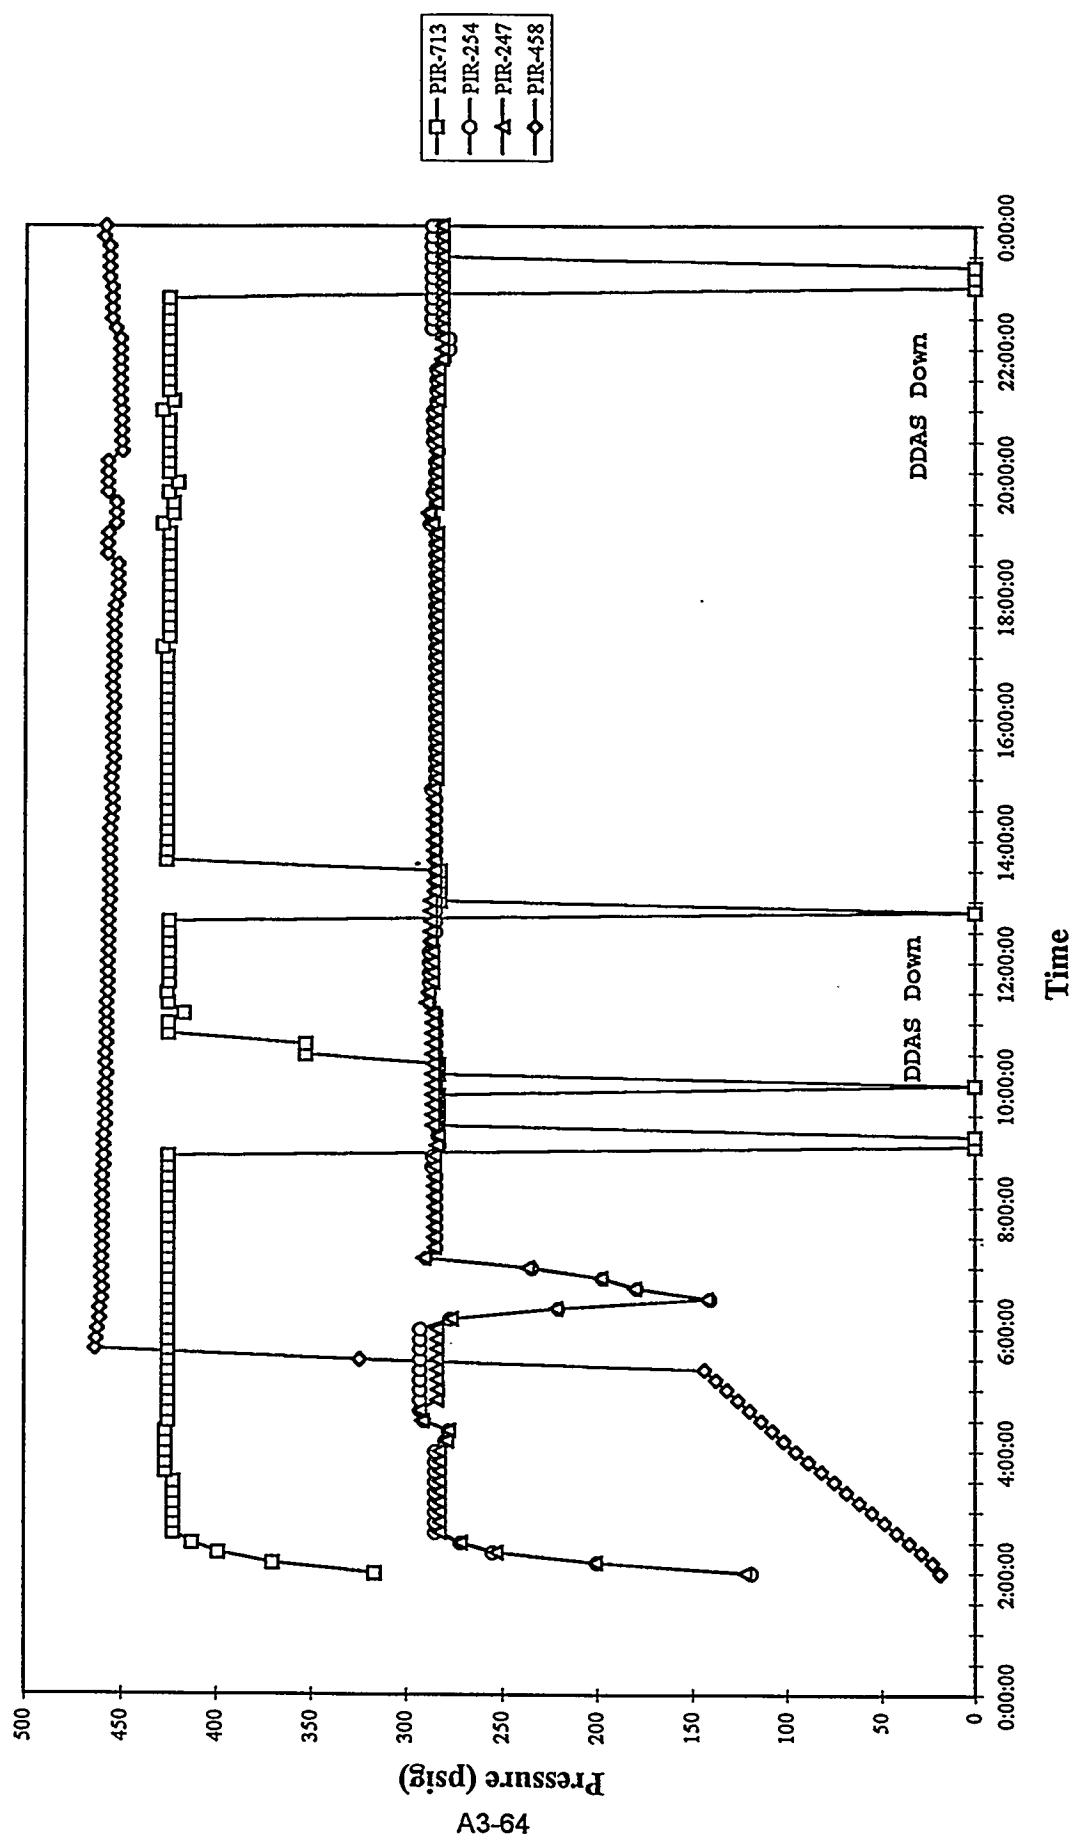


MGCR and FBG Process Pressures
Run 94MGC08, 07/19/94

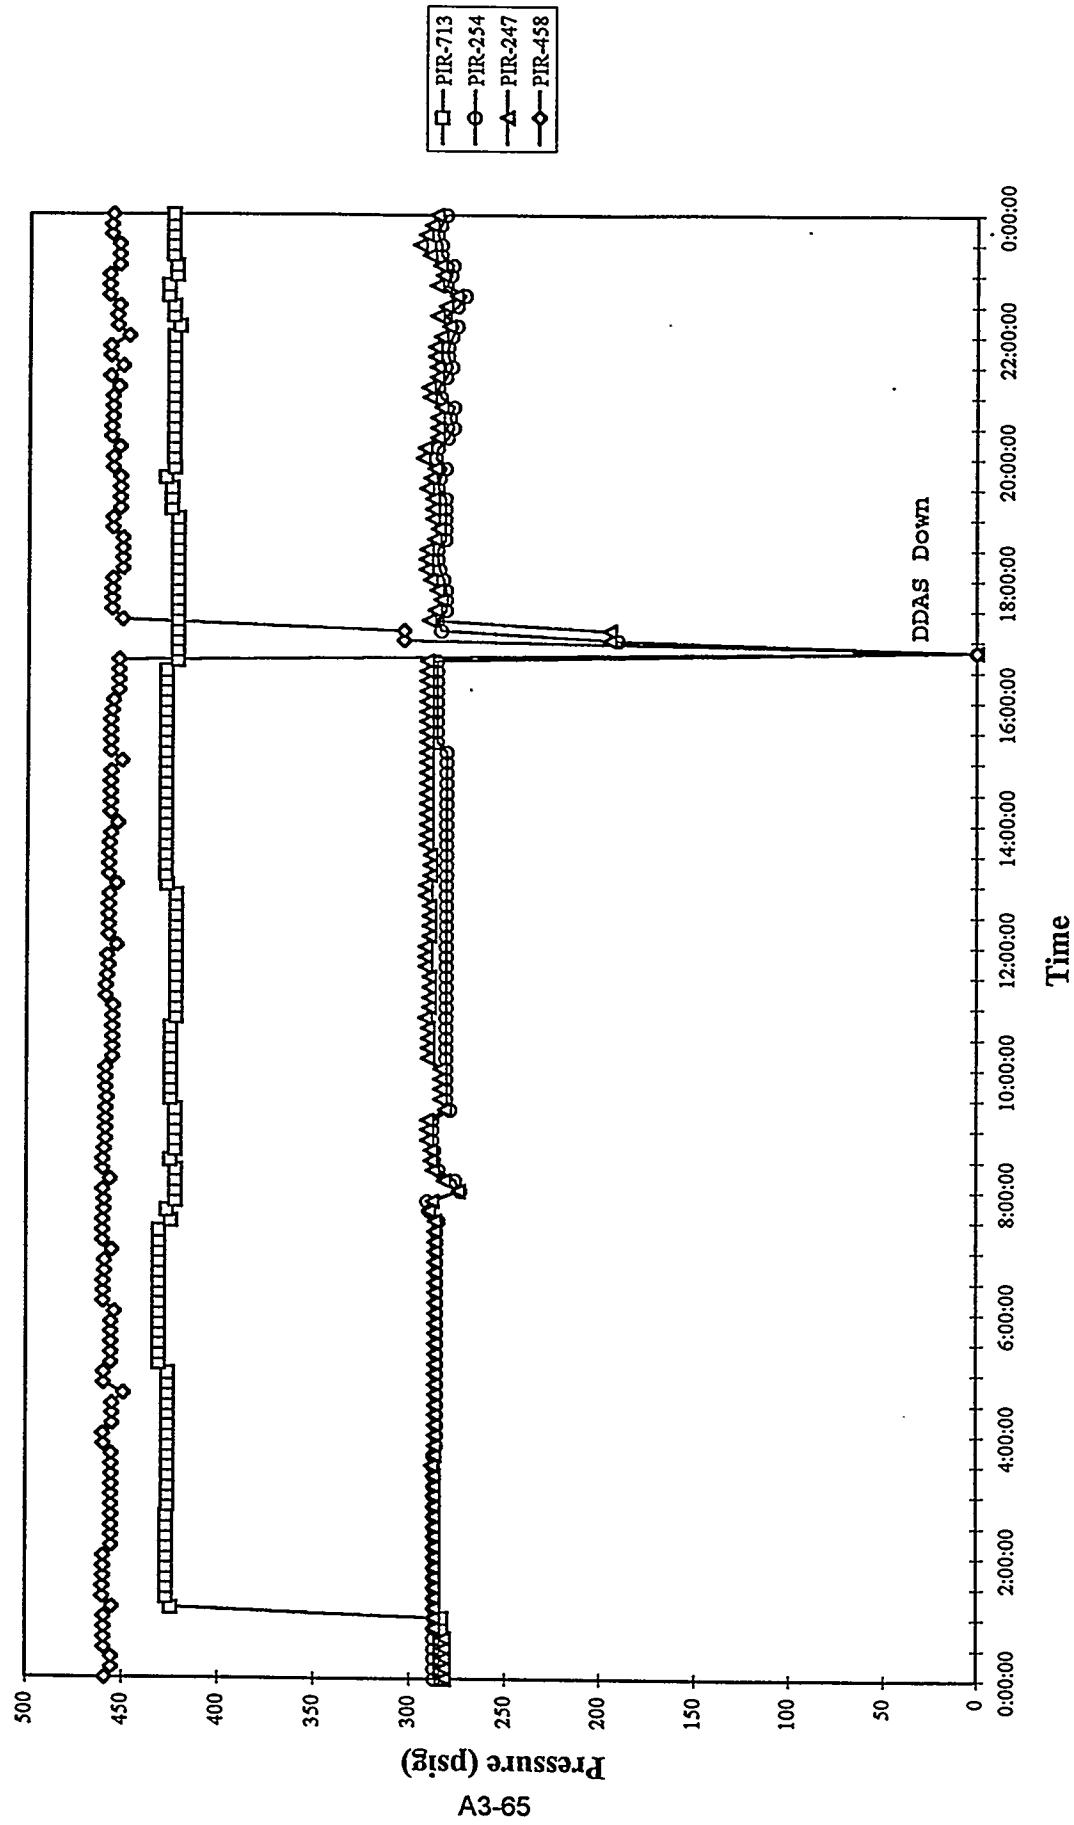


MGCR and FBG Process Pressures
Run 94MGC08, 07/20/94

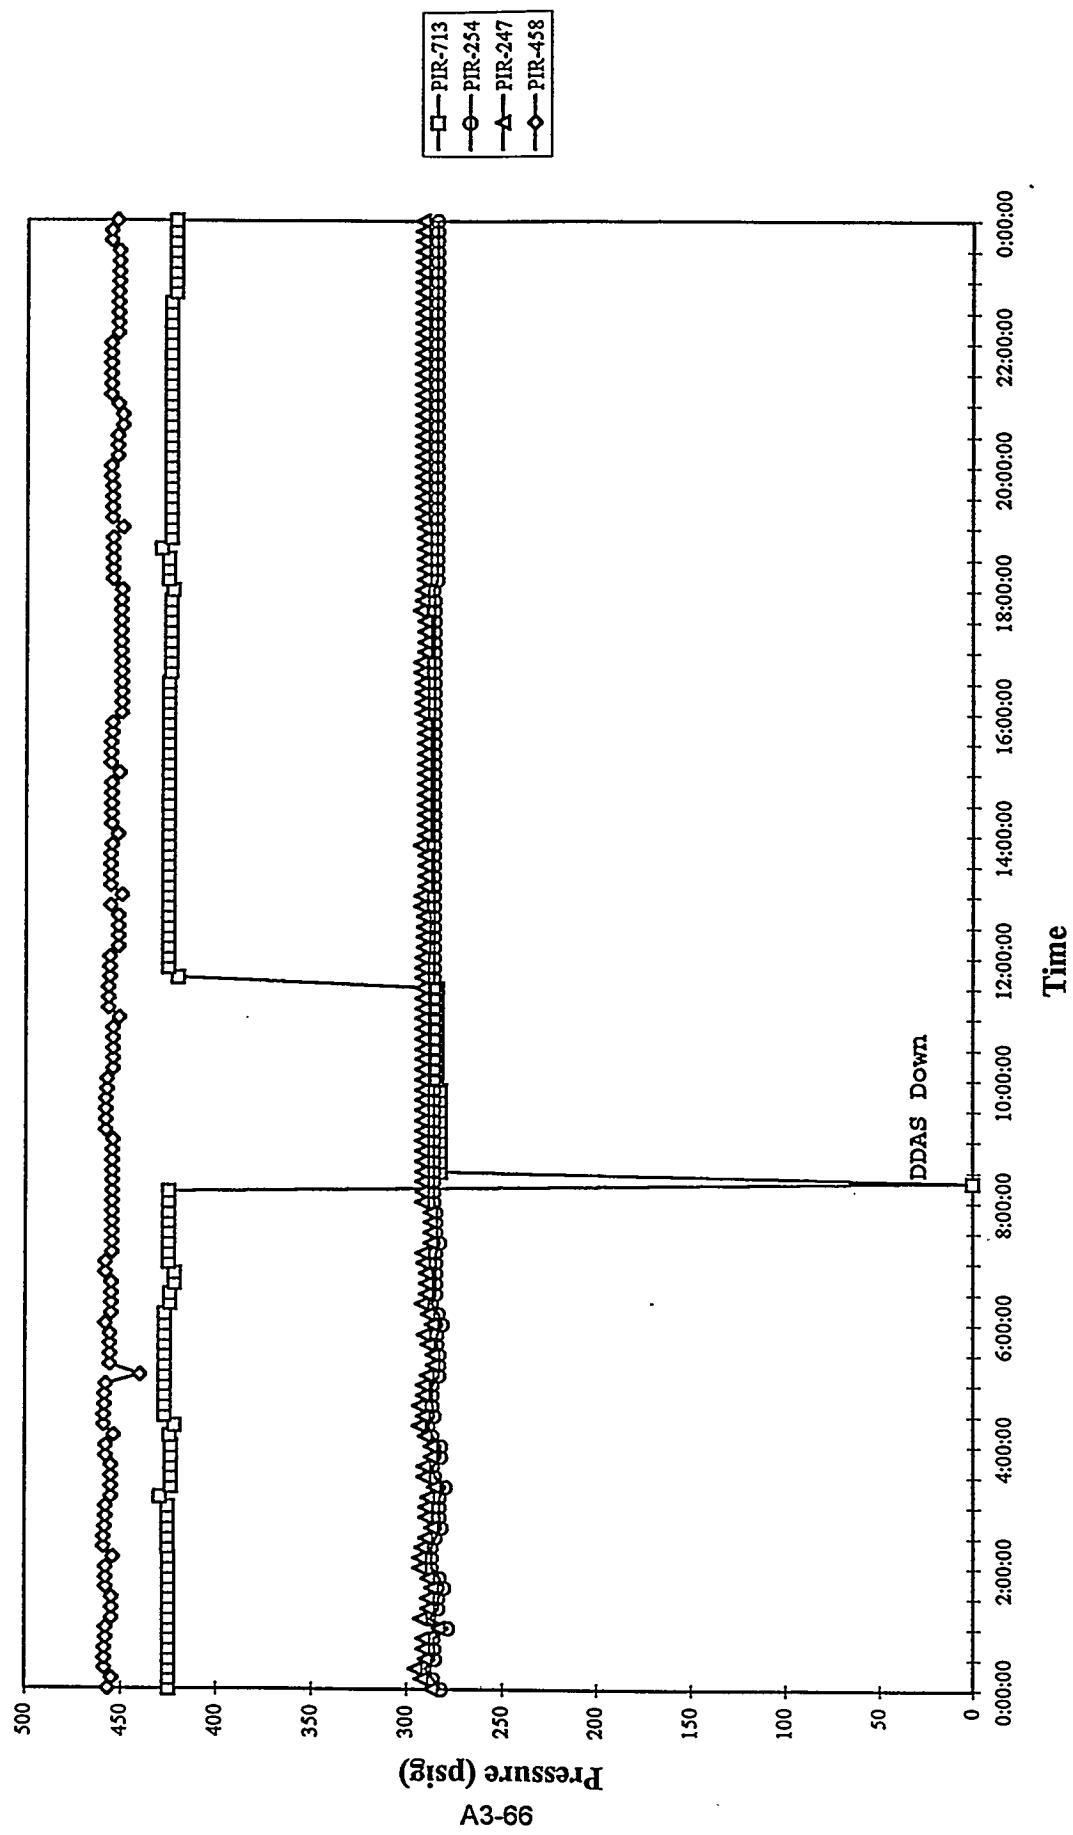


MGCR and FBG Process Pressures
Run 94MGC08, 07/21/94

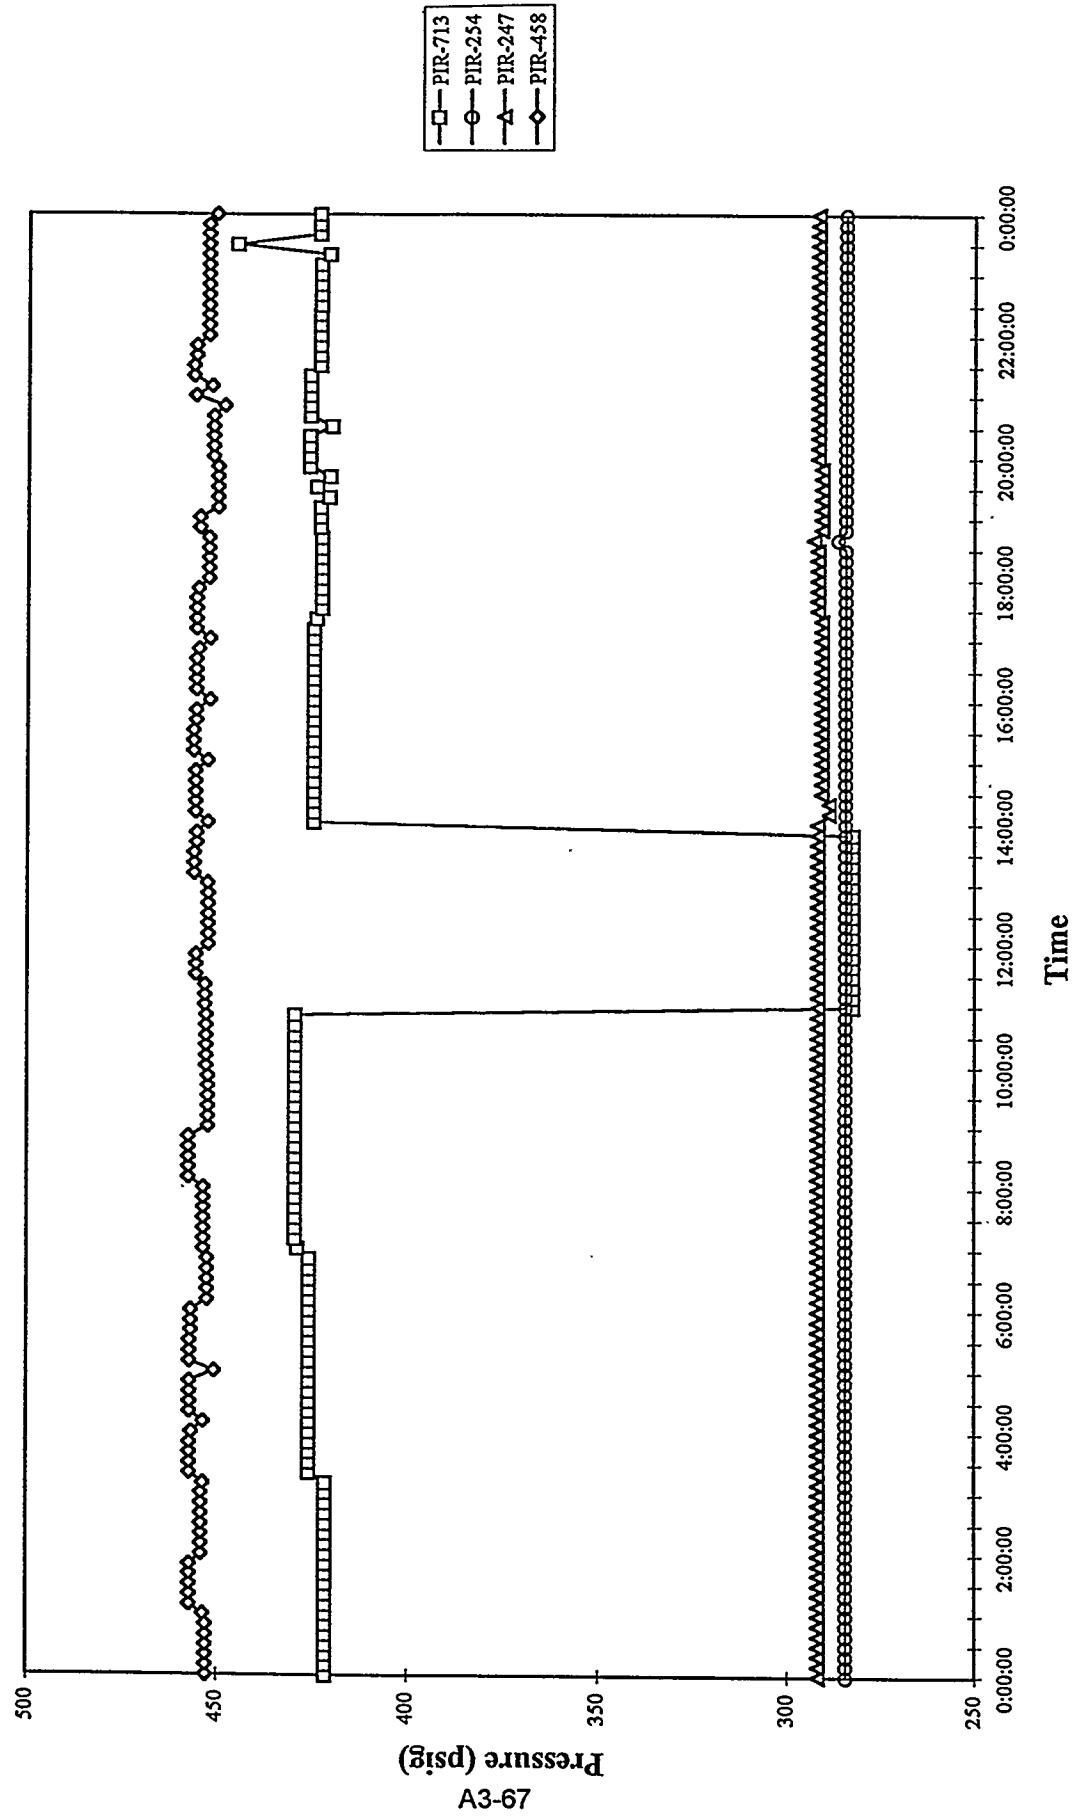


MGCR and FBG Process Pressures
Run 94MGC08, 07/22/94

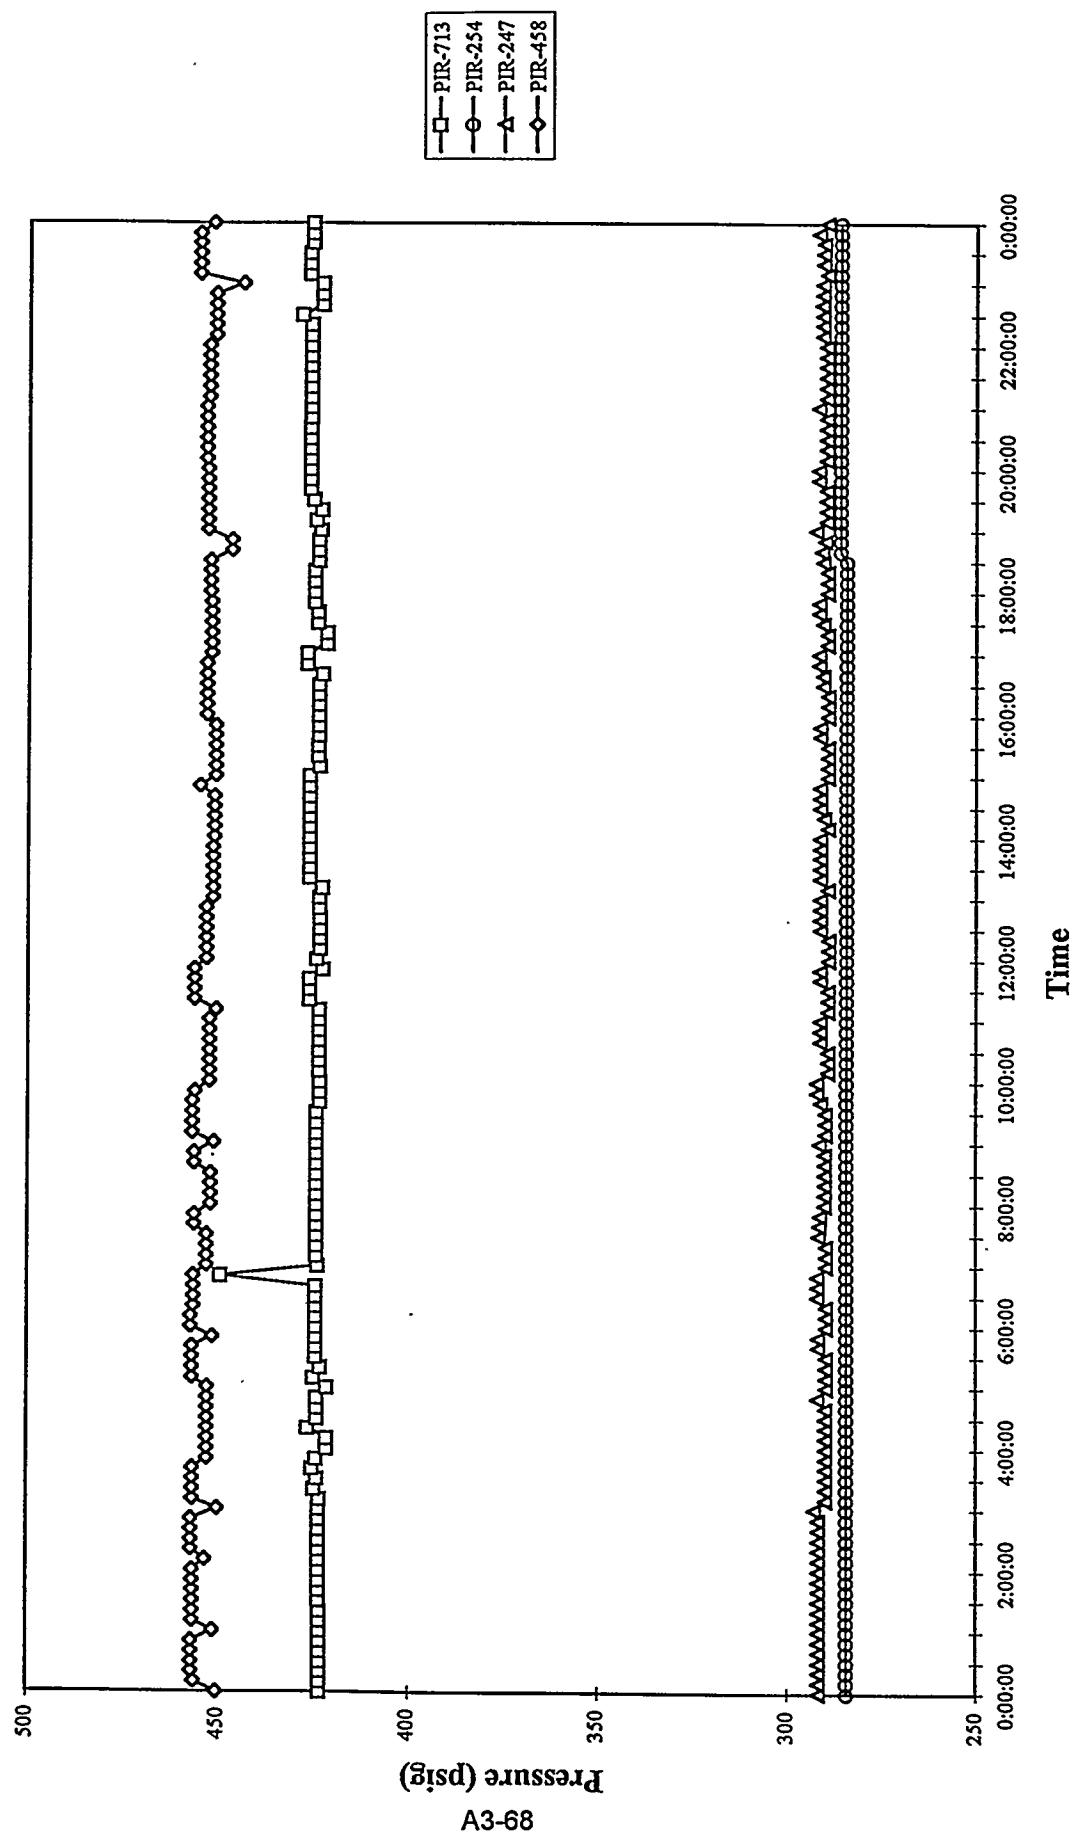


MGCR and FBG Process Pressures
Run 94MGC08, 07/23/94

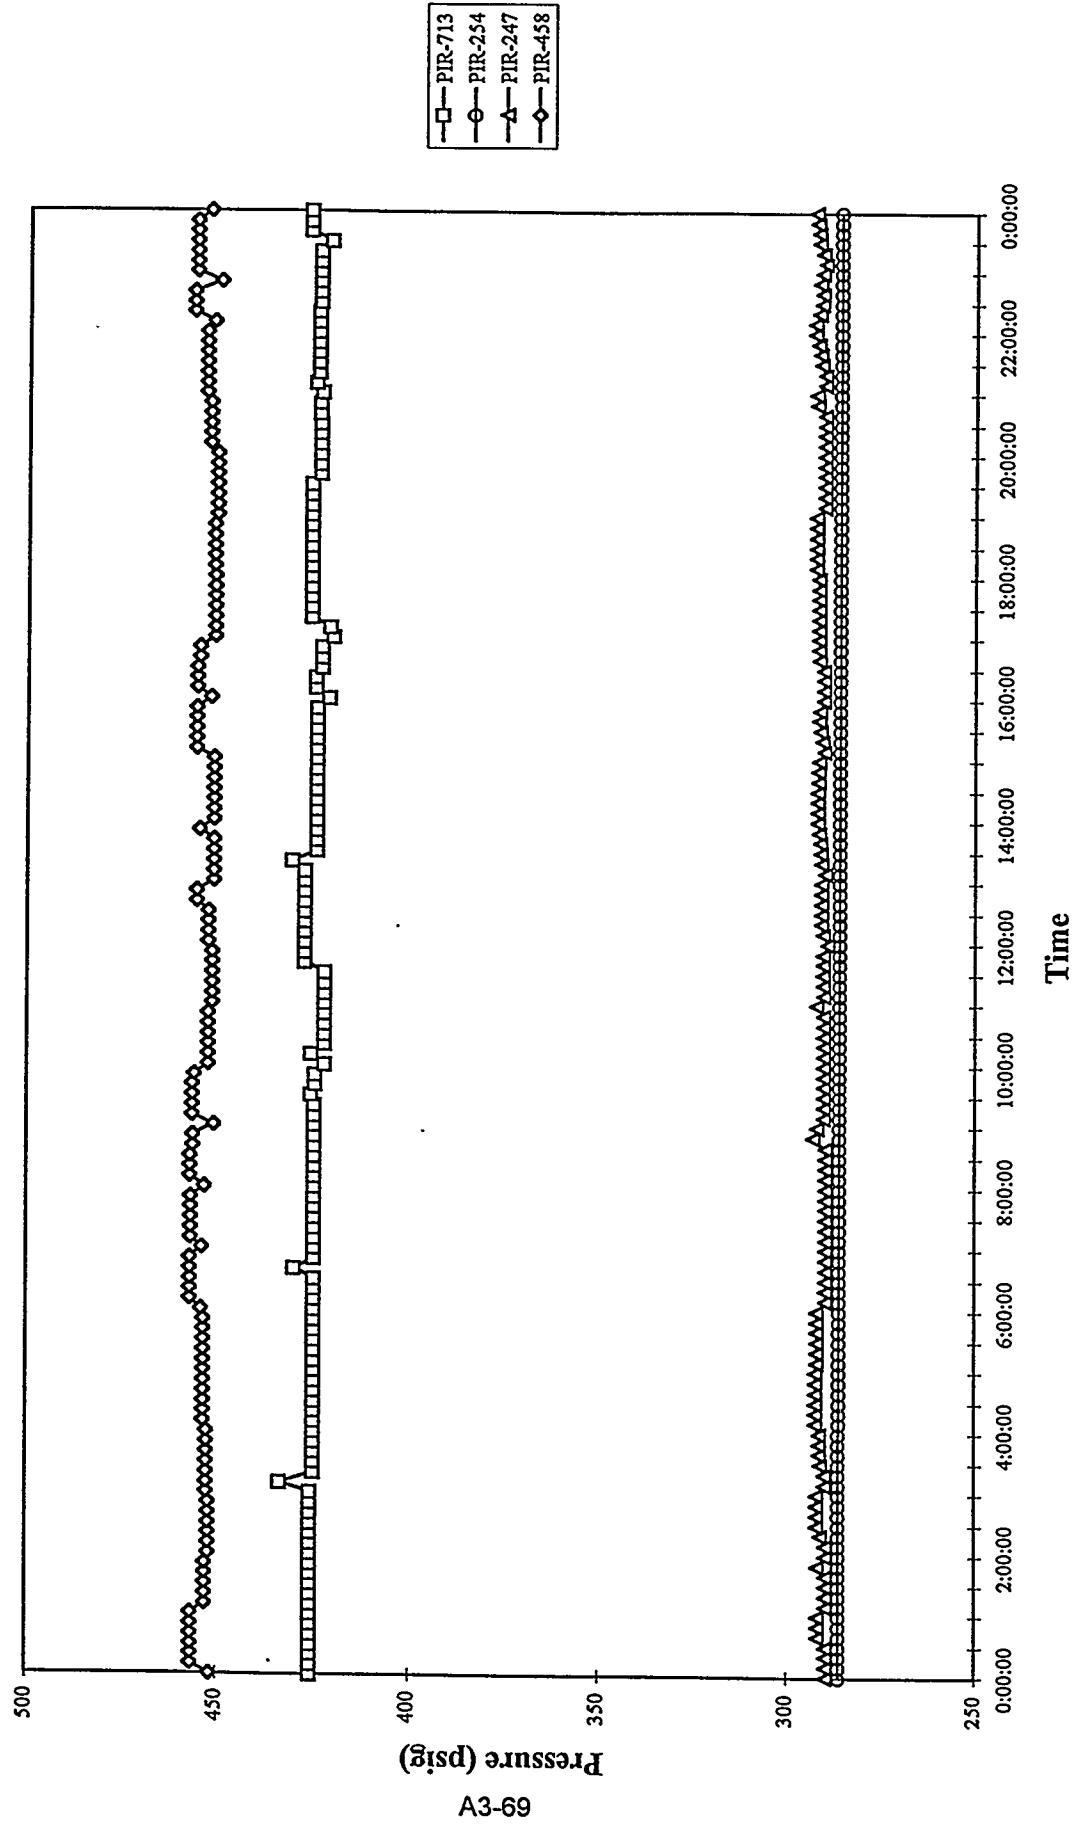


MGCR and FBG Process Pressures
Run 94MGC08, 07/24/94

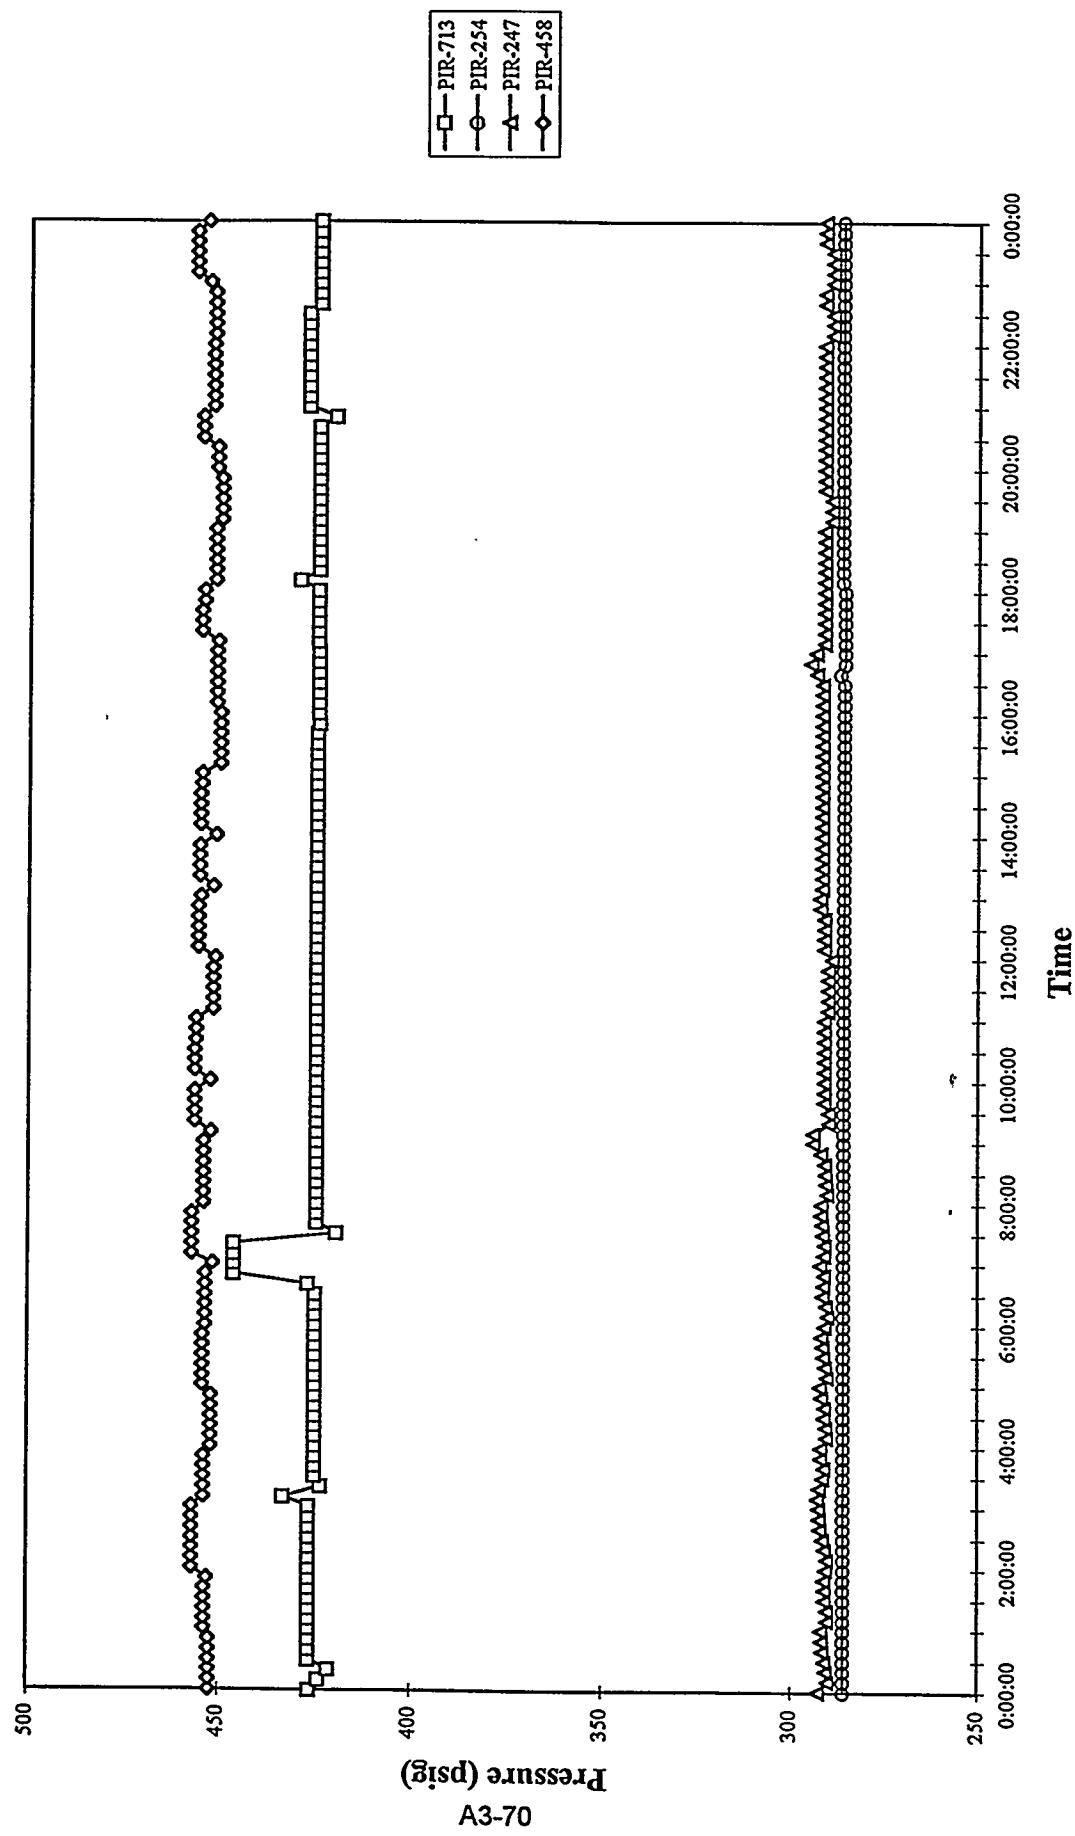


MGCR and FBG Process Pressures
Run 94MGC08, 07/25/94

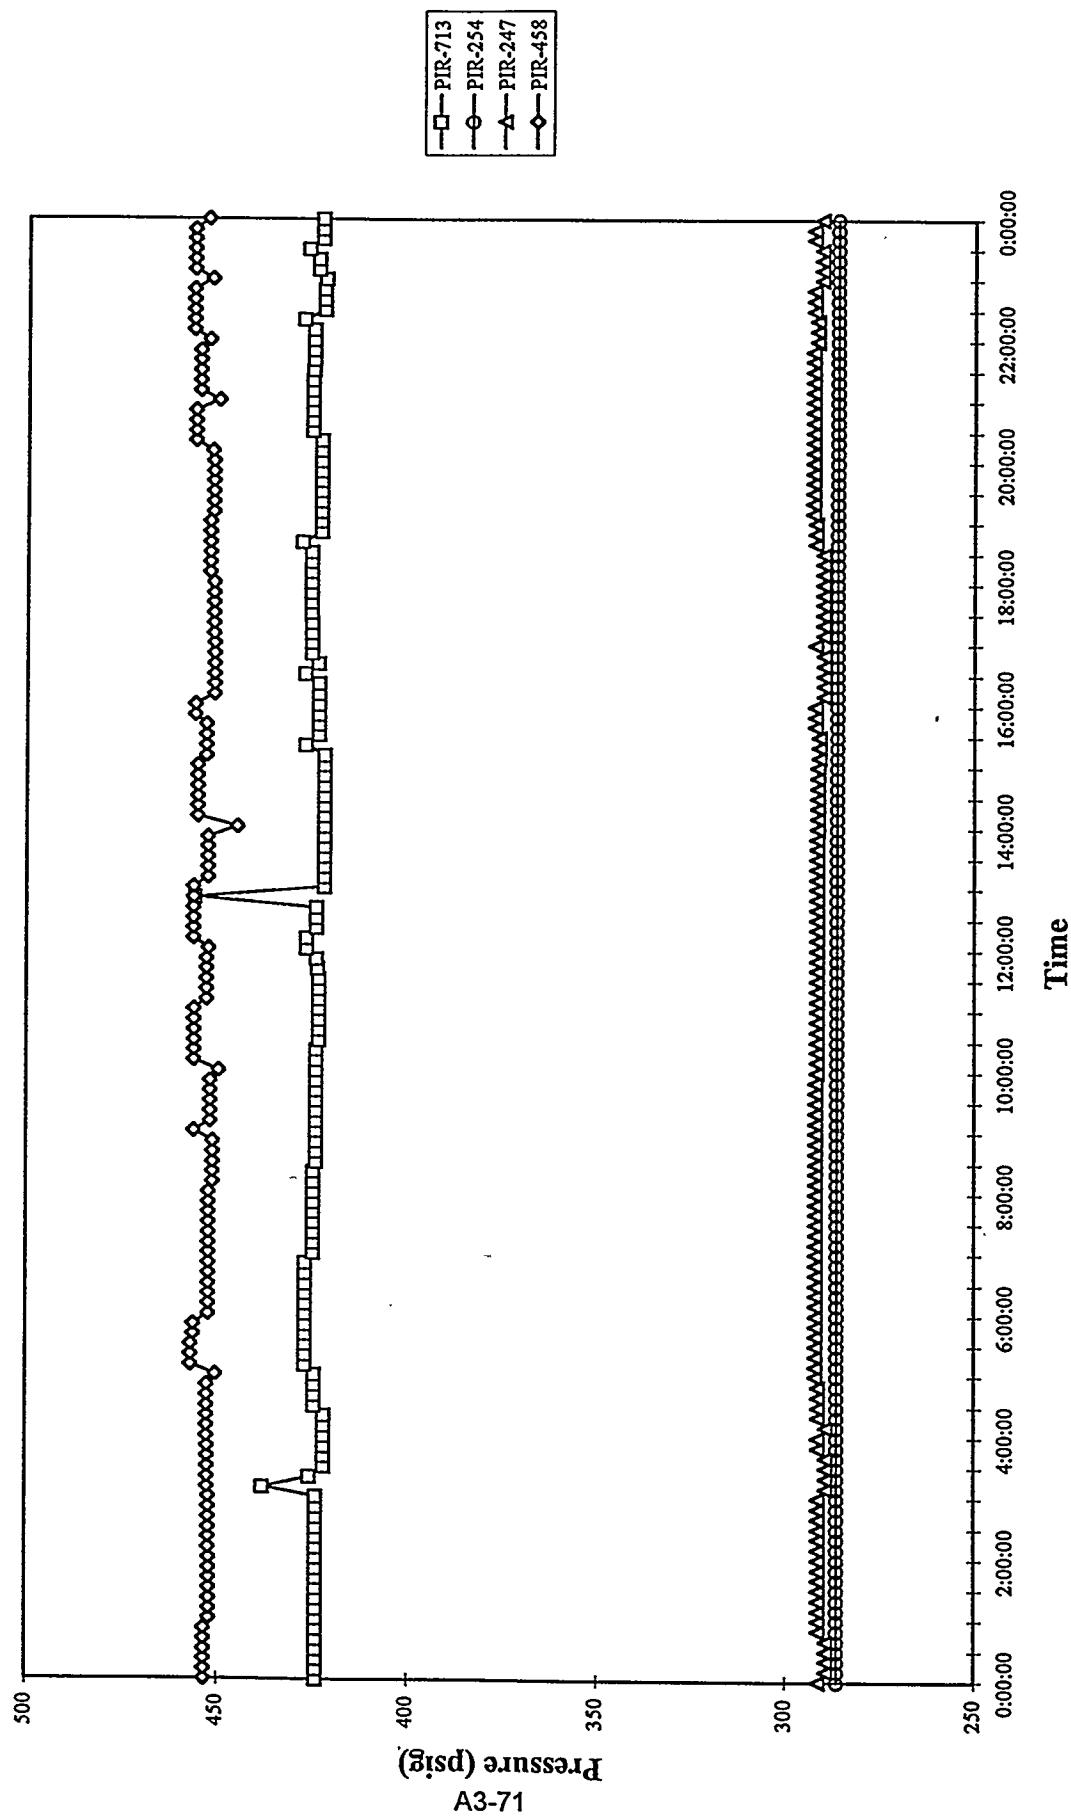


MGCR and FBG Process Pressures
Run 94MGGC08, 07/26/94

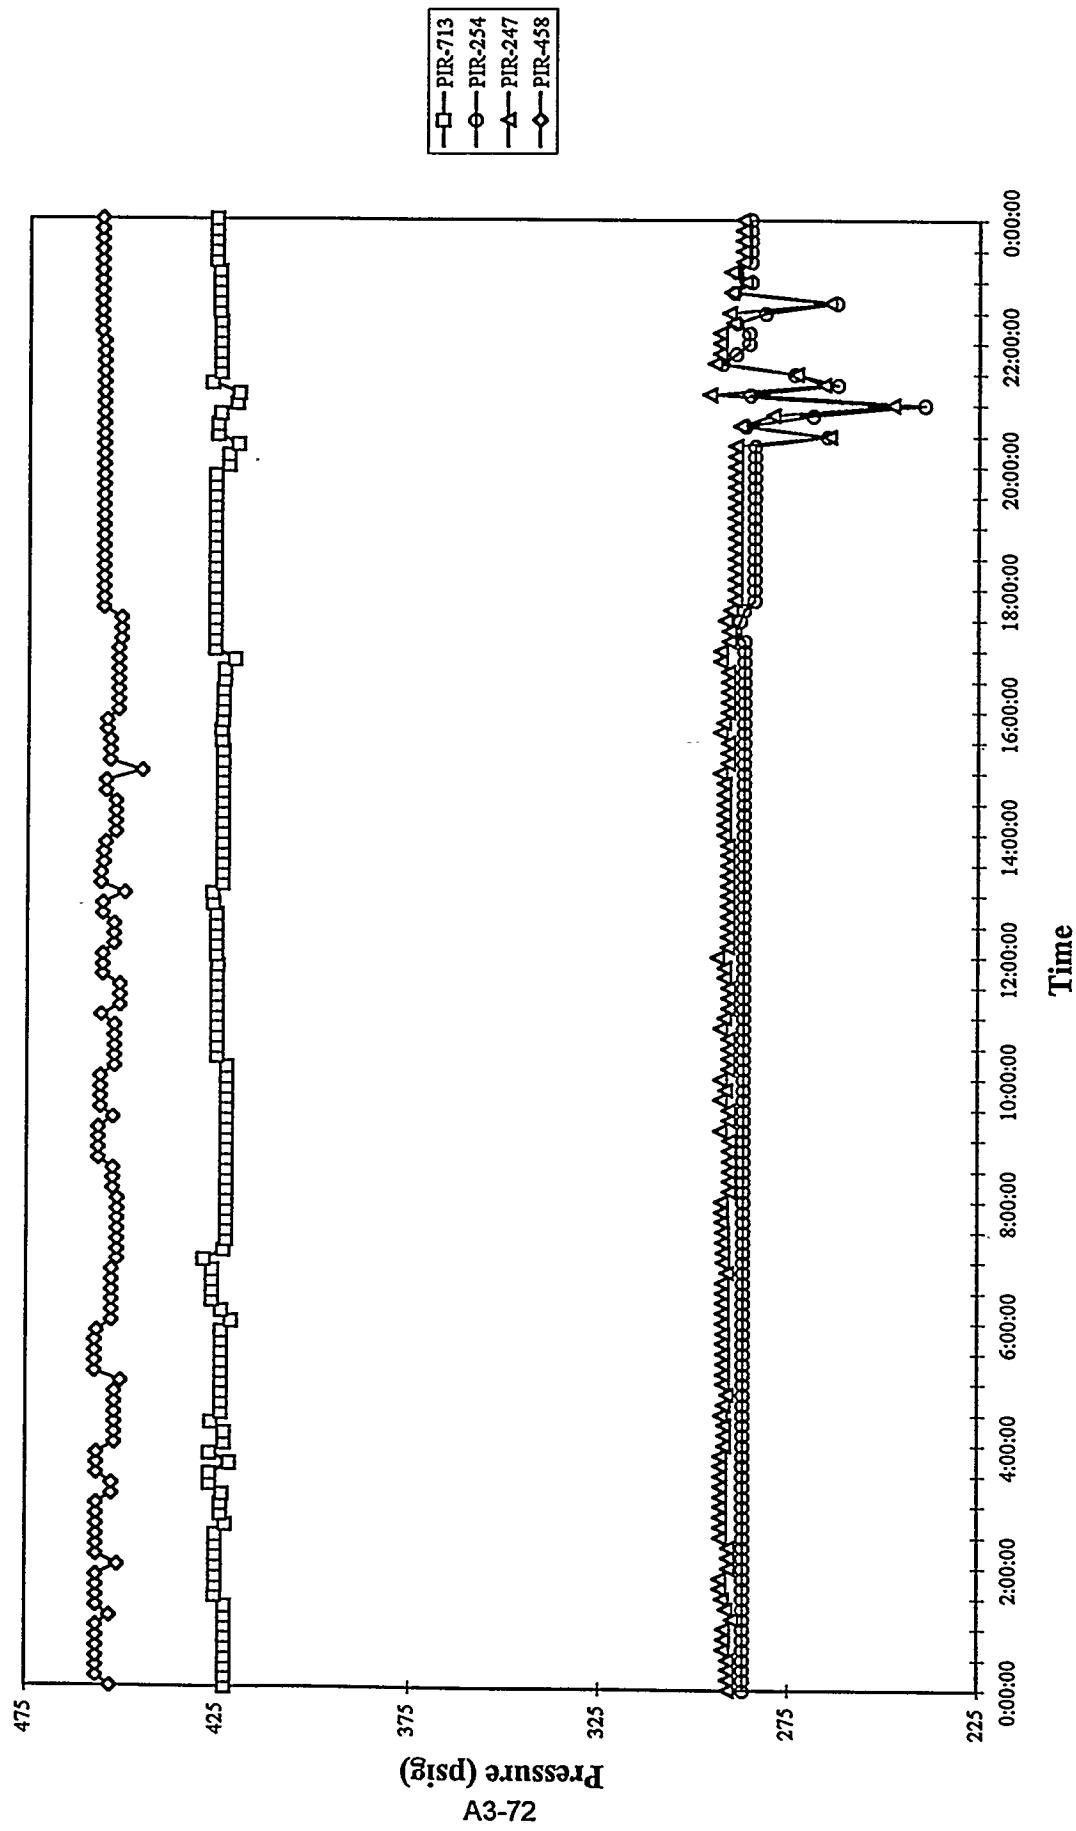


MGCR and FBG Process Pressures
Run 94MGC08, 07/27/94

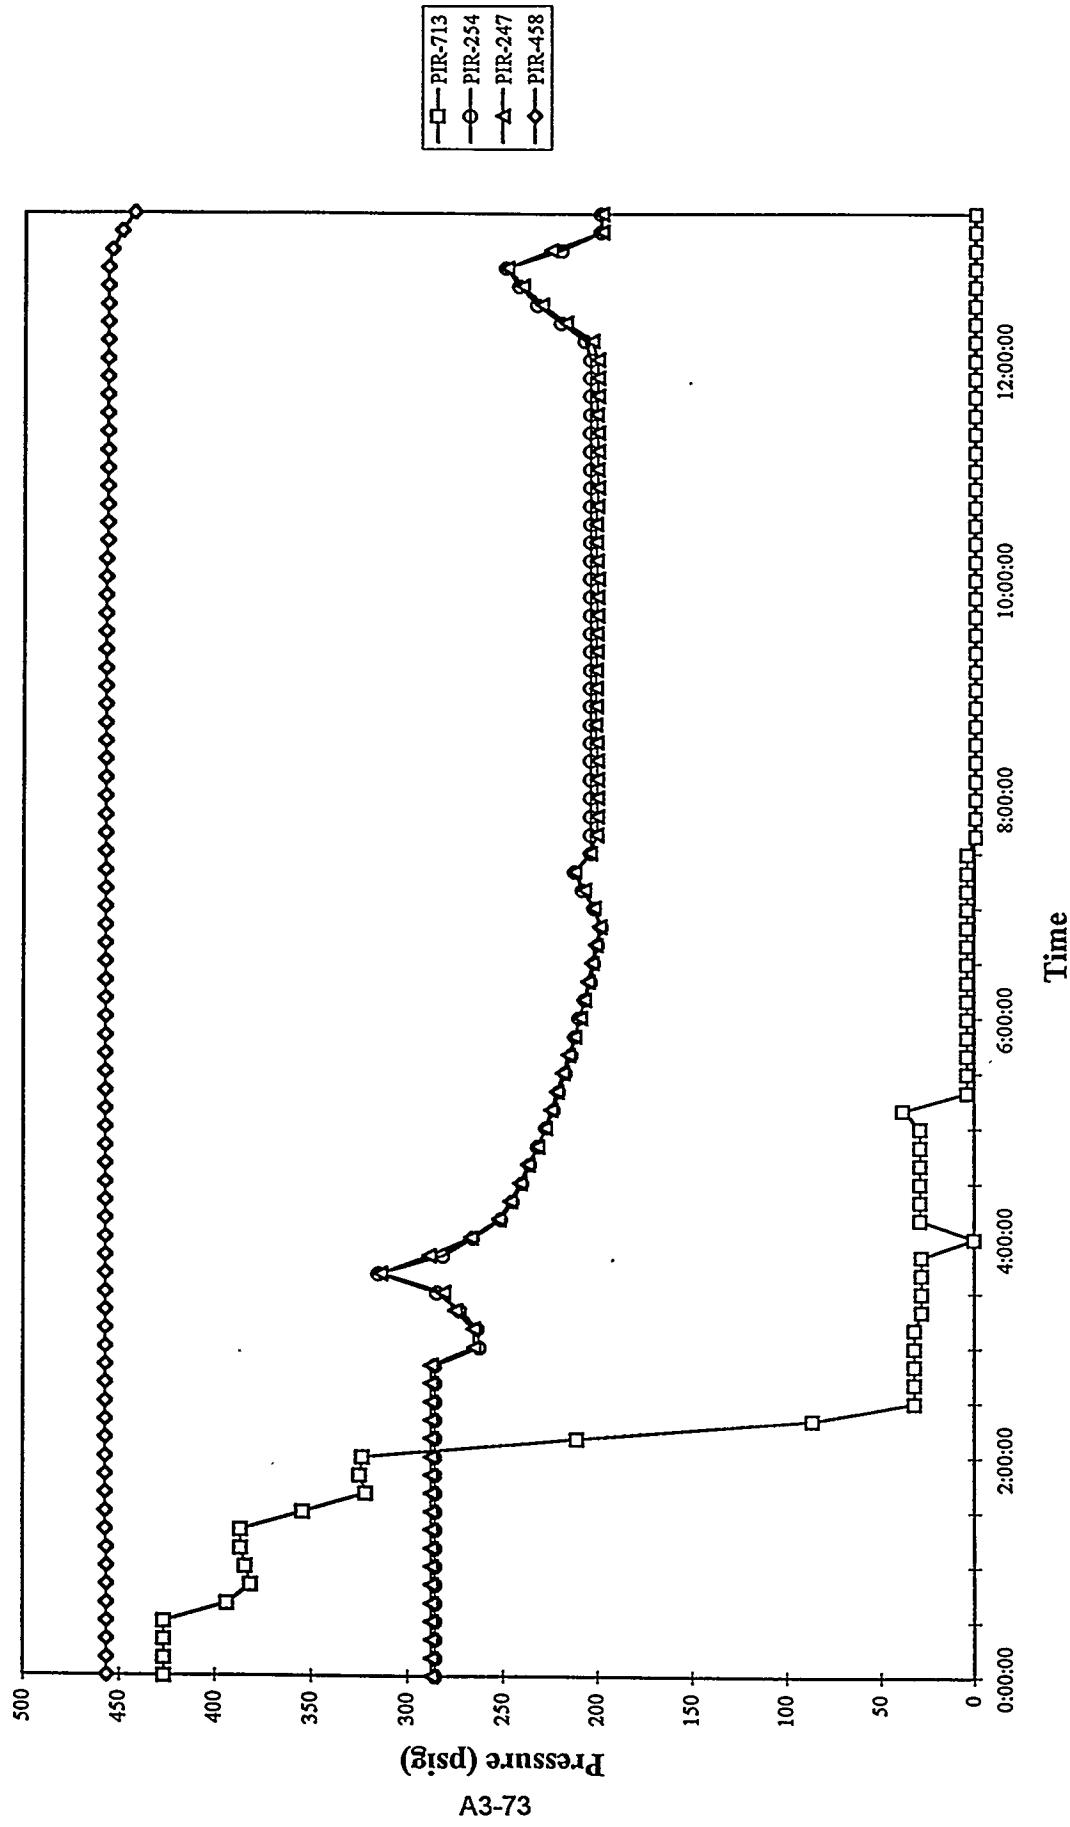


F-100 Differential Pressure
Run 94MGC08, 07/18/94

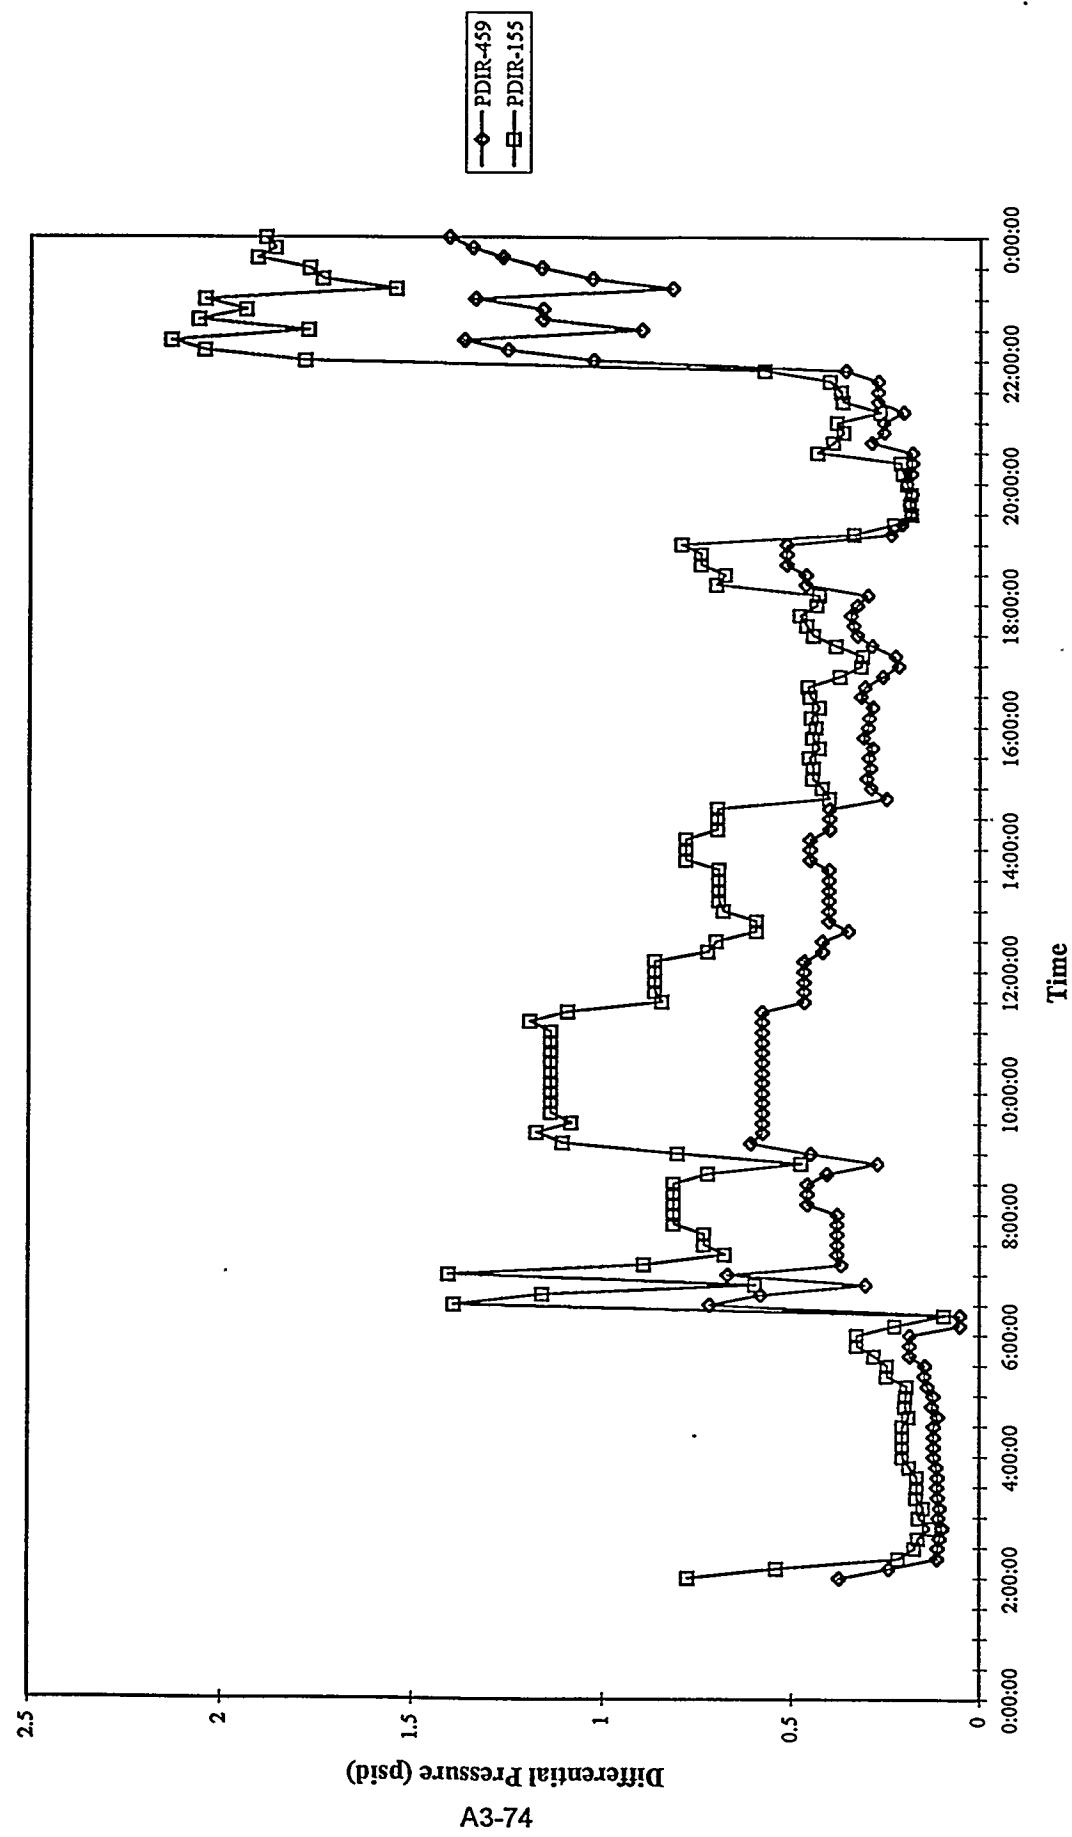


F-100 Differential Pressure
Run 94MGC08, 07/19/94

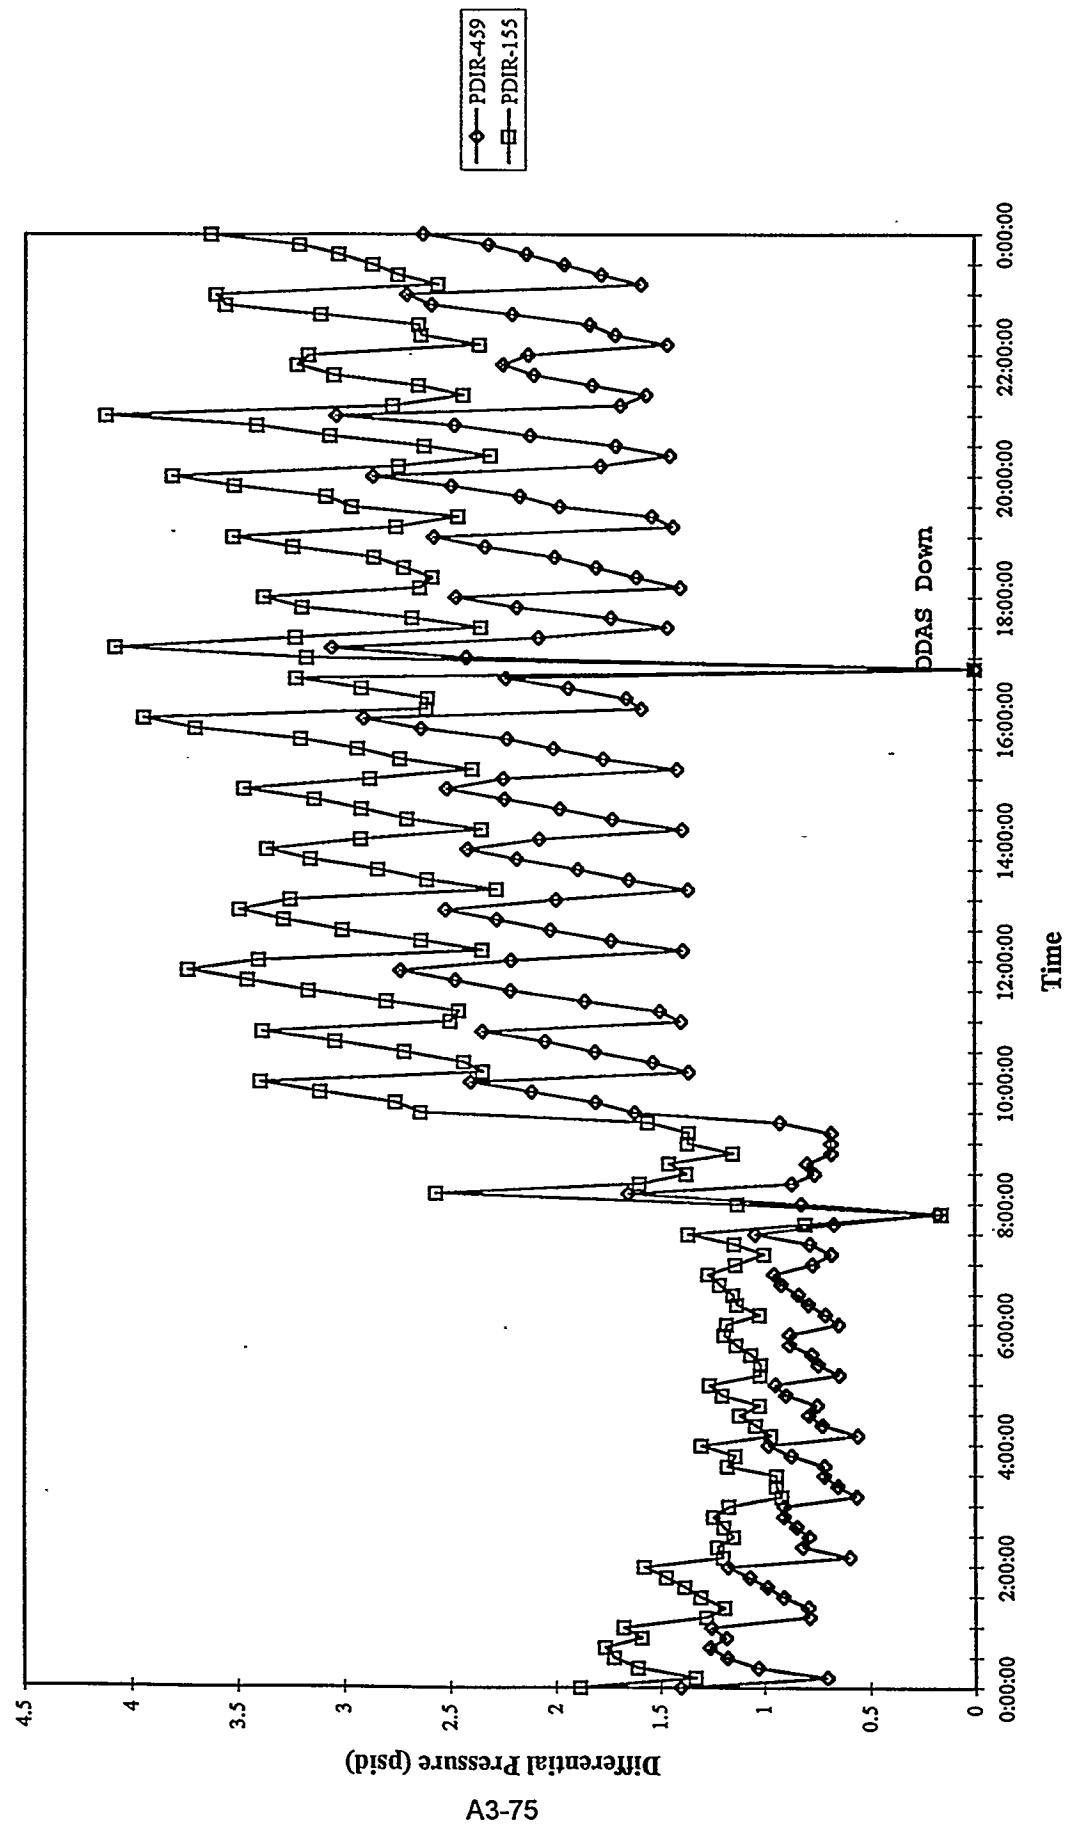


F-100 Differential Pressure
Run 94MGC08, 07/20/94

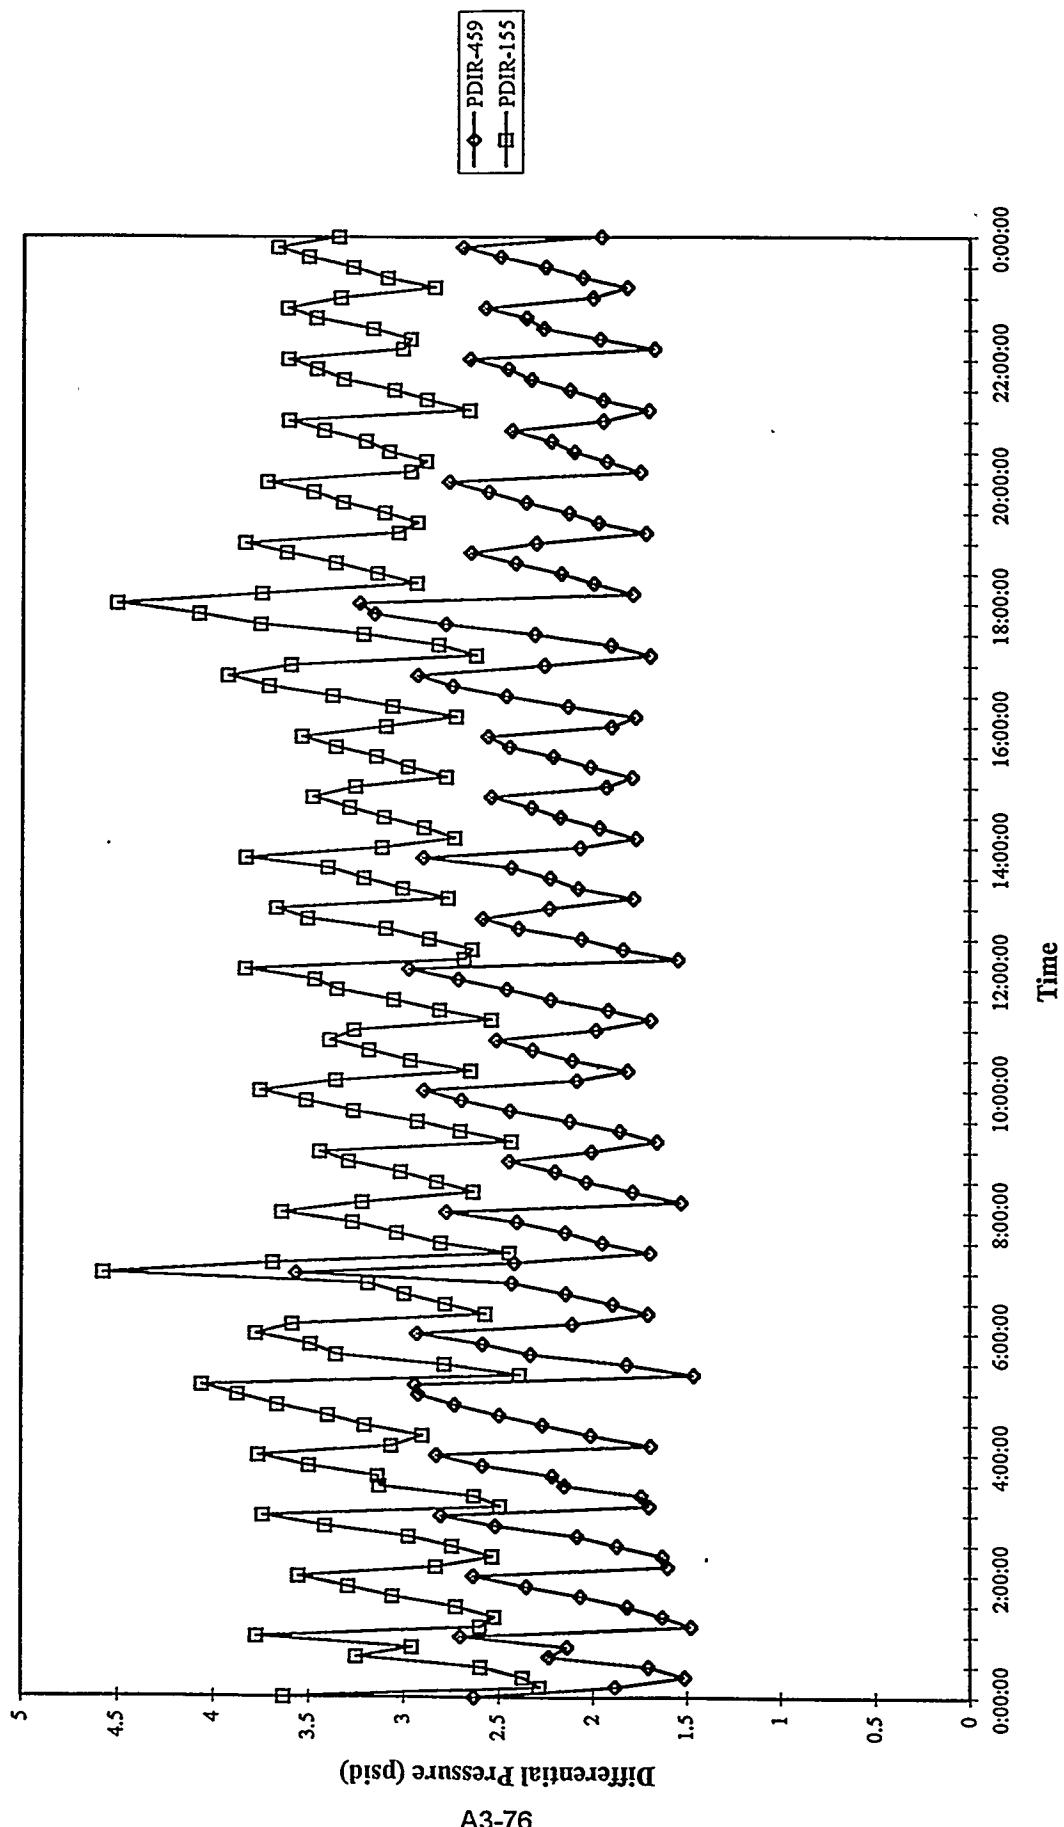


F-100 Differential Pressure
Run 94MGC08, 07/21/94

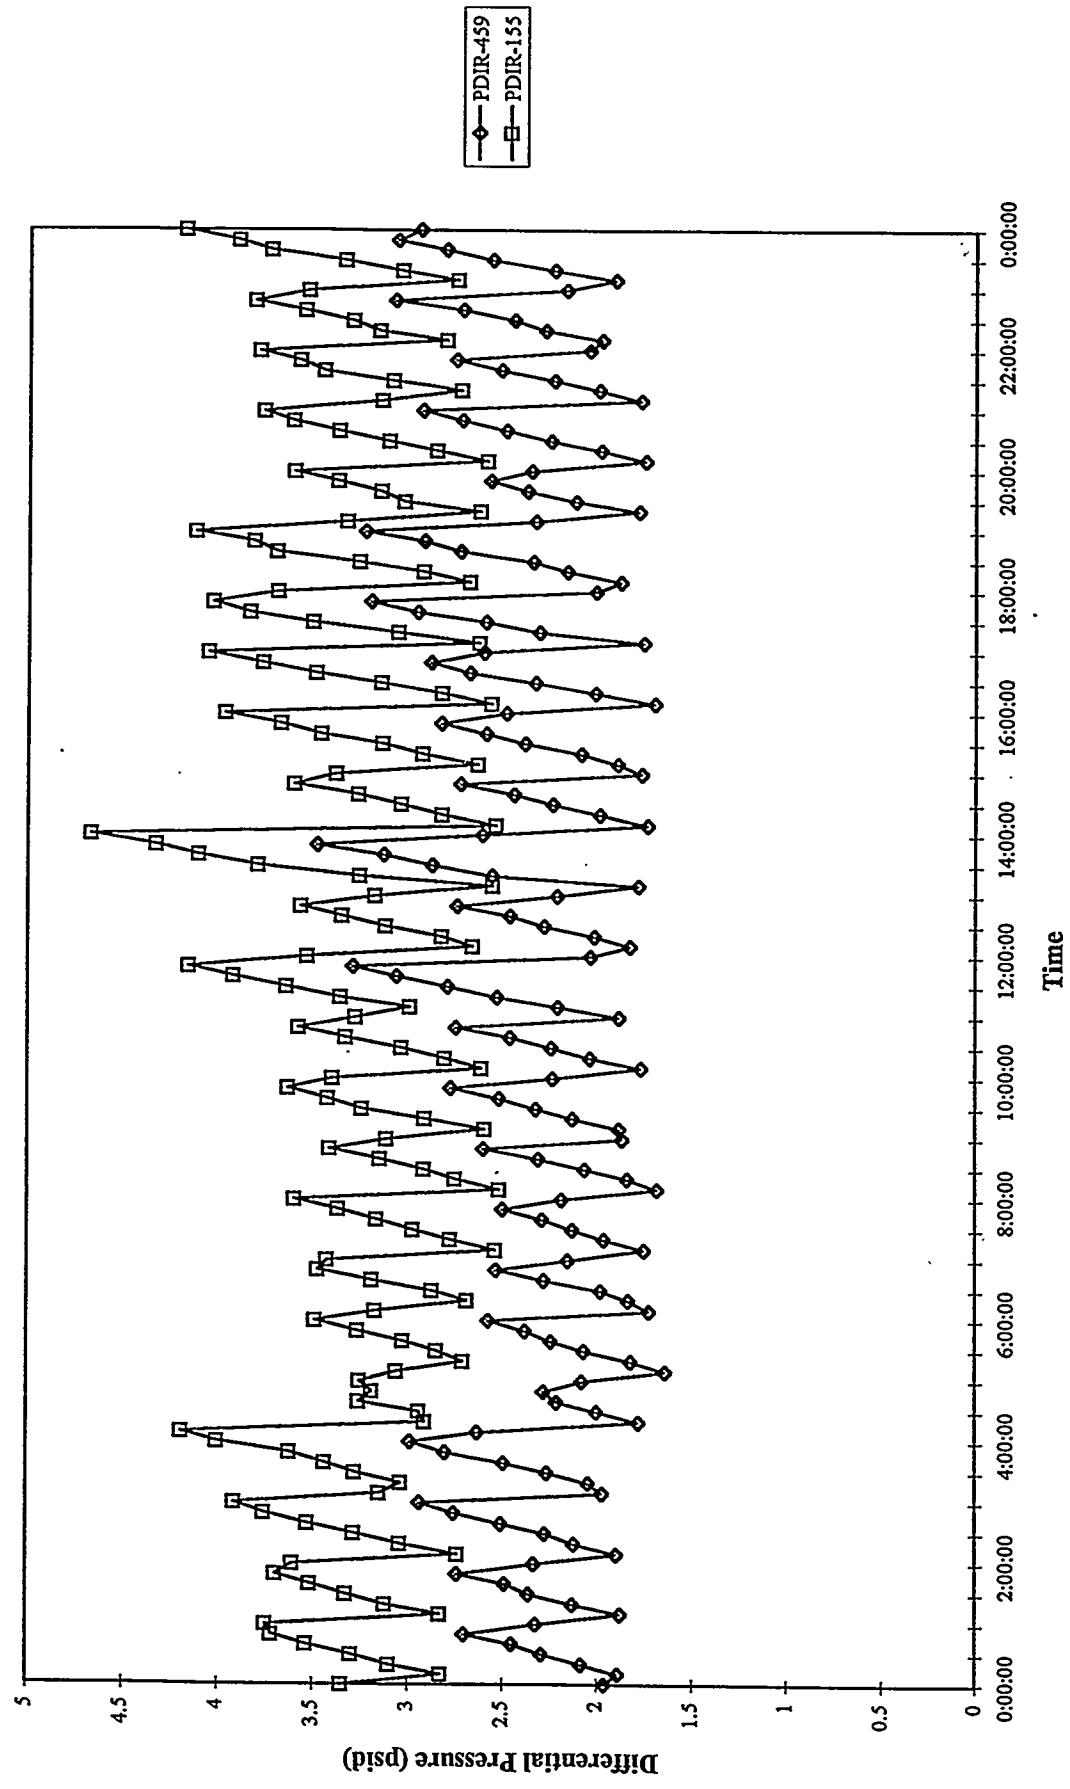


F-100 Differential Pressure
Run 94MGC08, 07/22/94

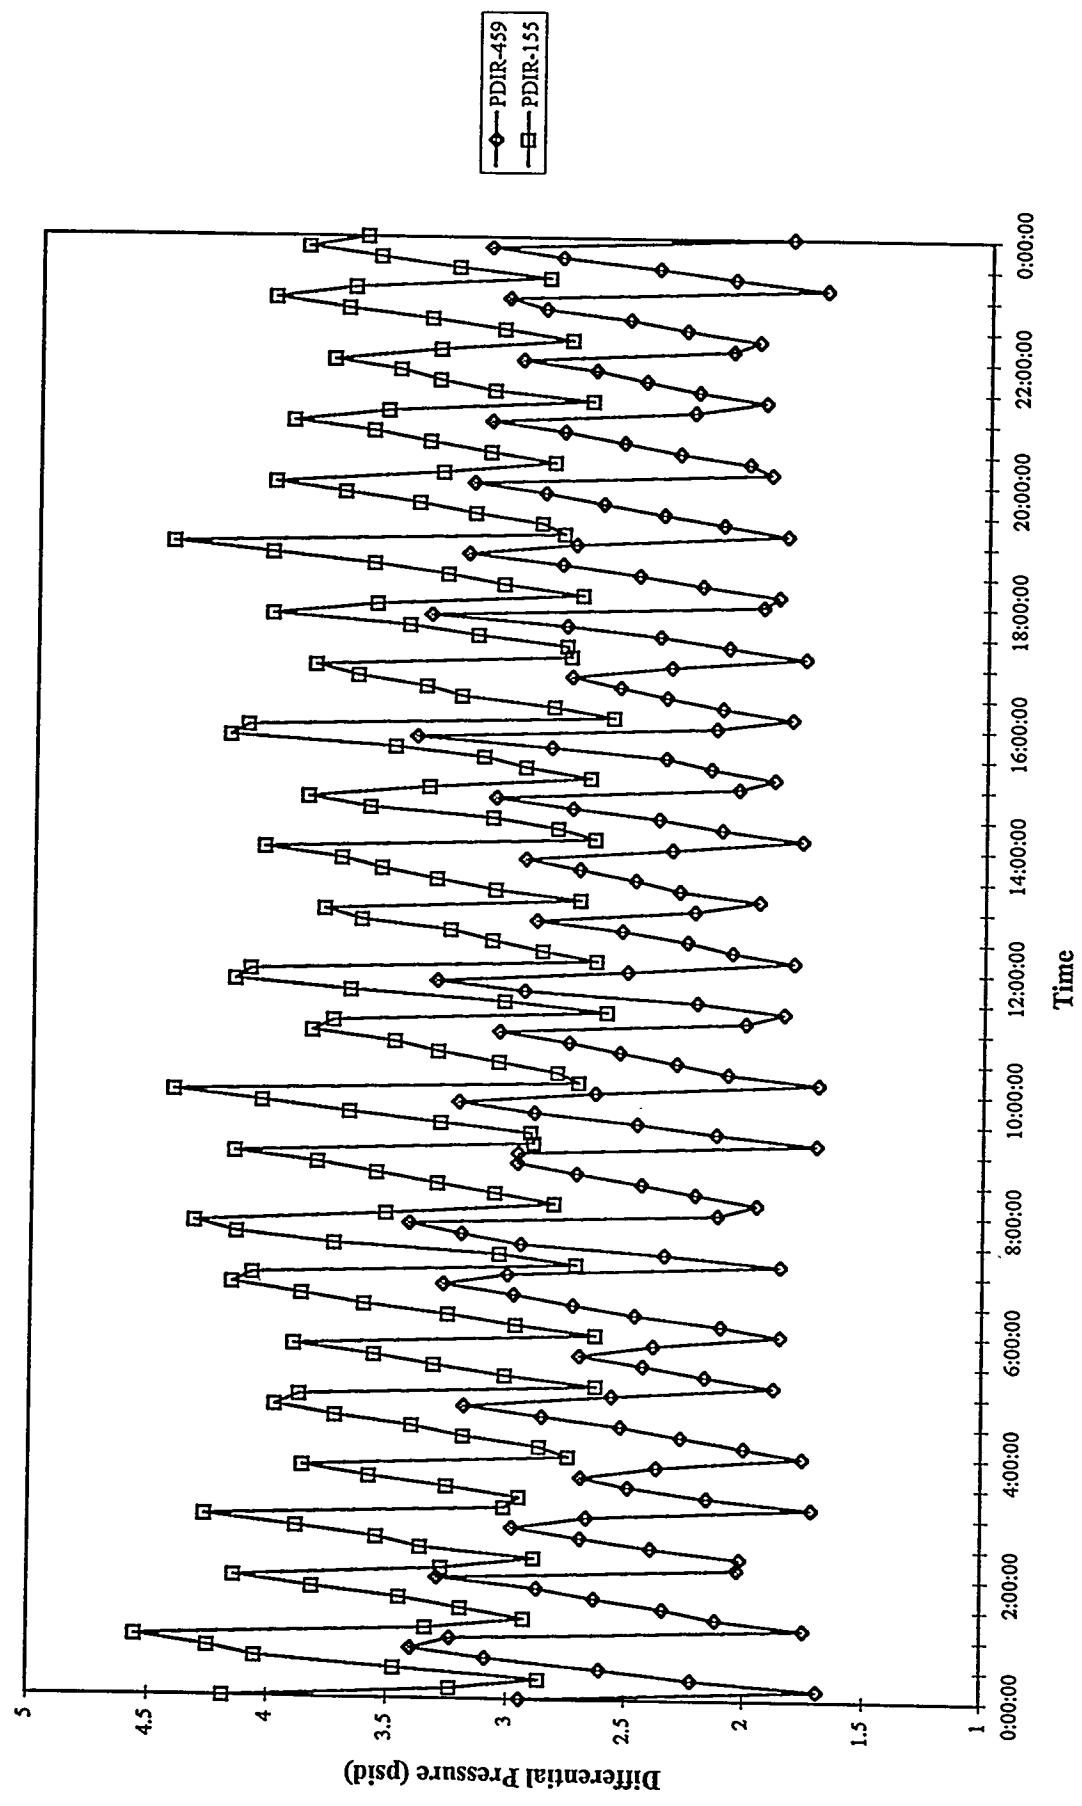


F-100 Differential Pressure
Run 94MGC08, 07/23/94

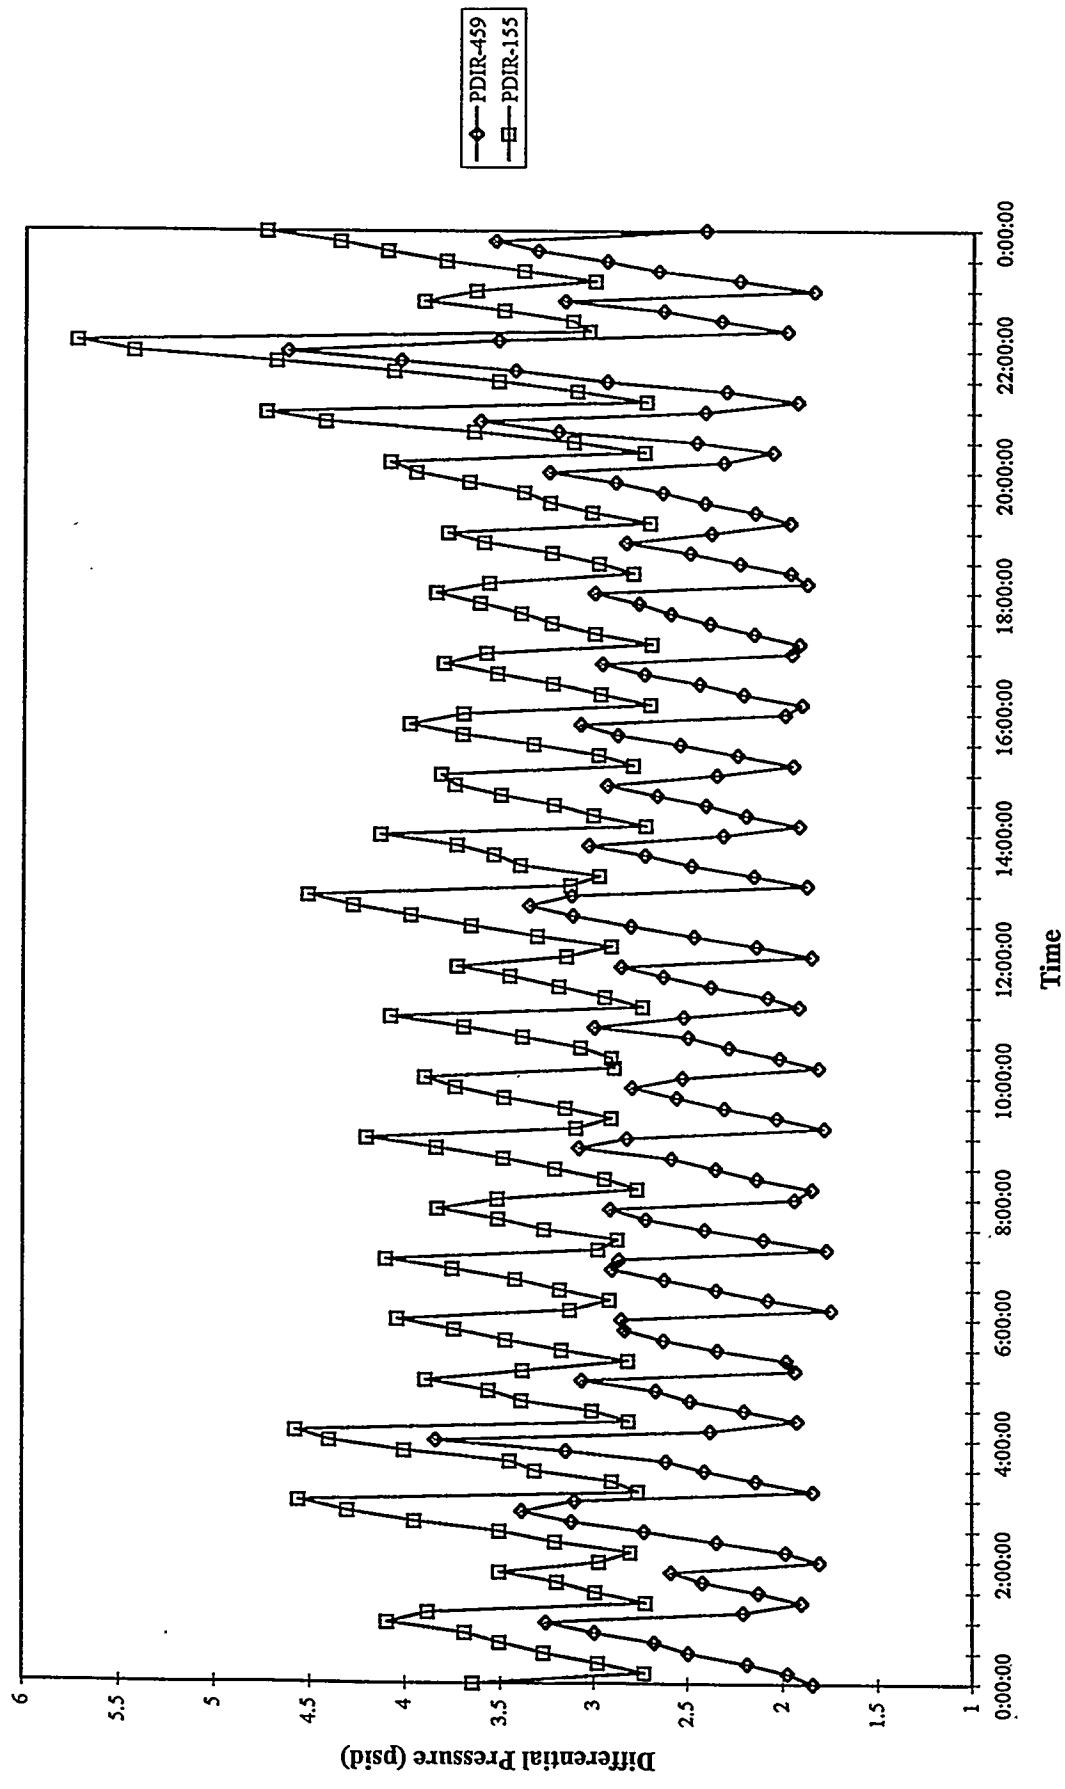


F-100 Differential Pressure
Run 94MGC08, 07/24/94

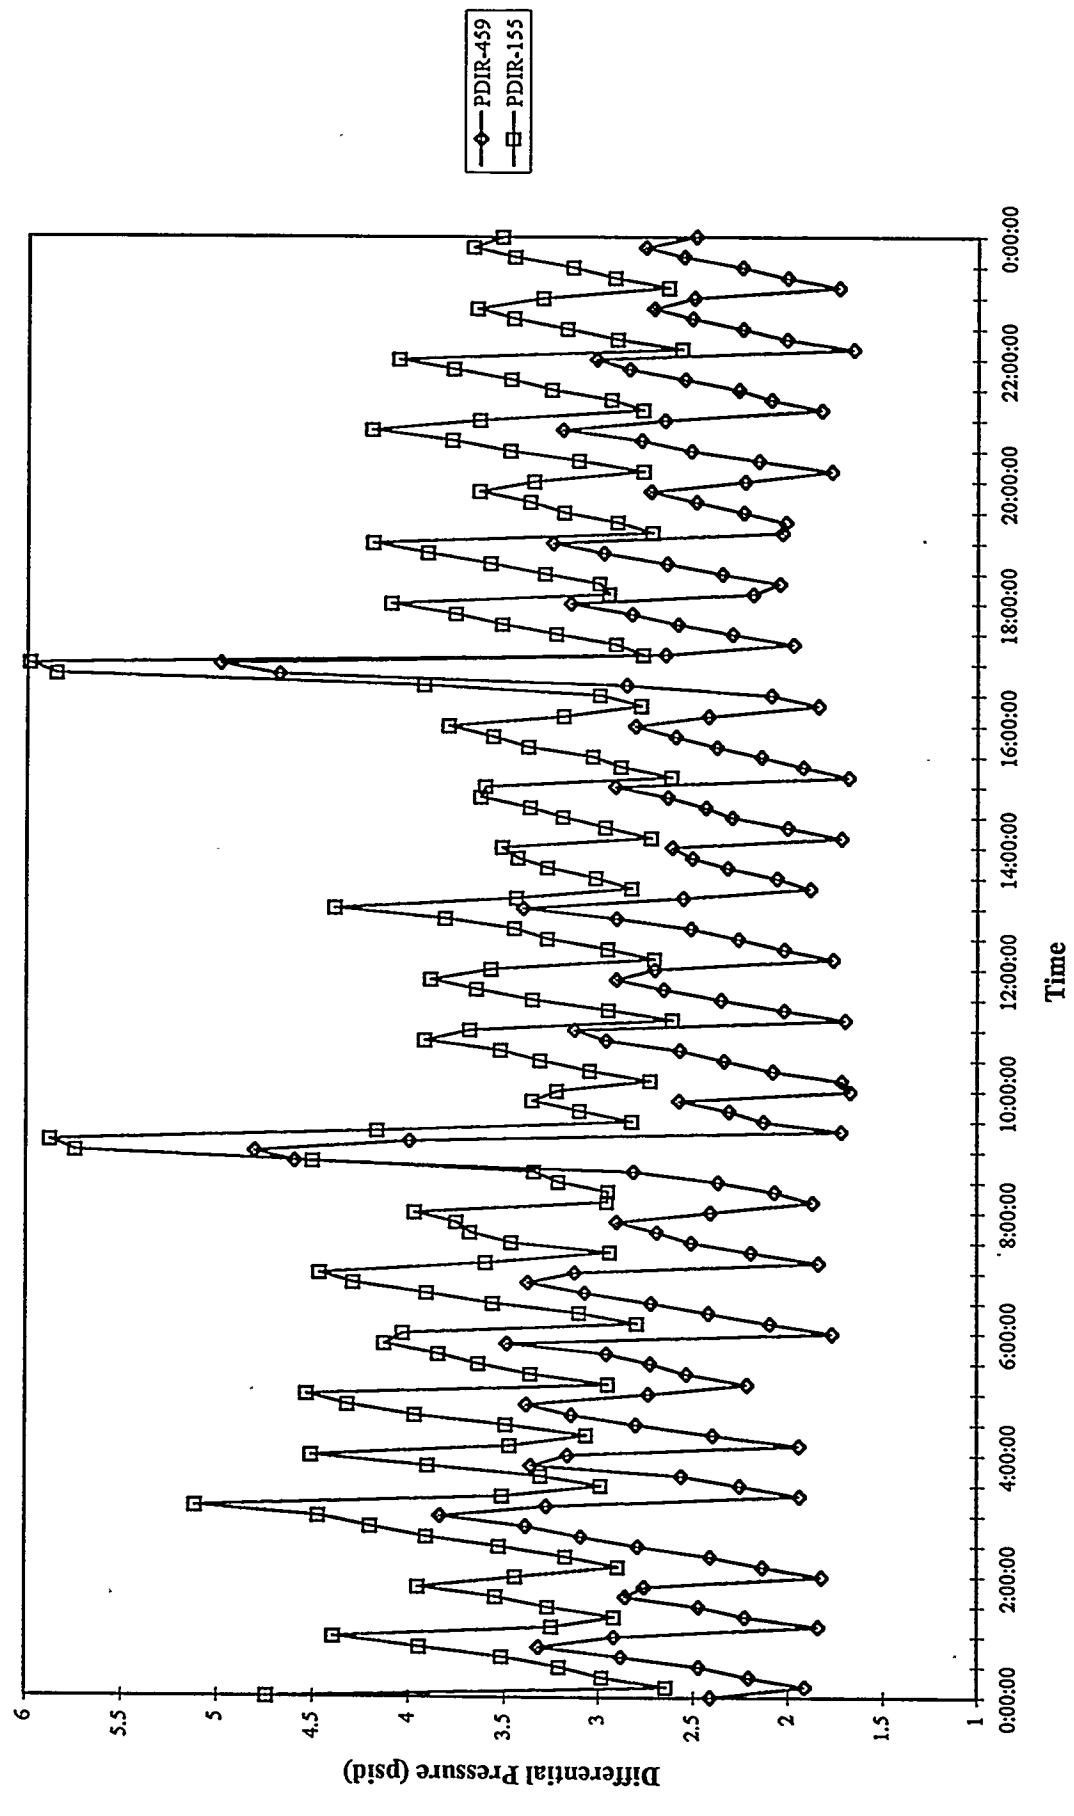

F-100 Differential Pressure
Run 94MGC08, 07/25/94

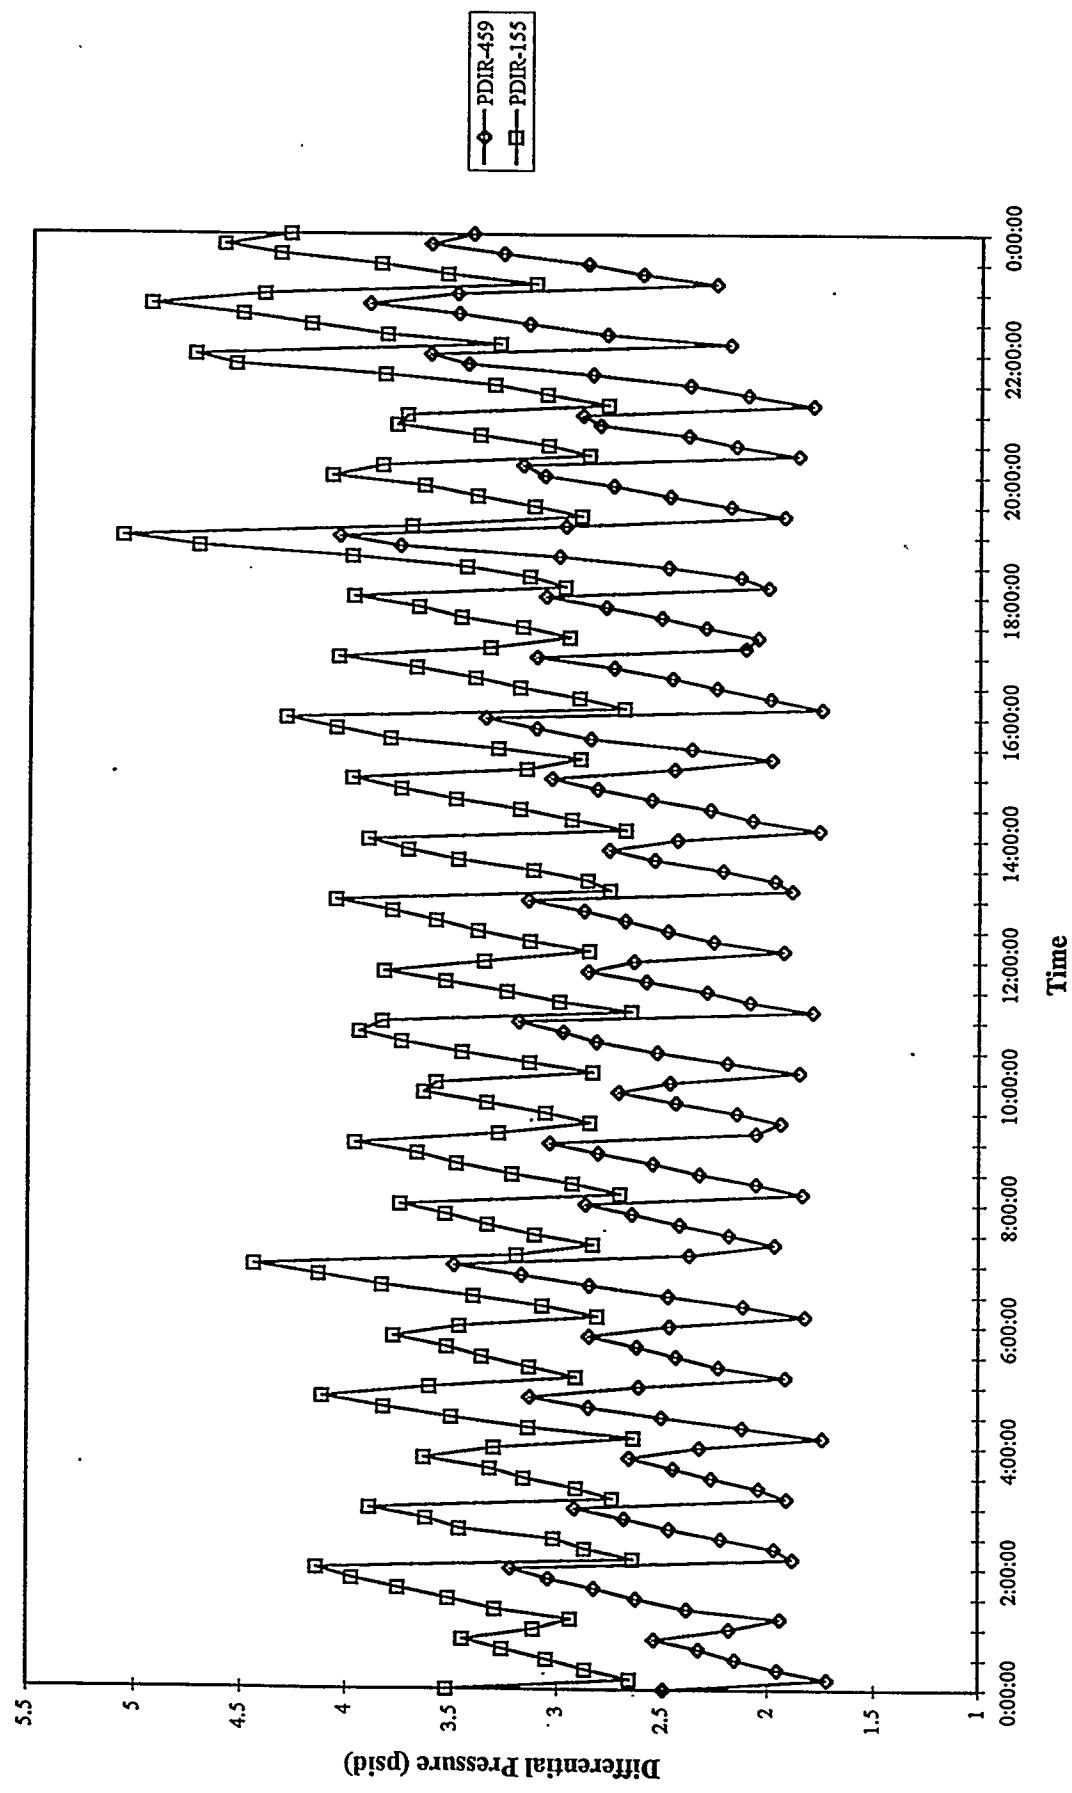


F-100 Differential Pressure
Run 94MGC08, 07/26/94

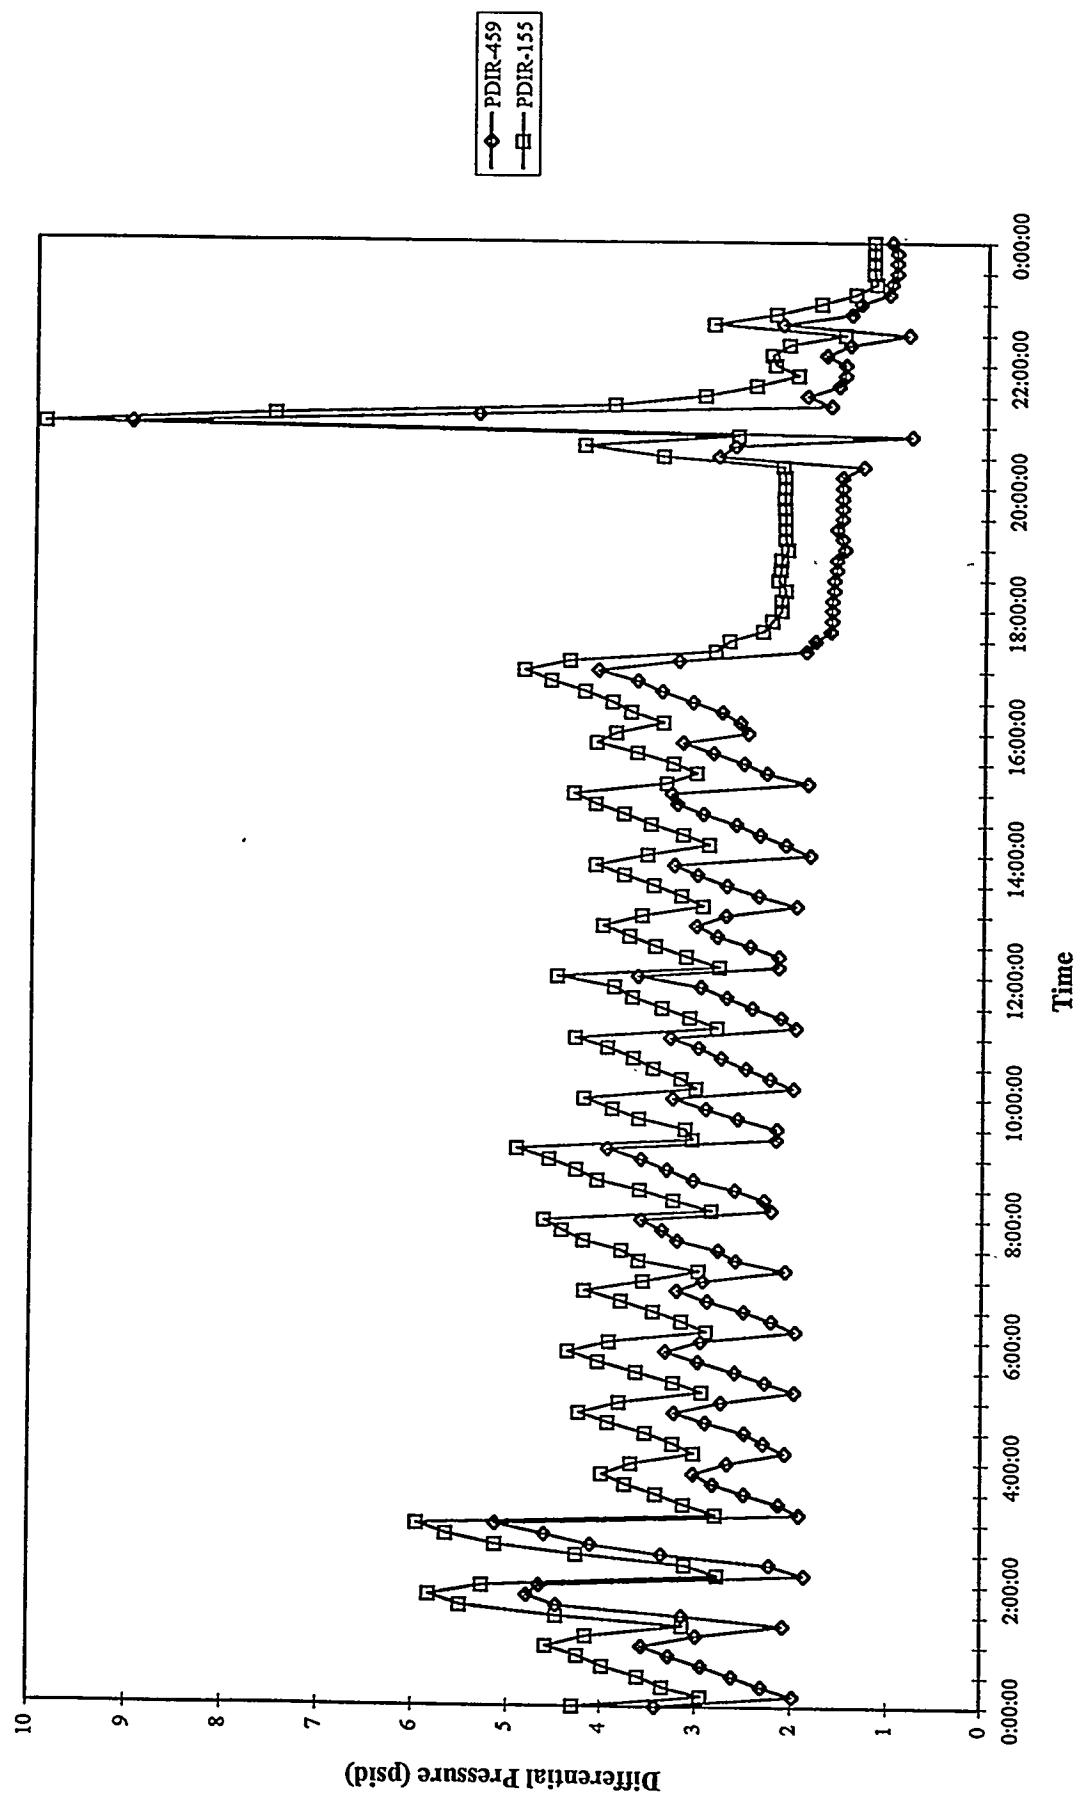

A3-82


F-100 Differential Pressure
Run 94MGC08, 07/27/94

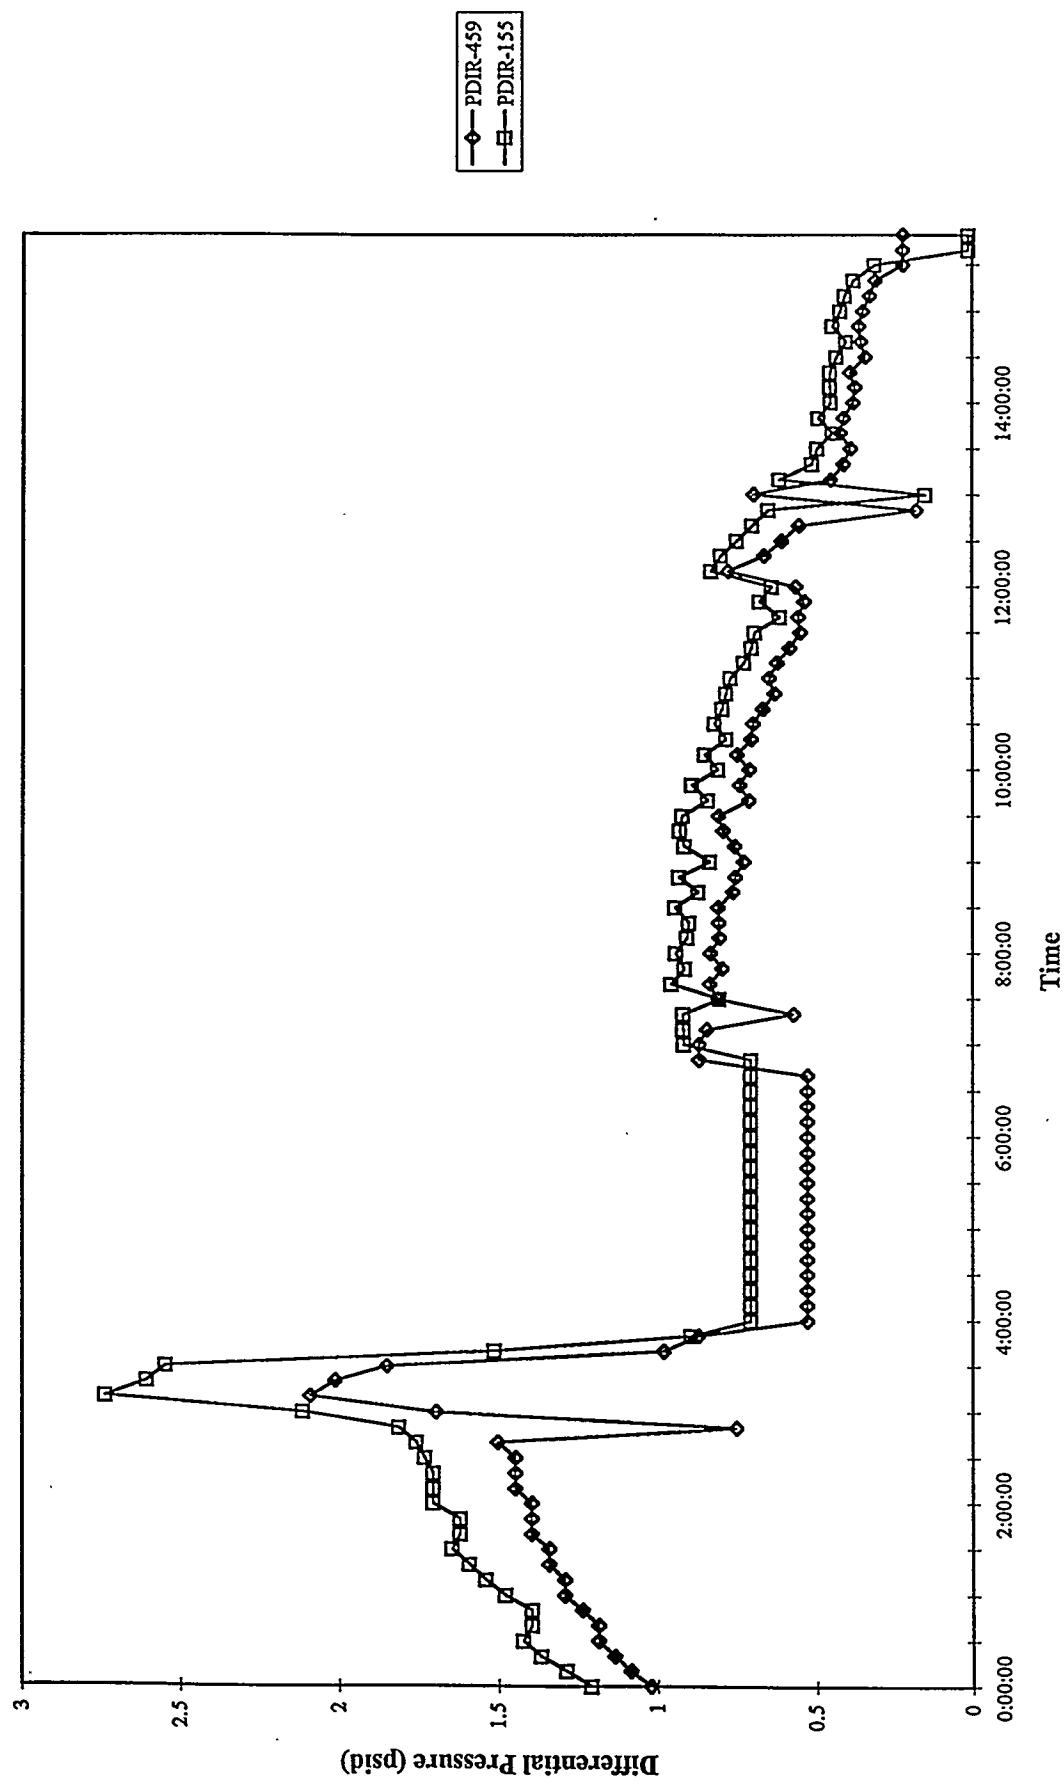


**94MGC09
(09/12/94 - 09/16/94)**




MGCR Inlet and Exit Flows
Run 94 MGCR09, 09/12/94

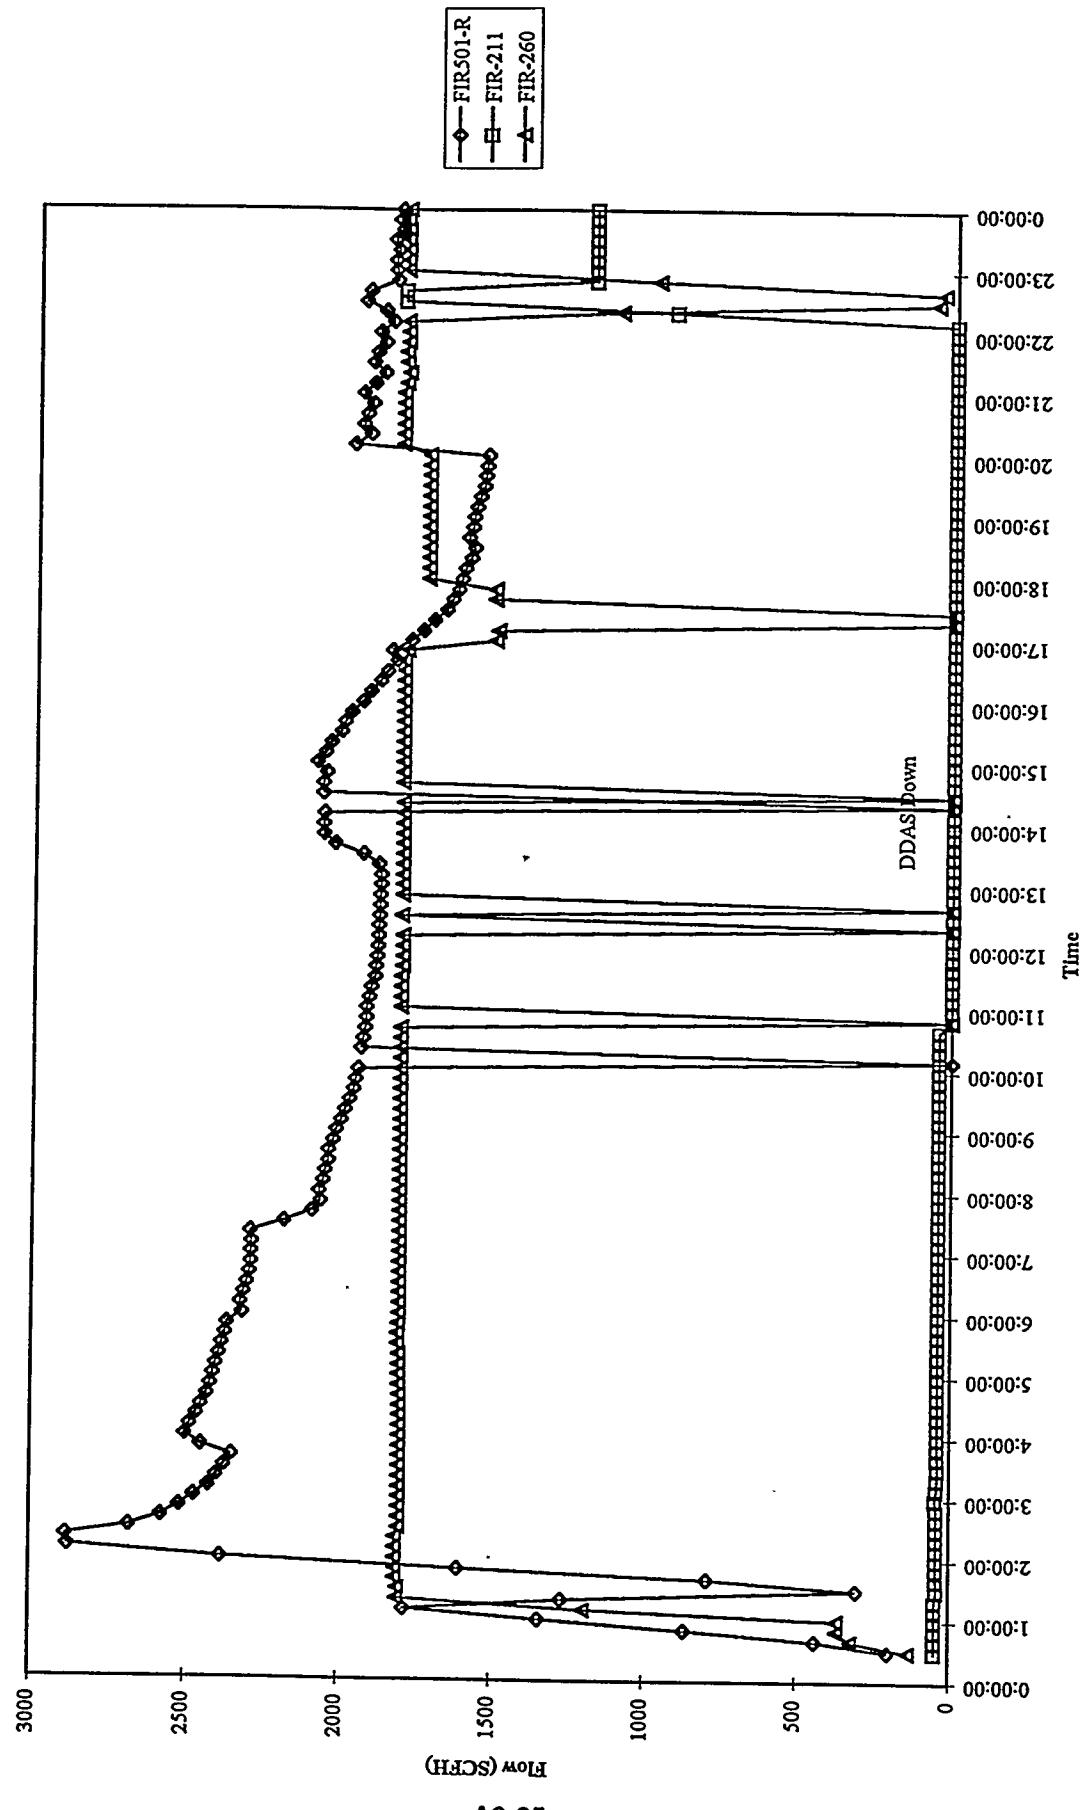


MGCR Inlet and Exit Flows
Run 94MGC09, 09/13/94

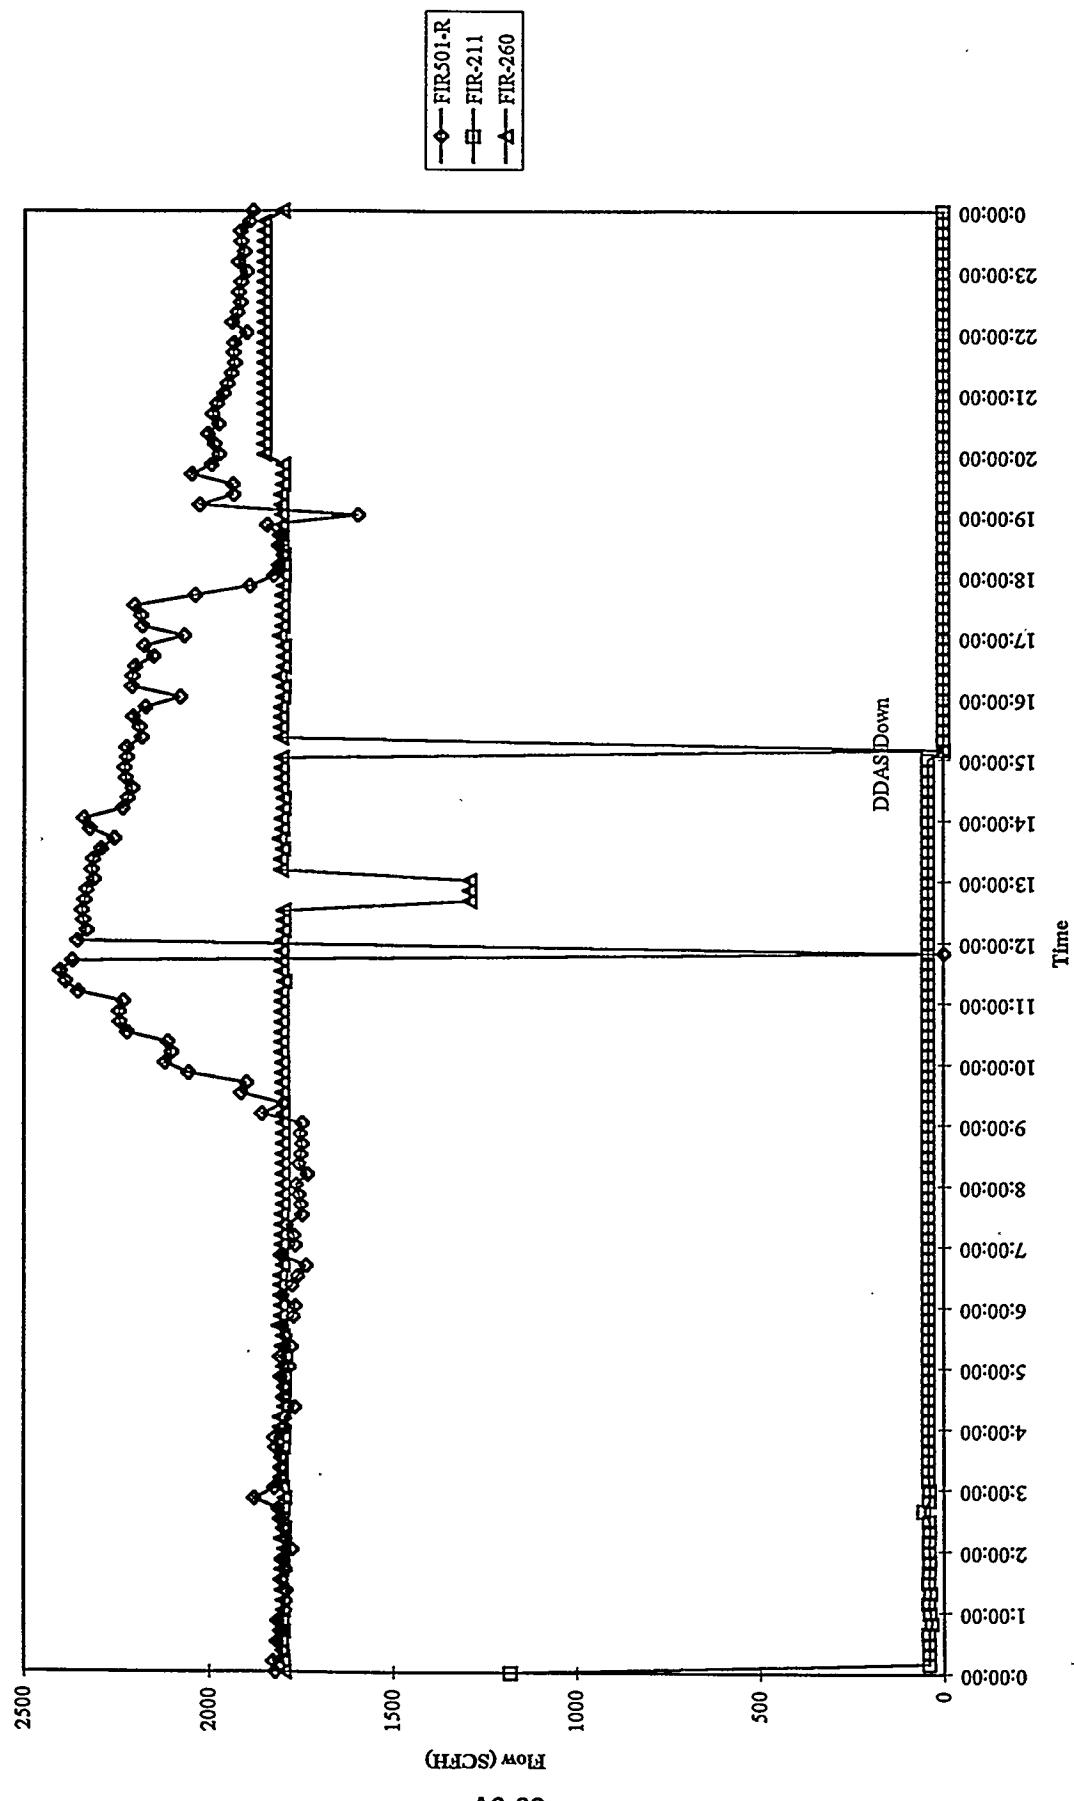


MGCR Inlet and Exit Flows
Run 94MGC09, 09/14/94

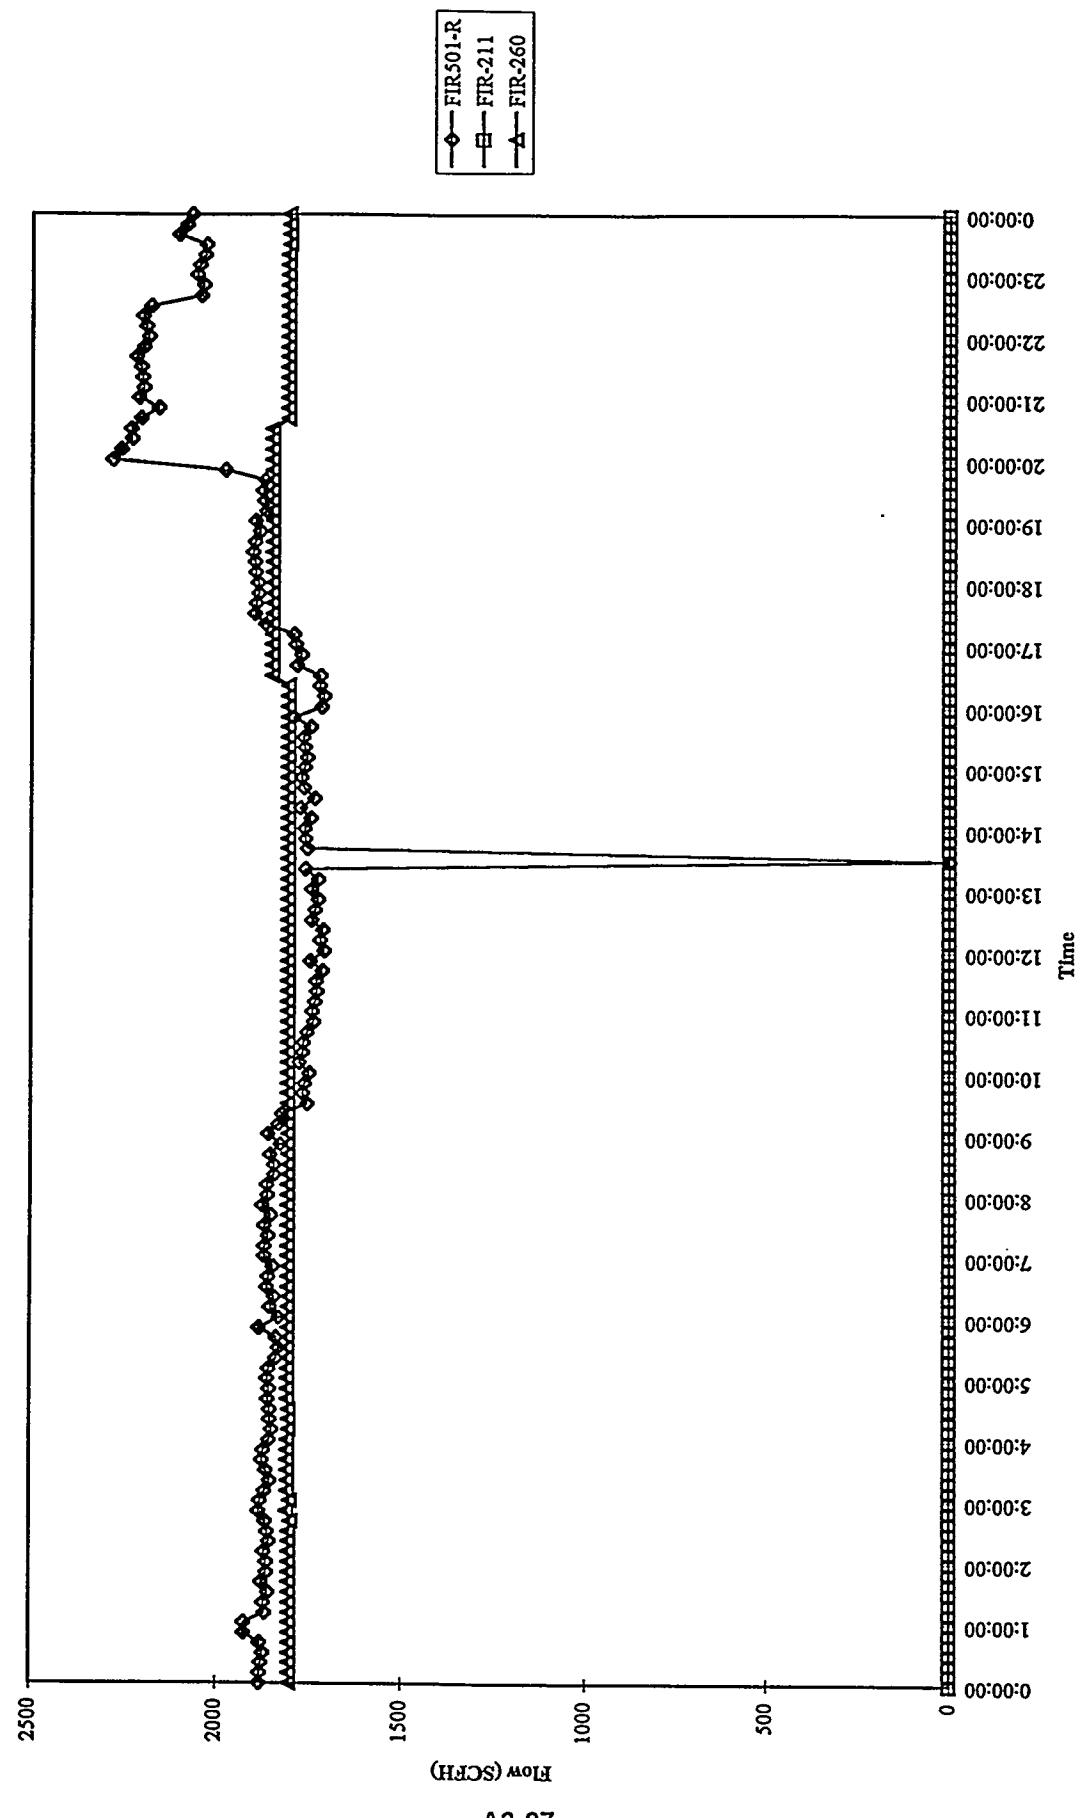


MIGCR Inlet and Exit Flows
Run 94MGC09, 09/15/94

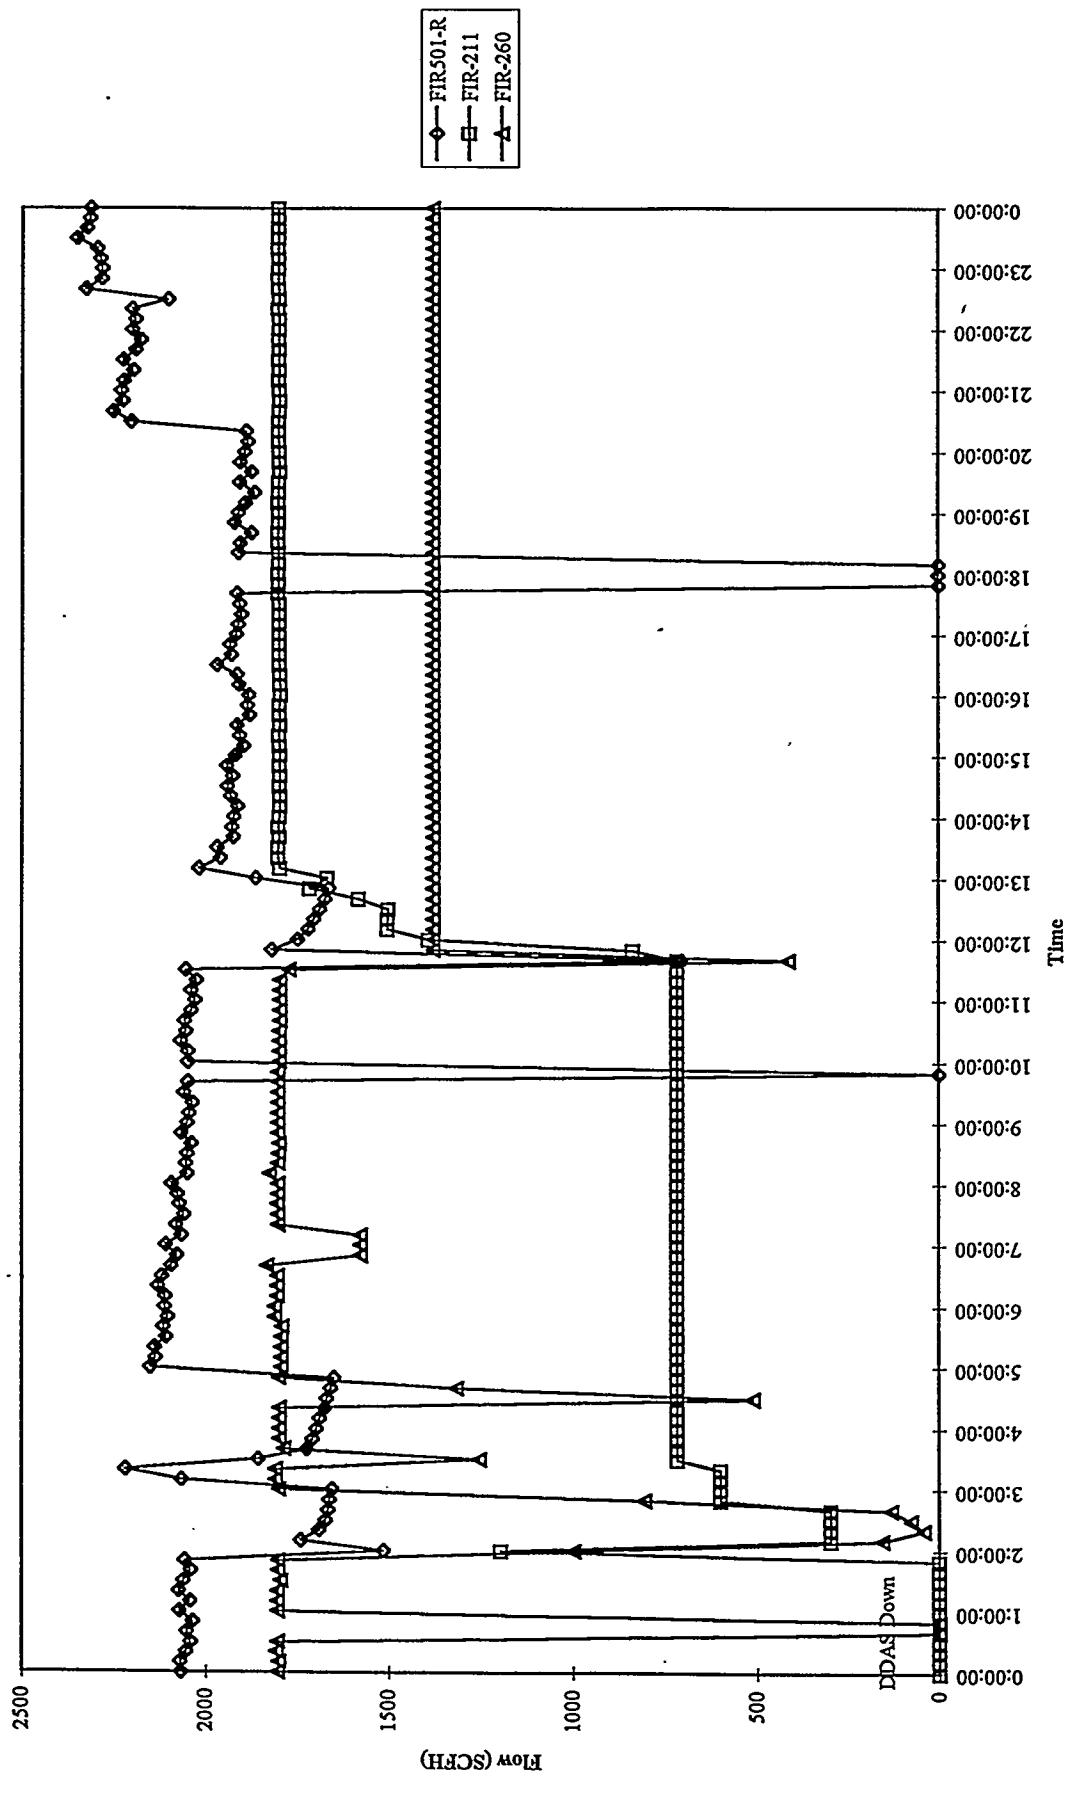

MGCR Inlet and Exit Flows
Run 94MGC09, 09/16/94

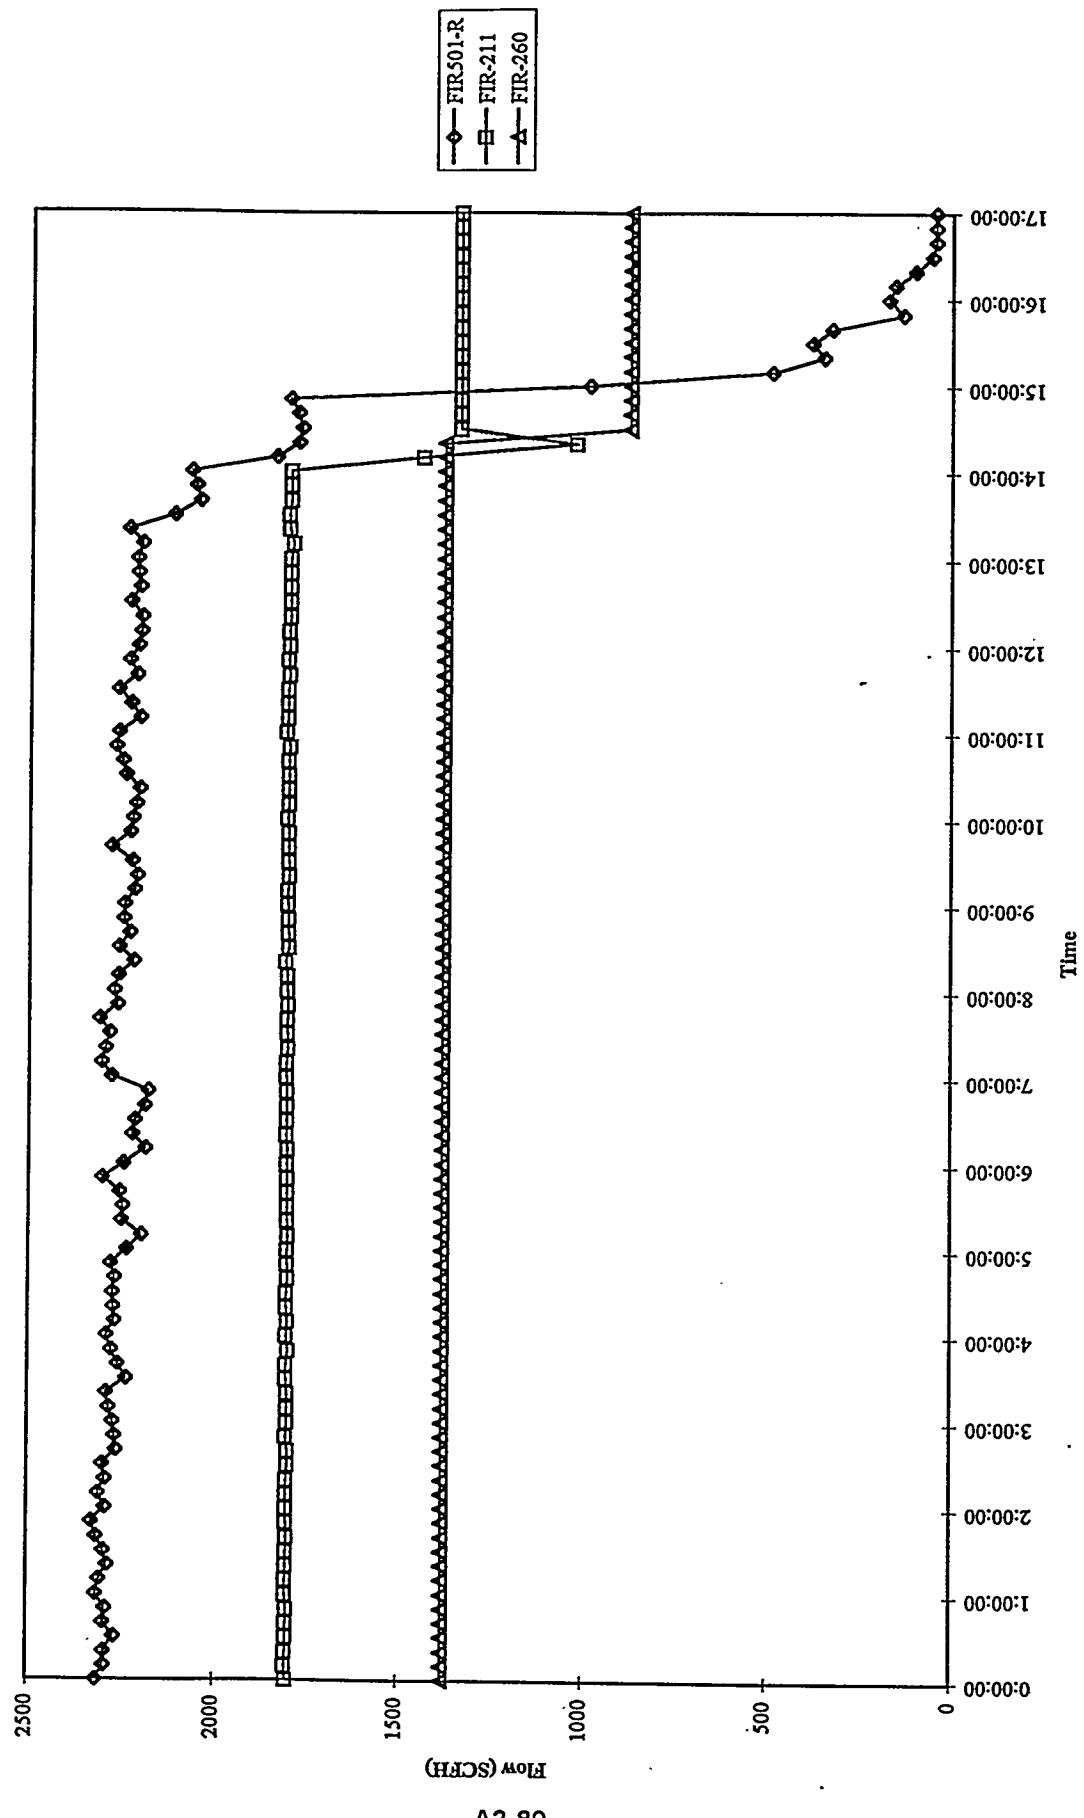


MGCR Process Gas Line Temperatures
Run 94MGC09, 09/12/94

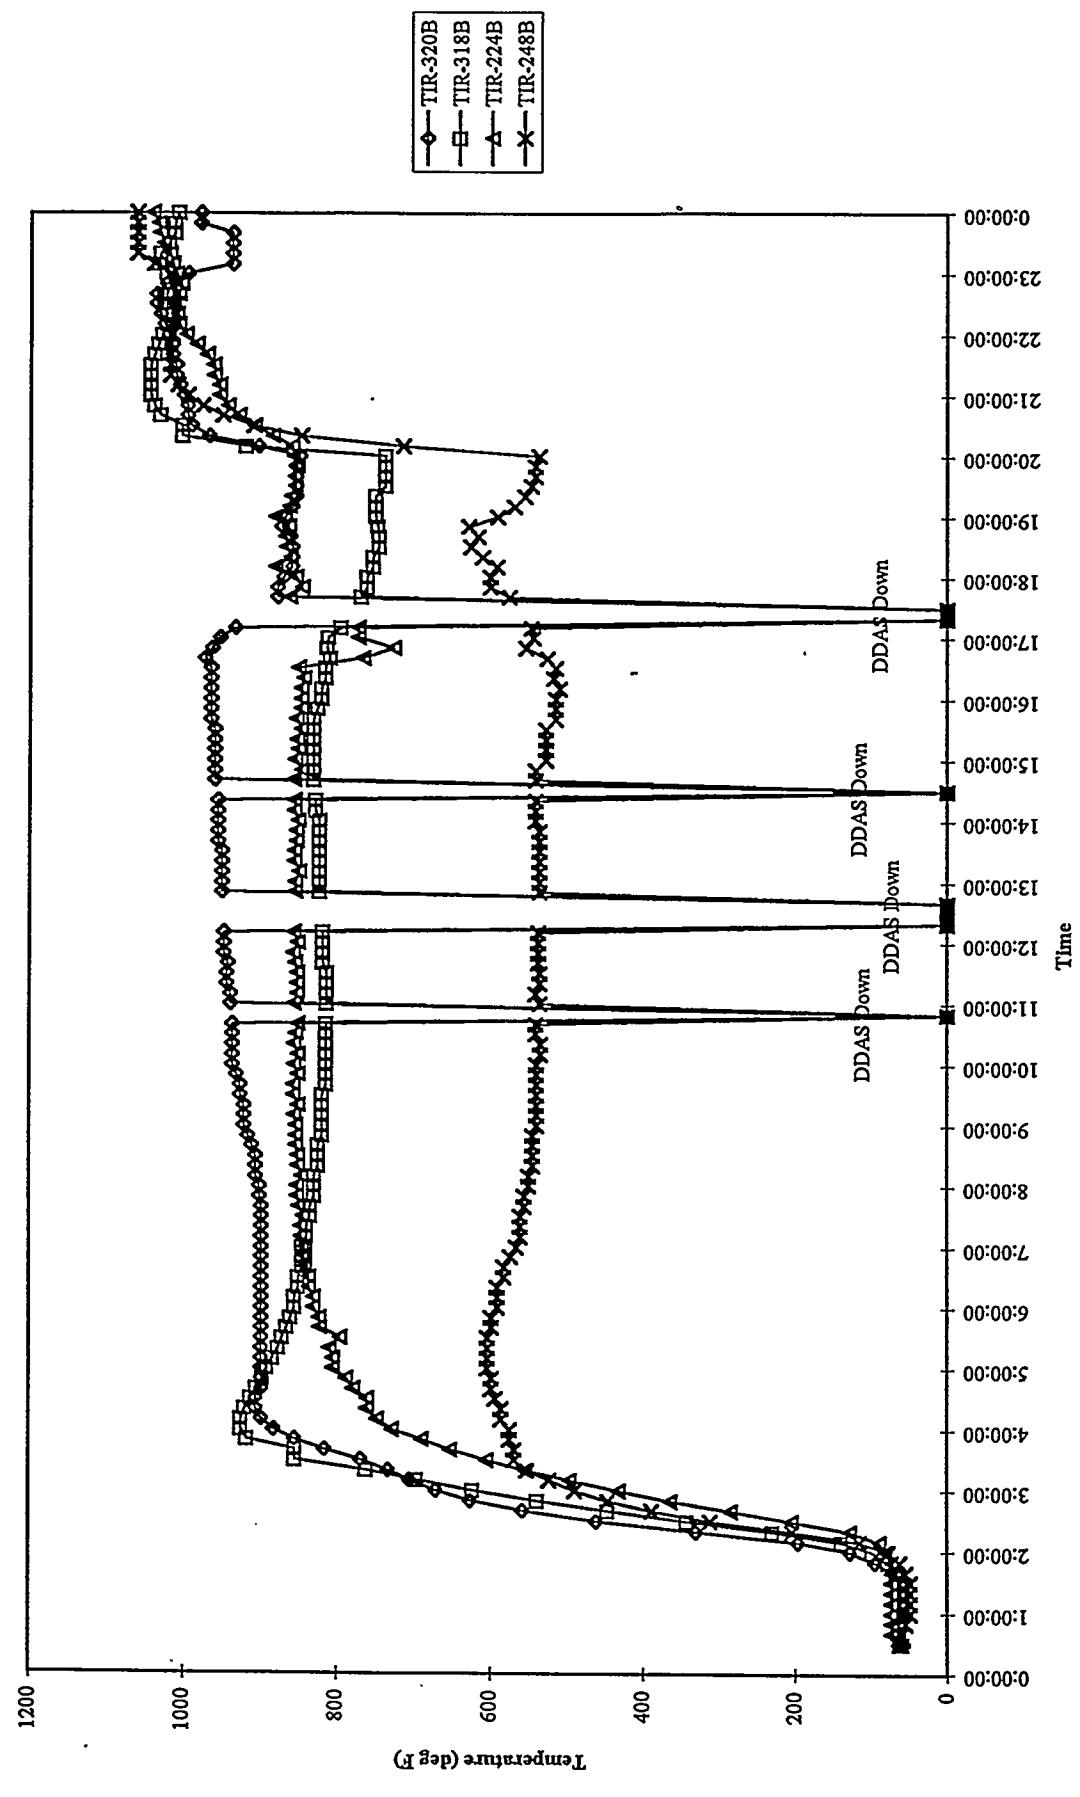


A3-90

MGCR Process Gas Line Temperatures
Run 94MGC09, 09/13/94

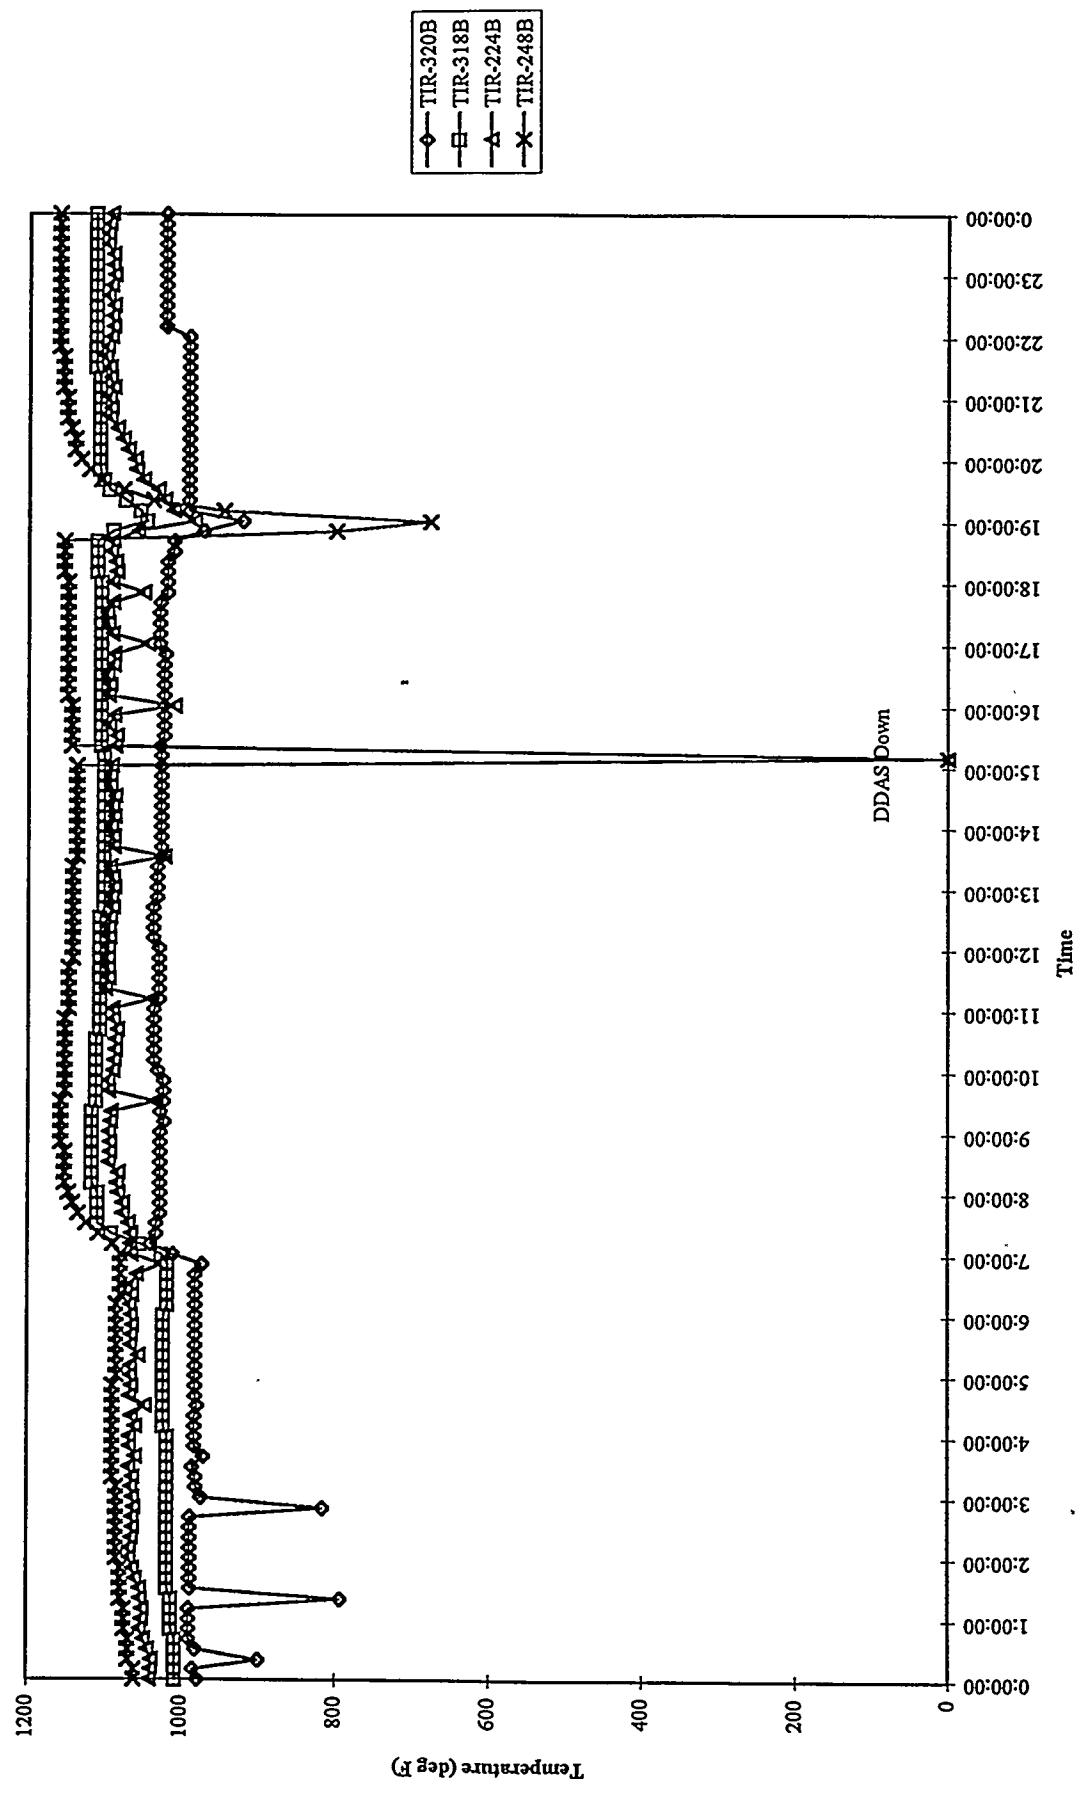


A3-91


MGCR Process Gas Line Temperatures
Run 94MGC09, 09/14/94

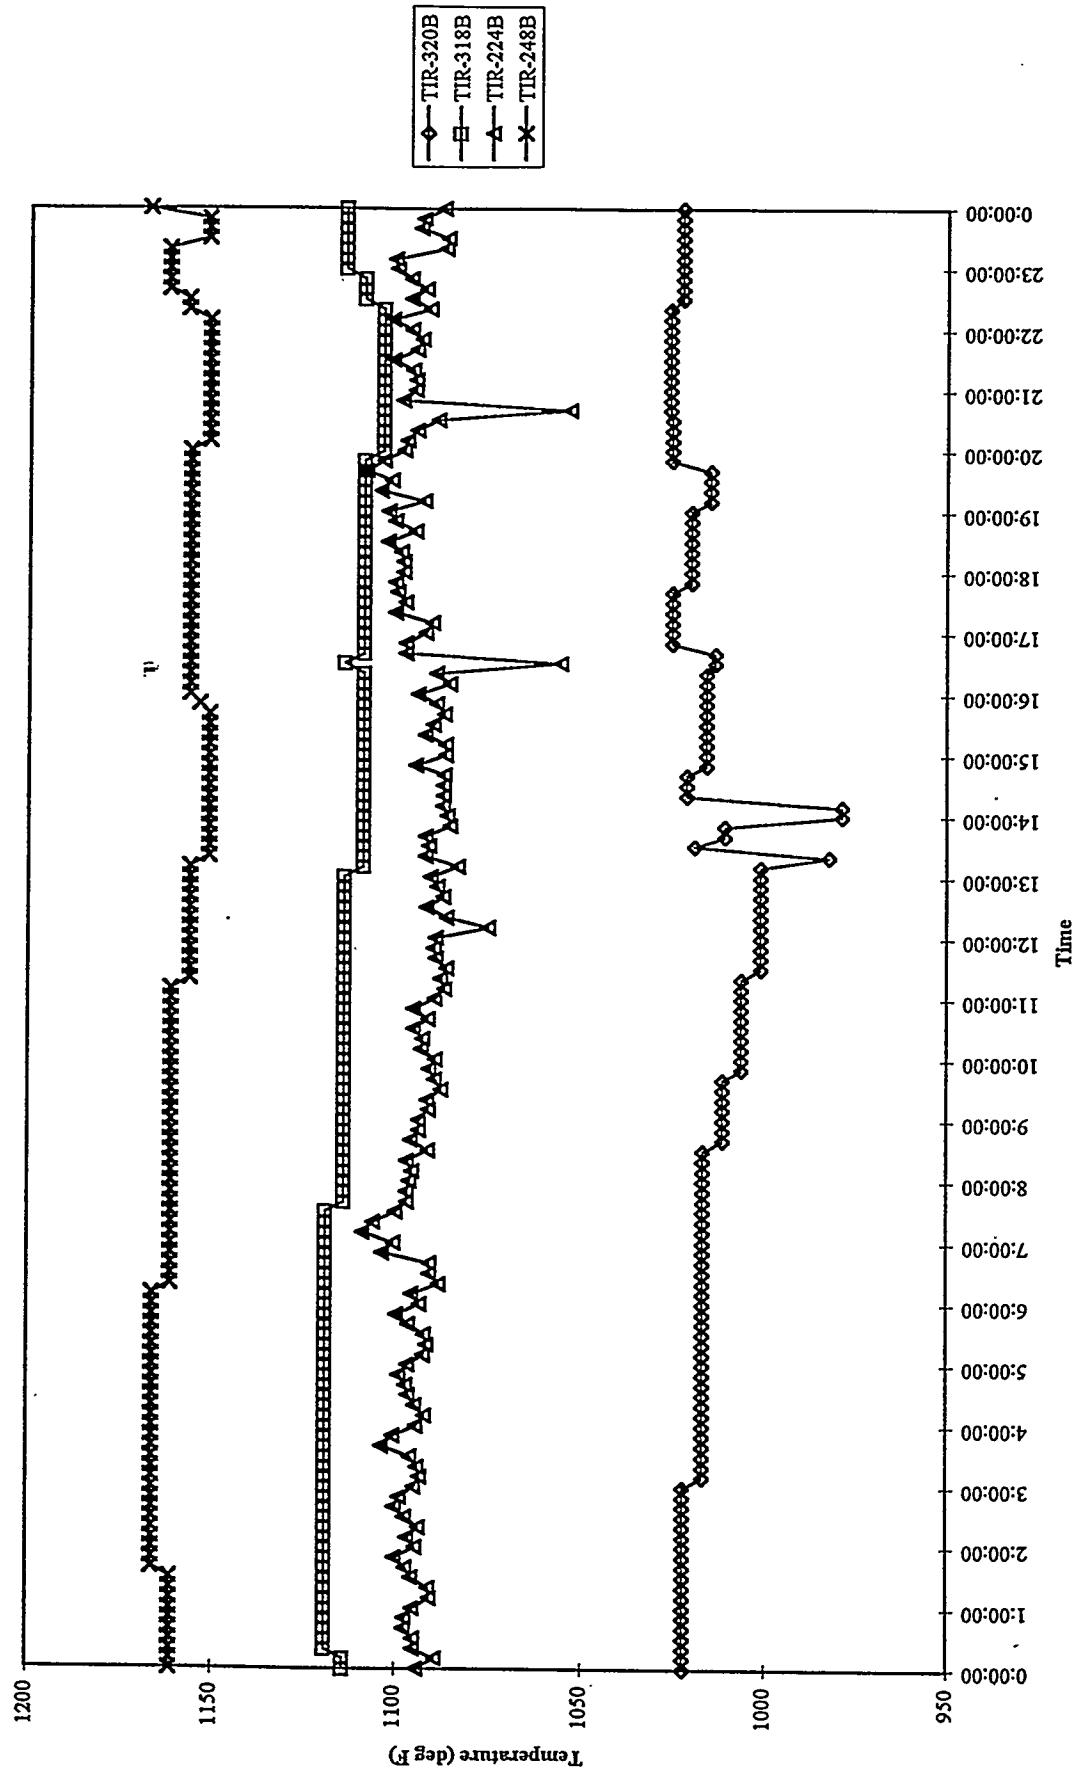

MGCR Process Gas Line Temperatures
Run 94MGC09, 09/15/94

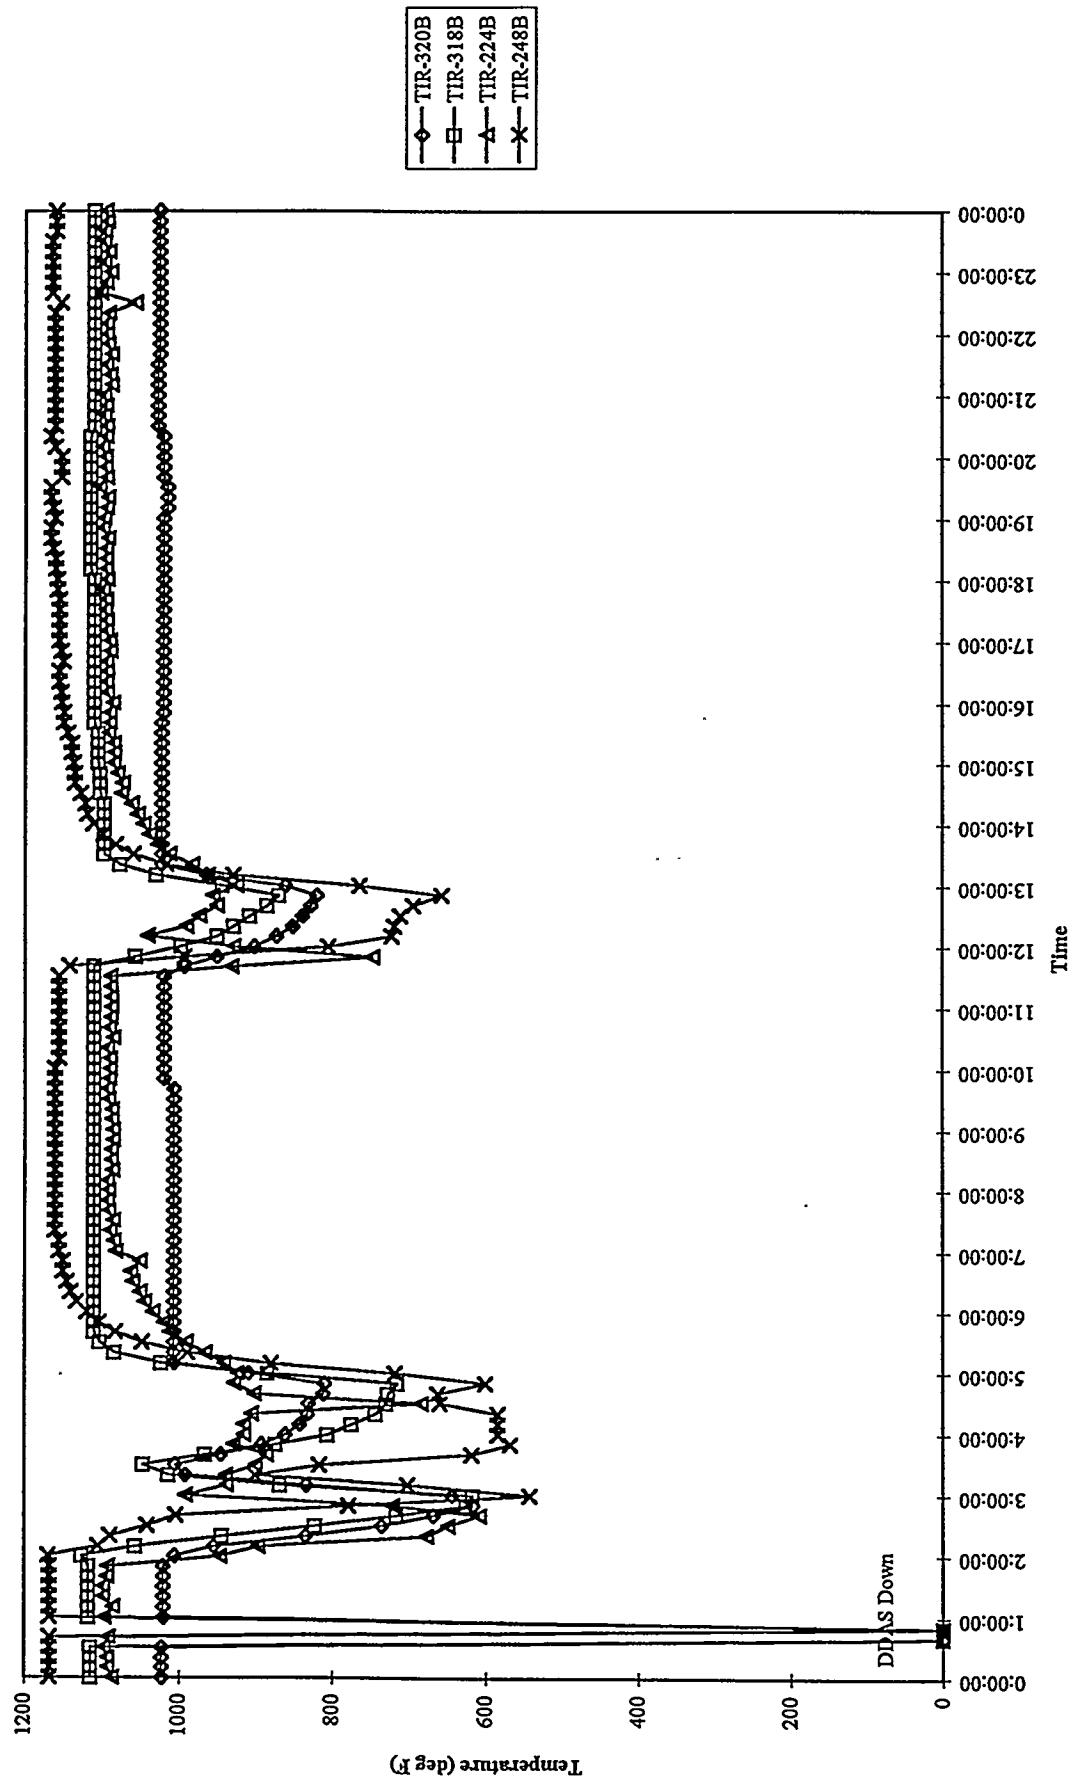


MGCR Process Gas Line Temperatures
Run 94MGC09, 09/16/94

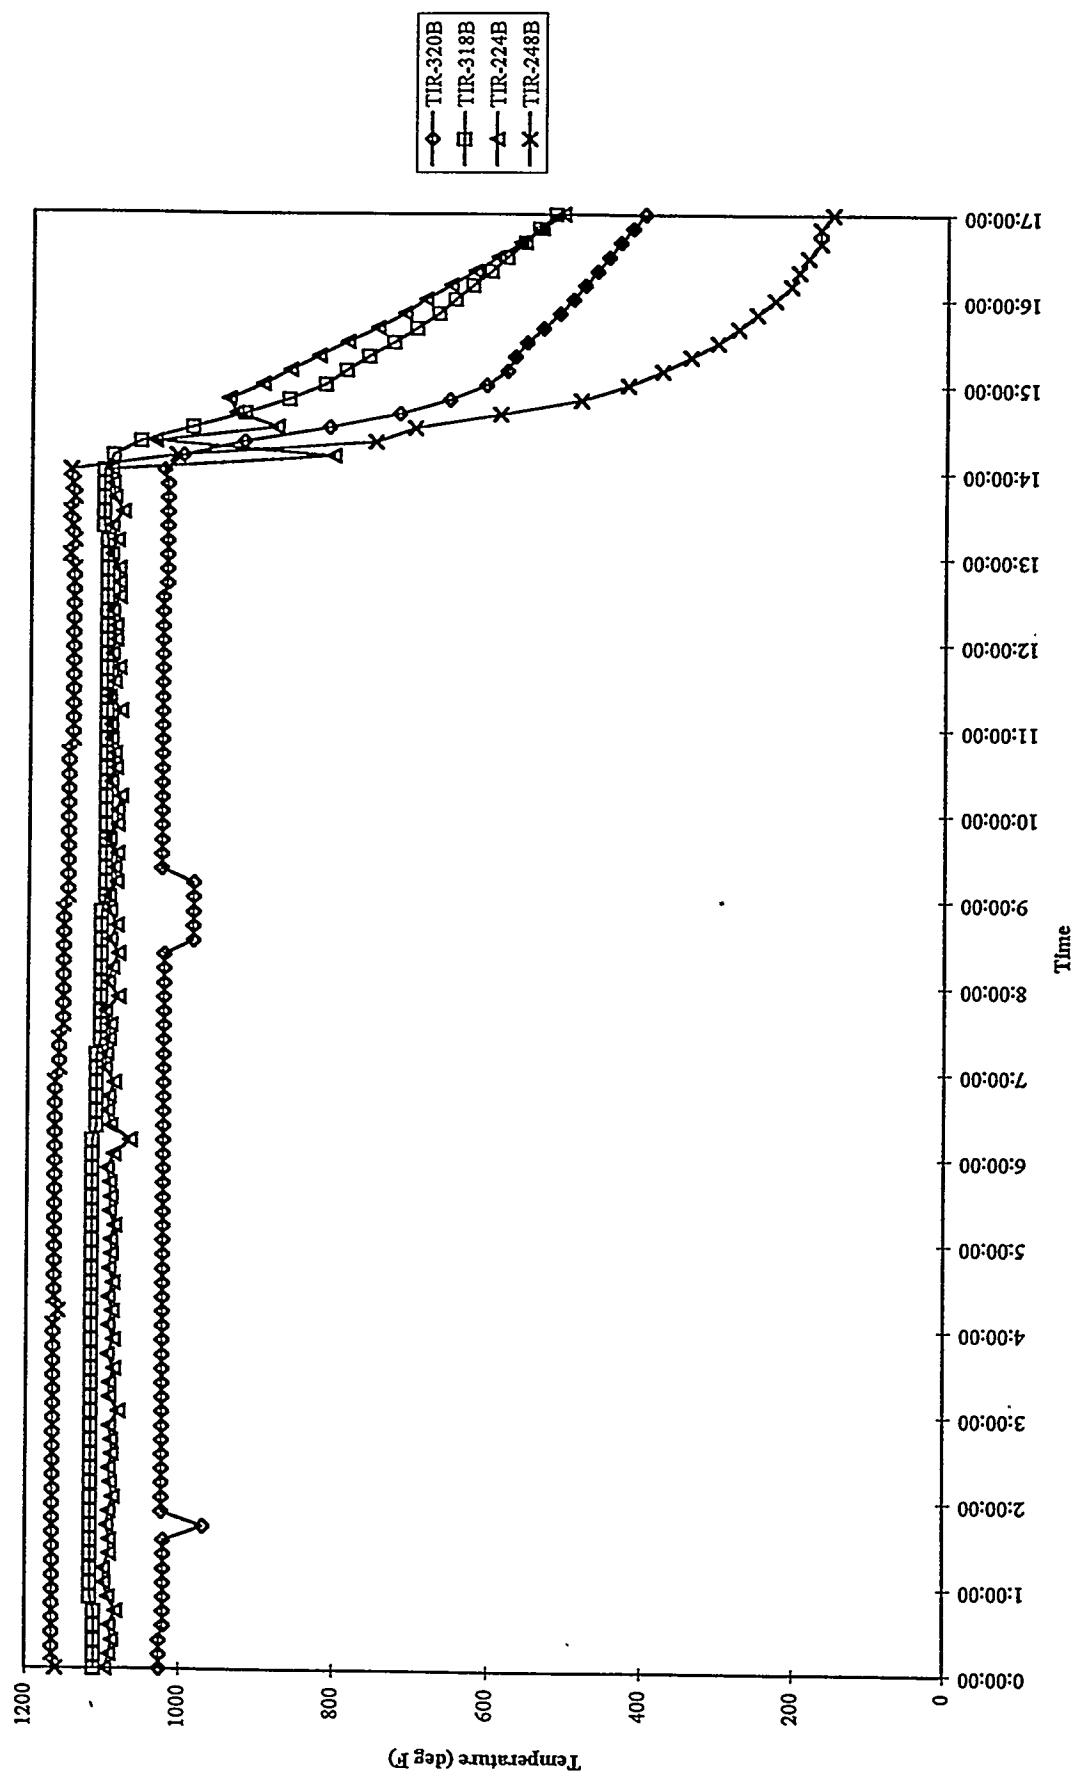


A3-94


FBG and MGCR Process Pressures
Run 94FBG09, 09/12/94

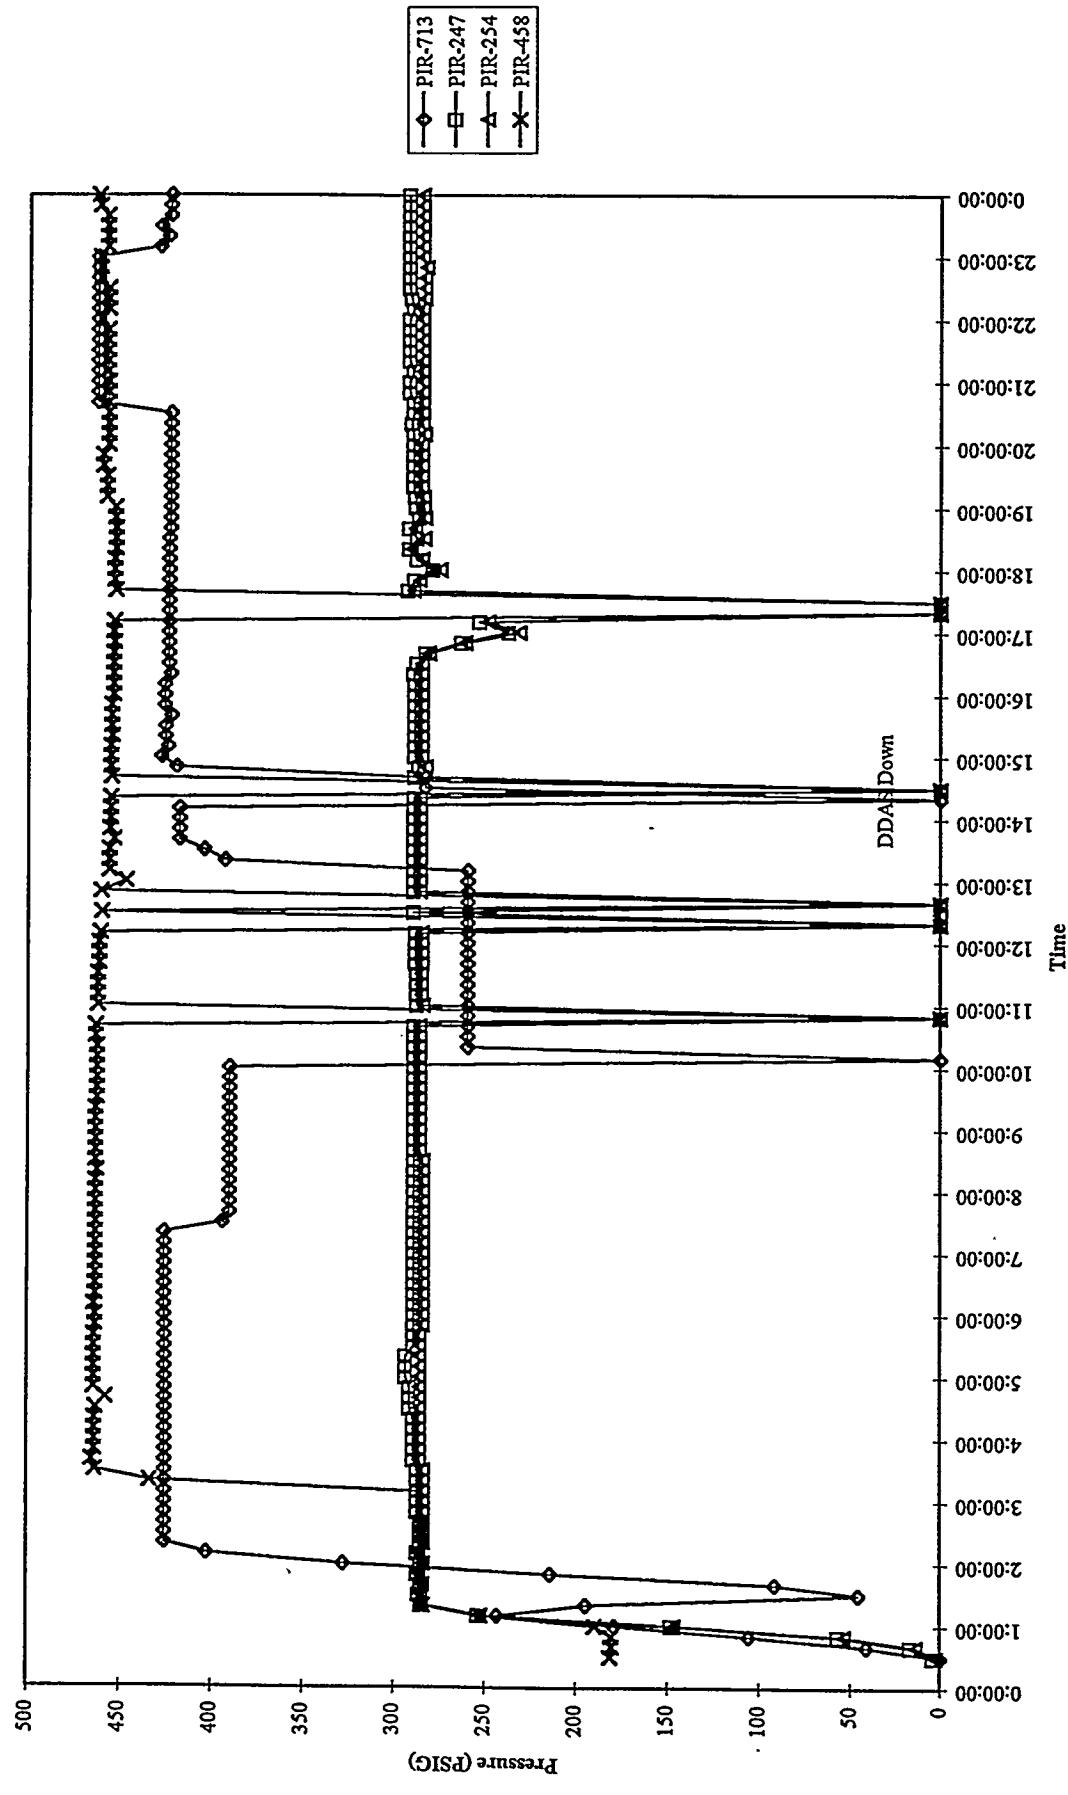

FBG and MGCR Process Pressures
Run 94FBG09, 09/13/94

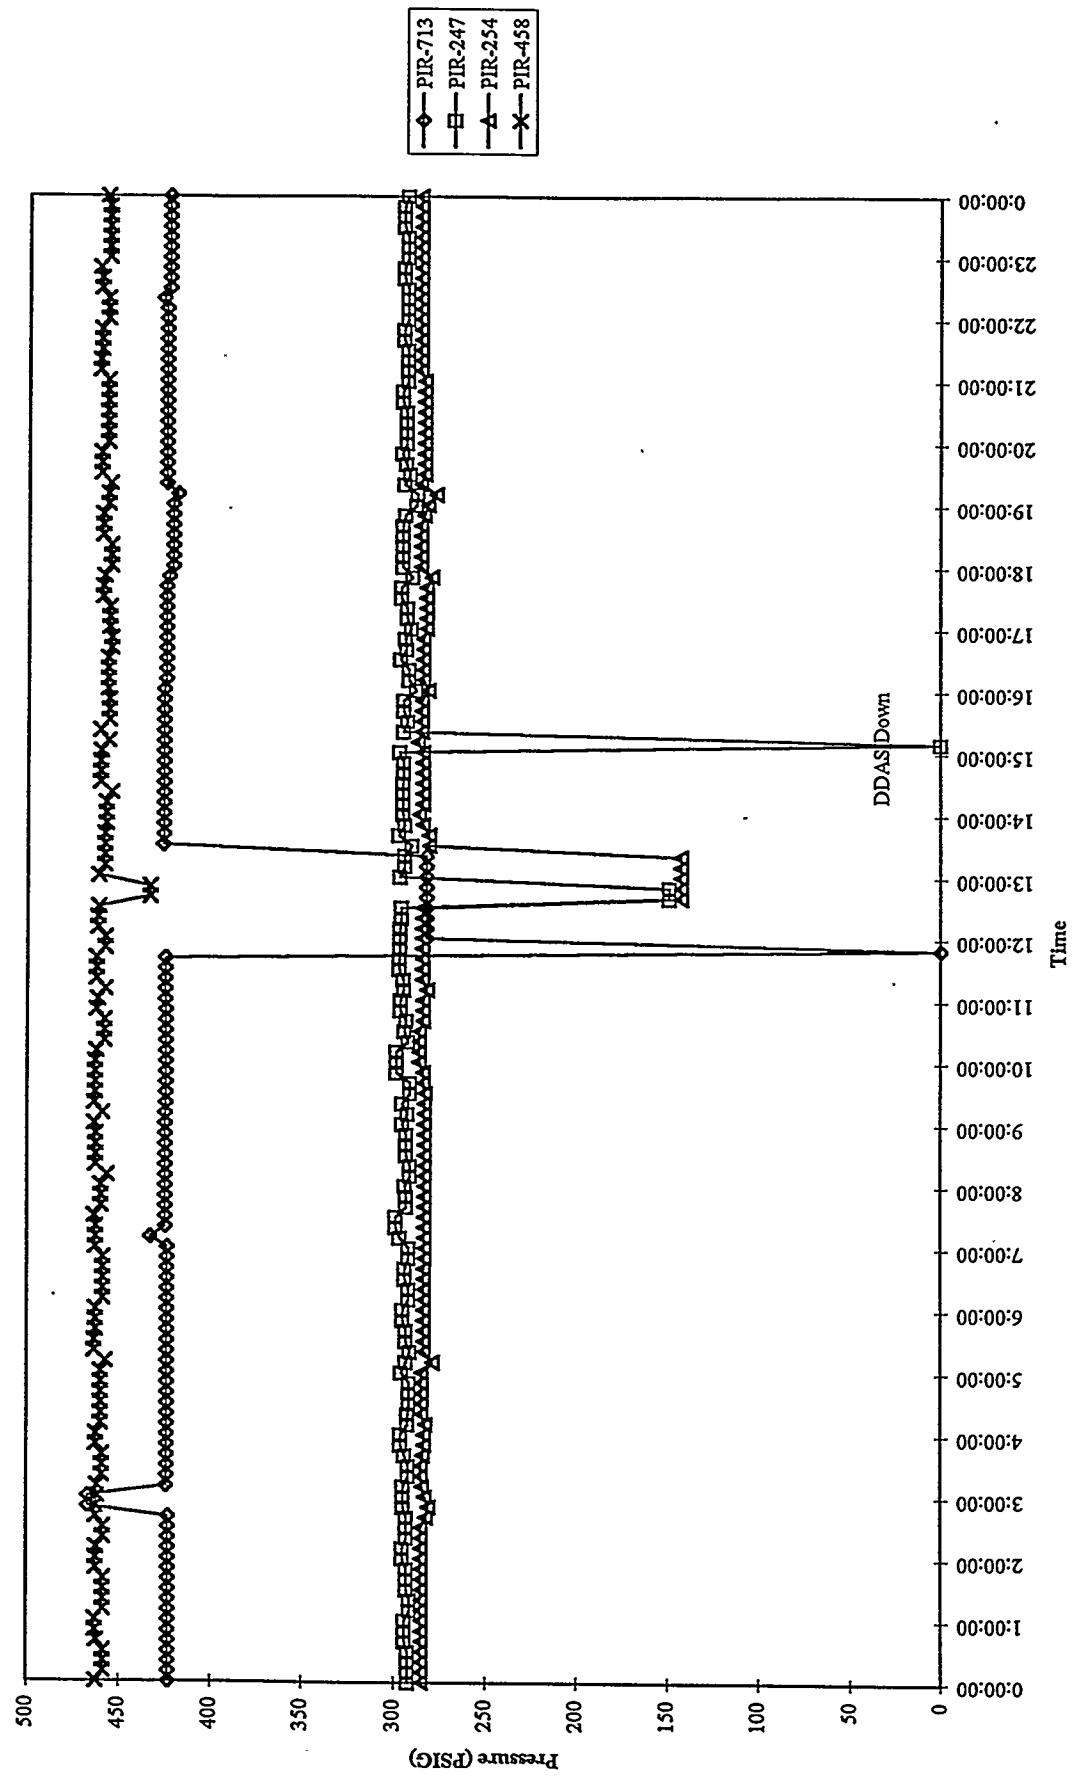


FBG and MGCR Process Pressures
Run 94FBG09, 09/14/94

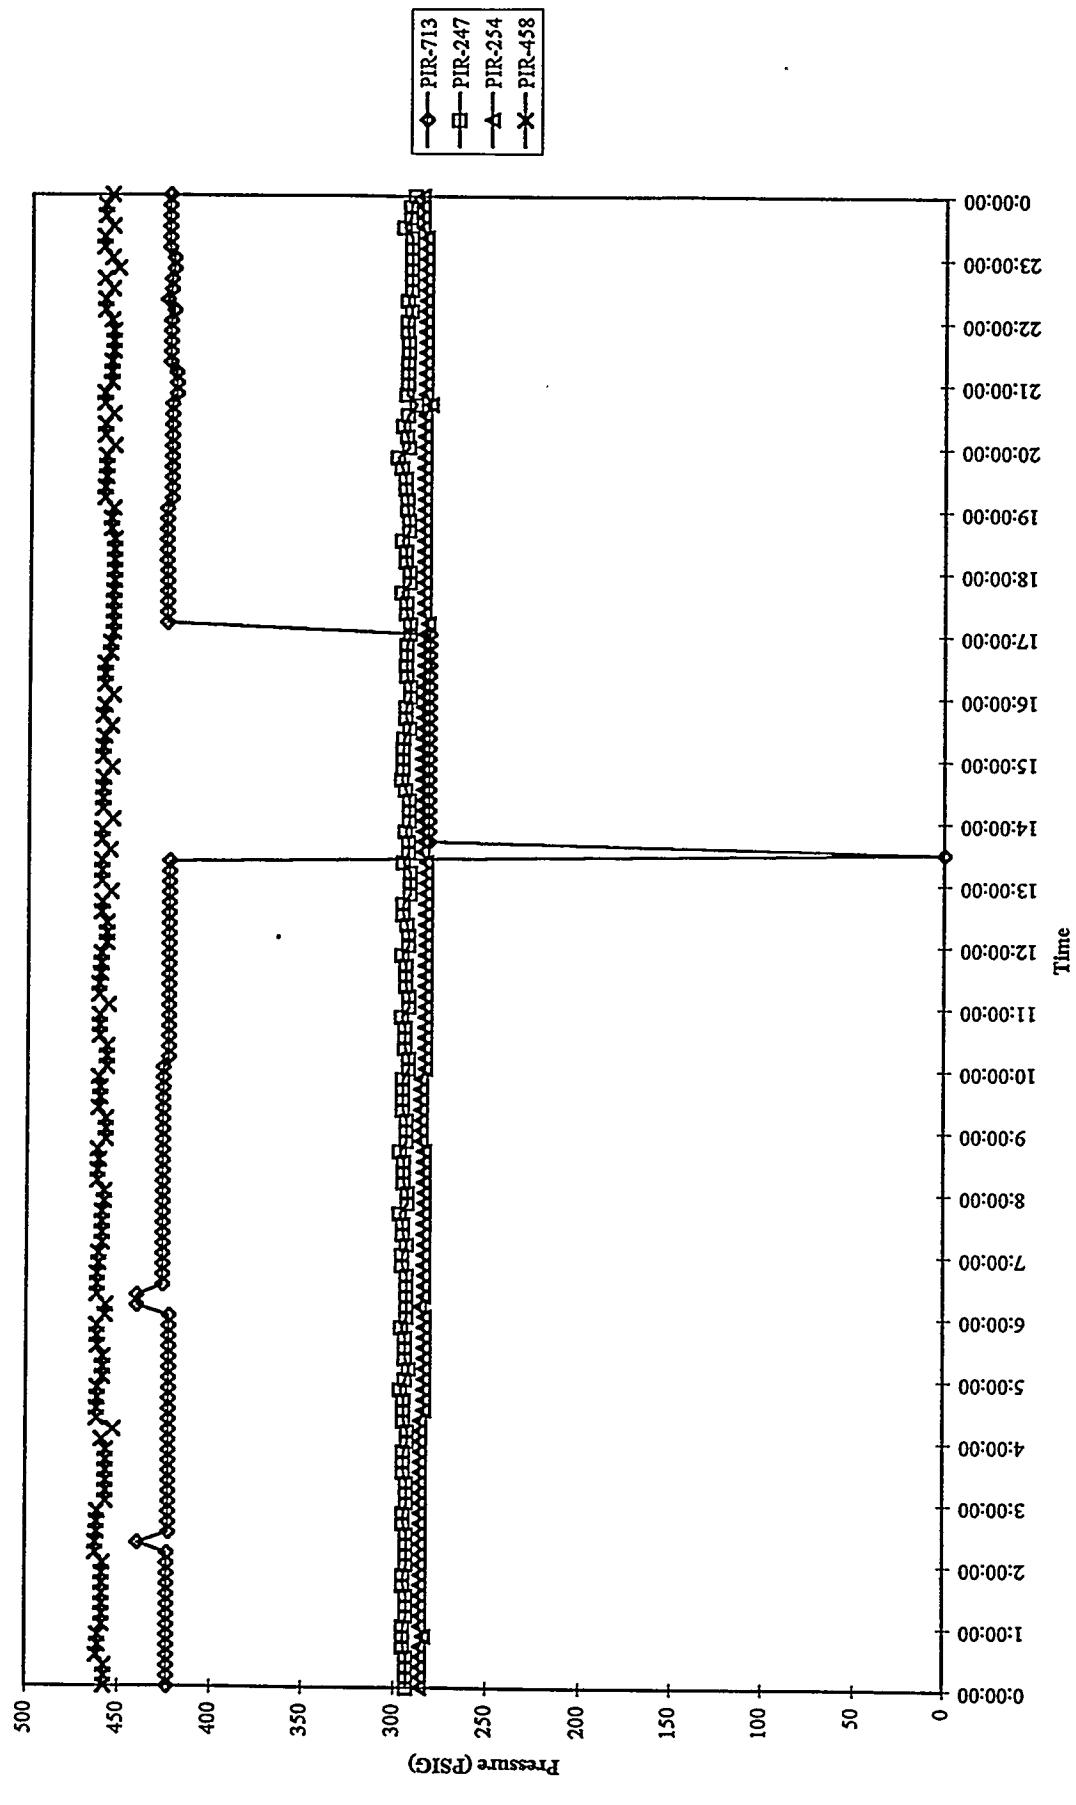


A3-97

FBG and MGCR Process Pressures
Run 94FBG09, 09/15/94

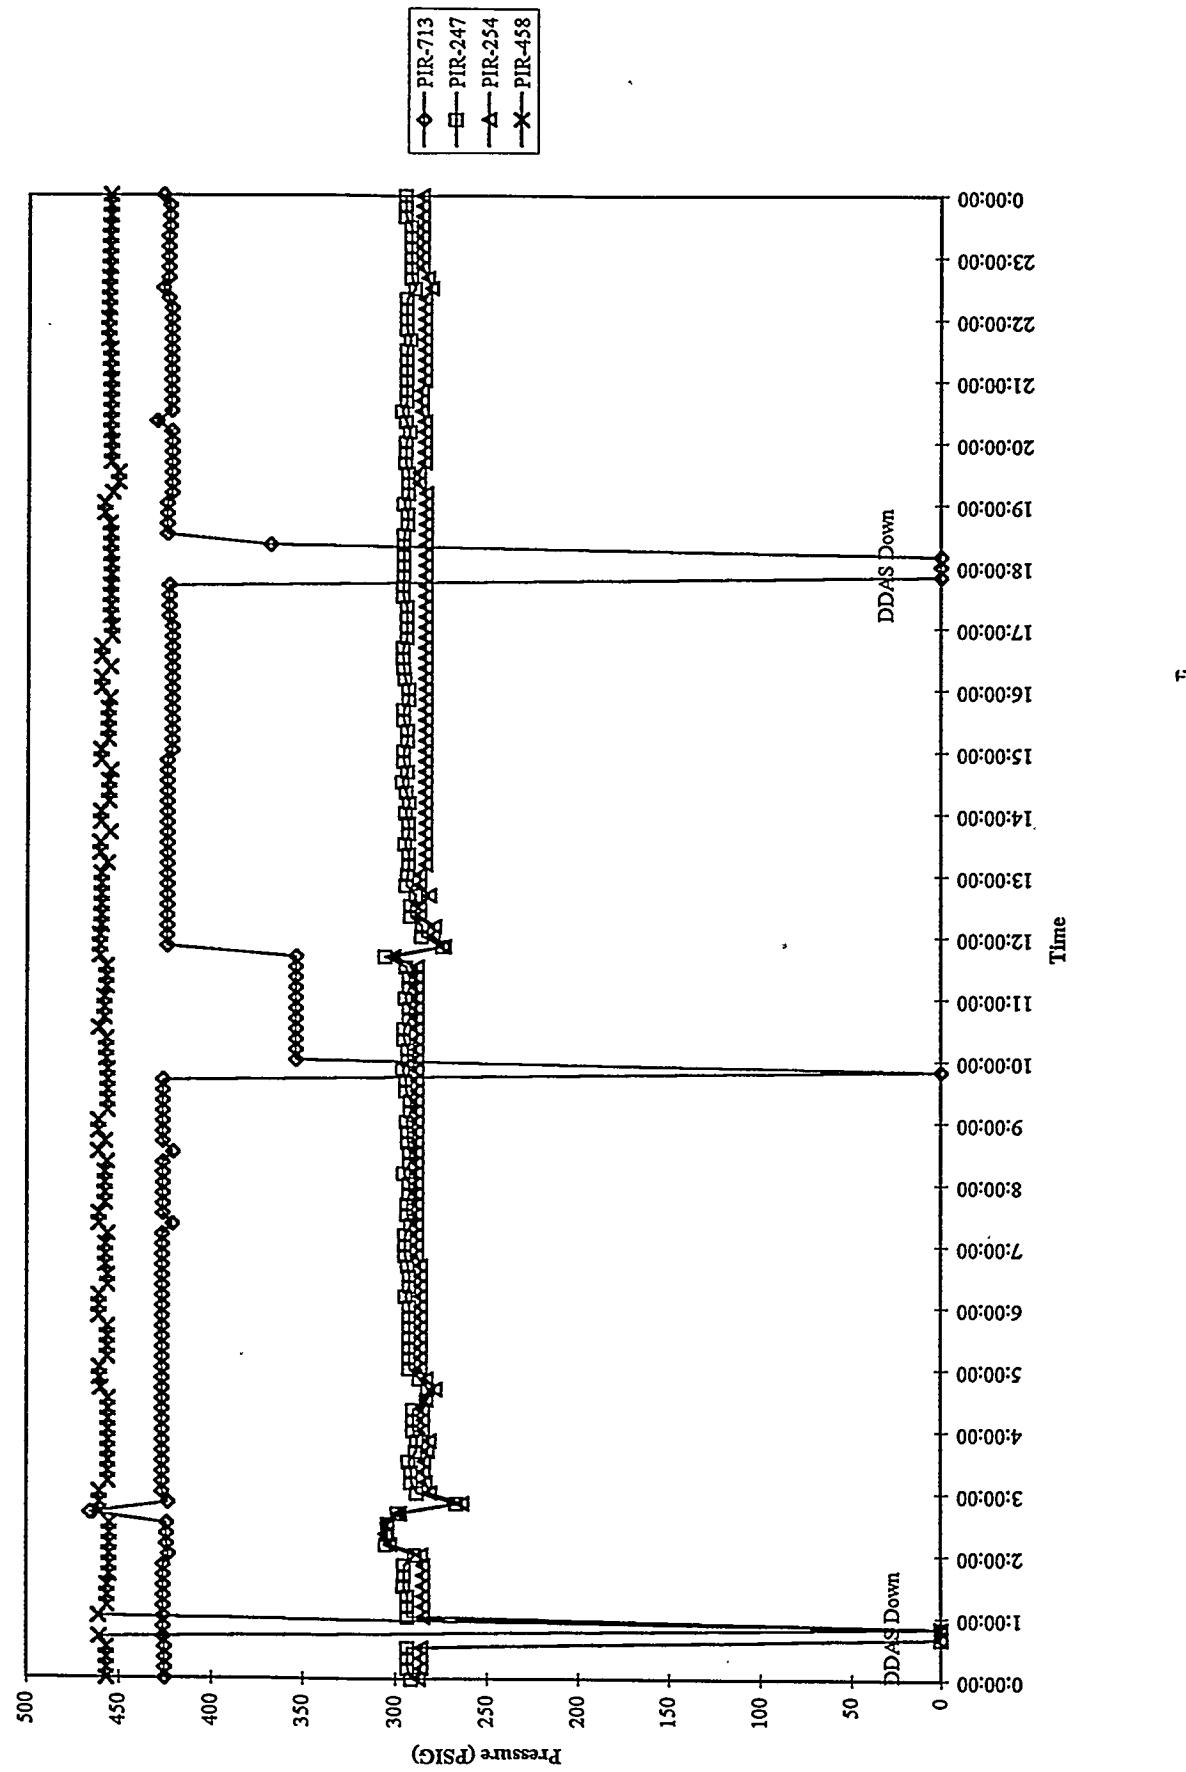


FBG and MGCR Process Pressures
Run 94FBG09, 09/16/94

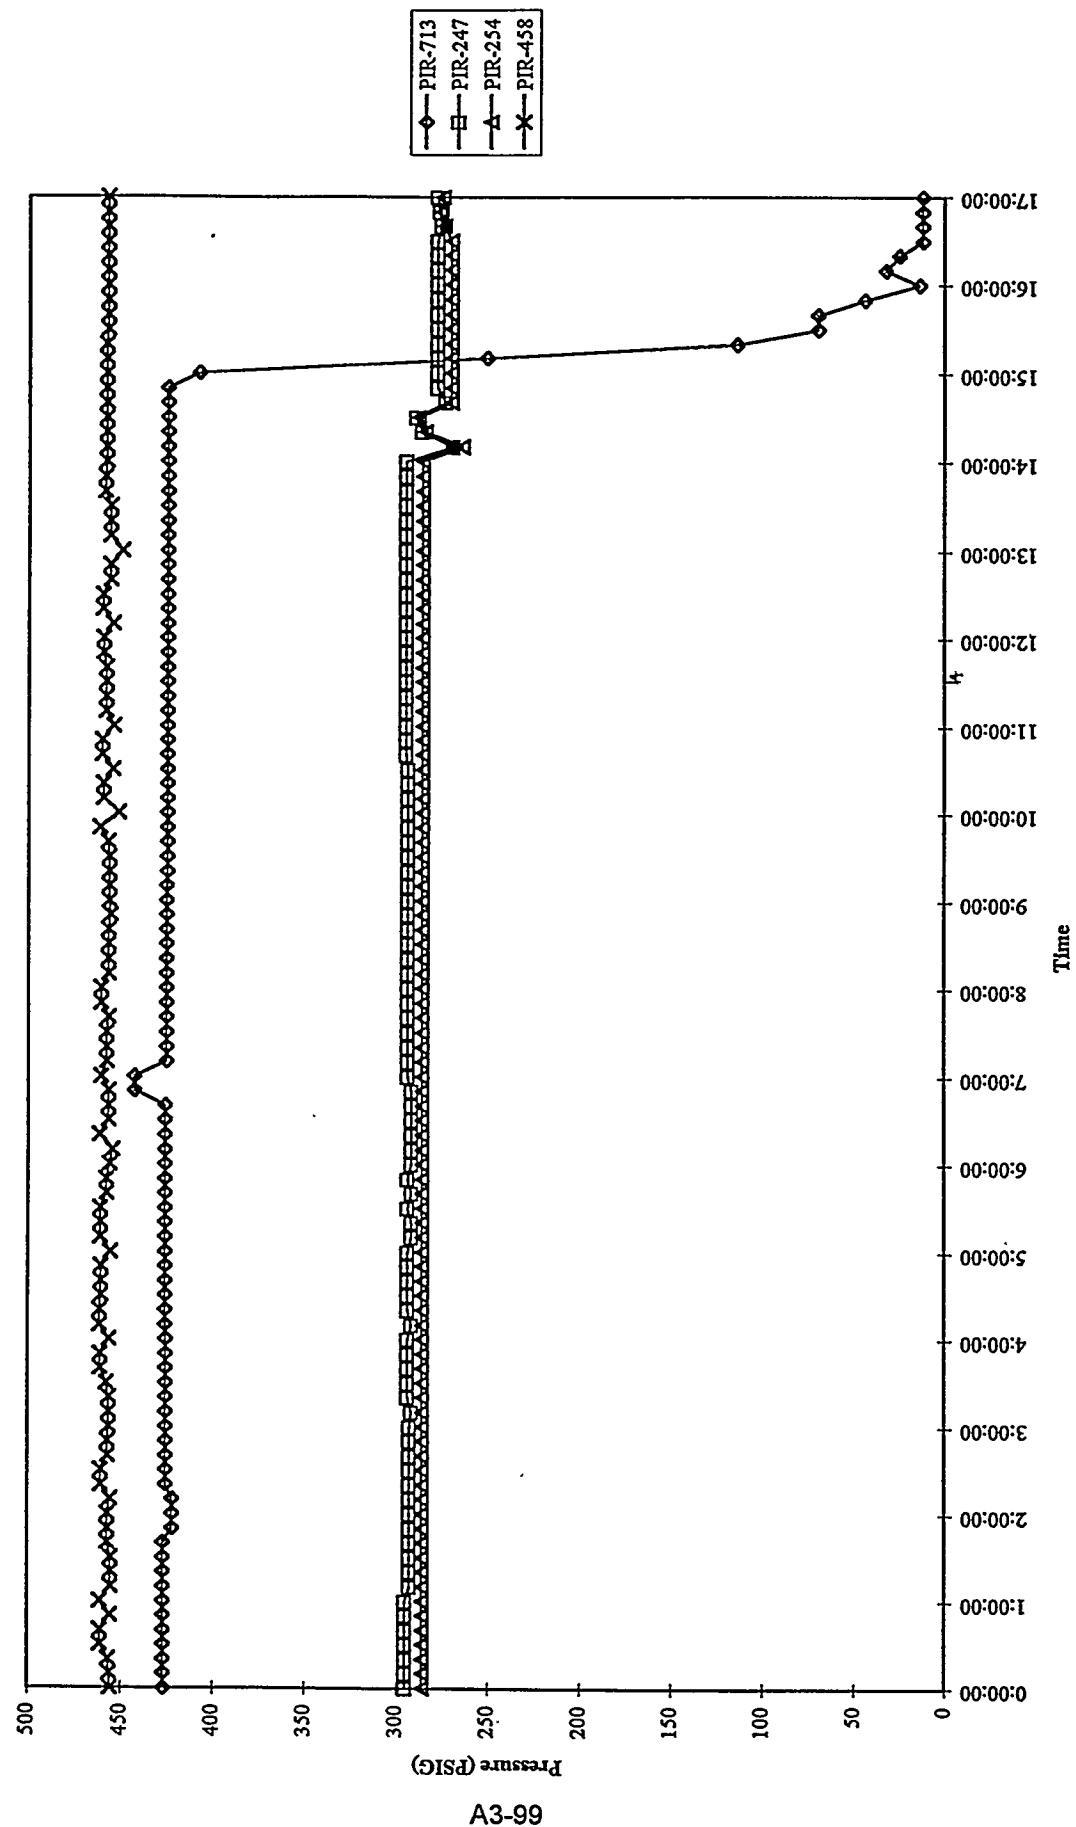


A3-99


F-100 Differential Pressure
Run 94MGC09, 09/12/94

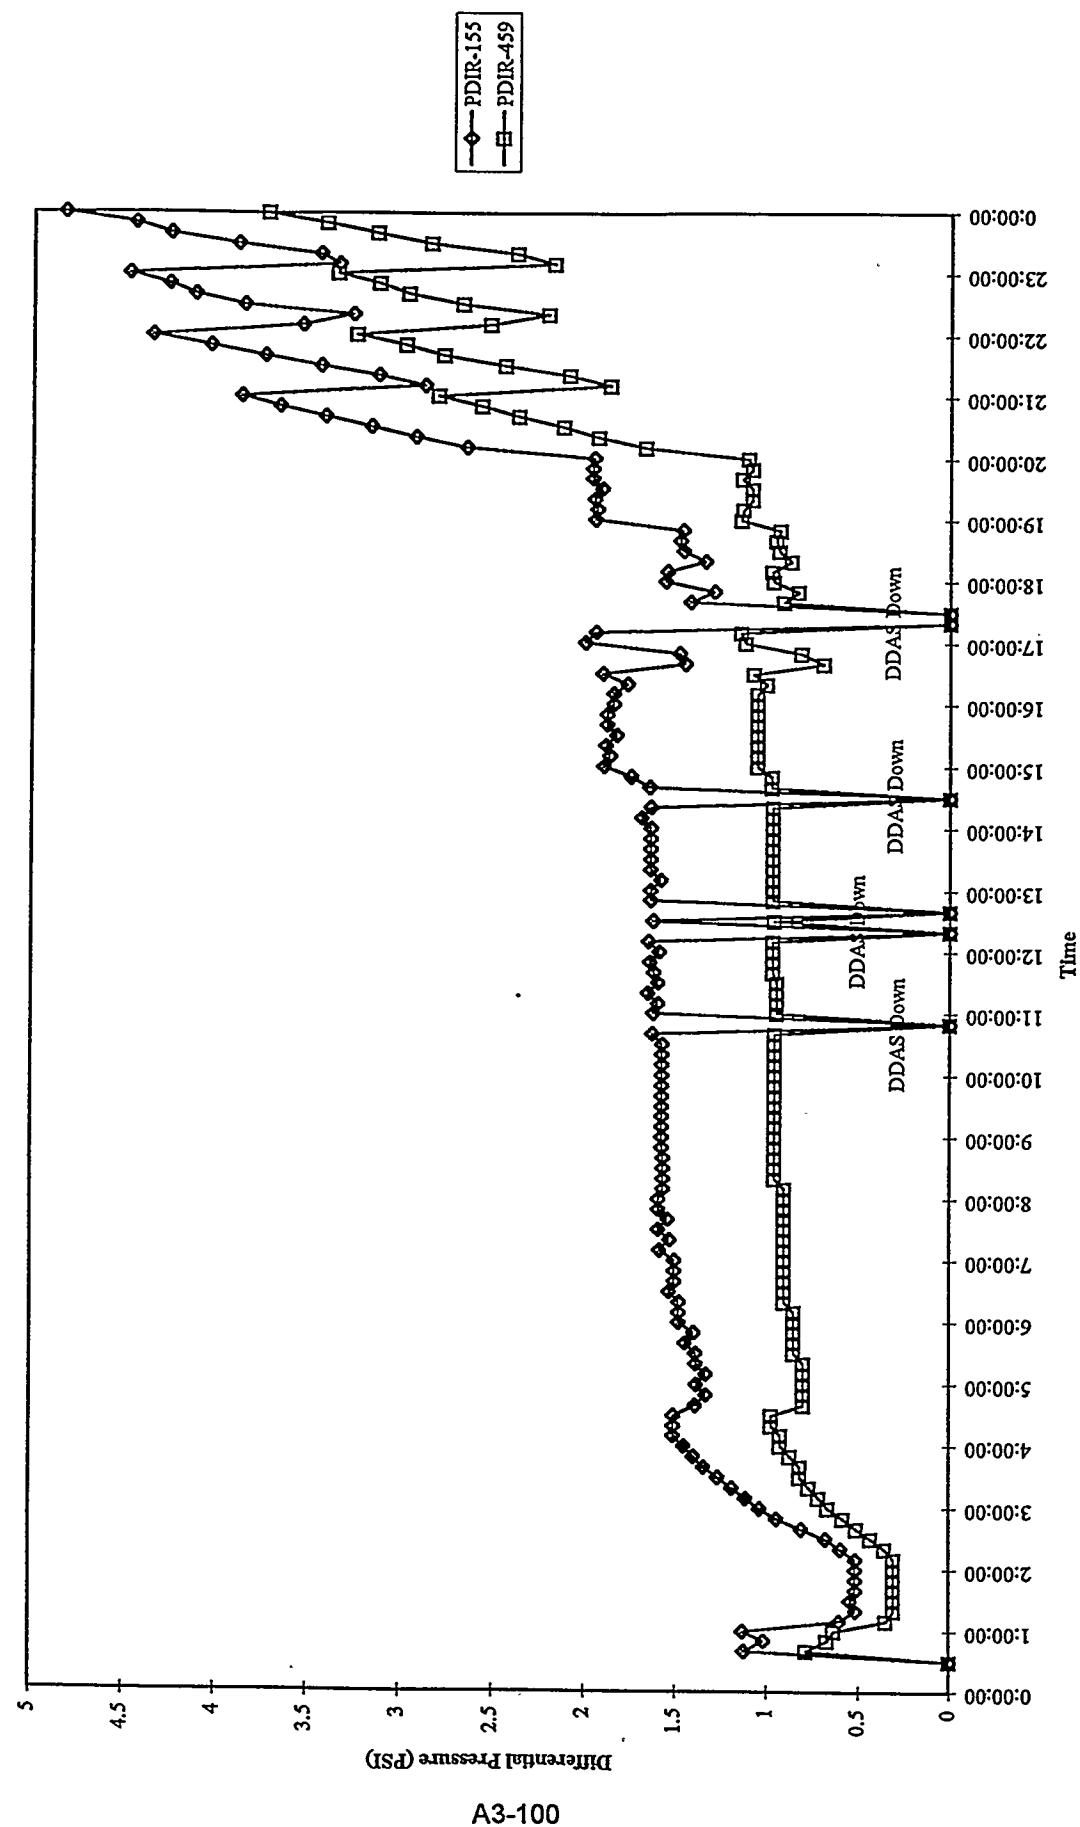

F-100 Differential Pressure
Run 94MGC09, 09/13/94

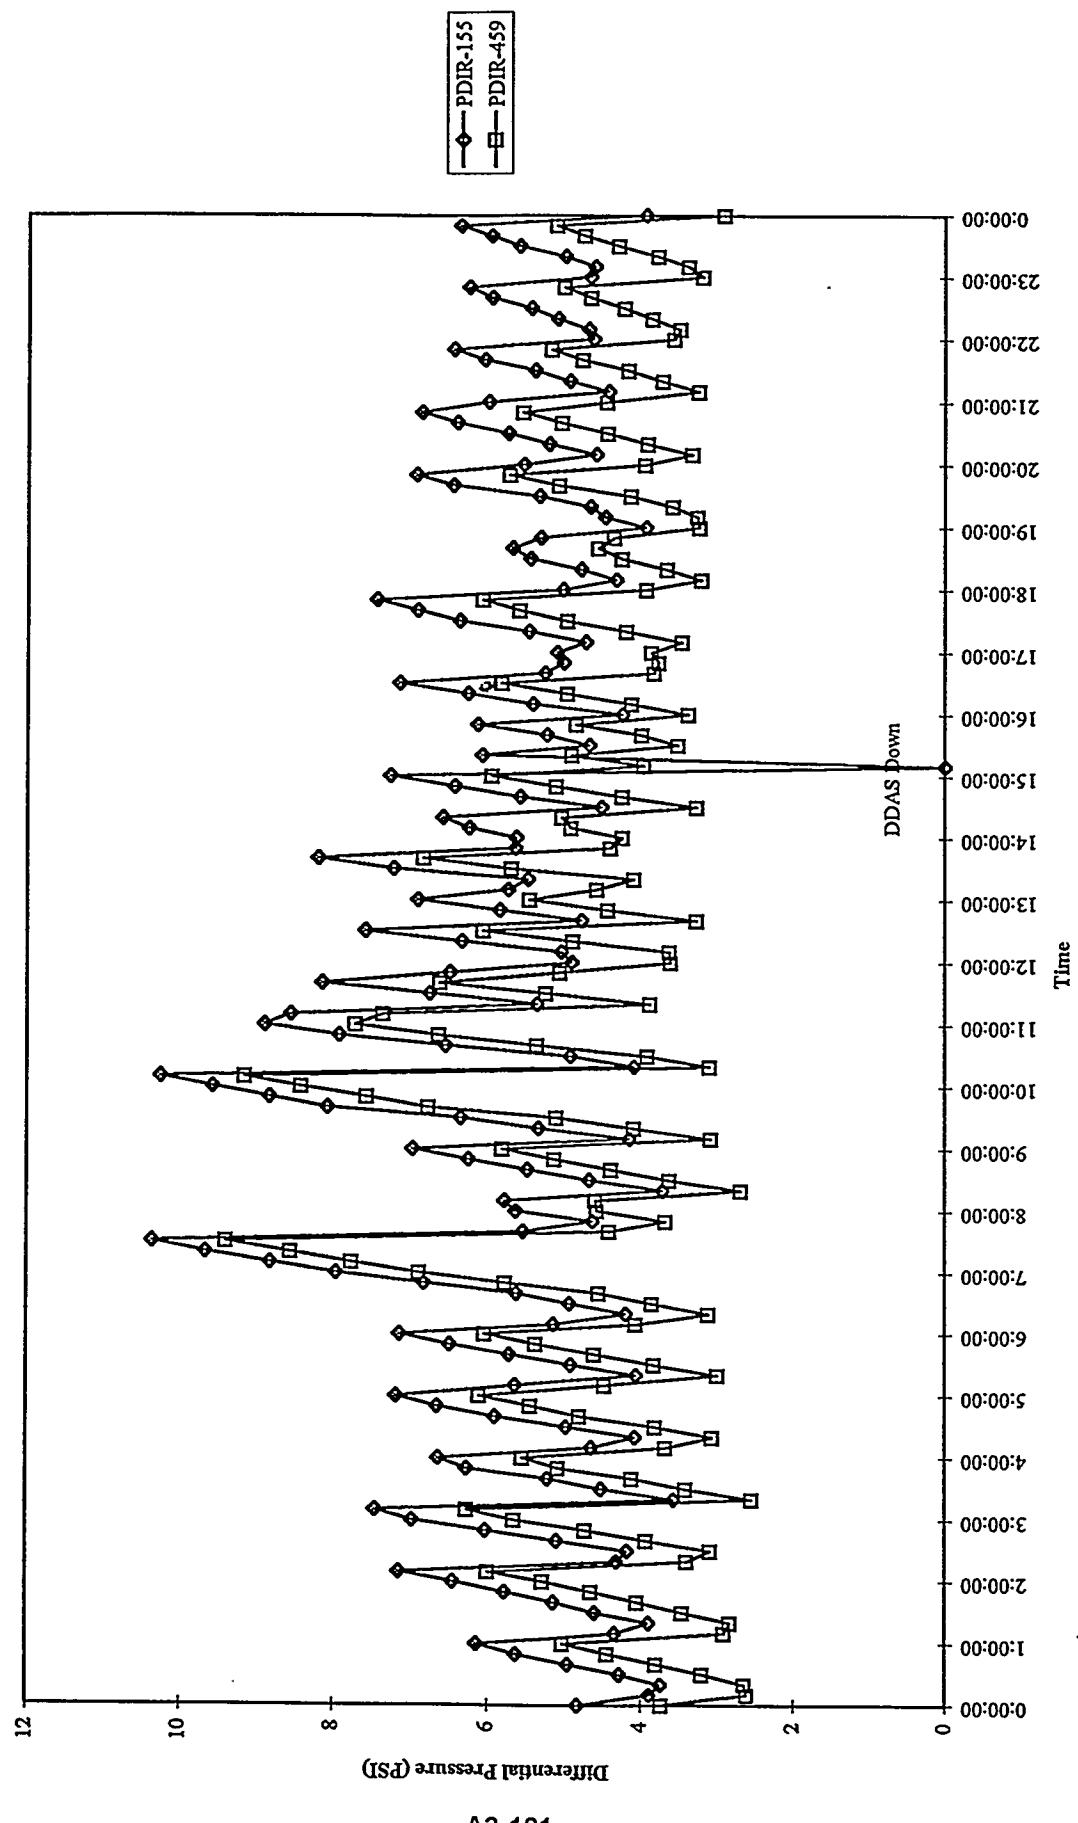


F-100 Differential Pressure
Run 94MGC09, 09/14/94

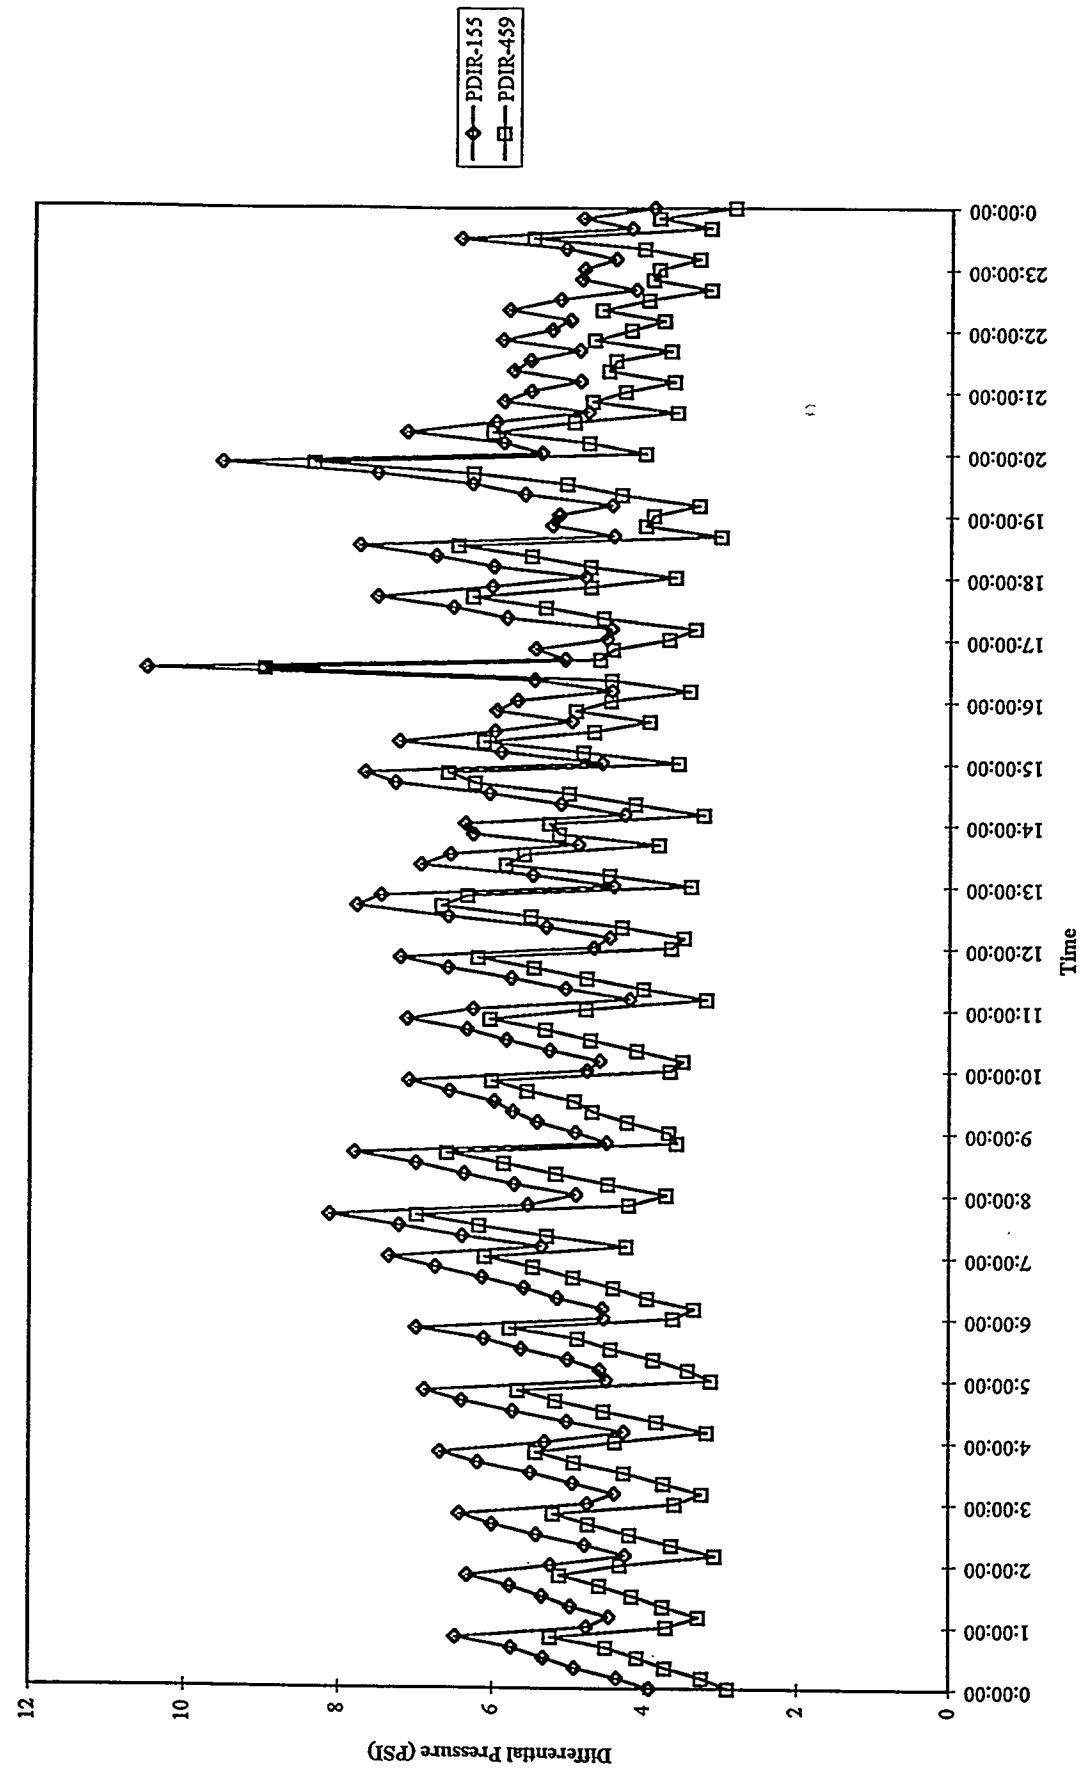


A3-102

T-100 Differential Pressure
Run 94MGC09, 09/15/94

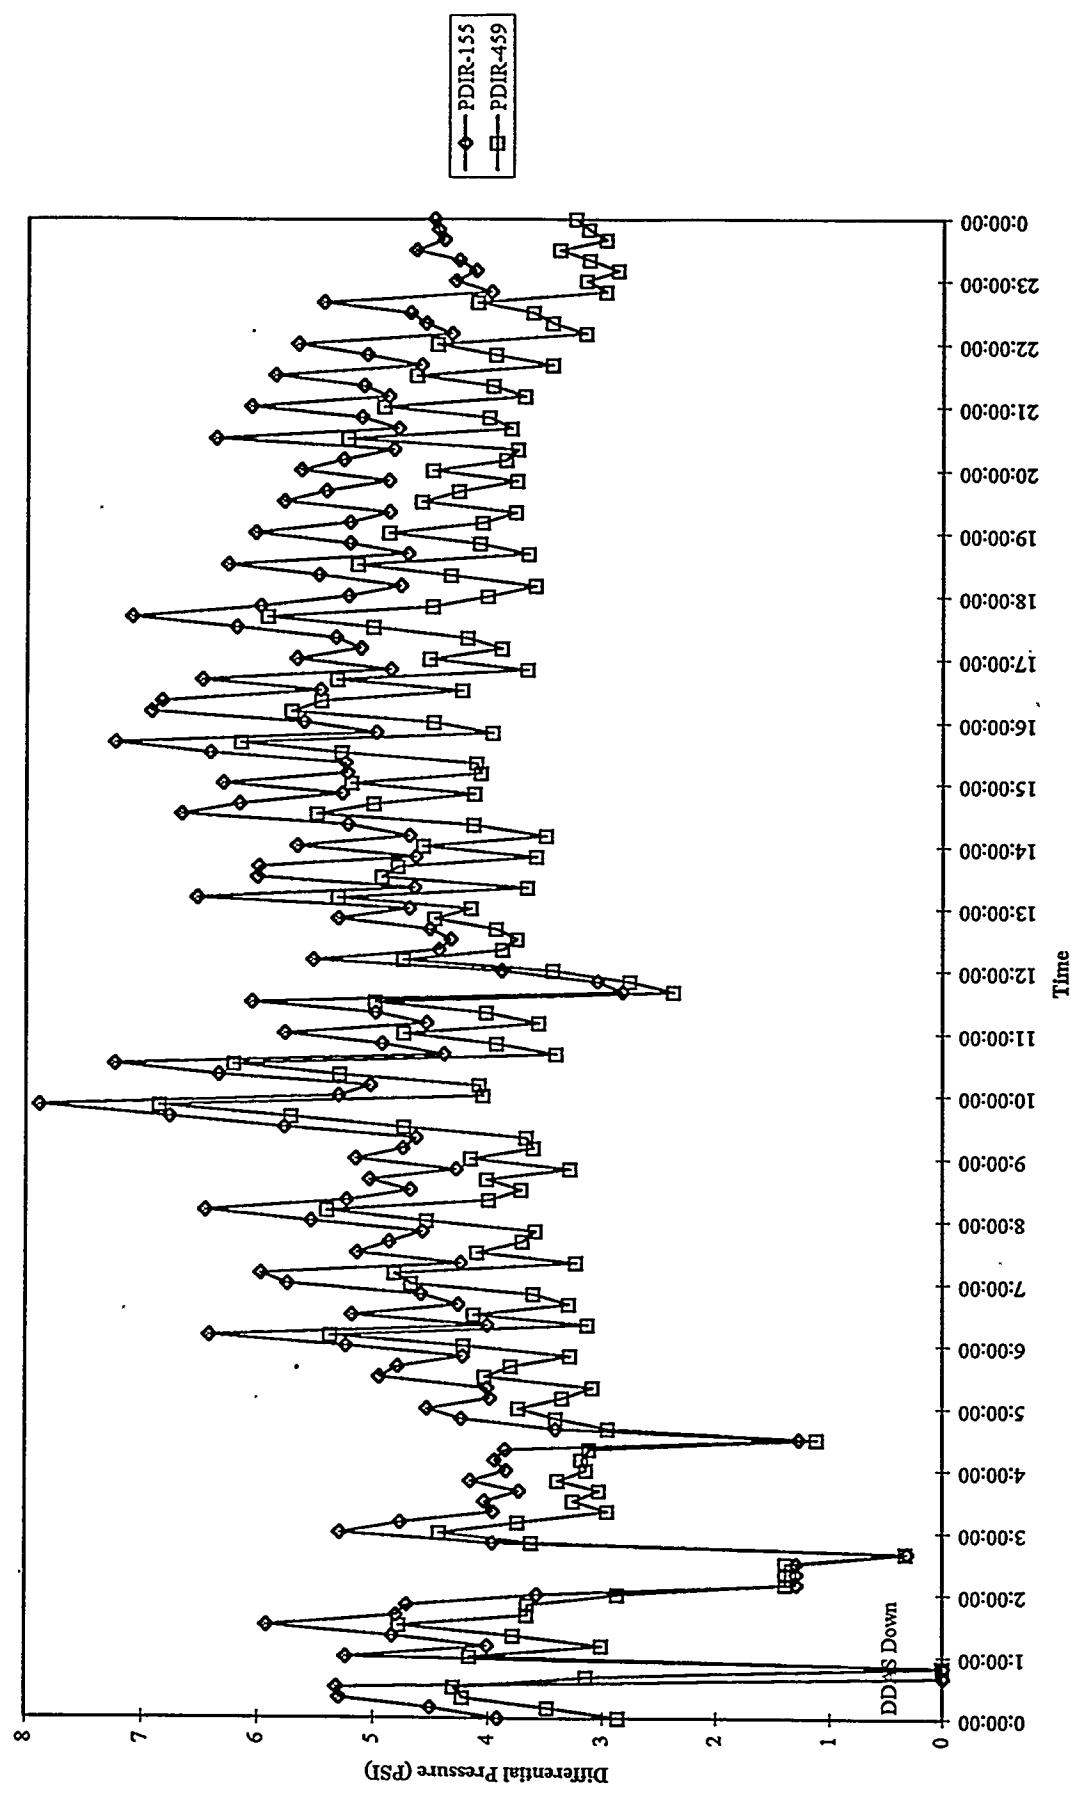

A3-103


F-100 Differential Pressure
Run 94MGC09, 09/16/94

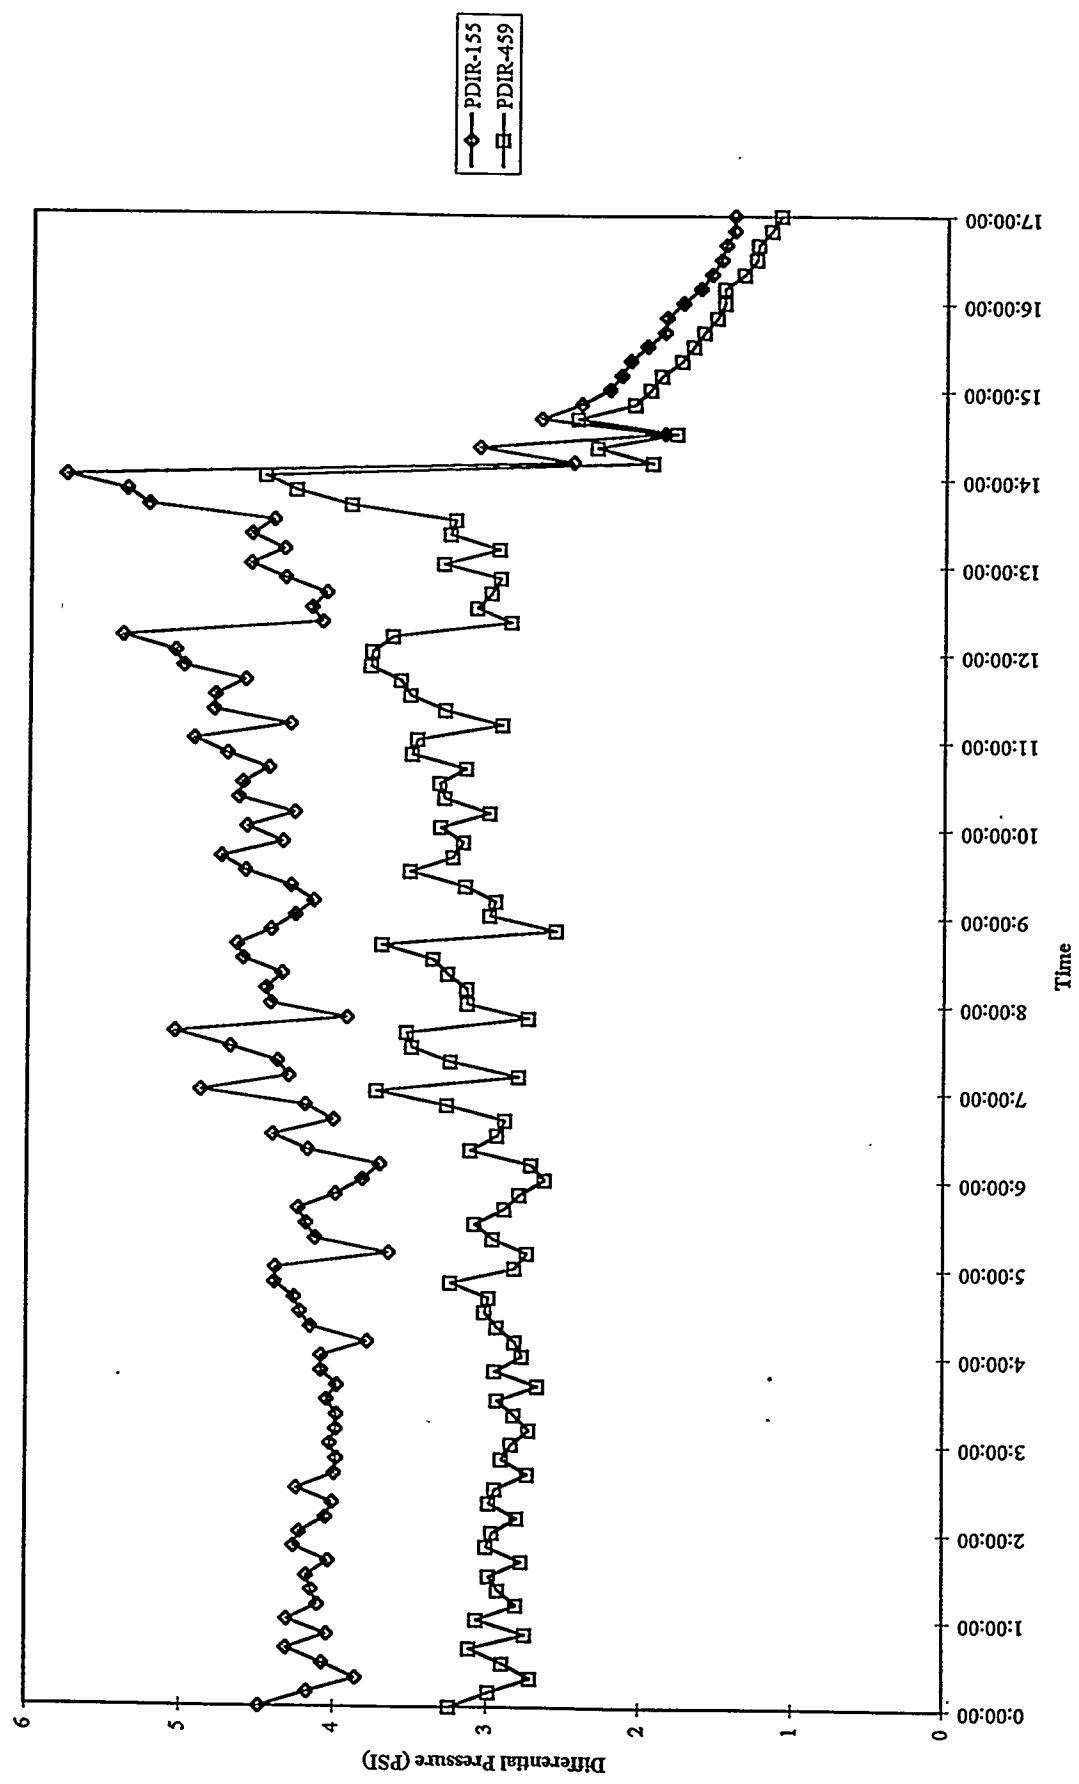


**94MGC10
(10/24/94 - 10/28/94)**




FBG EXIT FLOWS
RUN 94FBG10, 10/24/94

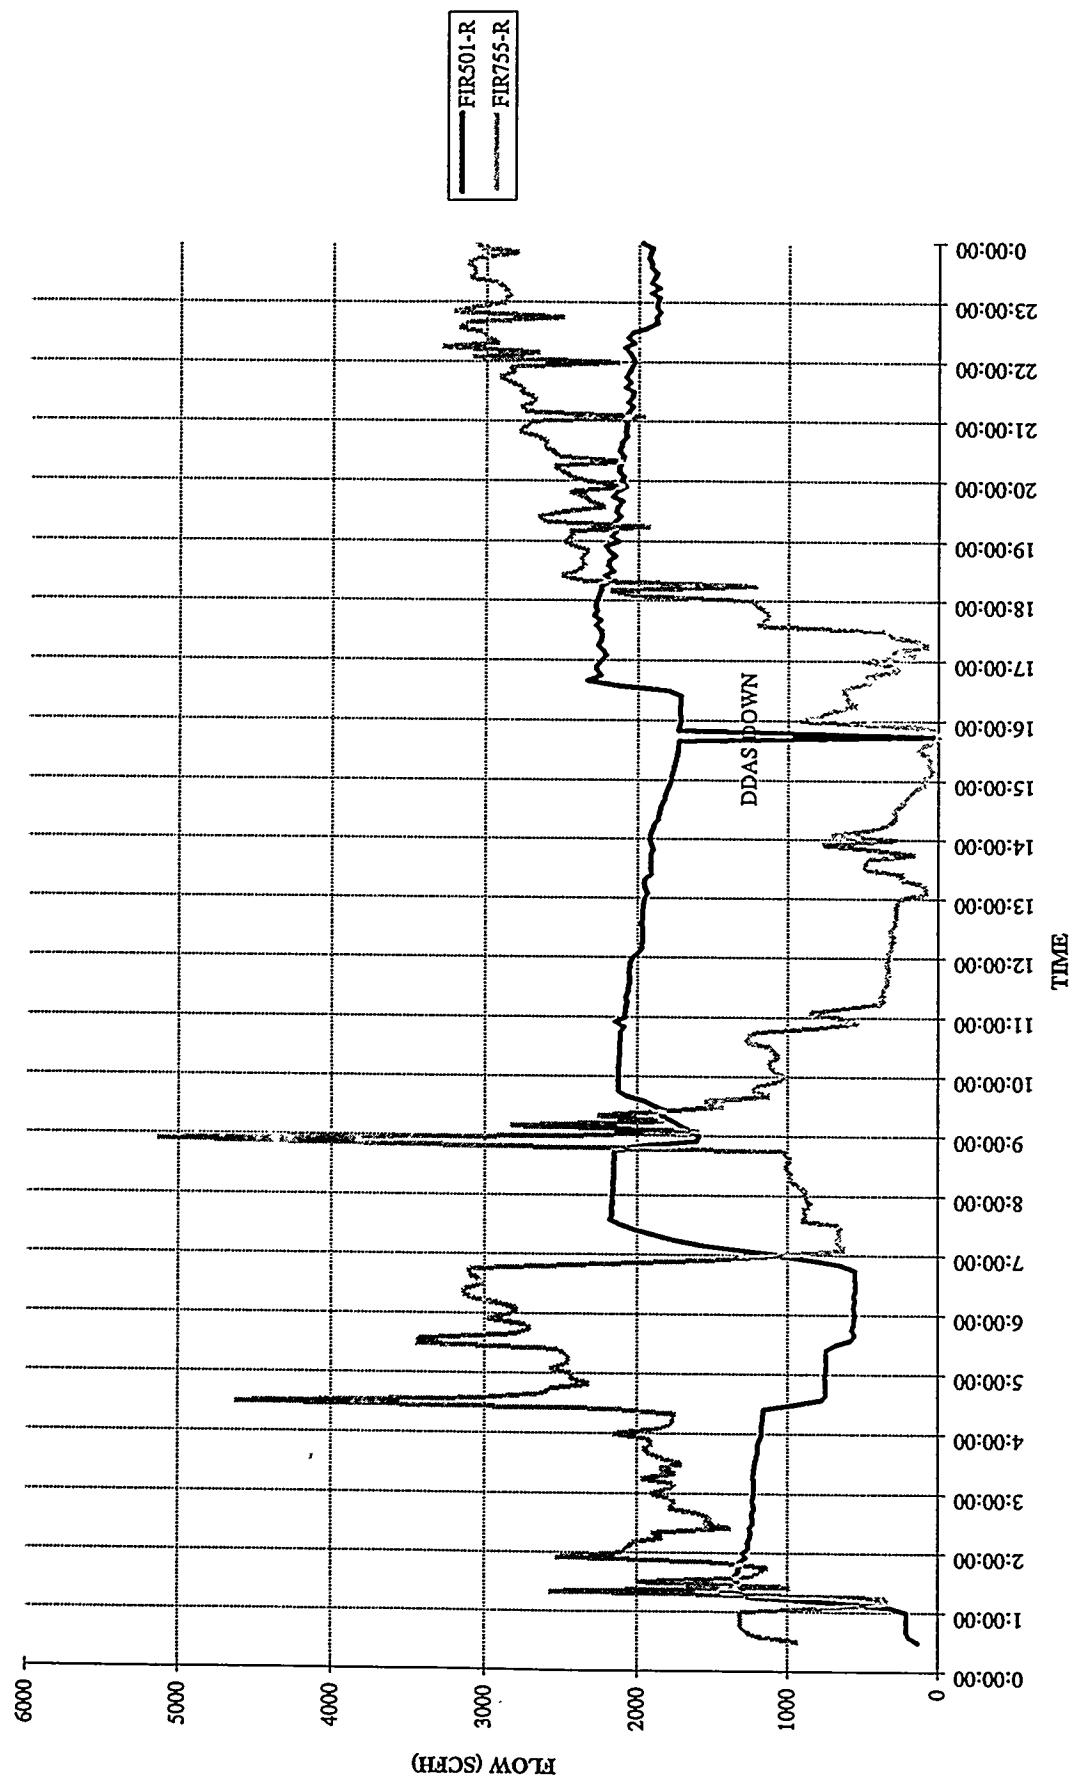


FBG EXIT FLOWS
RUN 94FBG10, 10/25/94

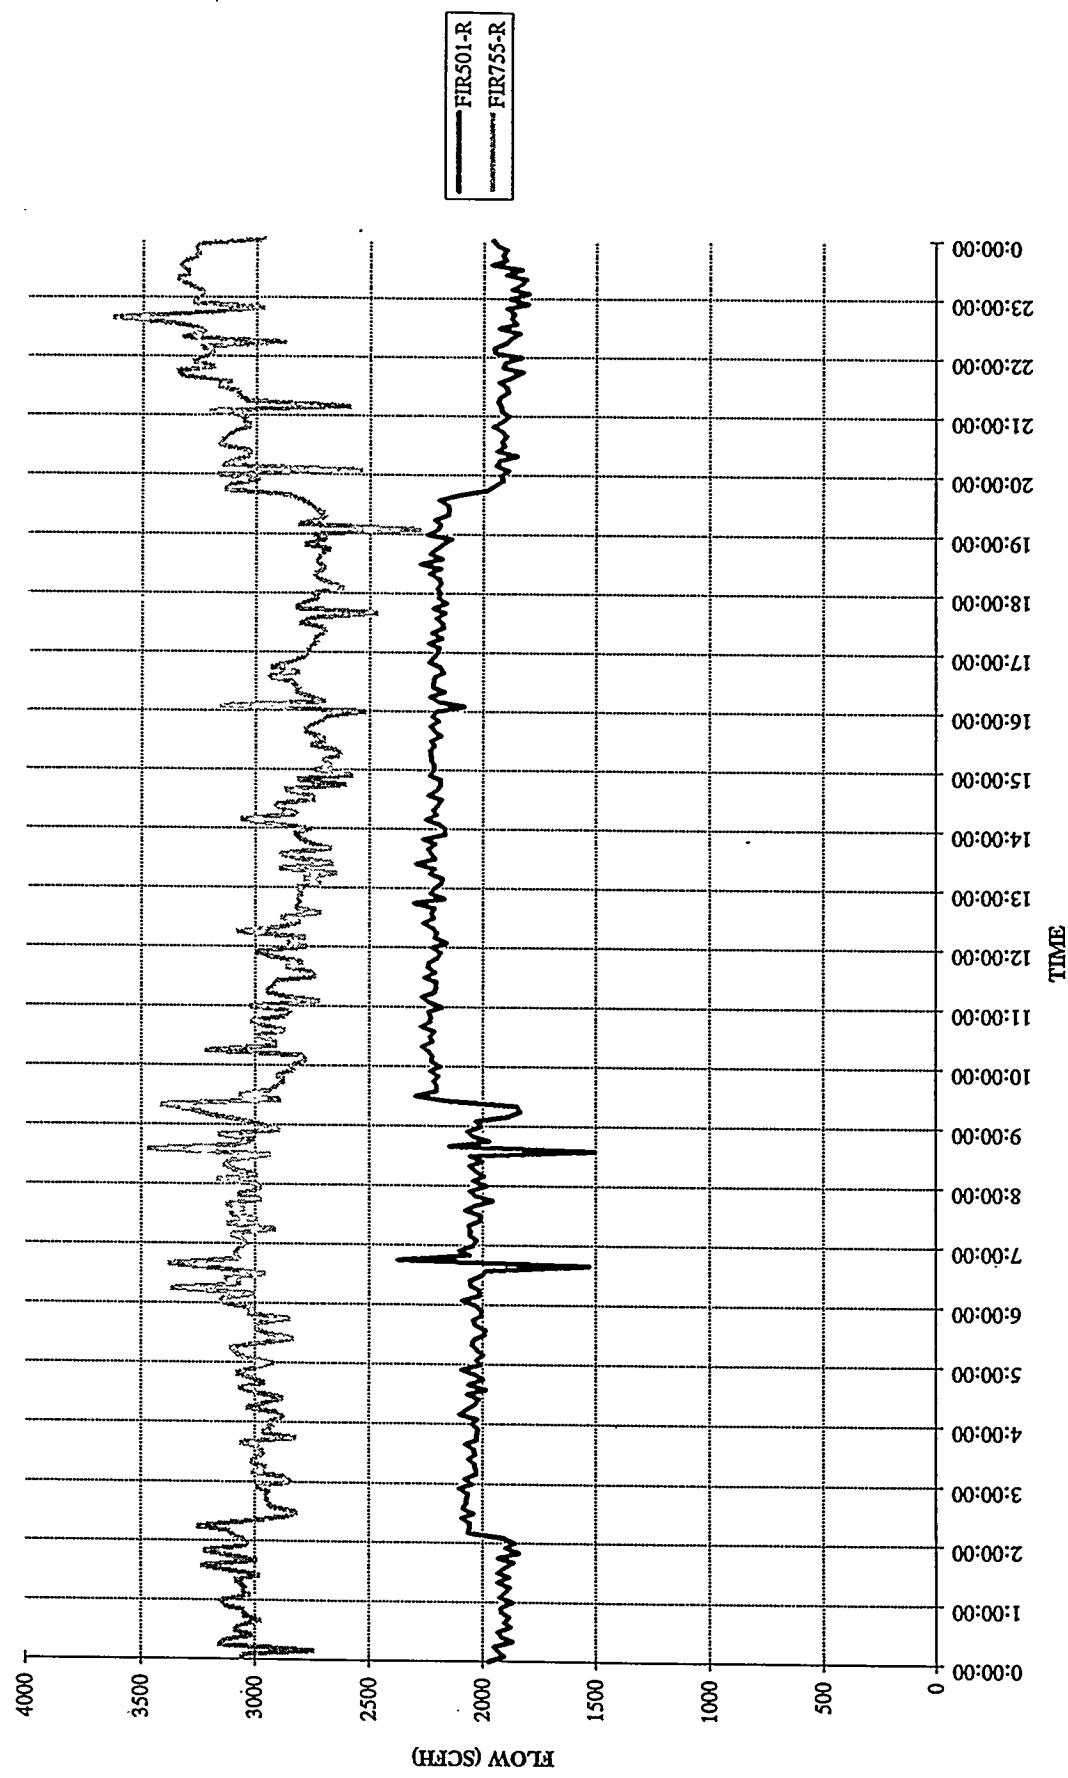


FBG EXIT FLOWS
RUN 94FBG10, 10/26/94

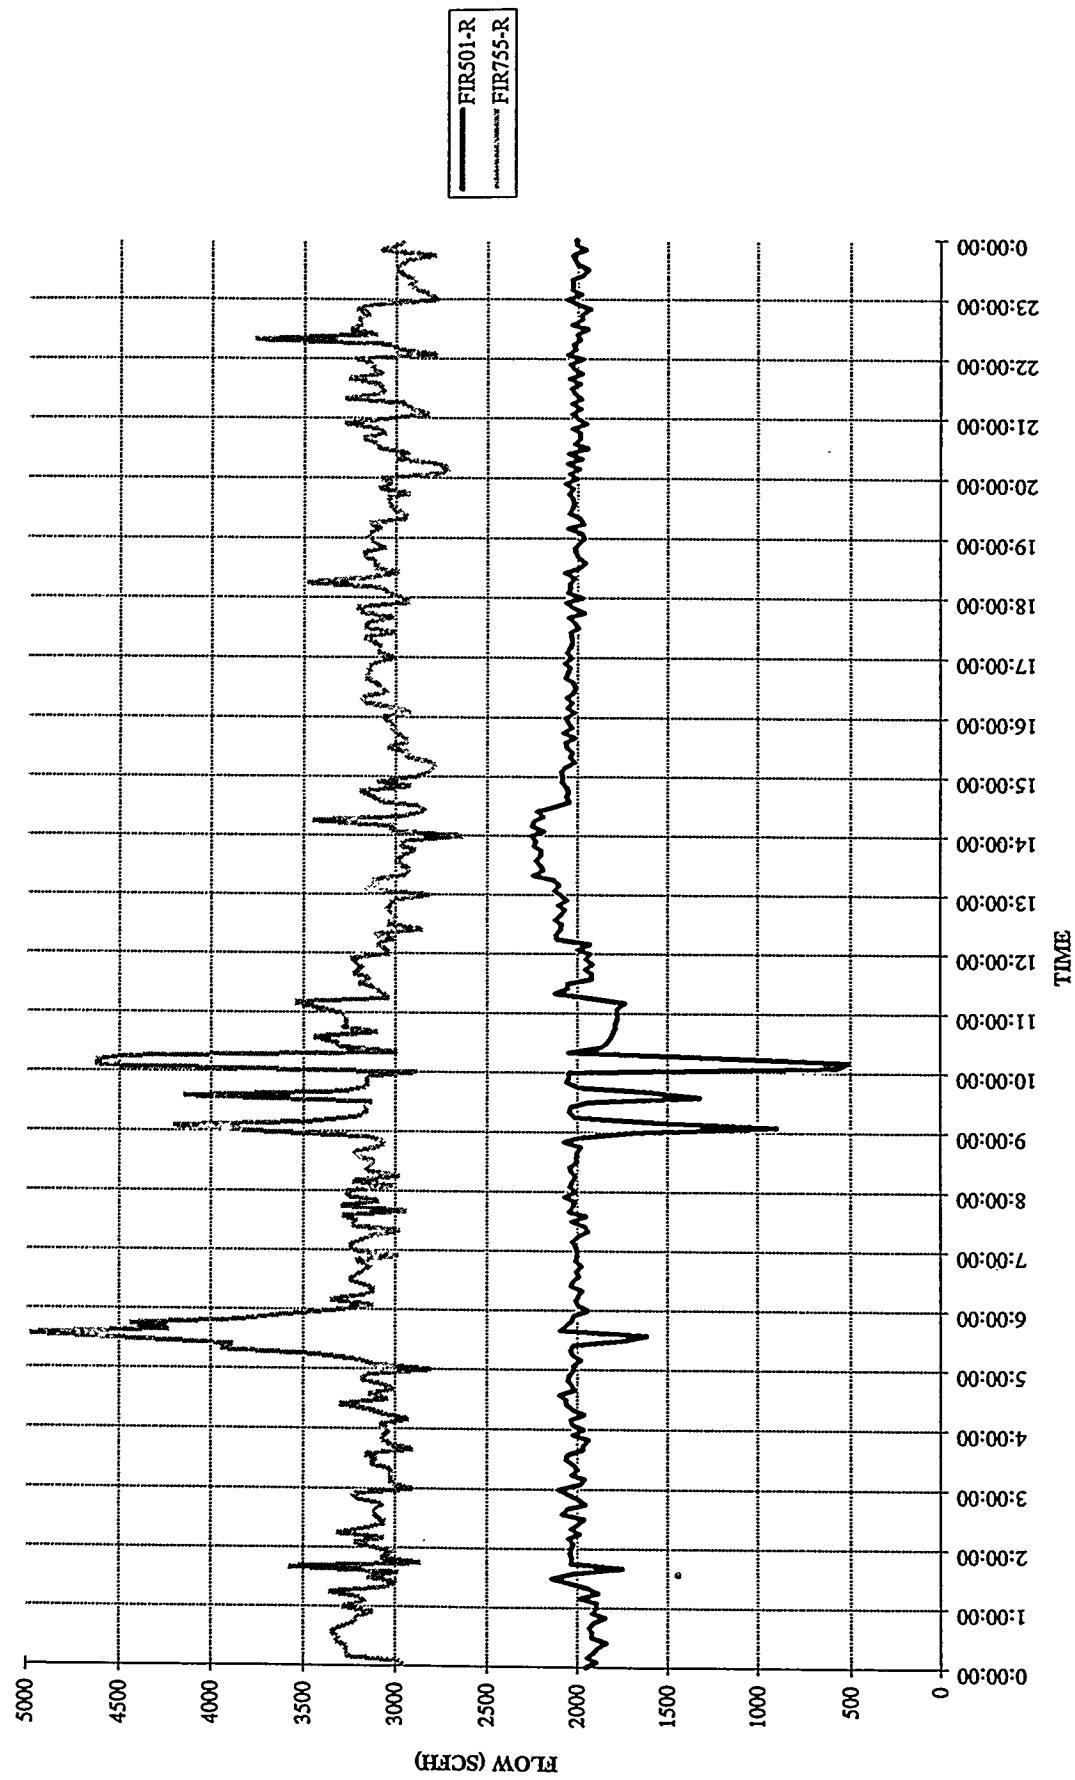


FBG EXIT FLOWS
RUN 94FBG10, 10/27/94

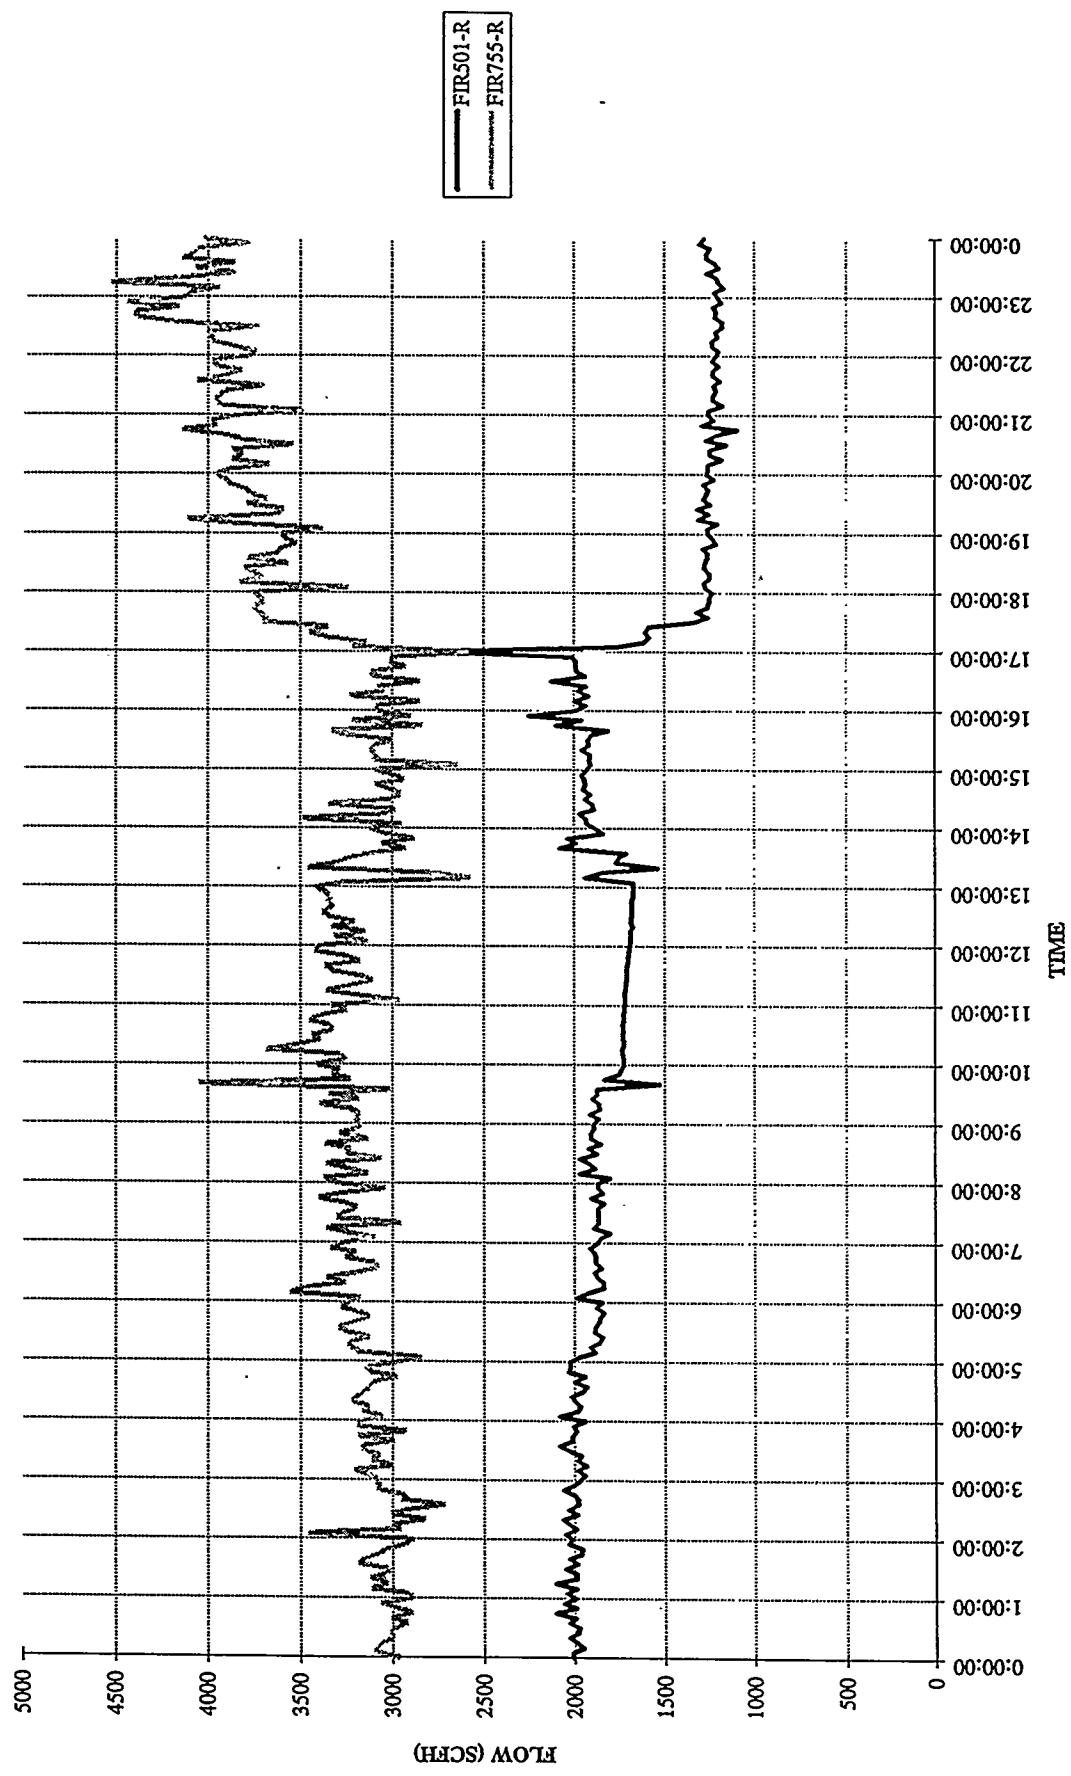


FBG EXIT FLOWS
RUN 94FBG10, 10/28/94

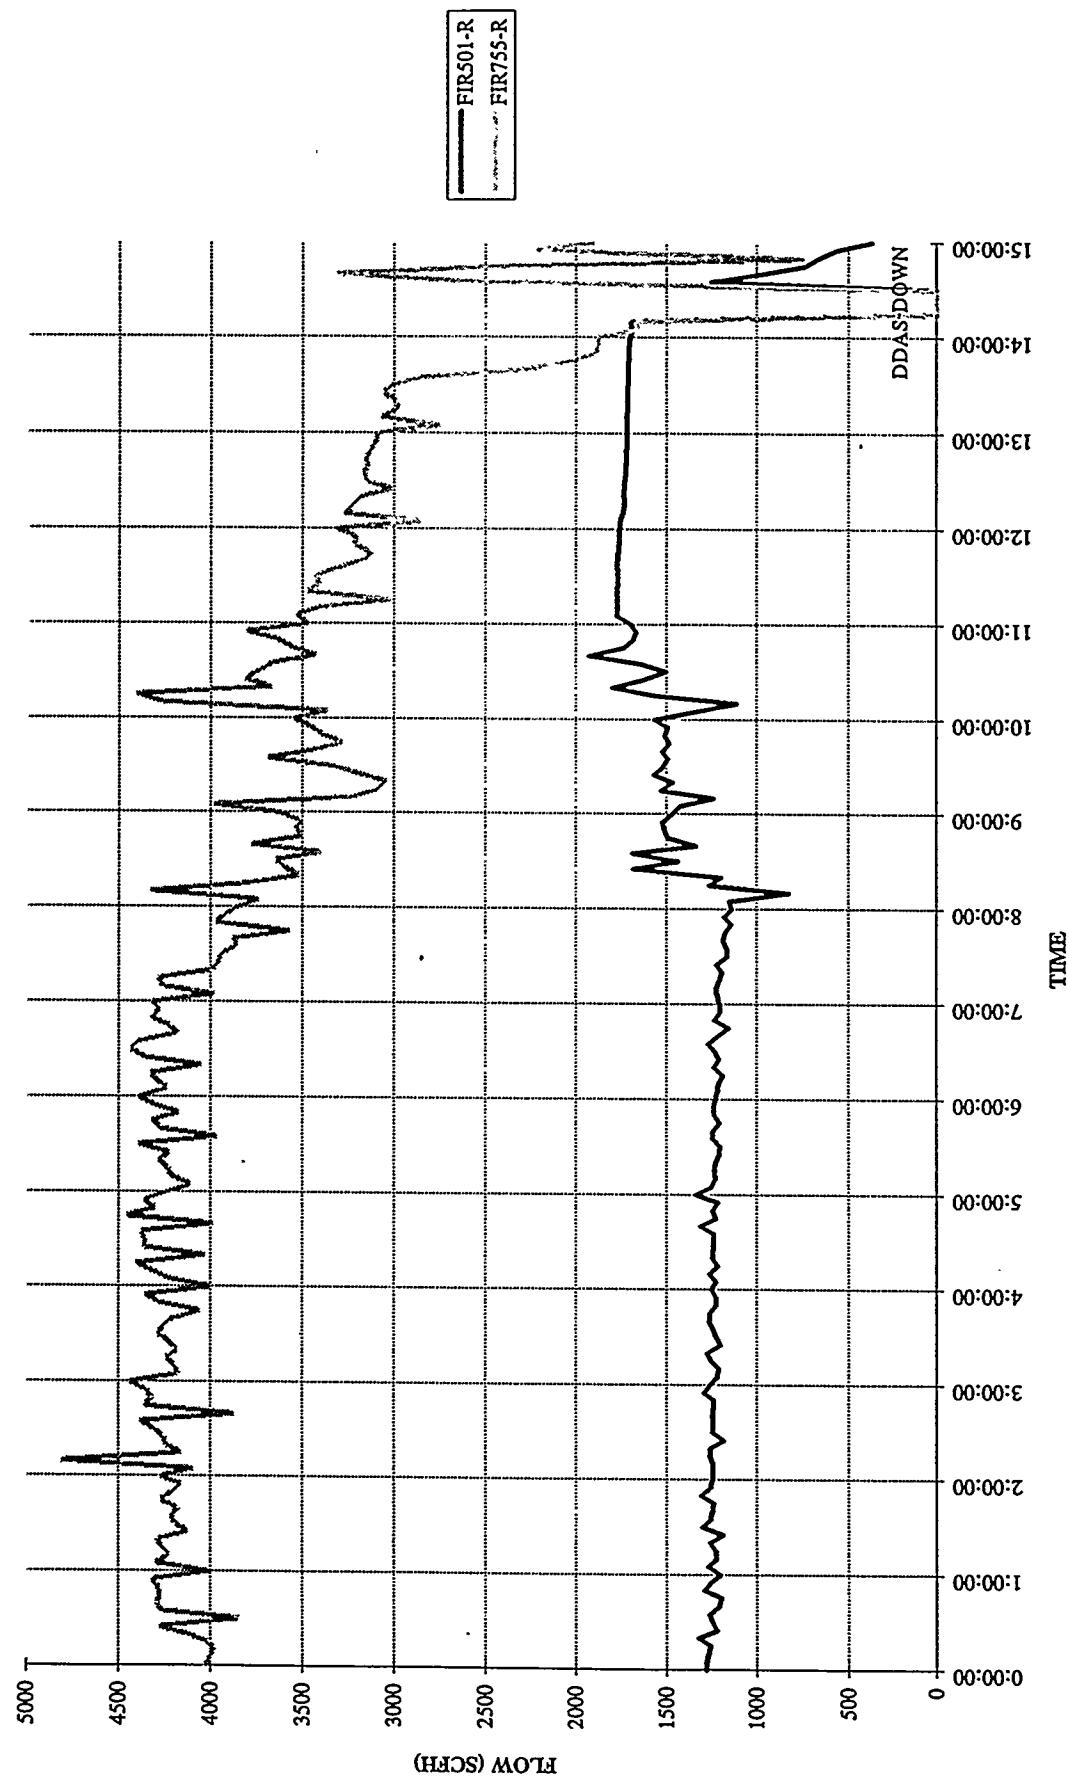


MGCR Process Gas Line Temperatures
Run 94MGC10, 10/24/94

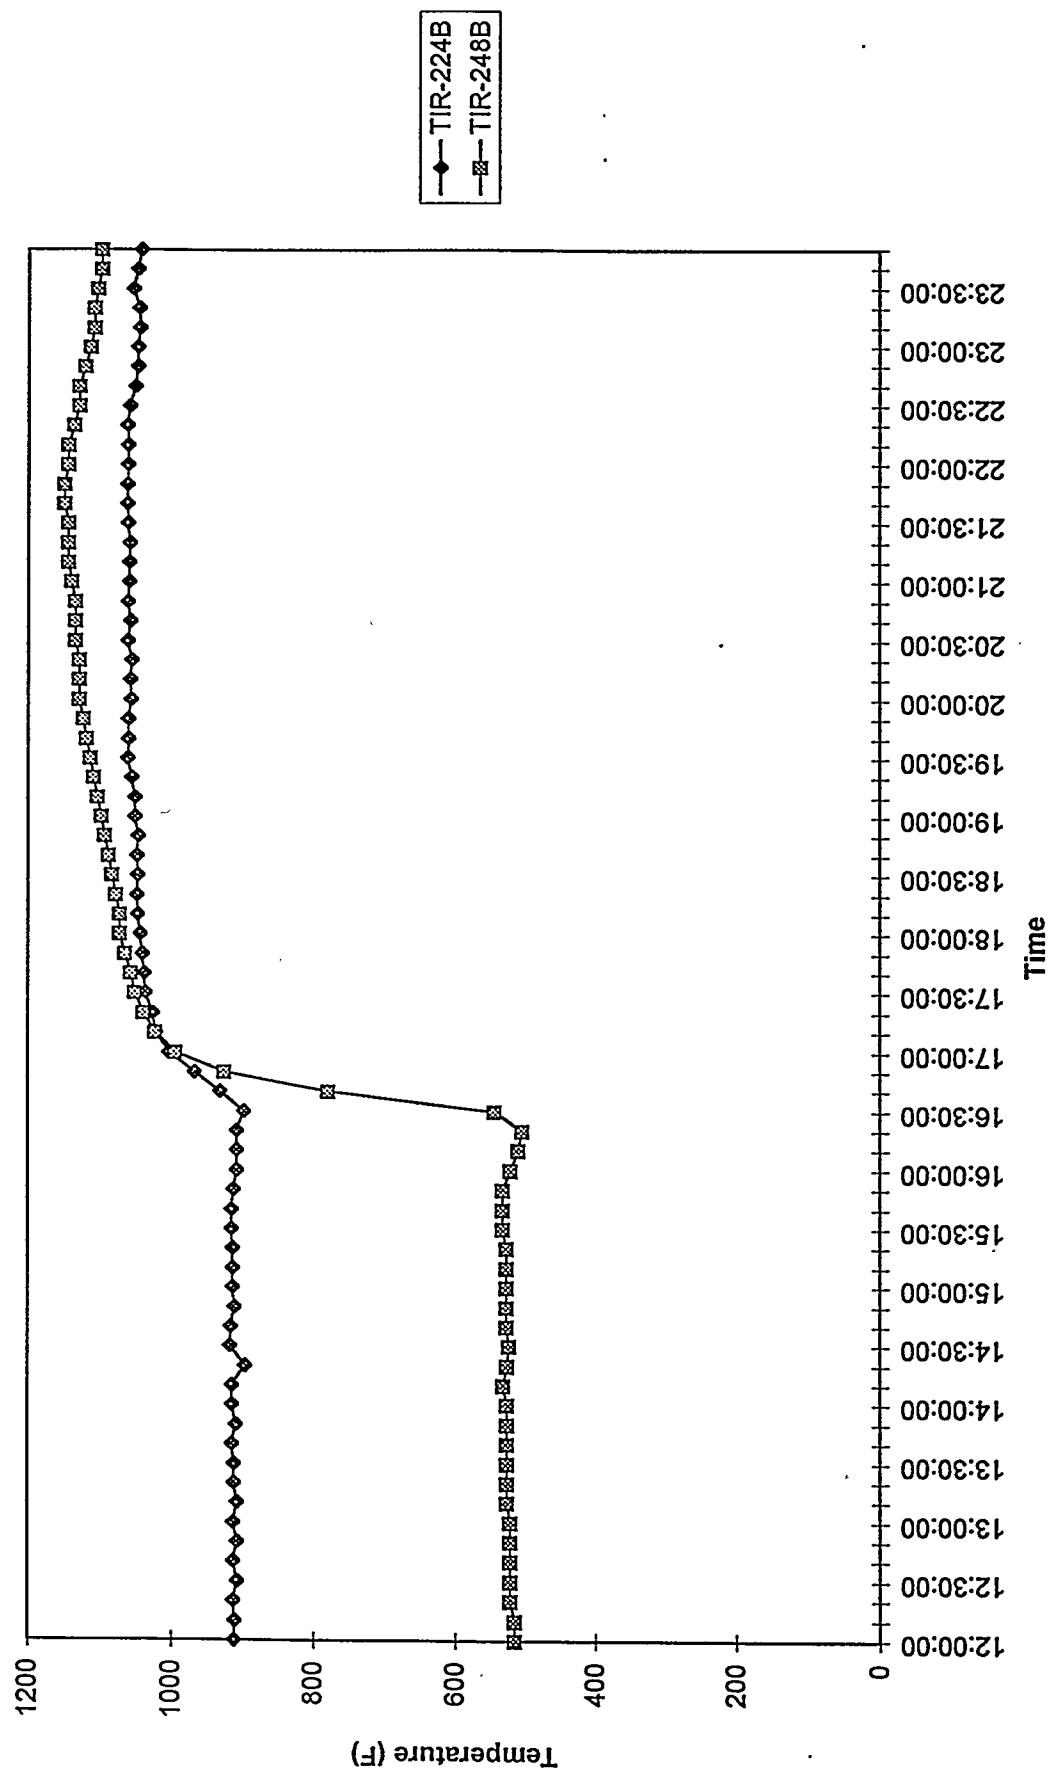

MGCR Process Gas Line Temperatures
Run 94MGCT0, 10/25/94

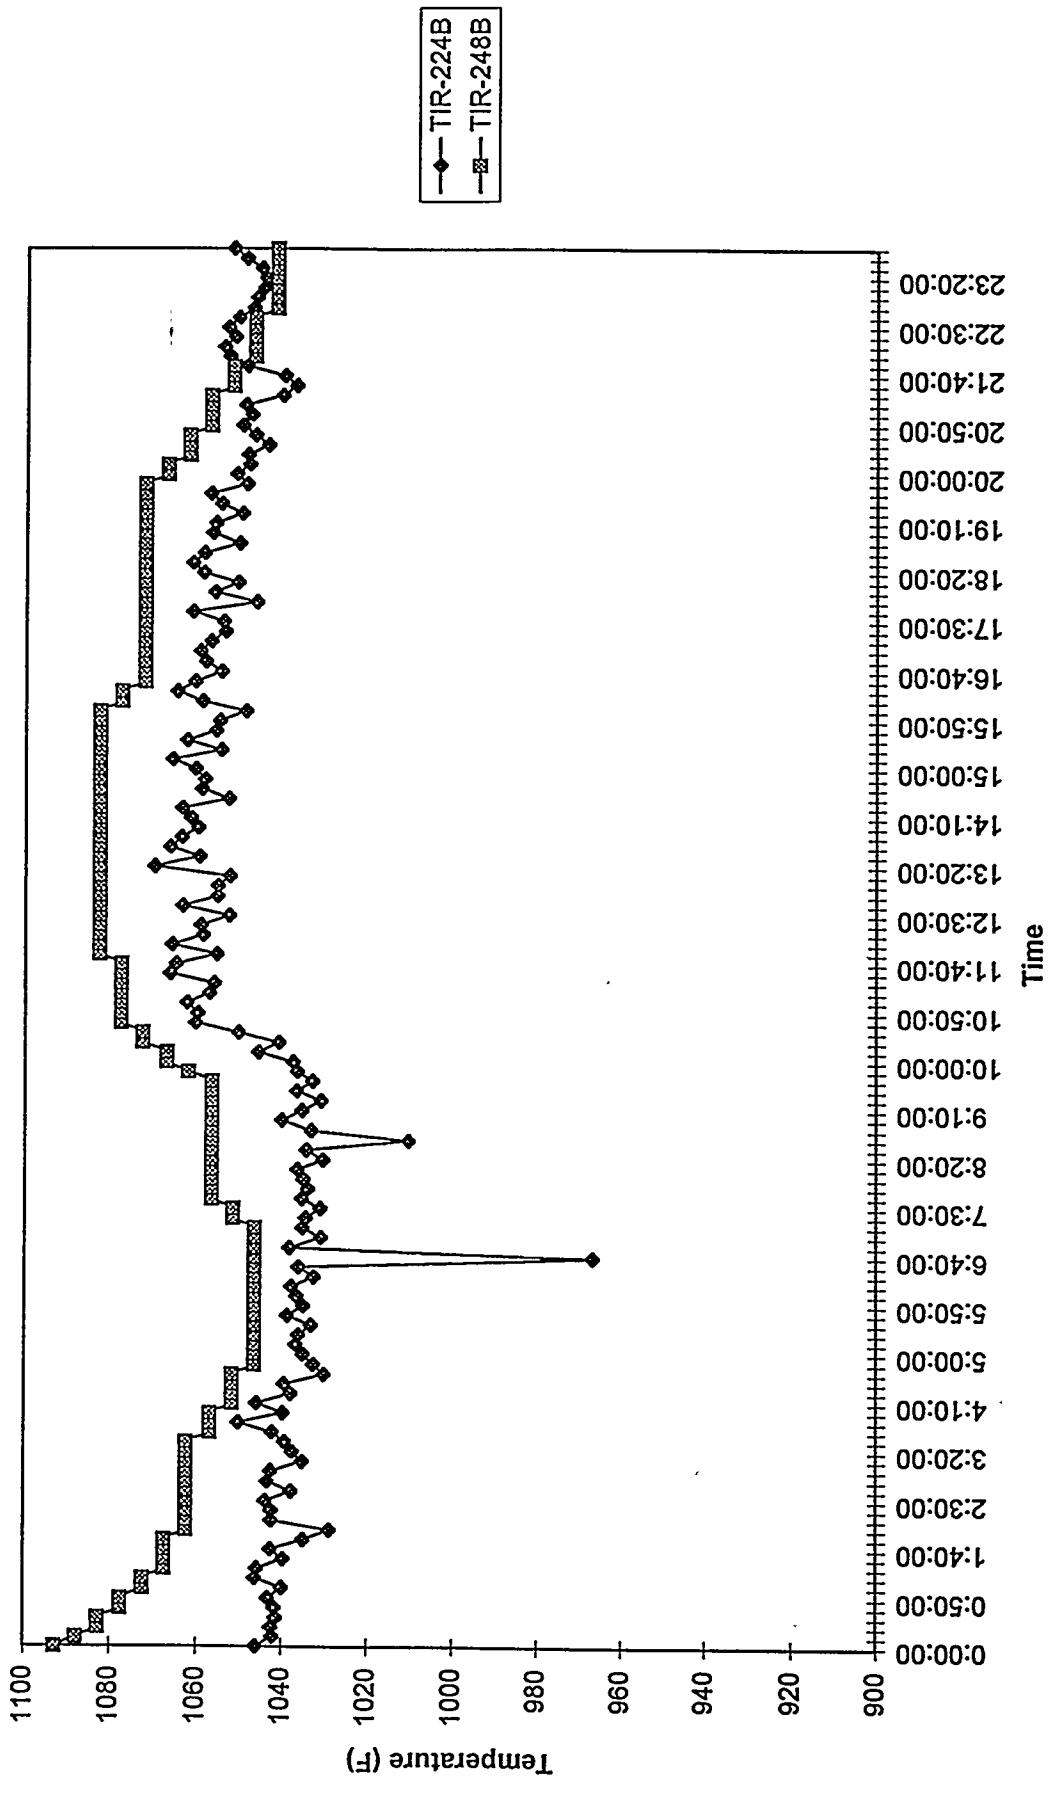


MGCR Process Gas Line Temperatures
Run 94 MGCR10, 10/26/94

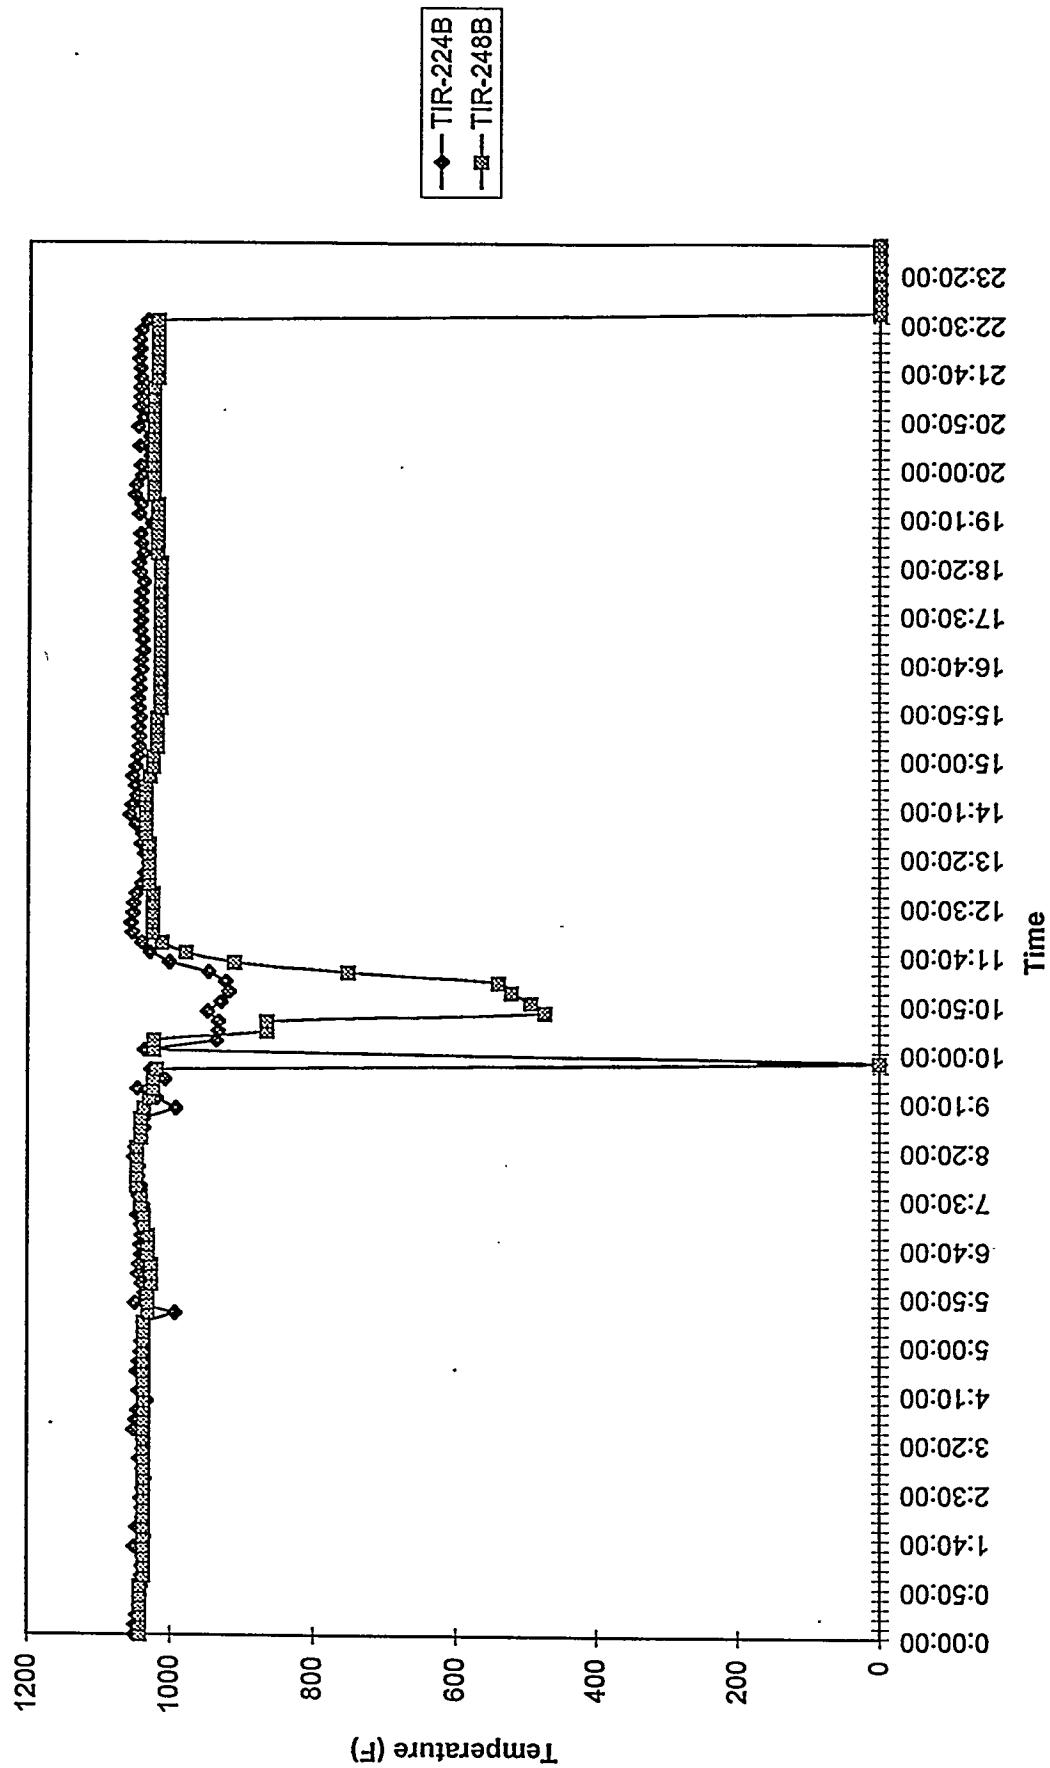


A3-113

MGCR Process Gas Line Temperatures
Run 94MGCI0, 10/27/94

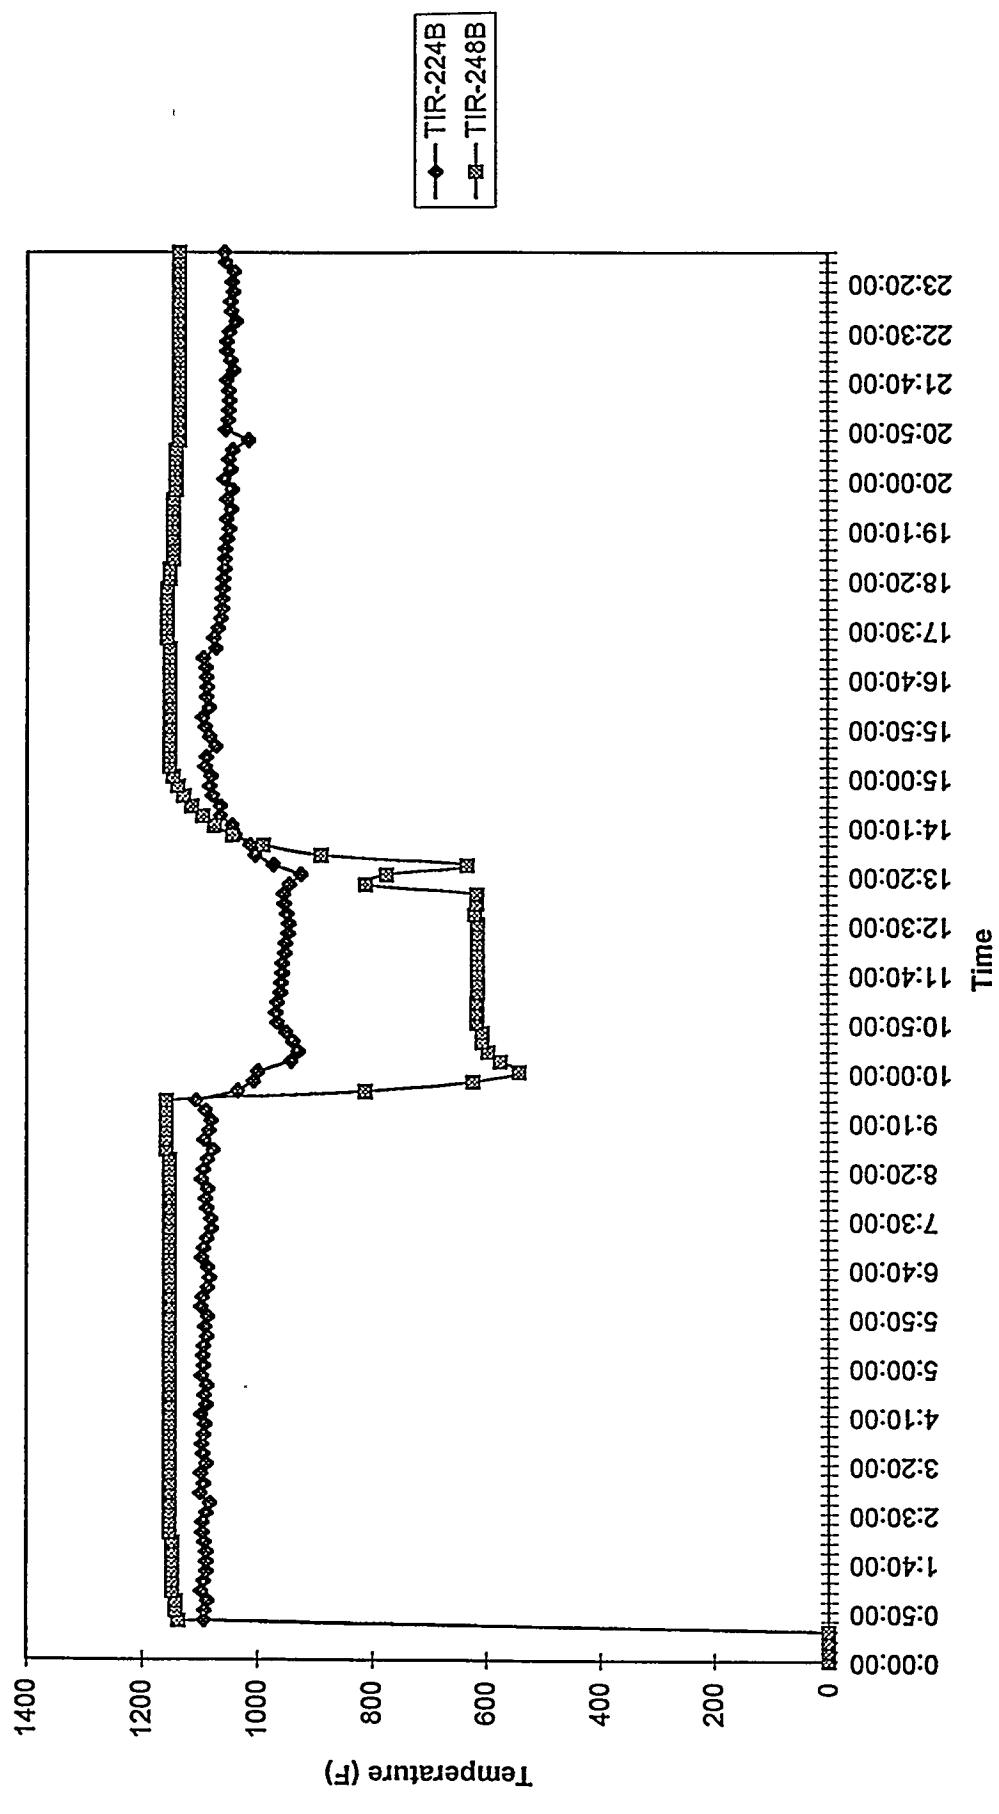


A3-114

MGCR Process Gas Line Temperatures
Run 94MGC10, 10/28/94

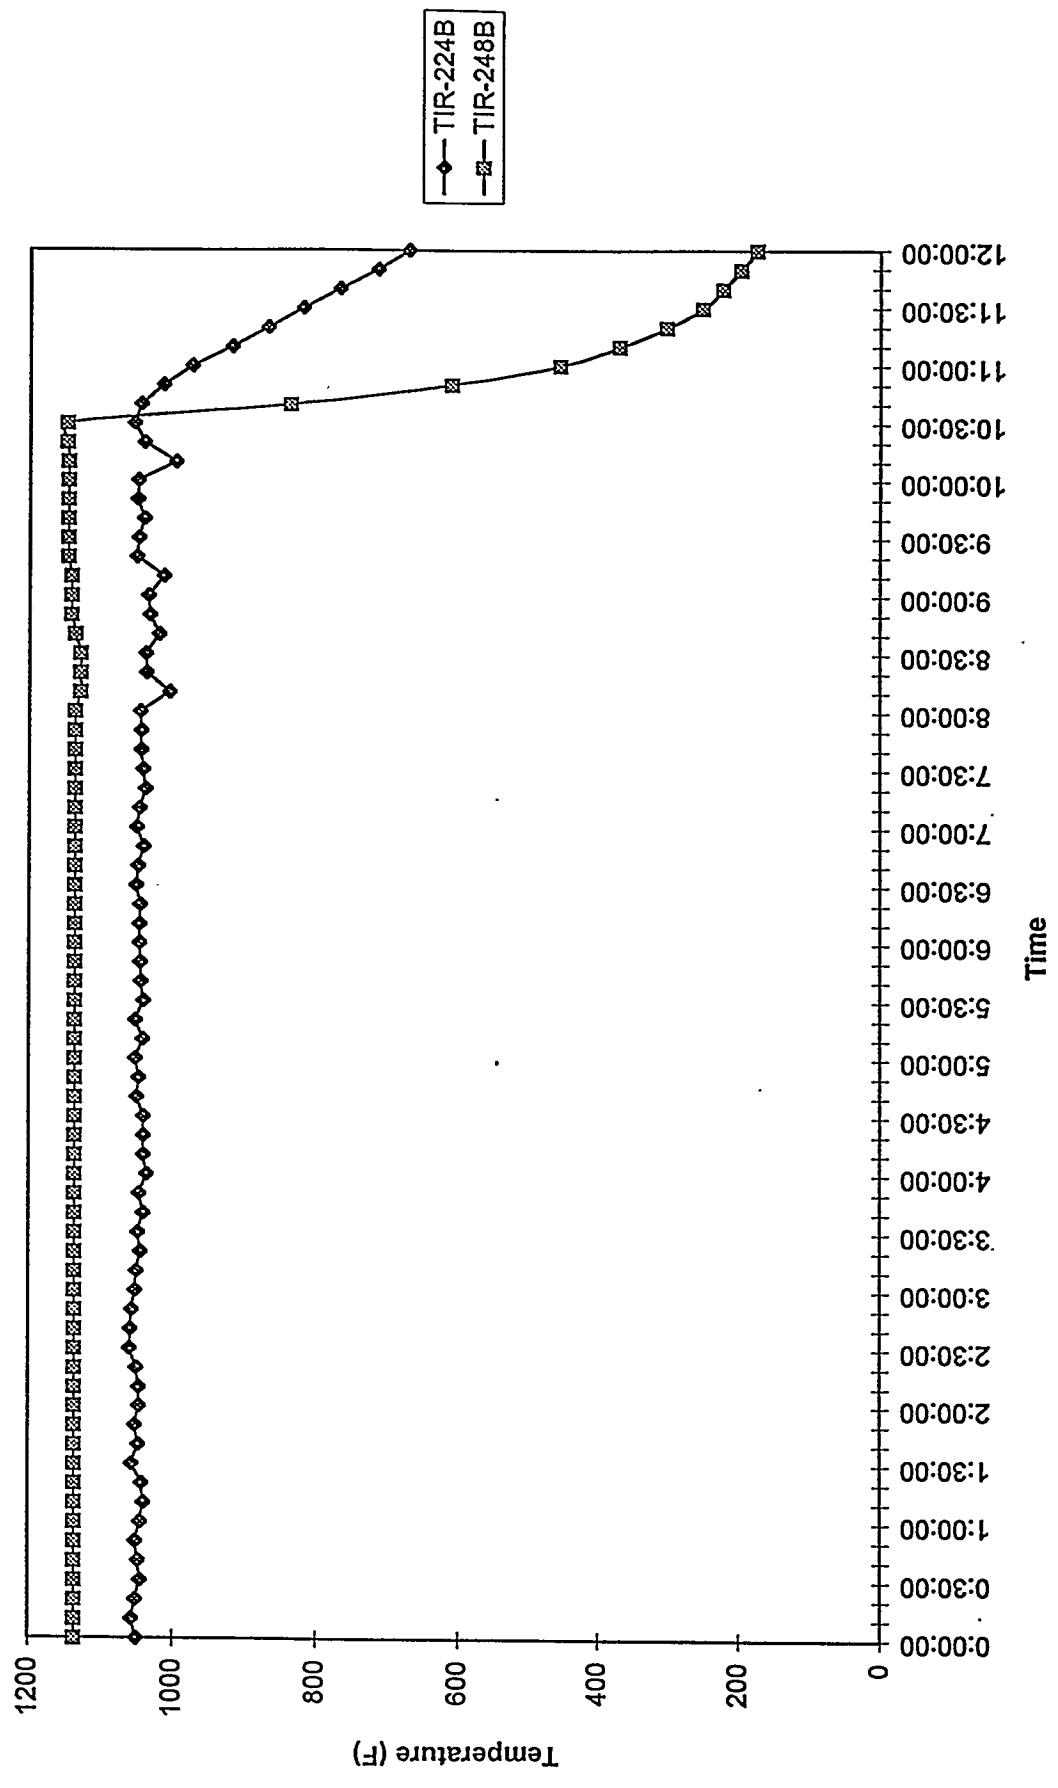


A3-115

FBG & MGCR Process Pressures
Run 94MGC10, 10/24/94

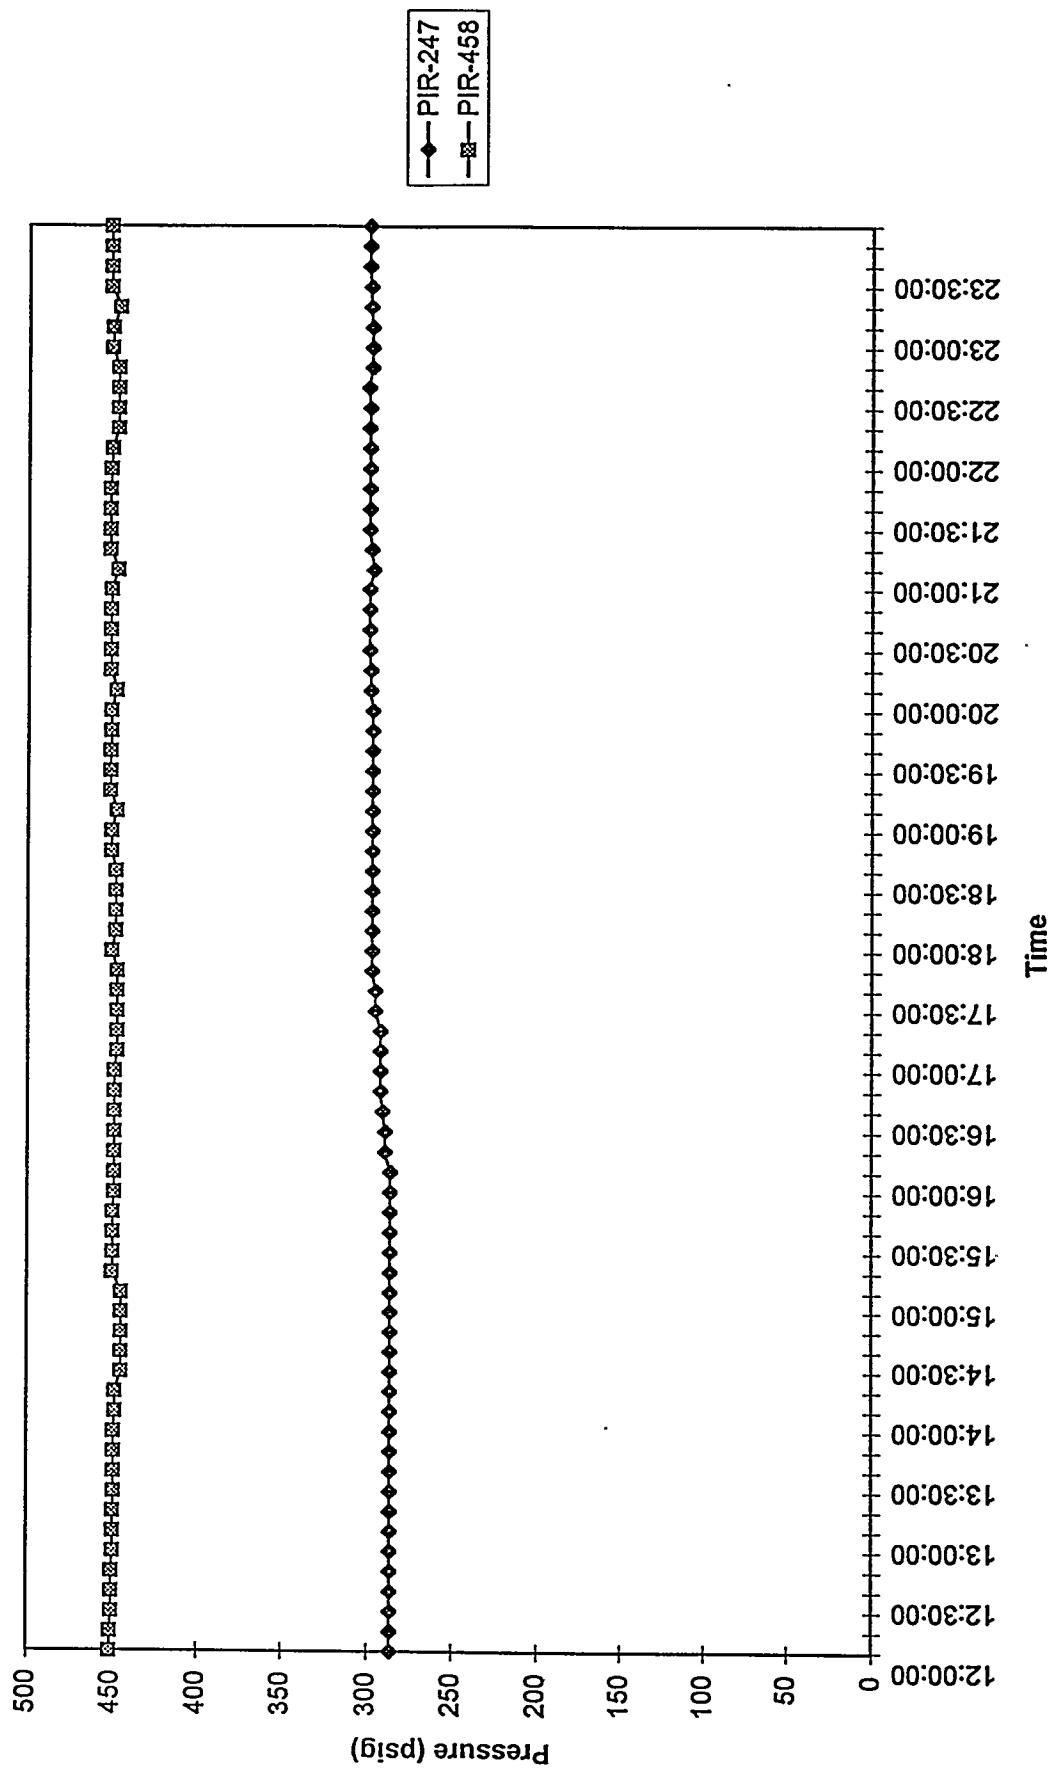


A3-116


FBG & MGCR Process Pressures
Run 94MGC10, 10/25/94

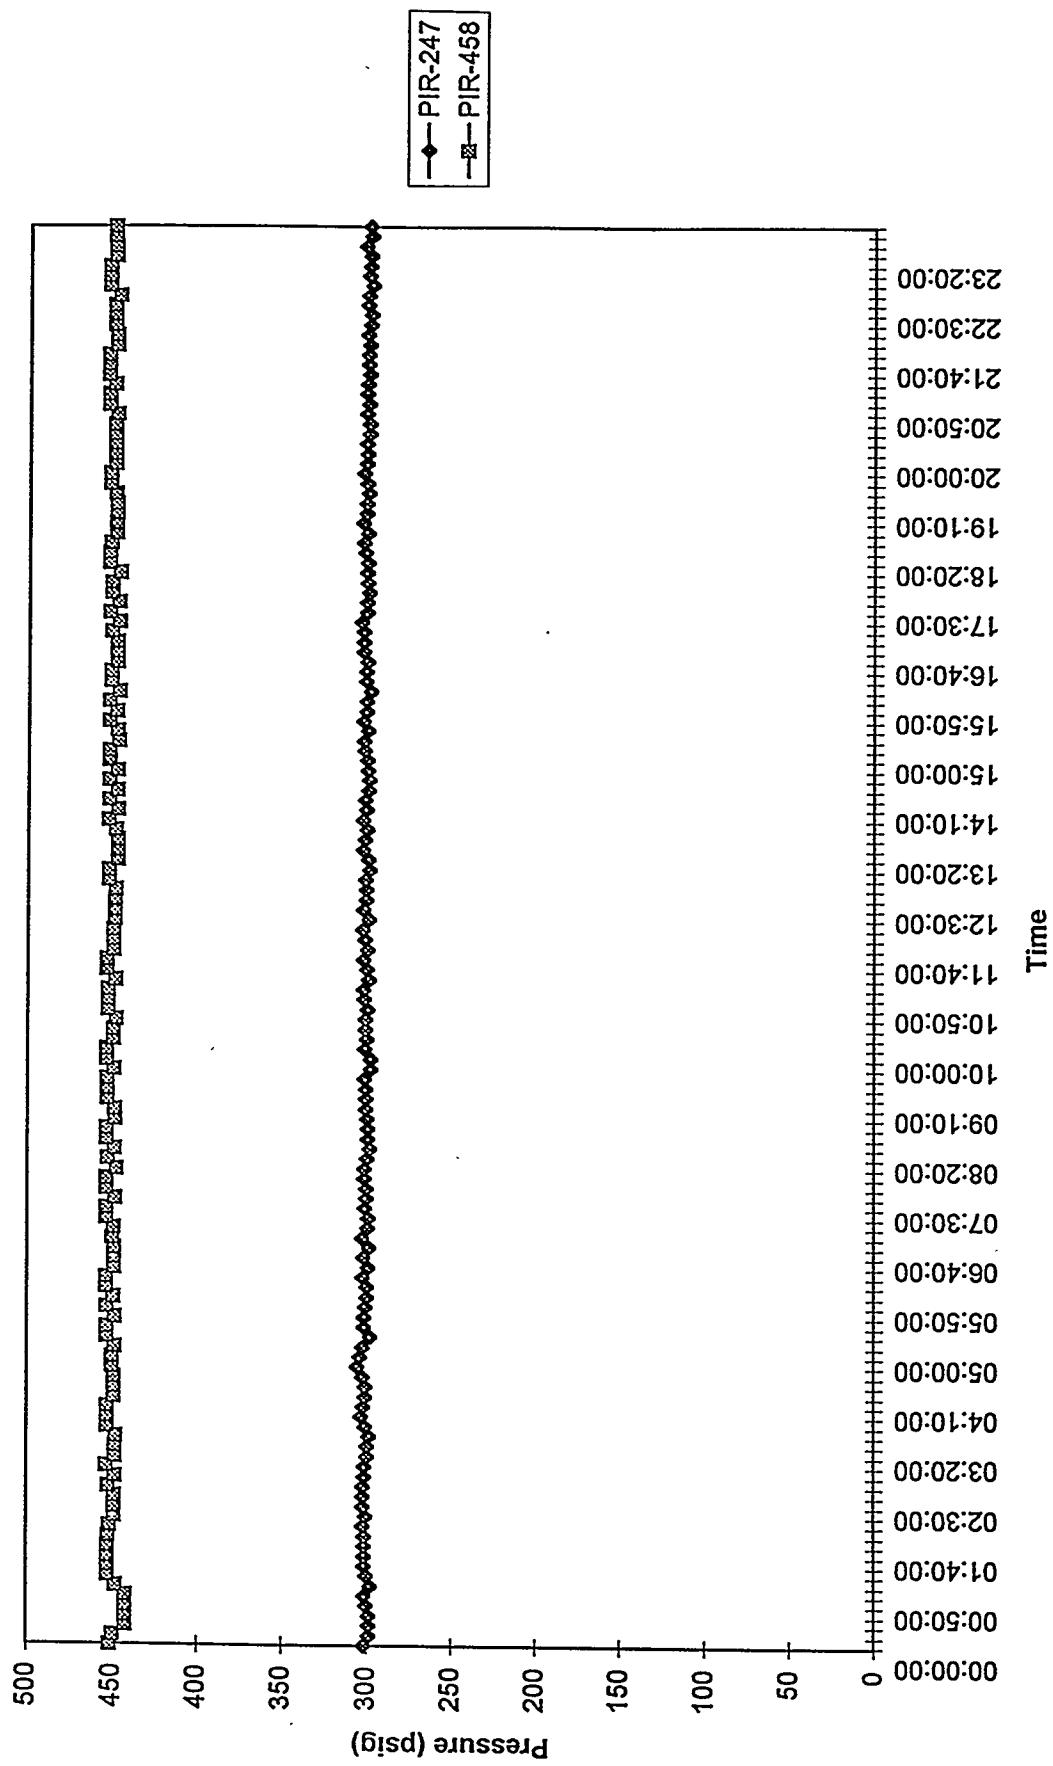


FBG & MGCR Process Pressures
Run 94MGCR10, 10/26/94

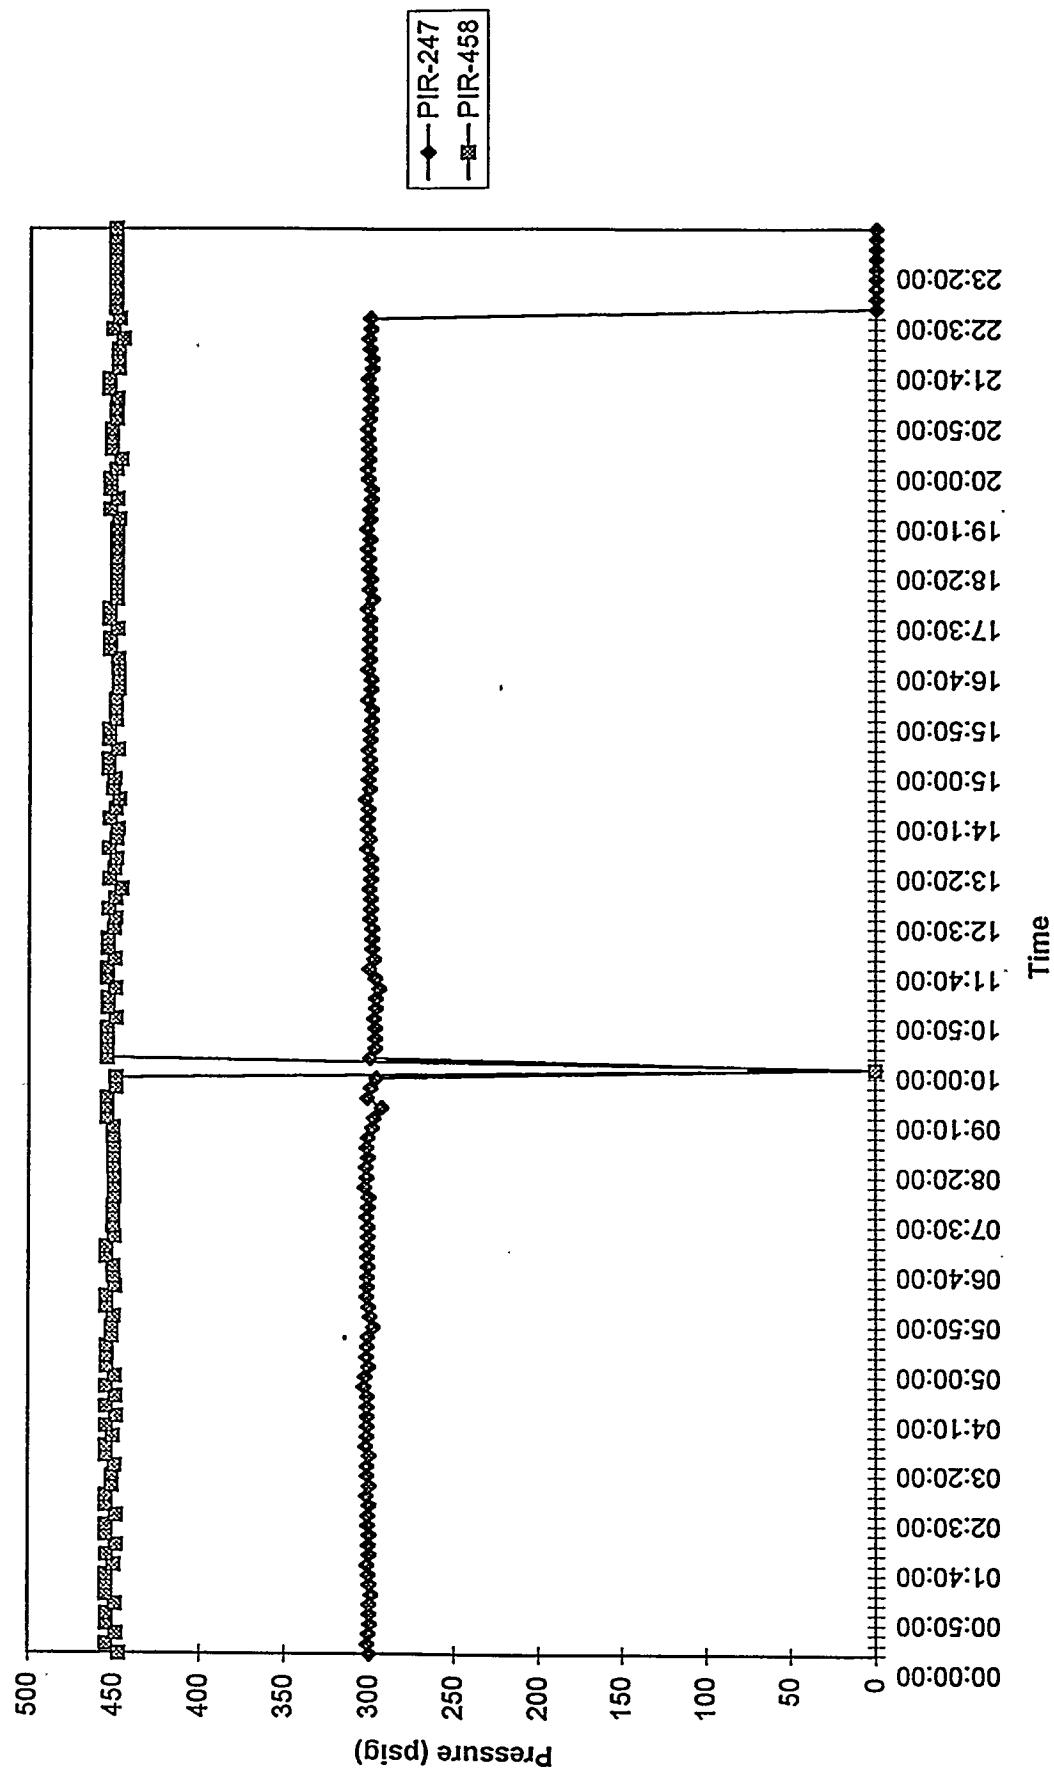

FBG & MGCR Process Pressures
Run 94MGC10, 10/27/94

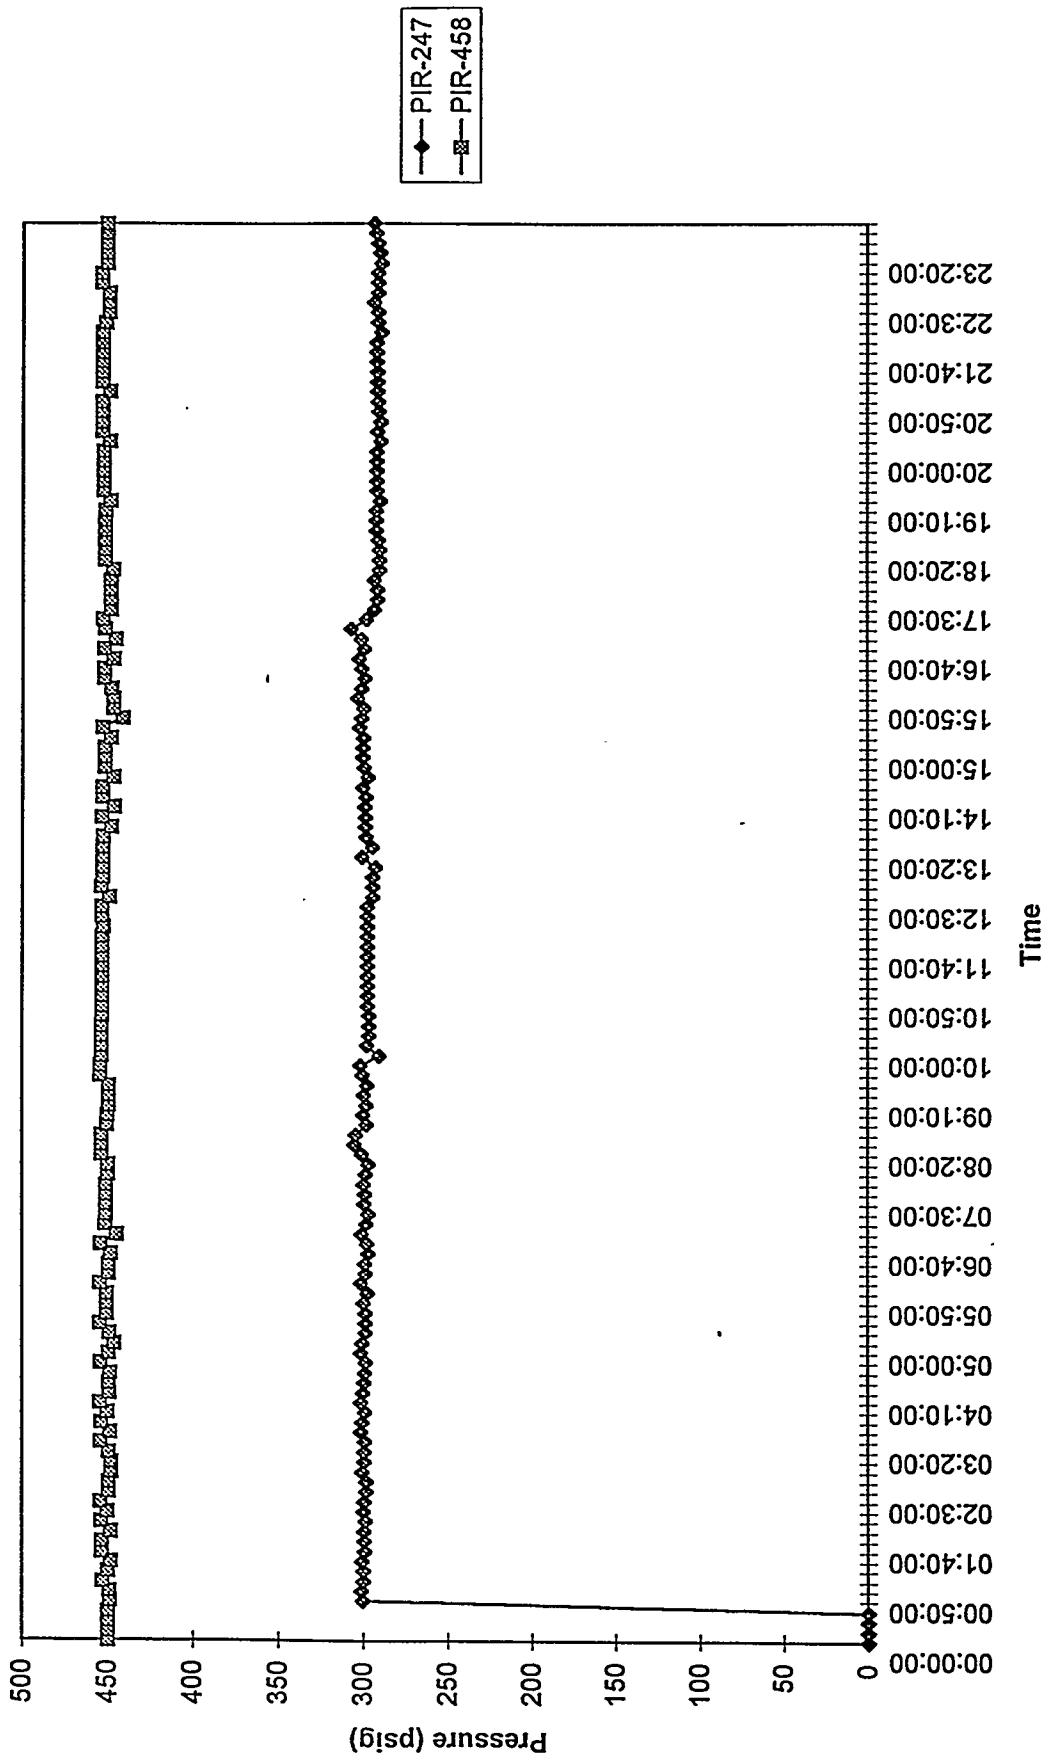


FBG & MGCR Process Pressures
Run 94/MGC10, 10/28/94

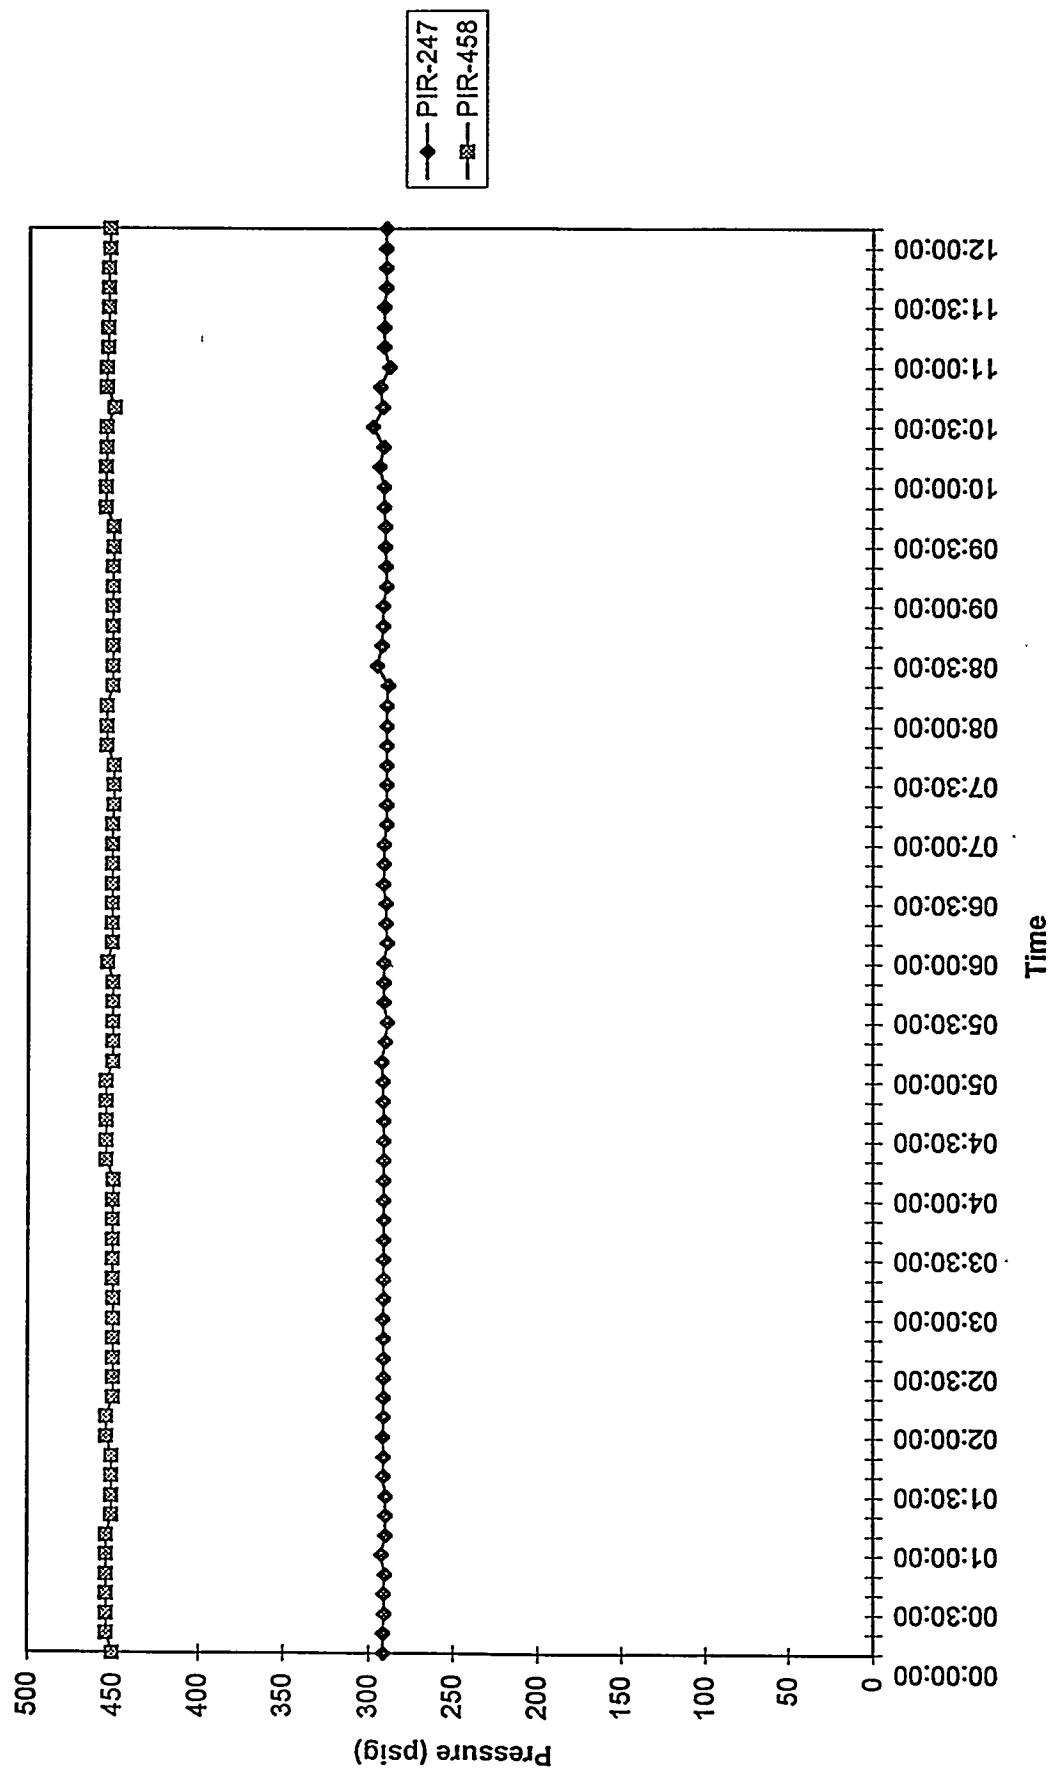


A3-120

F-100 Differential Pressure
Run 94MGC10, 10/24/94

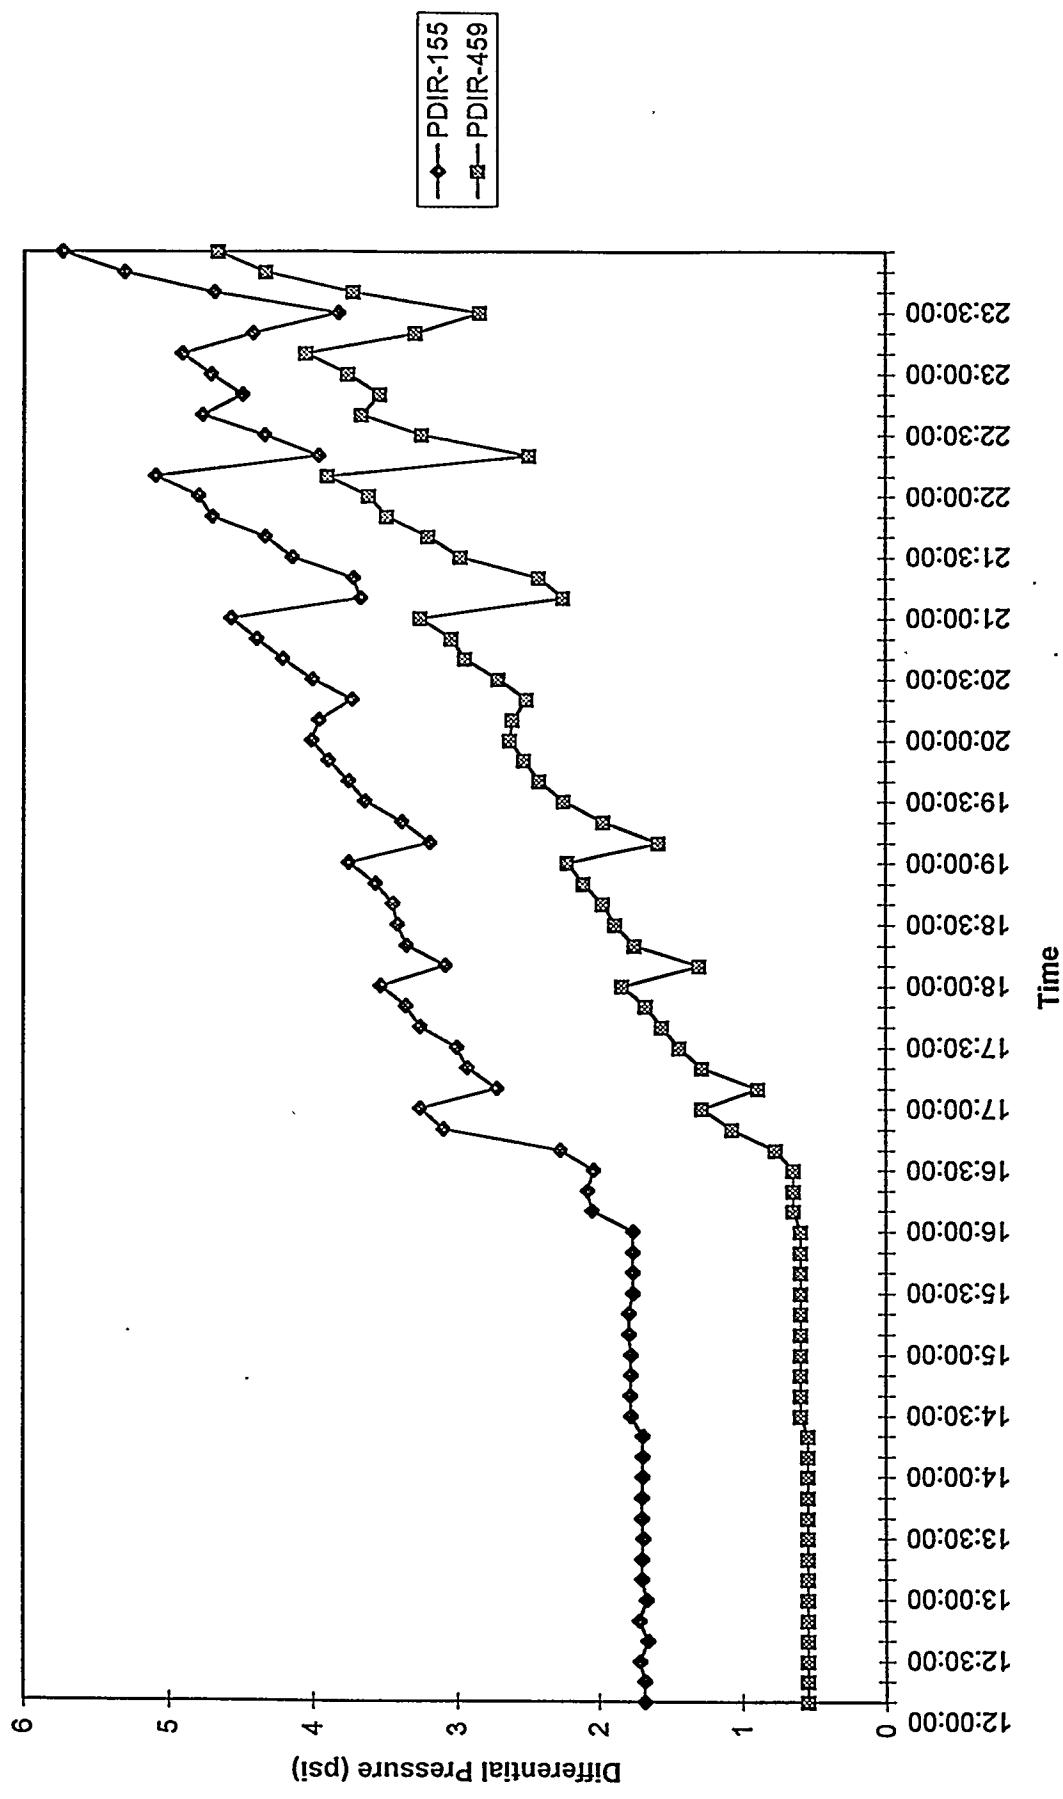


A3-121

F-100 Differential Pressure
Run 94MGC10, 10/25/94

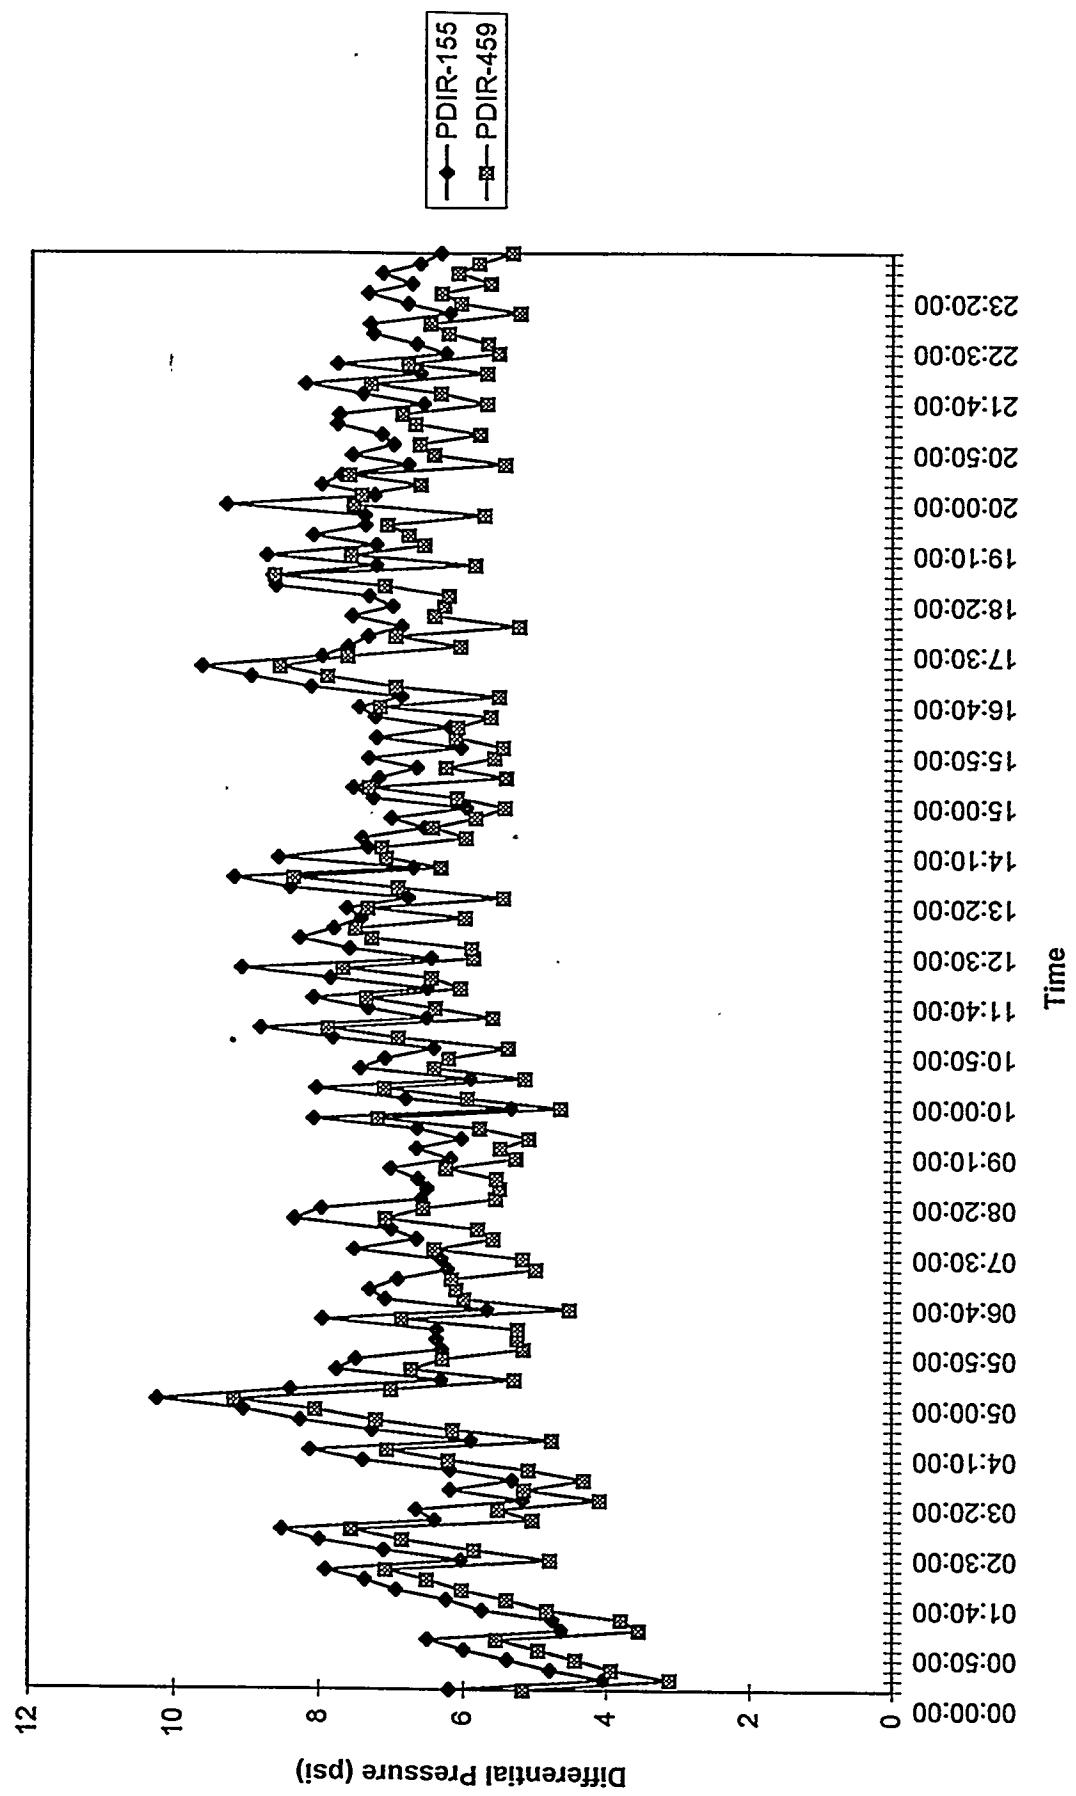


F-100 Differential Pressure
Run 94MGC10, 10/26/94

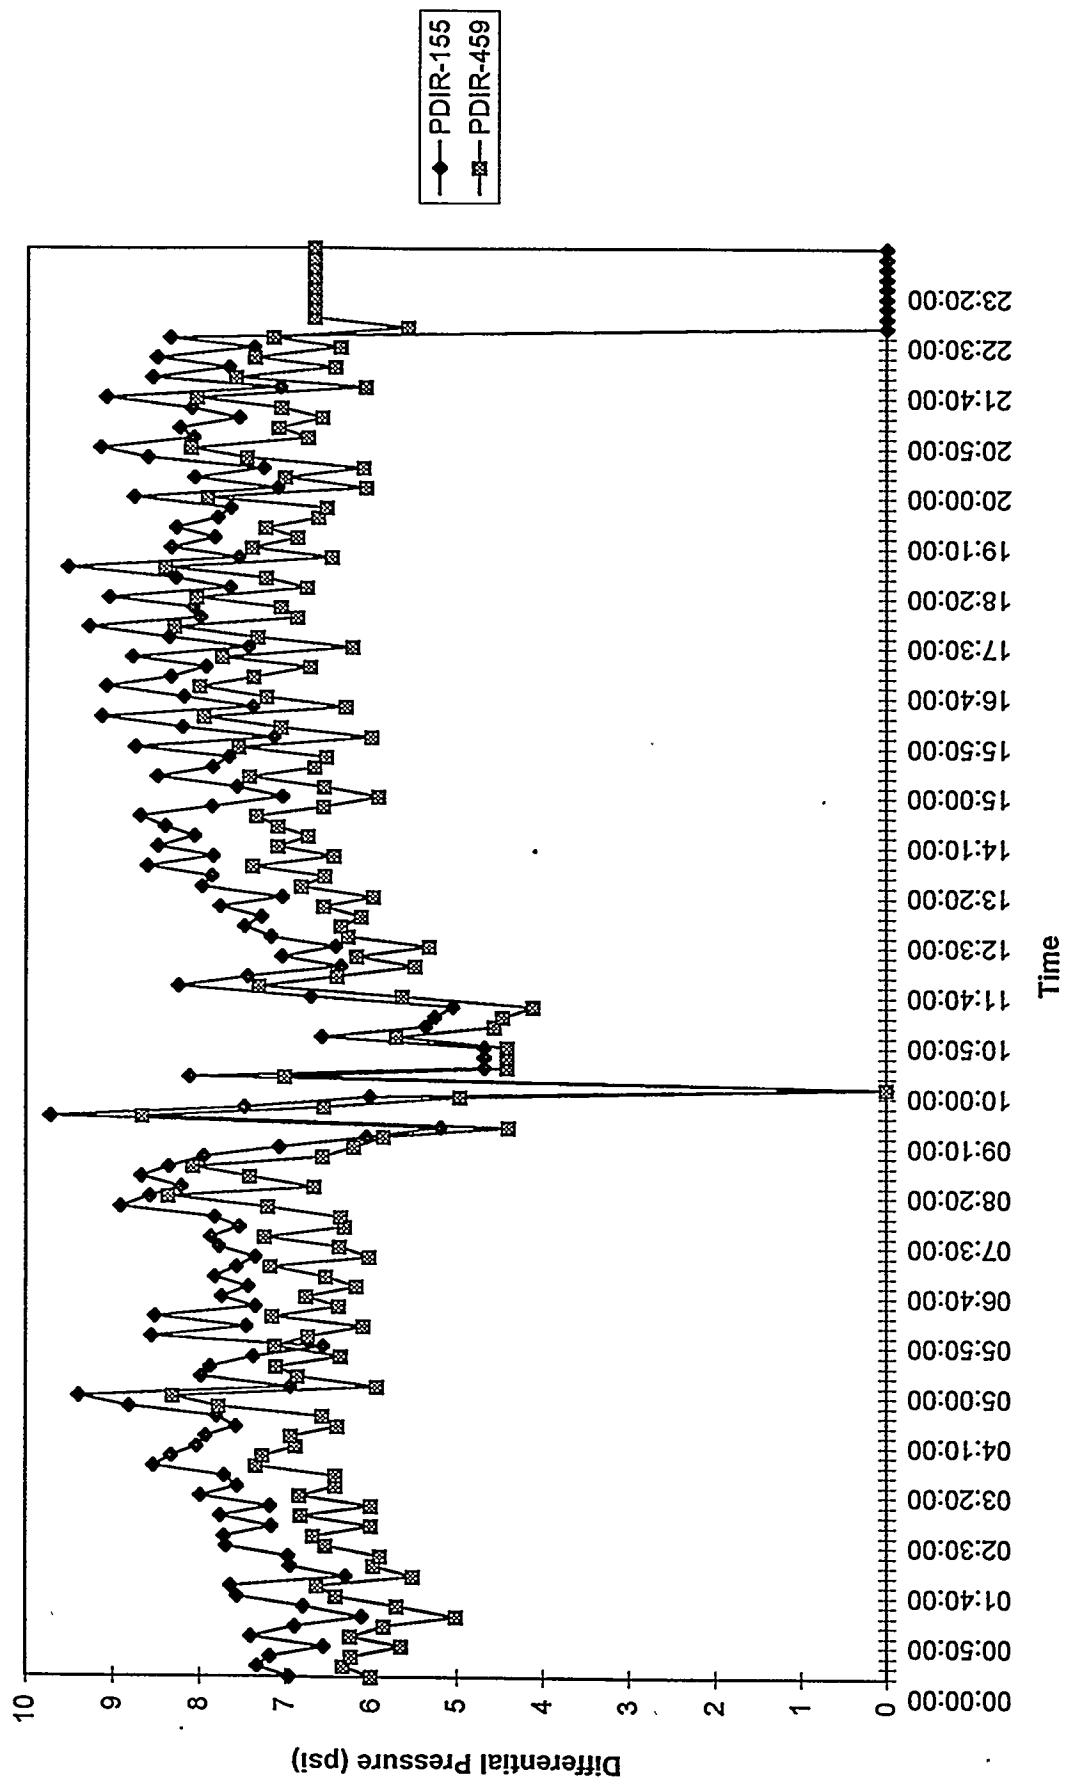


A3-123

F-100 Differential Pressure
Run 94MGC10, 10/27/94

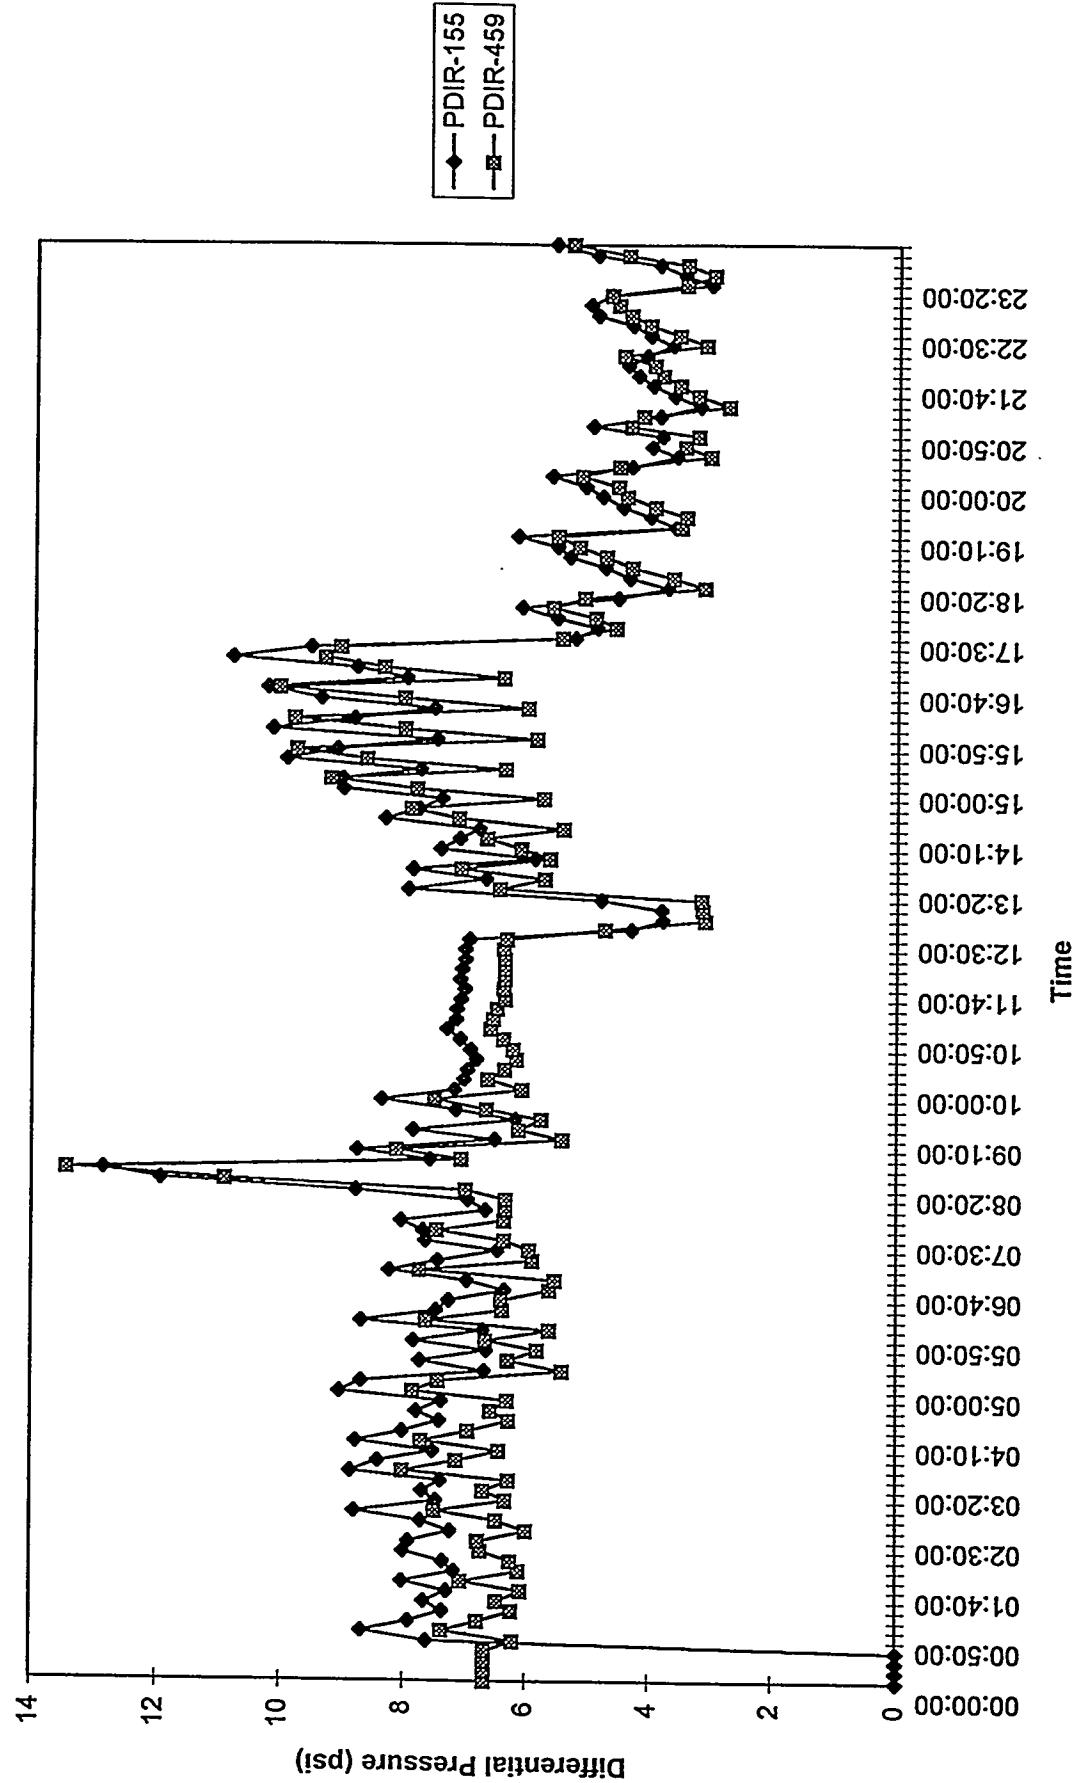

A3-124

F-100 Differential Pressure
Run 94MGC10, 10/28/94

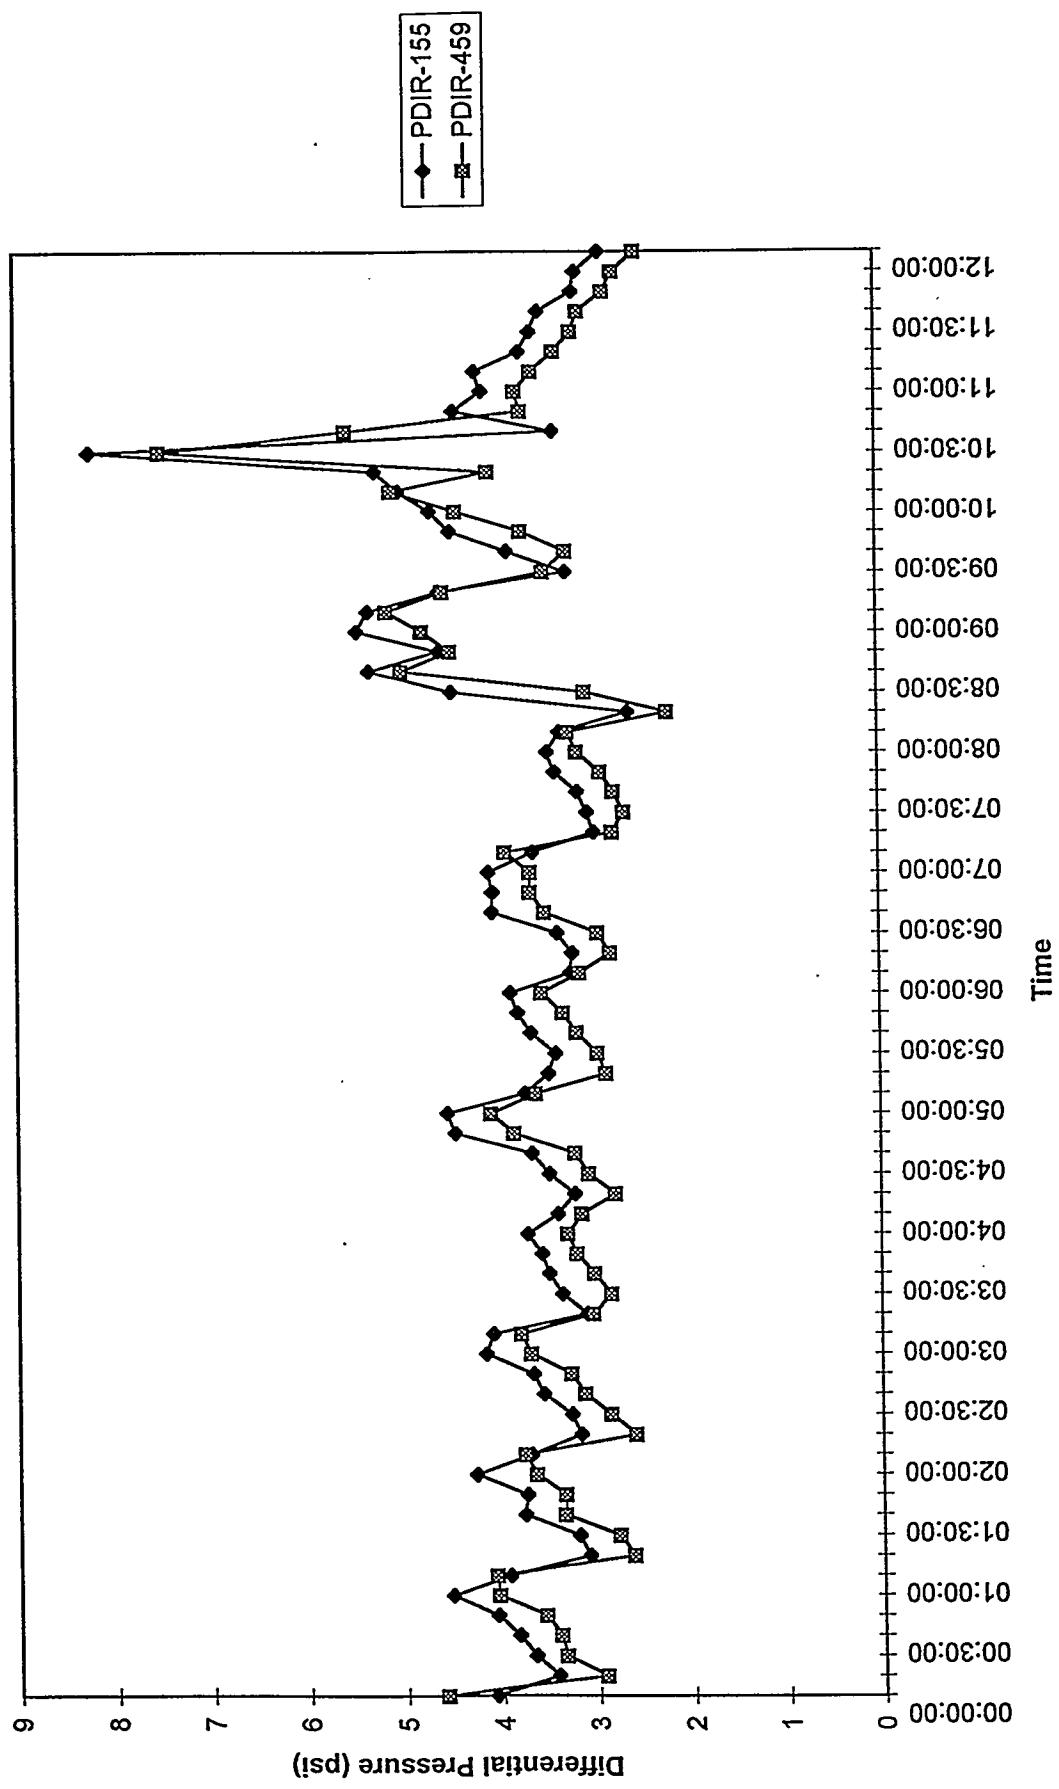


A3-125


Appendix 4

Process and Instrumentation Drawings

8

7

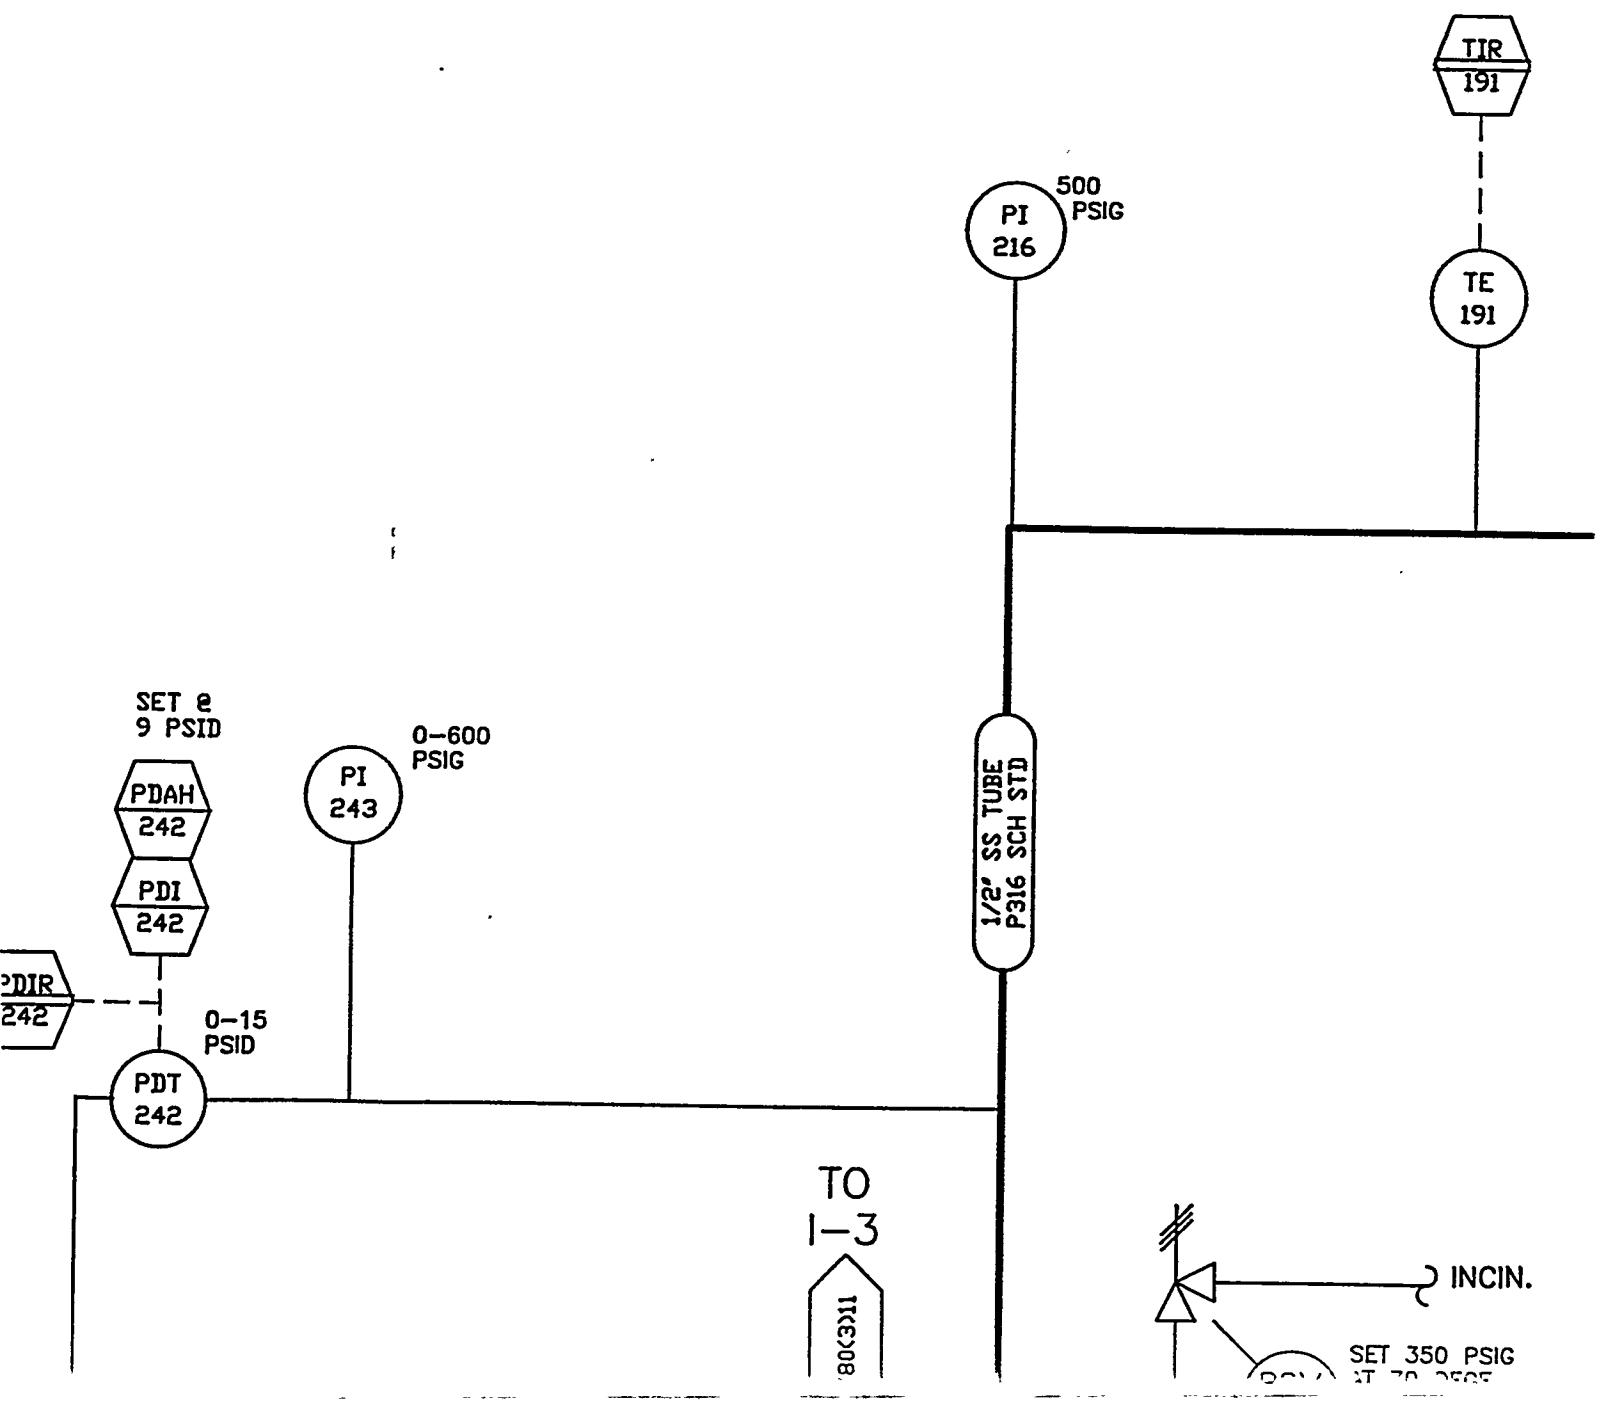

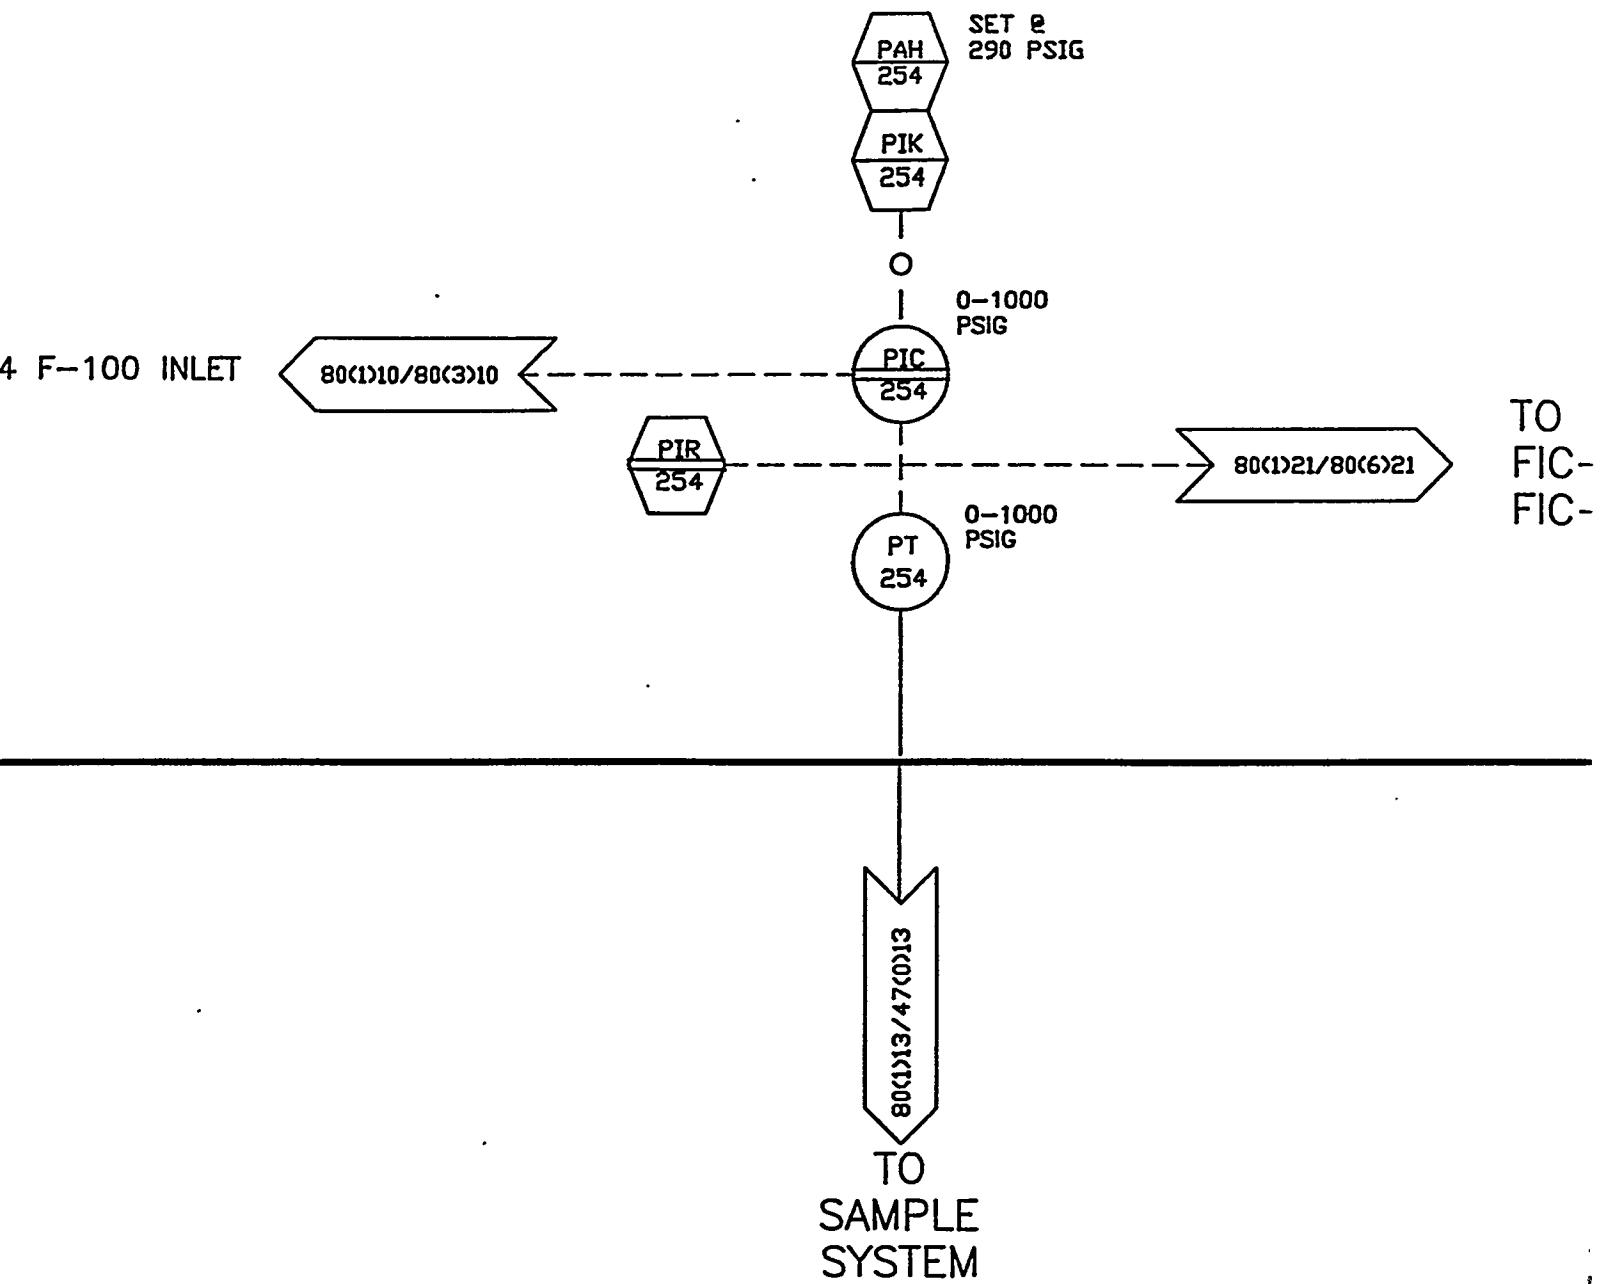

ZONE	REV	
GEN.	6	MODIFIED
DRAFTER		DAT
Gary Kulchock		5/
EG&G EST&H		DAT
W. E. Lowry		5/
ZONE	REV	
GEN.	7	MODIFIED
DRAFTER		DA
TERRY MCKISIC		8
EG&G EST&H		DA
ZONE	REV	
GEN.	8	MODIFIED
DRAFTER		DA
J. J. P. "Pete" Lowry		1/1
EG&G EST&H	DoE	DA
W. E. Lowry		DA

TO OUTLET
FILTERATION

80(1)16/80(6)16

REVISION


ONE	REV	DESCRIPTION						DATE
EN.	6	MODIFIED AS PER MARKED PRINT; ISSUED FOR CONSTRUCTION						5/12/94
FTER G ESH	Gary Kulchock	DATE 5/18/94	CHECKER S. Conko	DATE 5/18/94	EG&G RESPONSIBLE ENGR. Dave Lunifeld	DATE 5/24/94	REVIEWER	DATE
	W. E. Lowry	DATE 5/24/94	PROJECT ENGR. S. Renninger	DATE 5/18/94	BRANCH MANAGER John Rockey	DATE 5/18/94	DOE CEOSID John Rotunda	WJA DATE 5/18/94
ONE	REV	DESCRIPTION						DATE
EN.	7	MODIFIED AS PER MARKED PRINT; ISSUED FOR CONSTRUCTION						8/17/94
FTER G ESH	TERRY MCKISIC	DATE 8/17/94	CHECKER GARY KULCHOCK	DATE 8/17/94	EG&G RESPONSIBLE ENGR. Dave Lunifeld	DATE 8/17/94	REVIEWER	DATE
		DATE	PROJECT ENGR. JOHN M. ROCKEY	DATE 8/18/94	BRANCH MANAGER JOHN M. ROCKEY	DATE 8/18/94	DOE CEOSID John Rotunda	WJA DATE 8/18/94
ONE	REV	DESCRIPTION						DATE
EN.	8	MODIFIED AS PER MARKED PRINT; ISSUED FOR CONSTRUCTION						9/30/94
FTER G ESH	John M. Rockey W. E. Lowry	DATE 10-3-94	CHECKER Gary Kulchock	DATE 10/3/94	EG&G RESPONSIBLE ENGR. Dave Lunifeld	DATE 10/5/94	REVIEWER	DATE
		DATE	PROJECT ENGR. John M. Rockey	DATE 10/3/94	BRANCH MANAGER	DATE	DOE CEOSID John Rotunda	WJA DATE 10/5/94


H


G

F


FROM
N2 PURGE

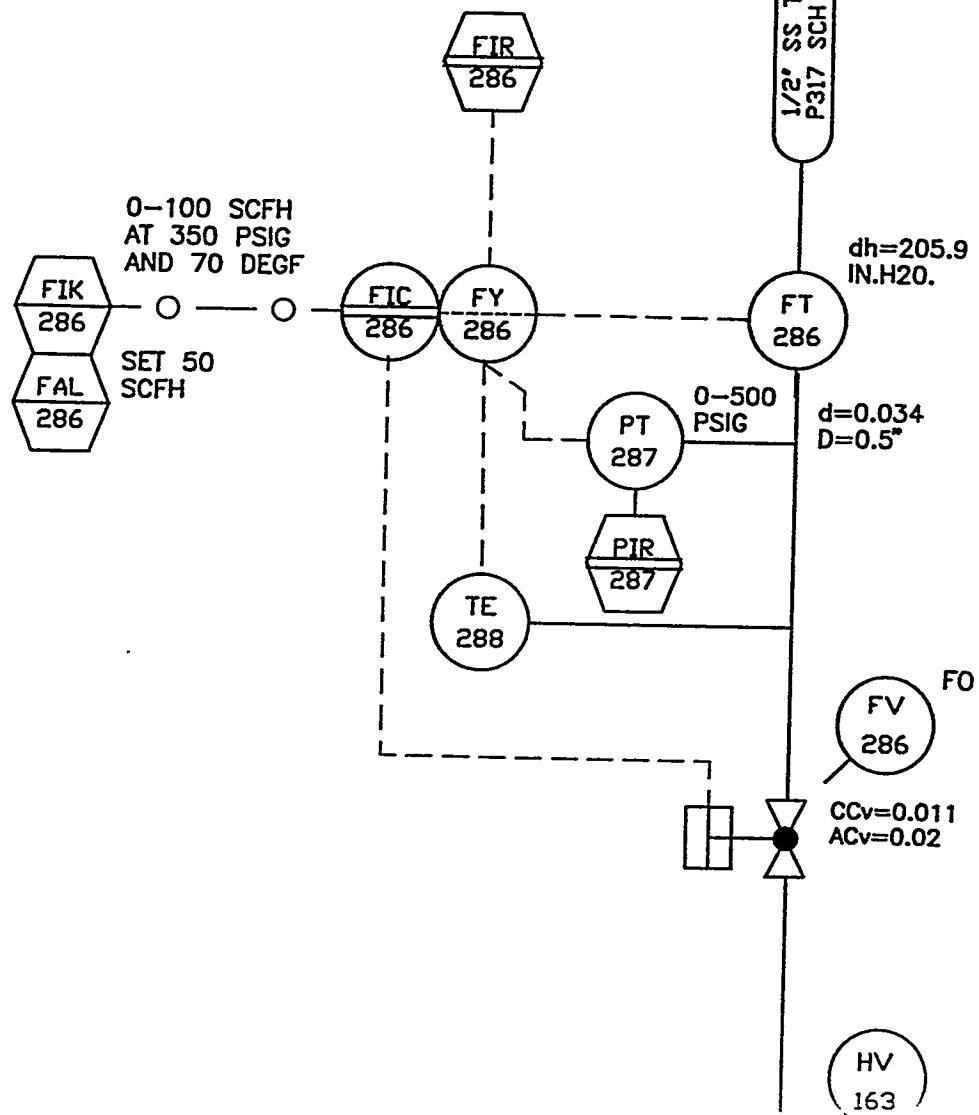

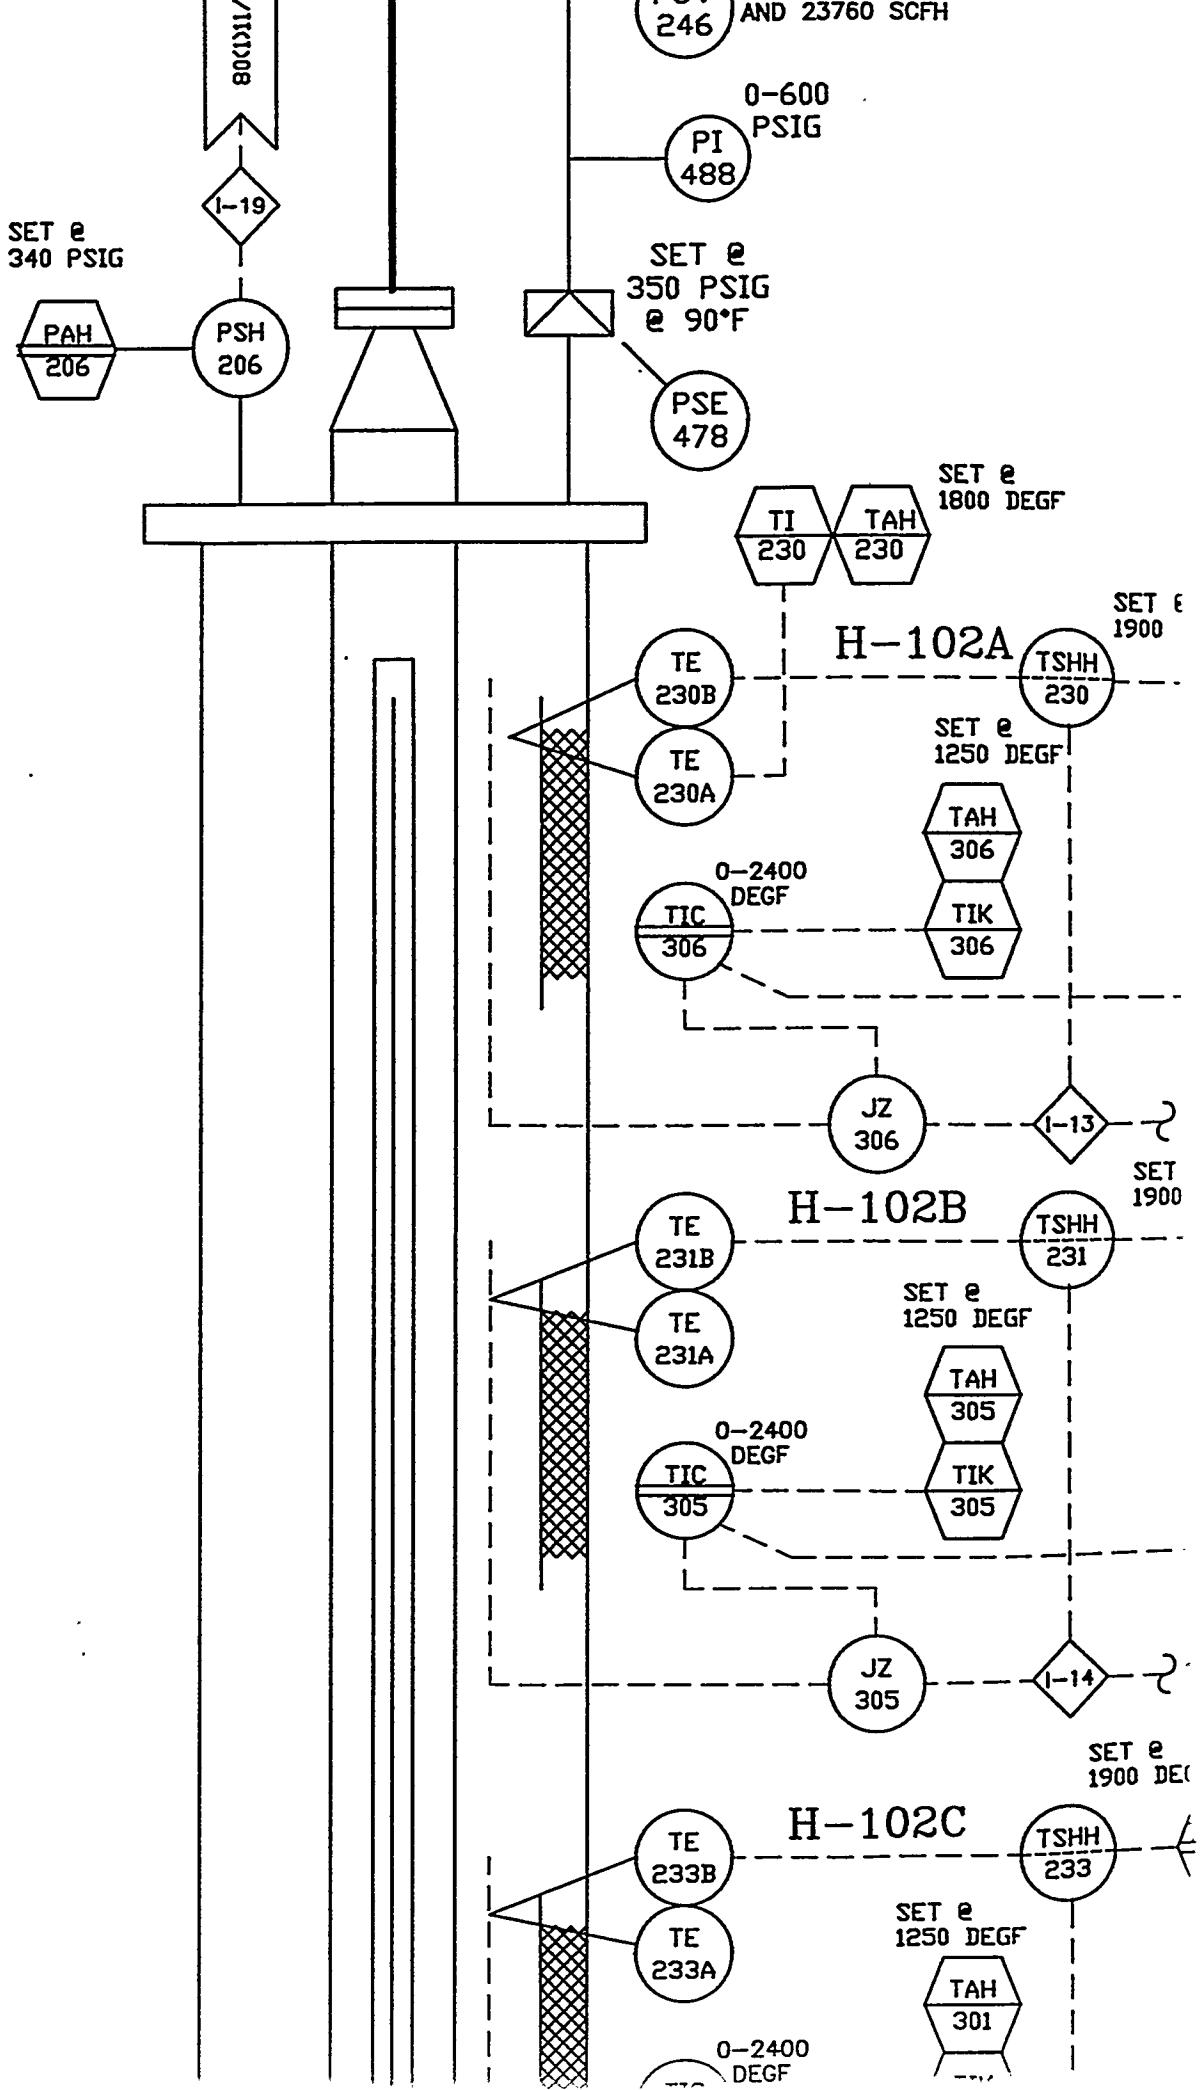

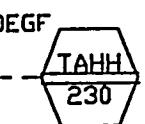TAHH
230


120VAC

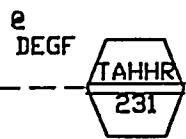
TAHHR
231

120VAC

TAHHR
233

600 PSIG

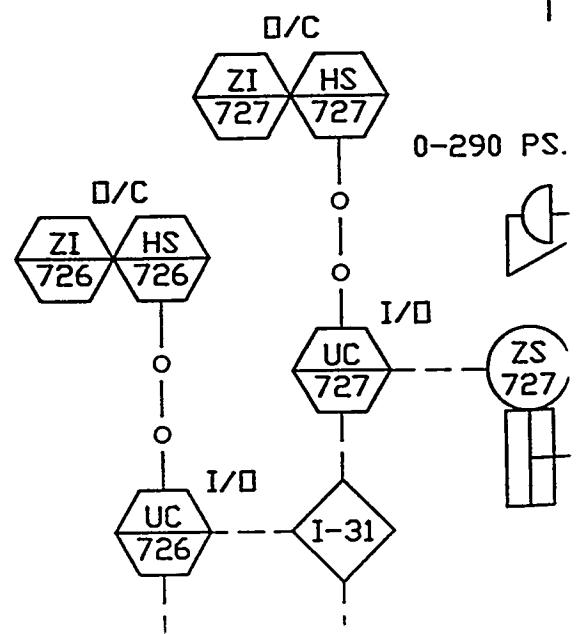N₂

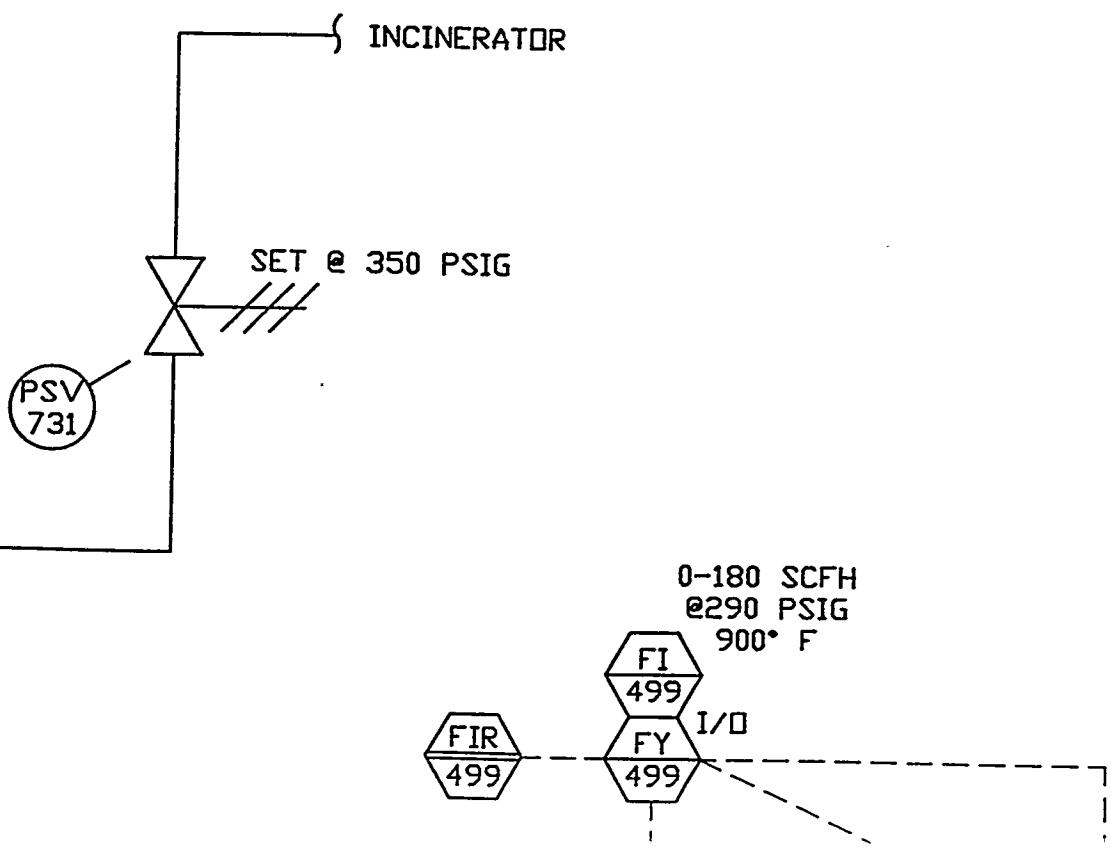



E


[


THERMOCOUPLE WELL
PRESSURIZATION

FROM
F-100

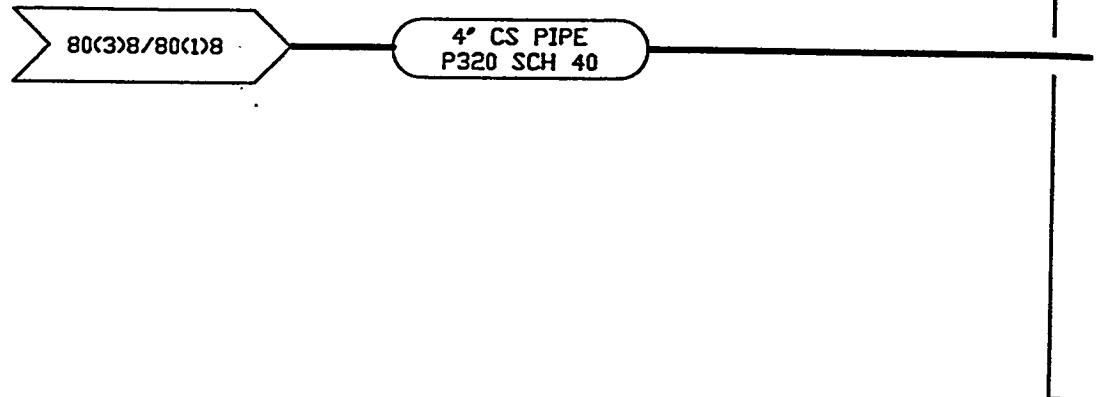

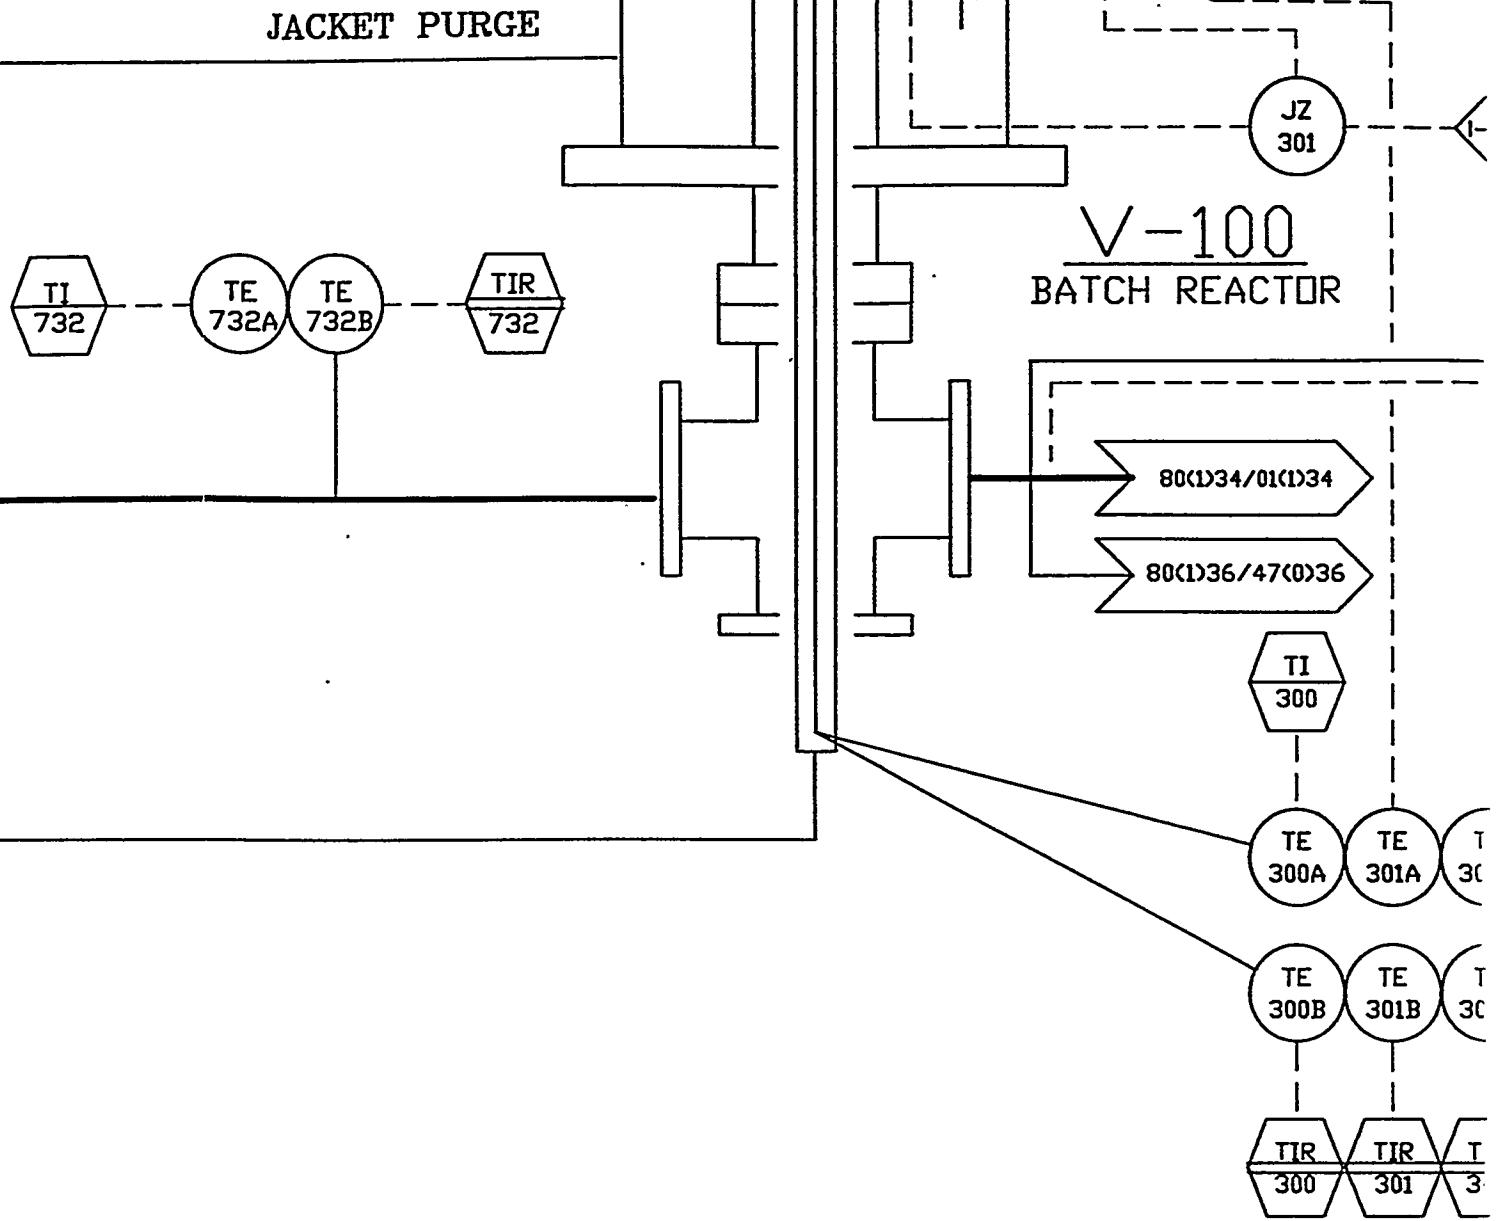

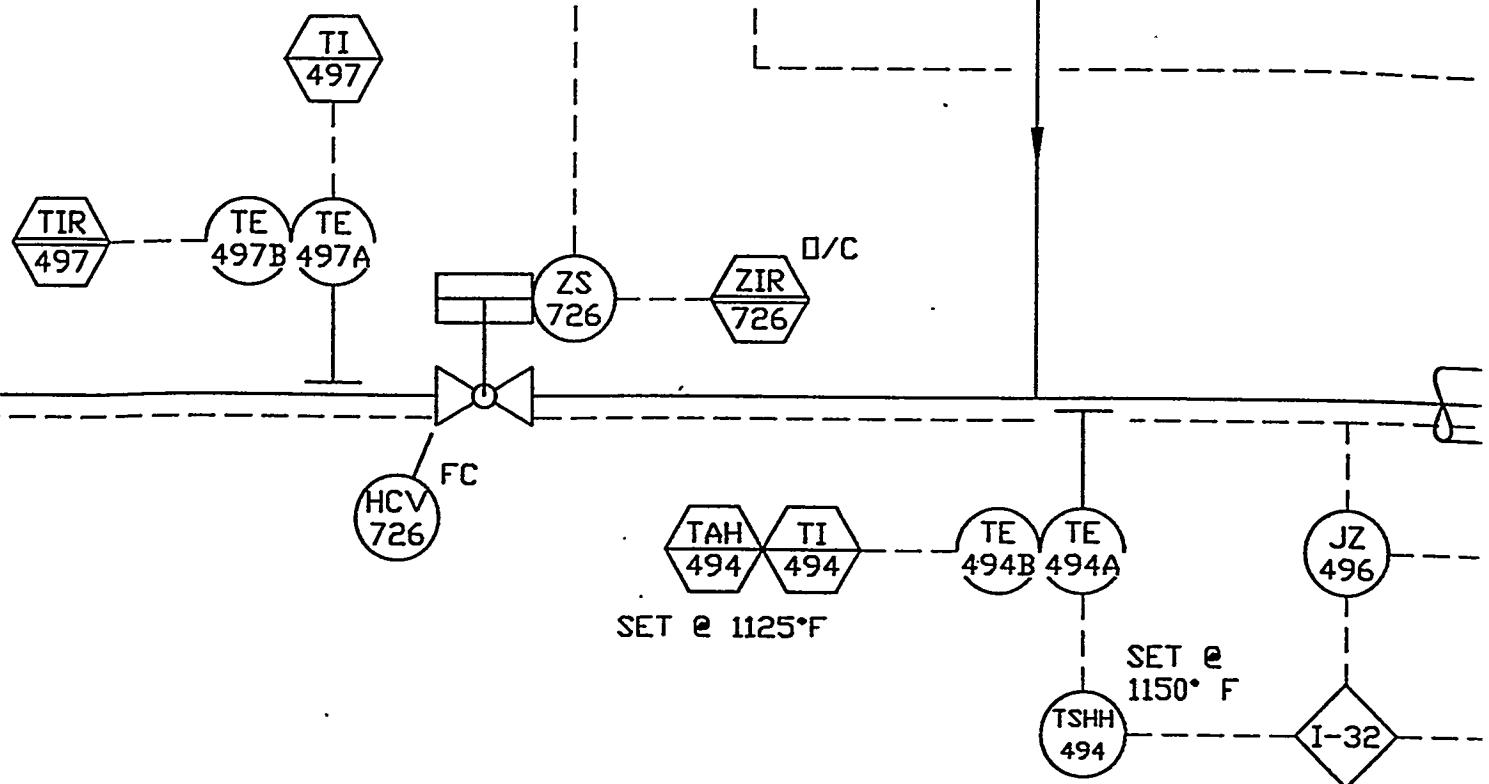

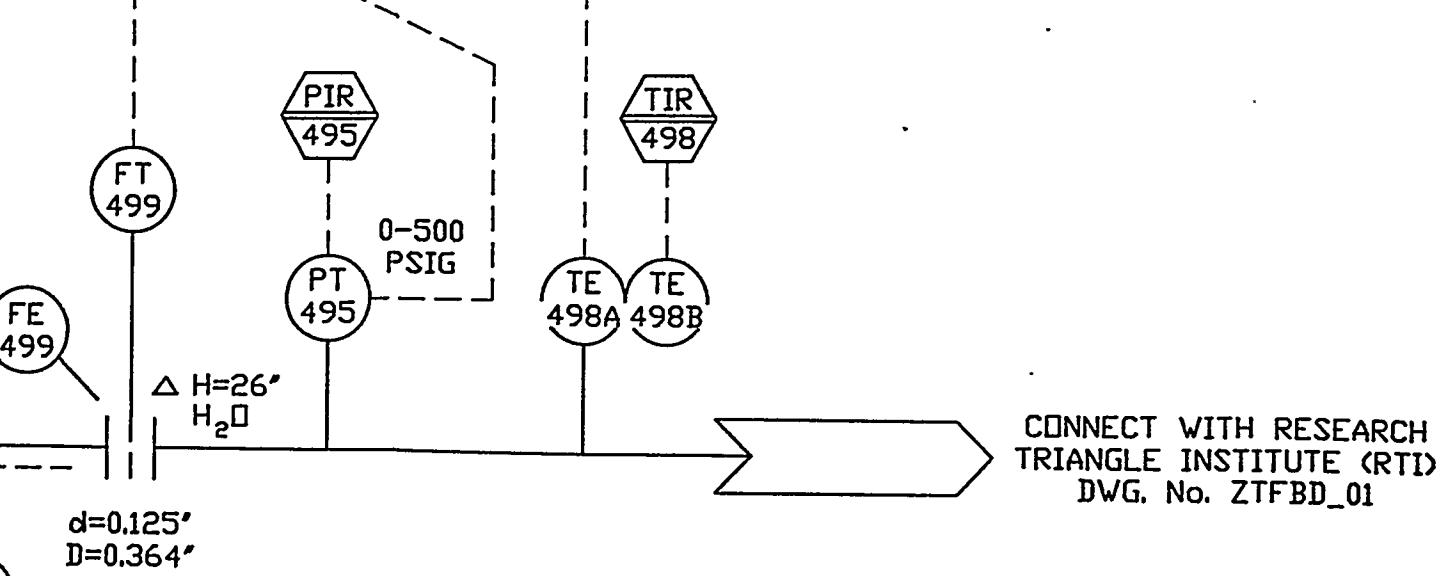

NOTES:

1. ALL IMPULSE LINES ARE 3/8
 2. PREV. BLOCK RANGE (0-425)
 3. CURRENT BLOCK RANGE (451)
 4. LAST POINT NUMBER USED 36
 5. LAST TAG NUMBER USED 493

REFERENCE DRAWINGS	DRAFTER Jimmy Thorton	DATE 10/28/93	 B-12 A1 MODU PRE DR
	PROJECT ENGINEER John Rockey	DATE 11/2/93	
	REQUESTOR John Rockey	DATE 11/2/93	
	BRANCH MANAGER Larry Strickland	DATE 11/2/93	
	ESTH	DATE	
	DOE WJA John Rotunda	DATE 10/28/93	
	DATE	SIZE E	FSCM NO
	DATE		

**THIS DRAWING IS PART
OF THE EG&G DOCUMENT
CONTROL SYSTEM**

CONNECT WITH RESEARCH
TRIANGLE INSTITUTE (RTI)
DWG. No. ZTFBD_01

C


S:
ALL IMPULSE LINES ARE 3/8 UNLESS OTHERWISE NOTED.
EV. BLOCK RANGE (0-425).
CURRENT BLOCK RANGE (451-499) P&ID's 1,2,3,6.
LAST POINT NUMBER USED 36.
LAST TAG NUMBER USED 493.

DWG NO

STD920080.08

HS
1

DRAFTER	DATE	Jimmy Thorton	10/28/93
PROJECT ENGINEER	DATE	John Rockey	11/2/93
REQUESTOR	DATE	John Rockey	11/2/93
BRANCH MANAGER	DATE	Larry Strickland	11/2/93
ESTH	DATE		
DOE	DATE	WJA John Rotunda	10/28/93
	DATE		

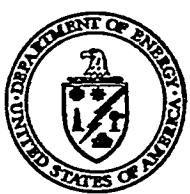


United States Department of Energy
MORGANTOWN ENERGY TECHNOLOGY CENTER

Morgantown, WV


B-12 ADVANCED GASIFICATION FACILITY
MODULAR GAS CLEANUP RIG (MGCR)
PROCESS AND INSTRUMENTATION
DRAWING (P&ID1) BATCH MODE

SIZE	FSCM NO	DWG NO	REV
E		STD920080.08	8


A

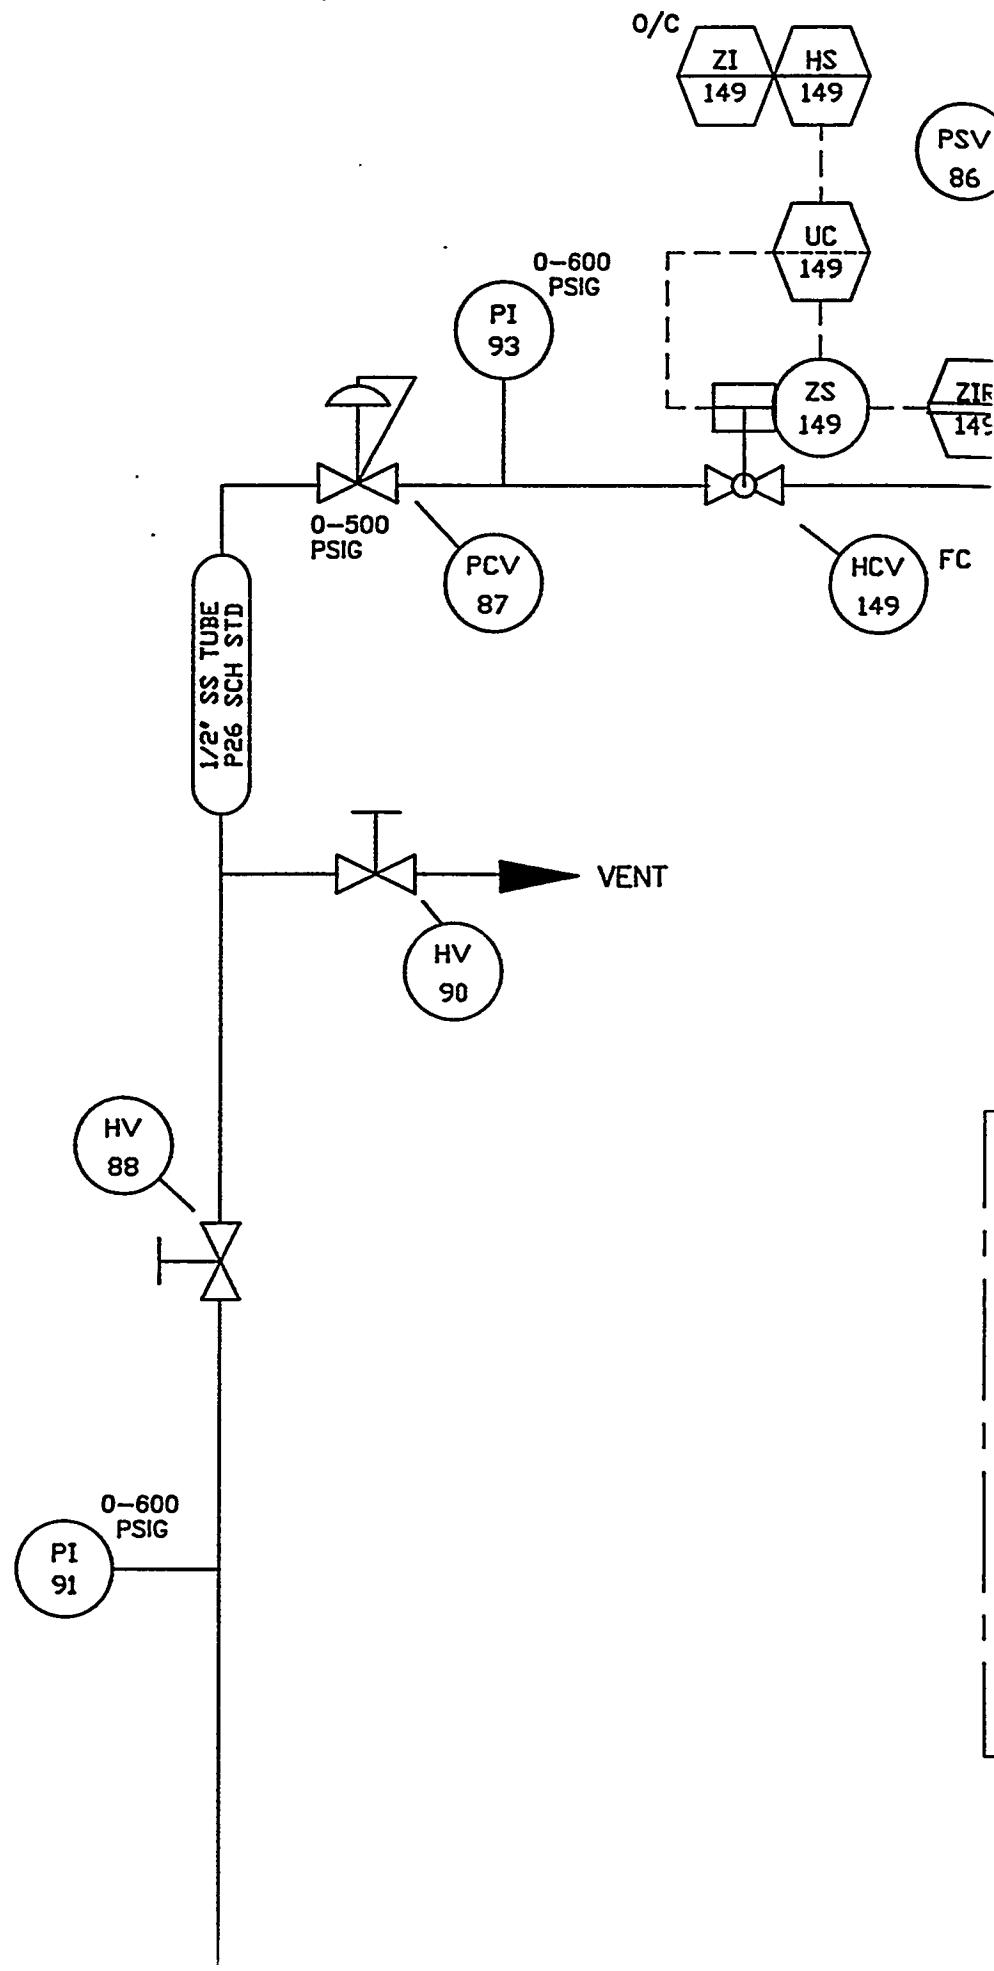


VENT

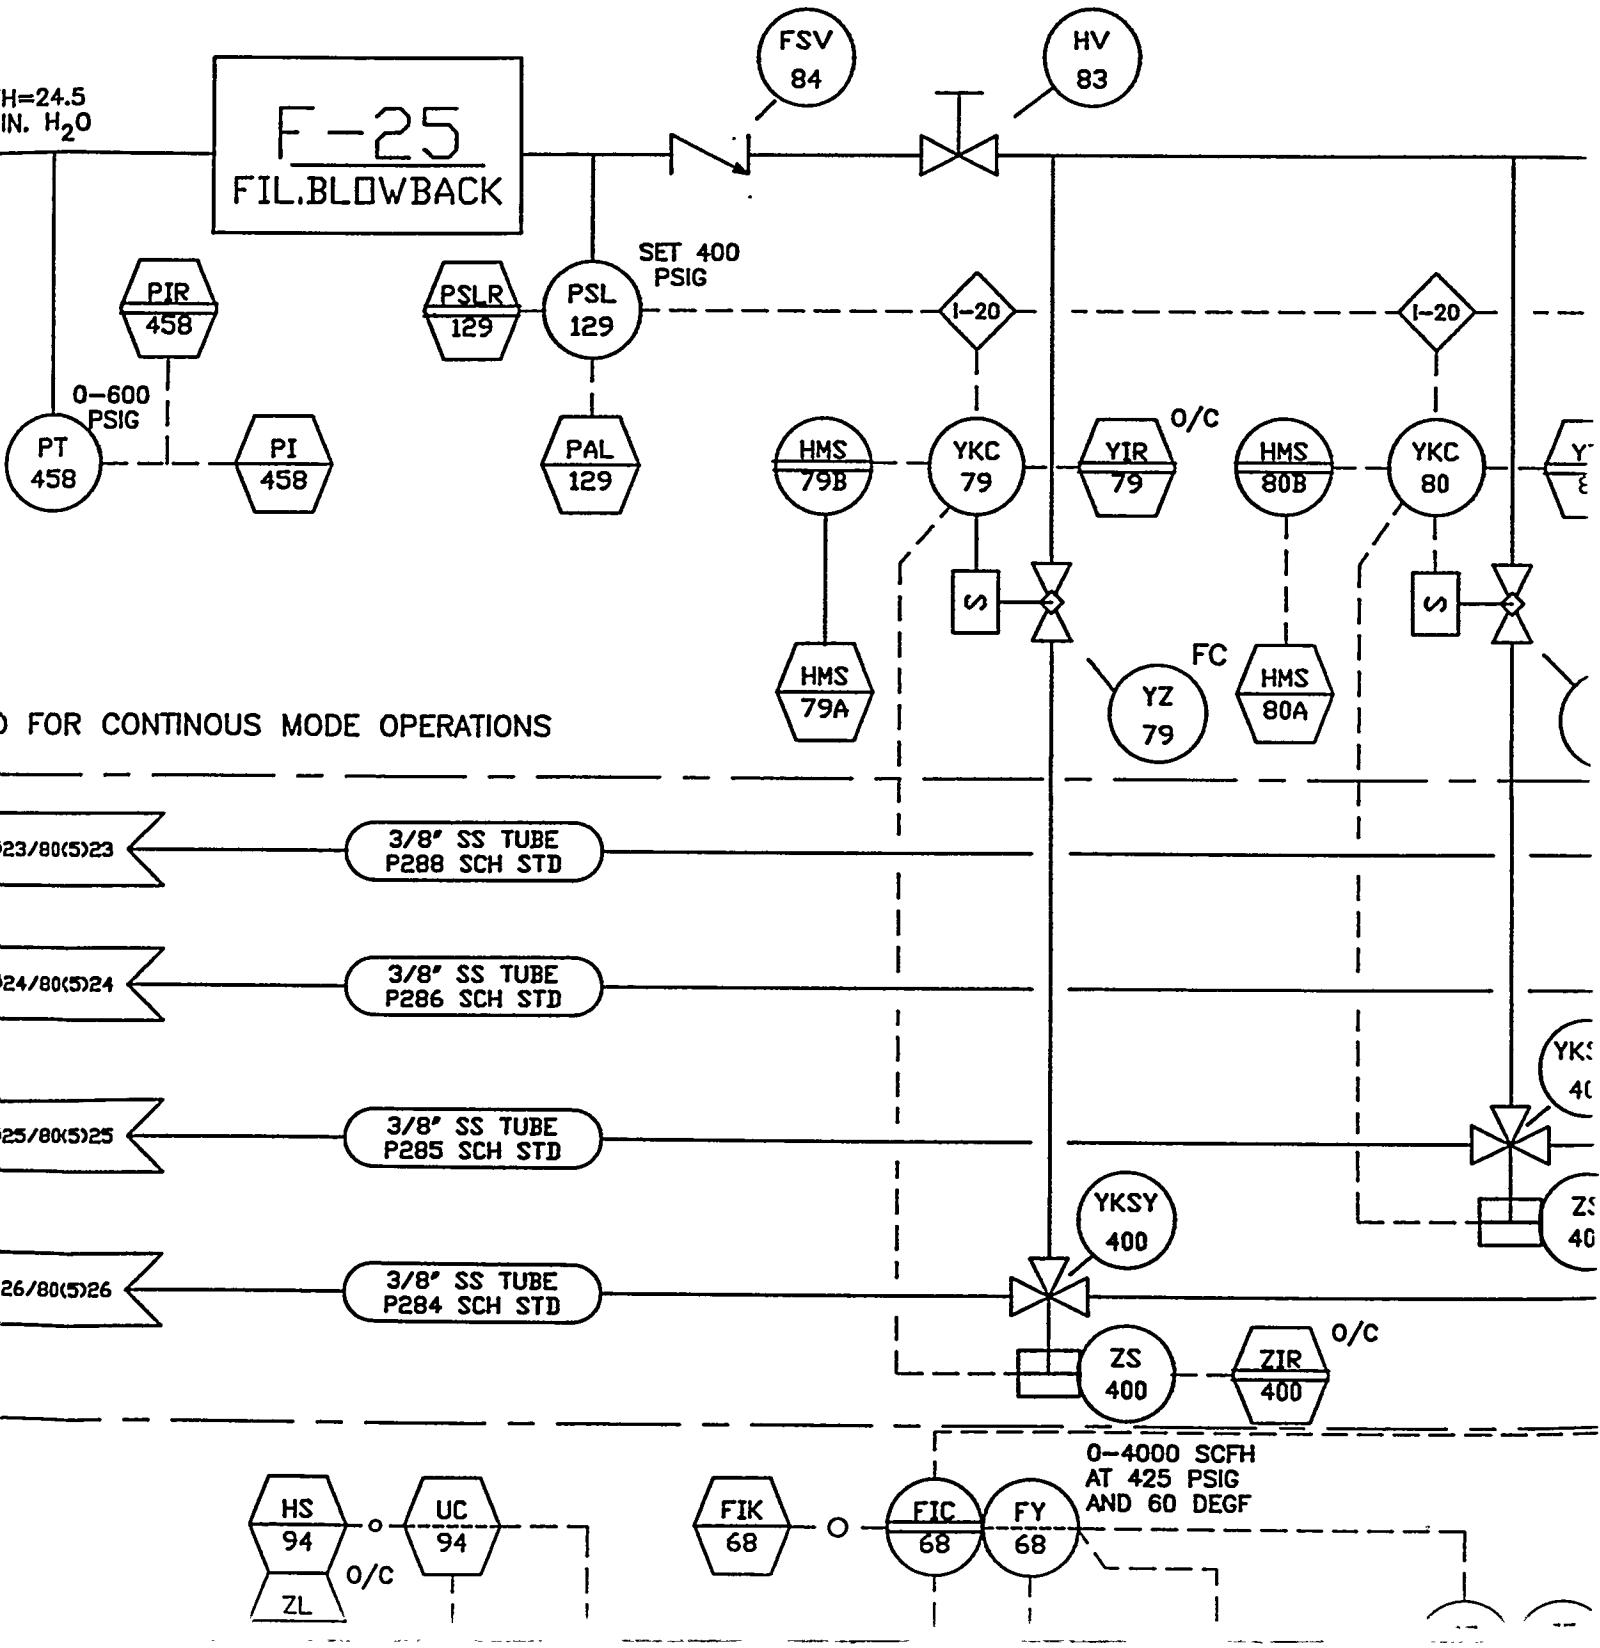

FROM
PSL-152

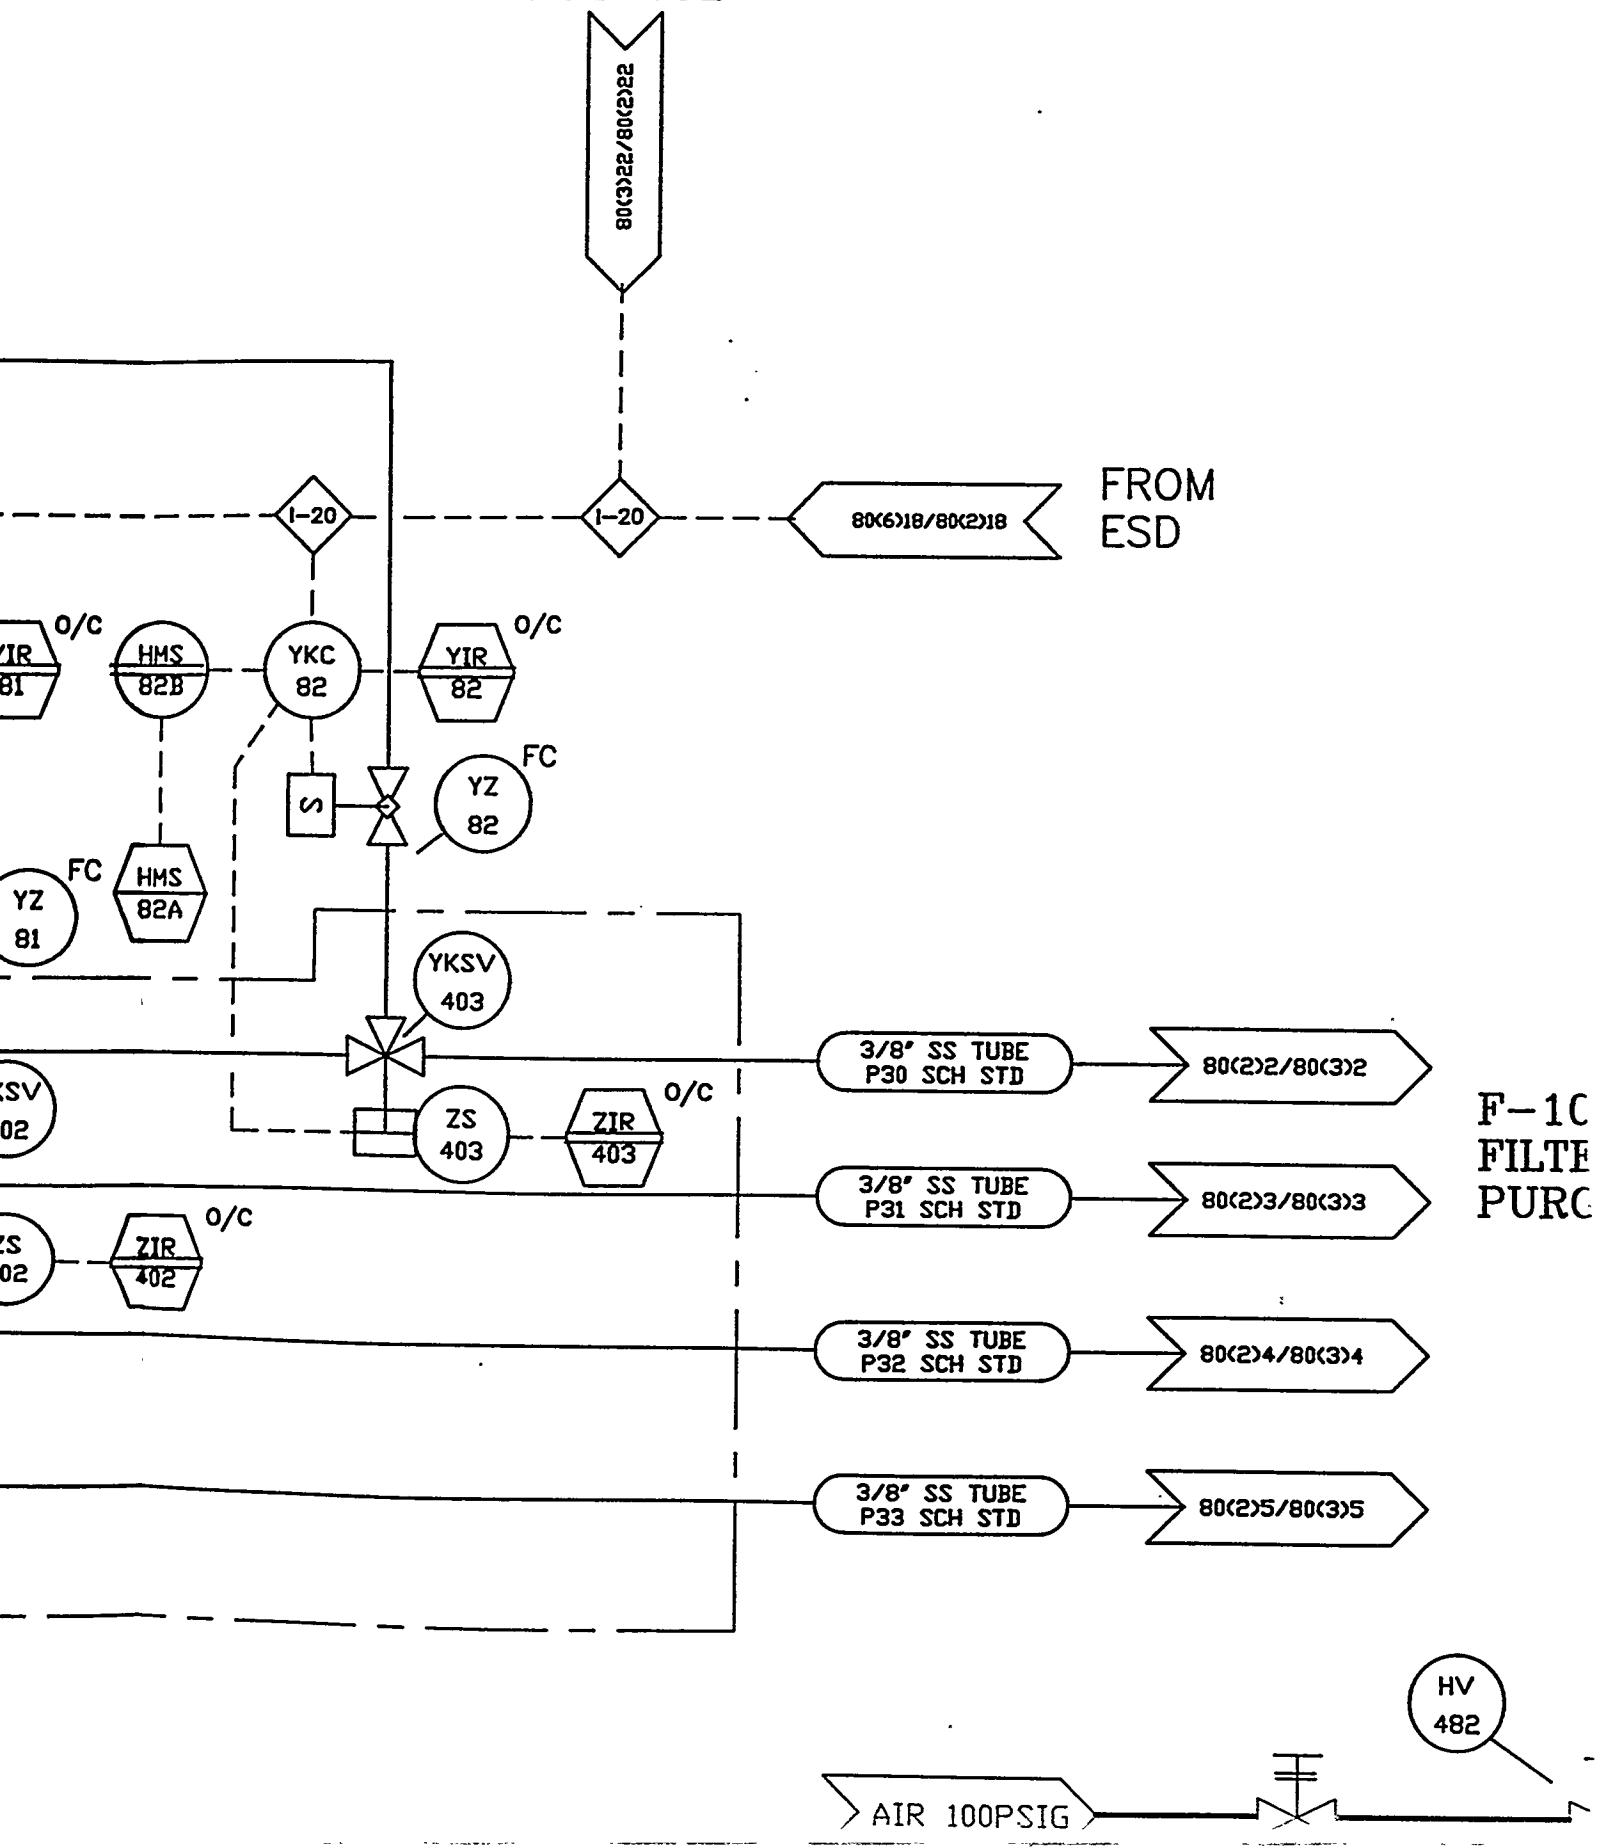



ZONE	REV	
GEN.	6	MODIFIED AS PER MARKED PRINT
DRAFTER	GARY J. KULCHOCK	DATE 5/18/94 CHECKER S. CONKO
EGG ESH	W.E. LOWRY	DATE 5/24/94 PROJECT ENGR. S. RENNINGER
ZONE	REV	
GEN.	7	MODIFIED AS PER MARKED PRINT
DRAFTER	Gary J. Kulchock	DATE 10-3-94 CHECKER Gary J. Kulch
EGG ESH	W.E. Lowry	DATE 10-11-94 PROJECT ENGR. S. Renninger

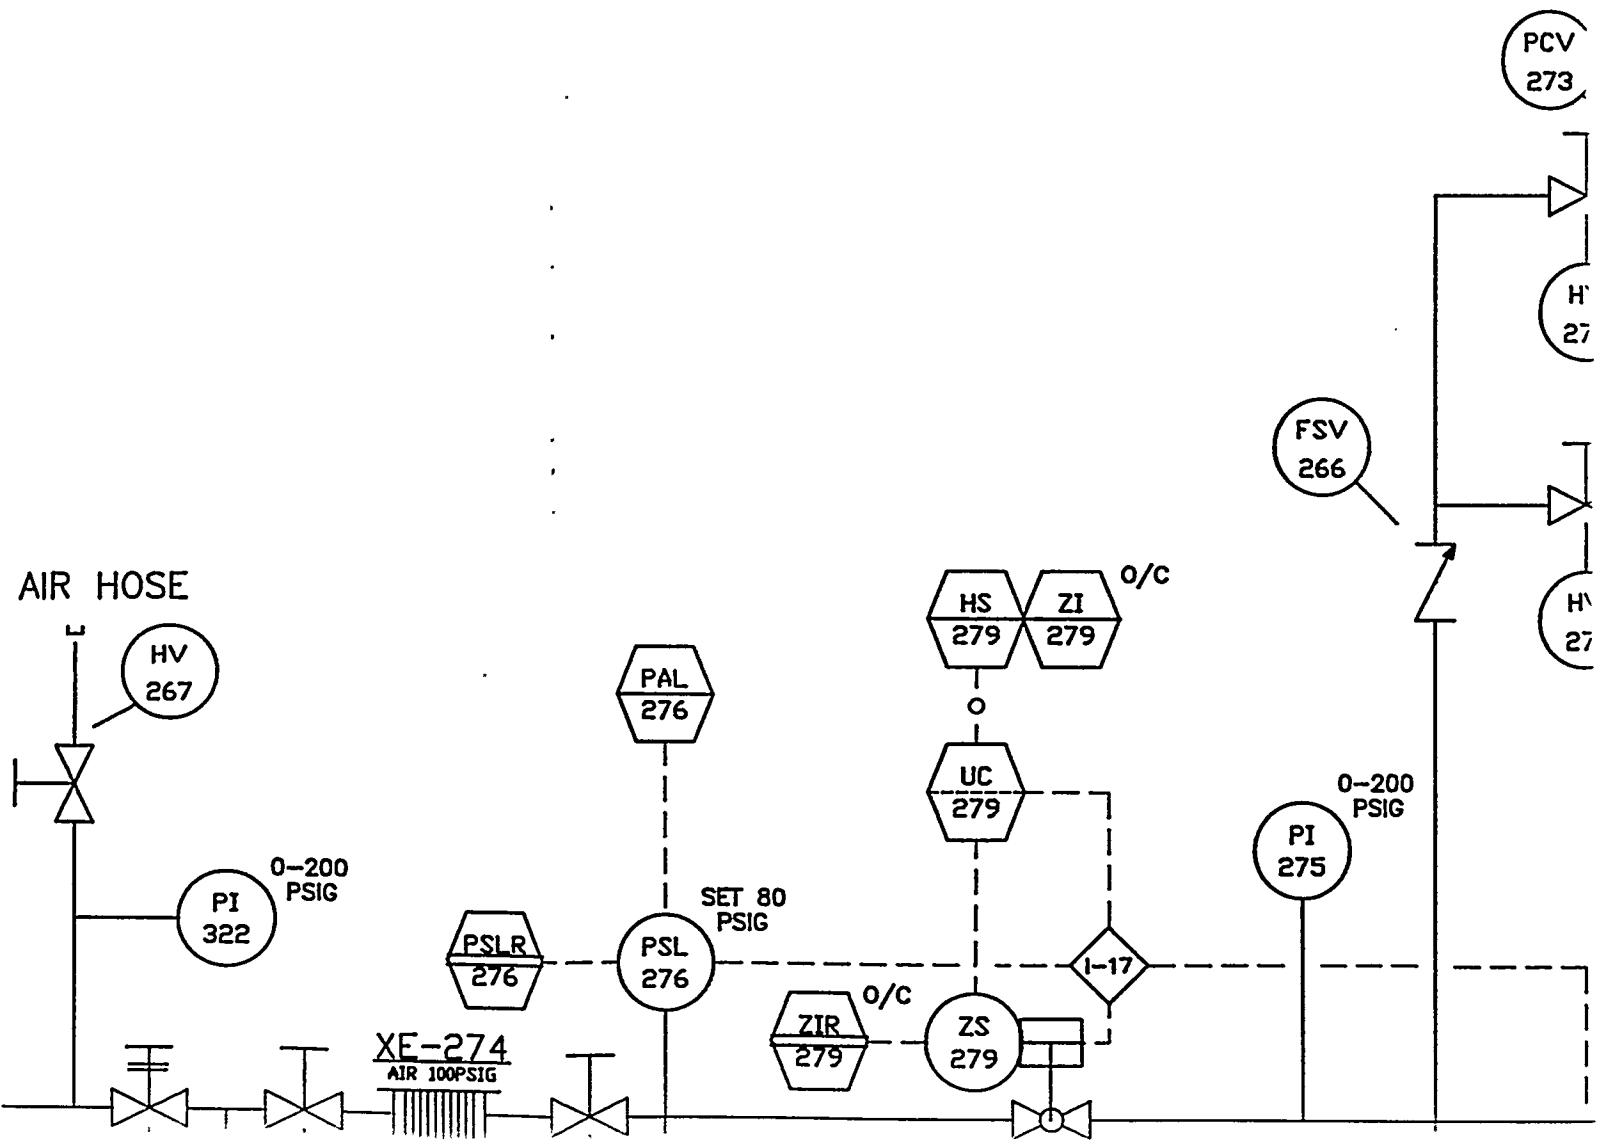



REVISION



LINE	REV	DESCRIPTION						DATE
EN.	6	MODIFIED AS PER MARKED PRINT; ISSUED FOR CONSTRUCTION						5/13/94
INTER		DATE	CHECKER	DATE	EG&G RESPONSIBLE ENGR.	DATE	REVIEWER	DATE
J. KULCHOCK	5/18/94	S. CONKO	5/18/94	DAVID LUNIFELD	5/24/94	JOE CEISID		
ESCH	DATE	PROJECT ENGR.	DATE	BRANCH MANAGER	DATE	JOHN R. ROTUNDA	DATE	
E. LOWRY	5/24/94	S. RENNINGER	5/18/94	JOHN M. ROCKEY	5/18/94			5/18/94
LINE	REV	DESCRIPTION						DATE
EN.	7	MODIFIED AS PER MARKED PRINT; ISSUED FOR CONSTRUCTION						9/30/94
INTER		DATE	CHECKER	DATE	EG&G RESPONSIBLE ENGR.	DATE	REVIEWER	DATE
J. KULCHOCK	10-3-94	J. KULCHOCK	10/3/94	DAVID LUNIFELD	10/5/94	JOE CEISID		
ESCH	DATE	PROJECT ENGR.	DATE	BRANCH MANAGER	DATE	JOHN R. ROTUNDA	DATE	
E. LOWRY	10-11-94	S. RENNINGER	10/14/94					10/15/94

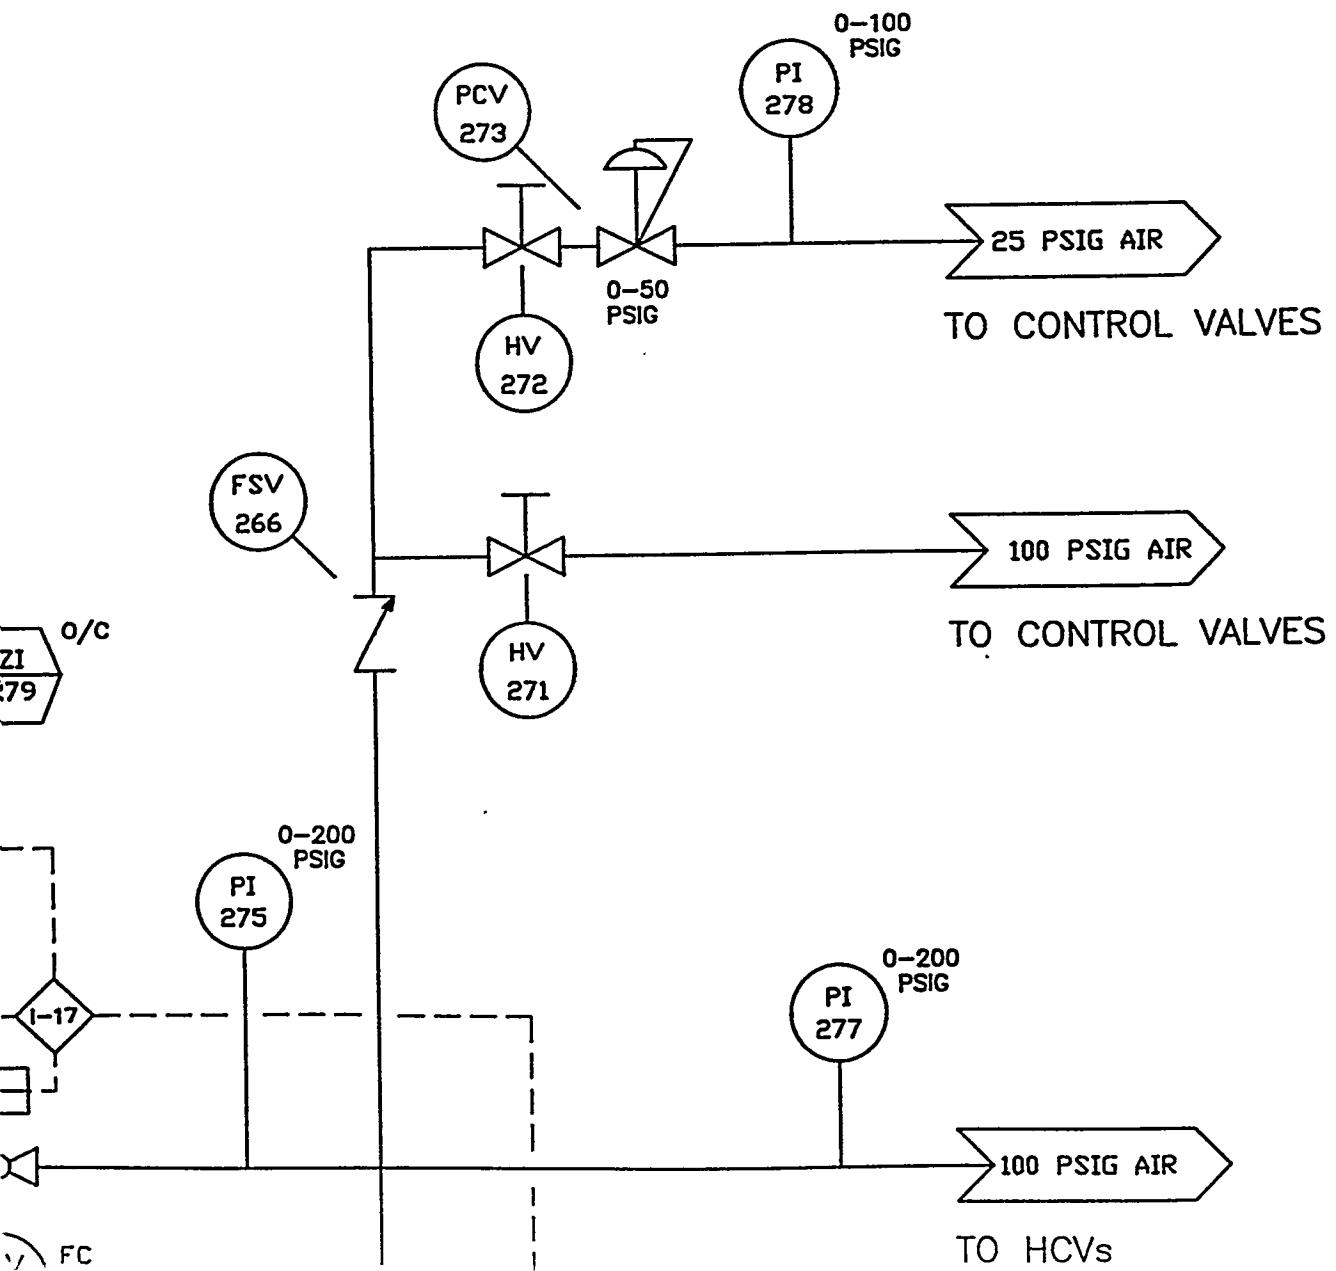


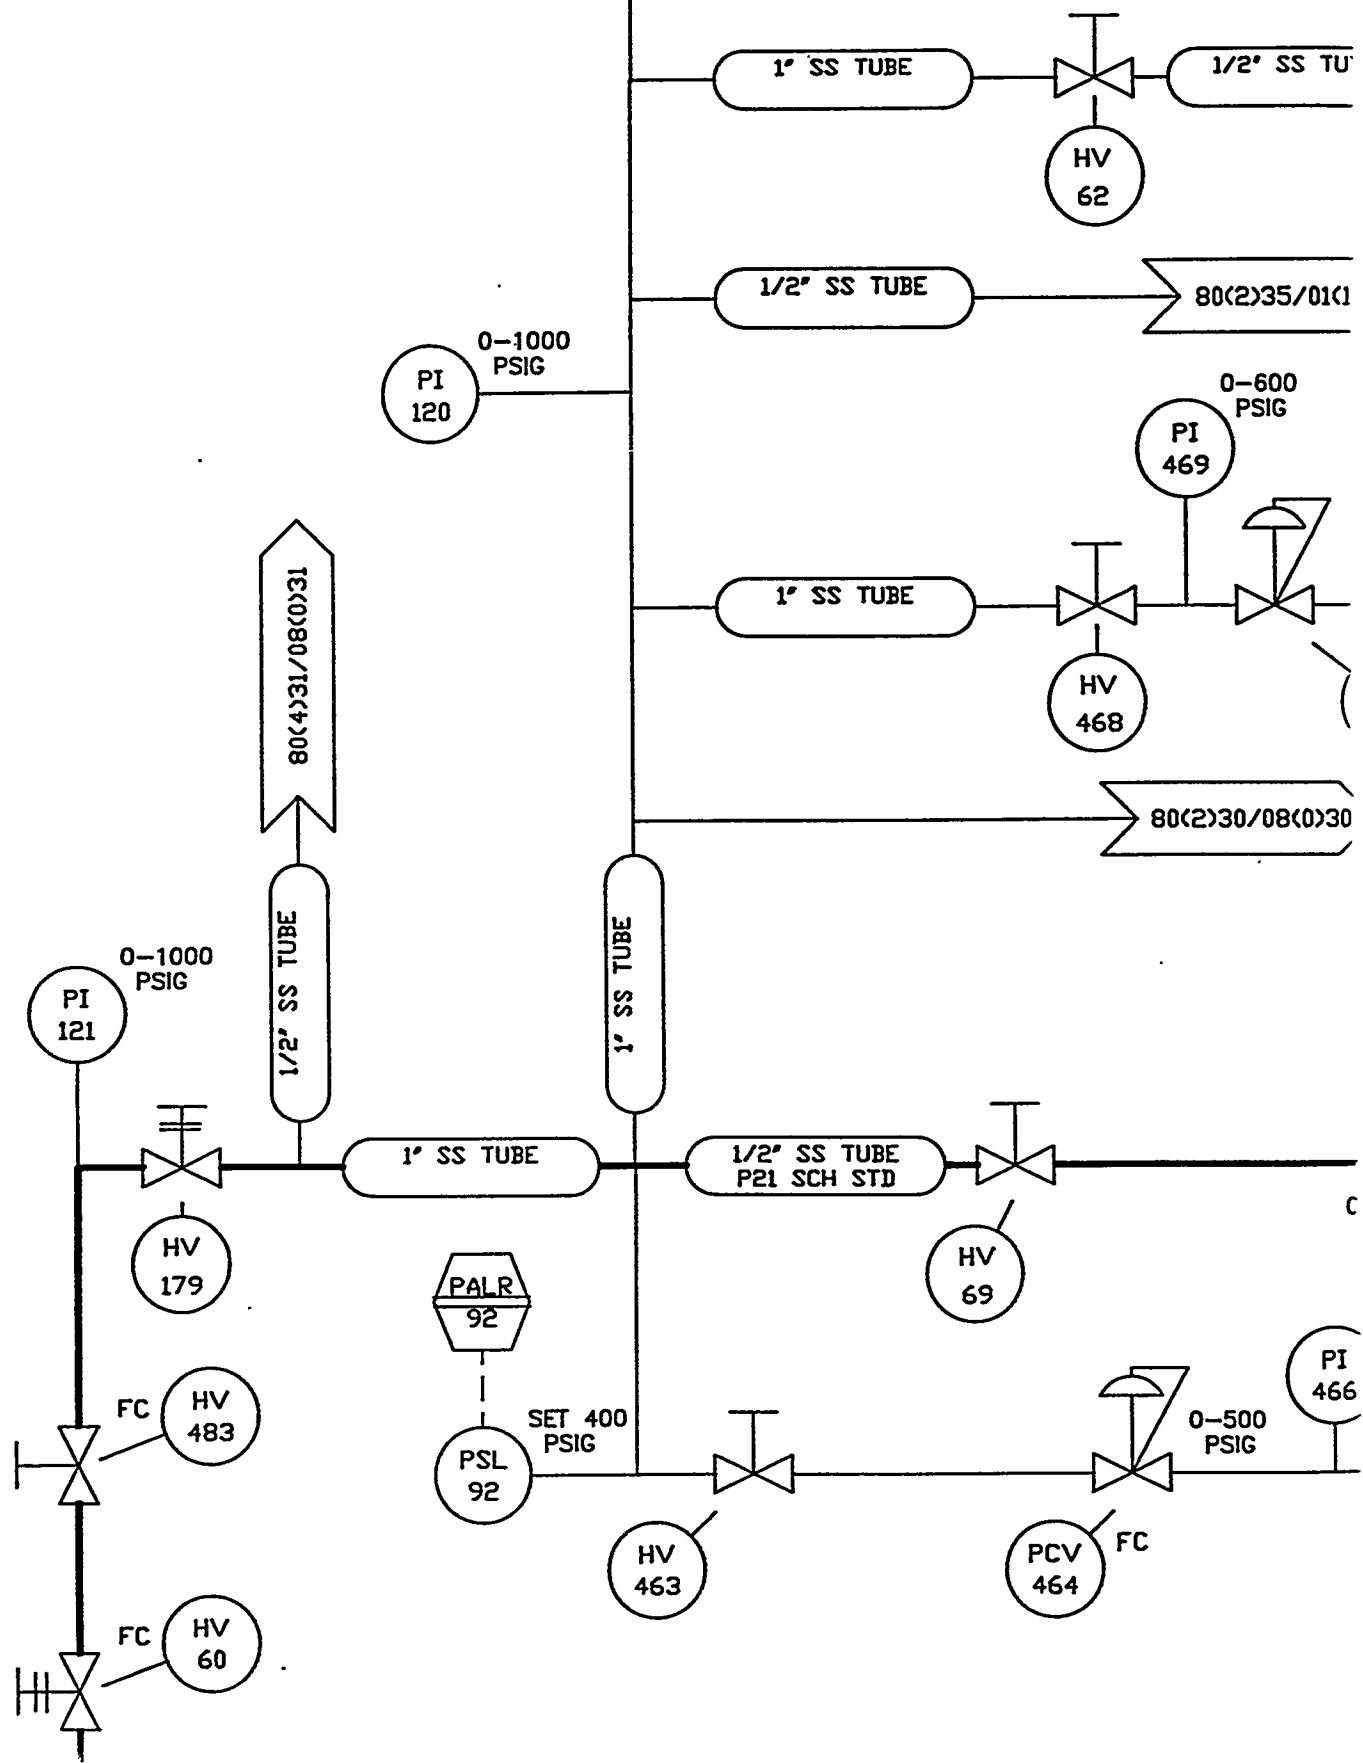



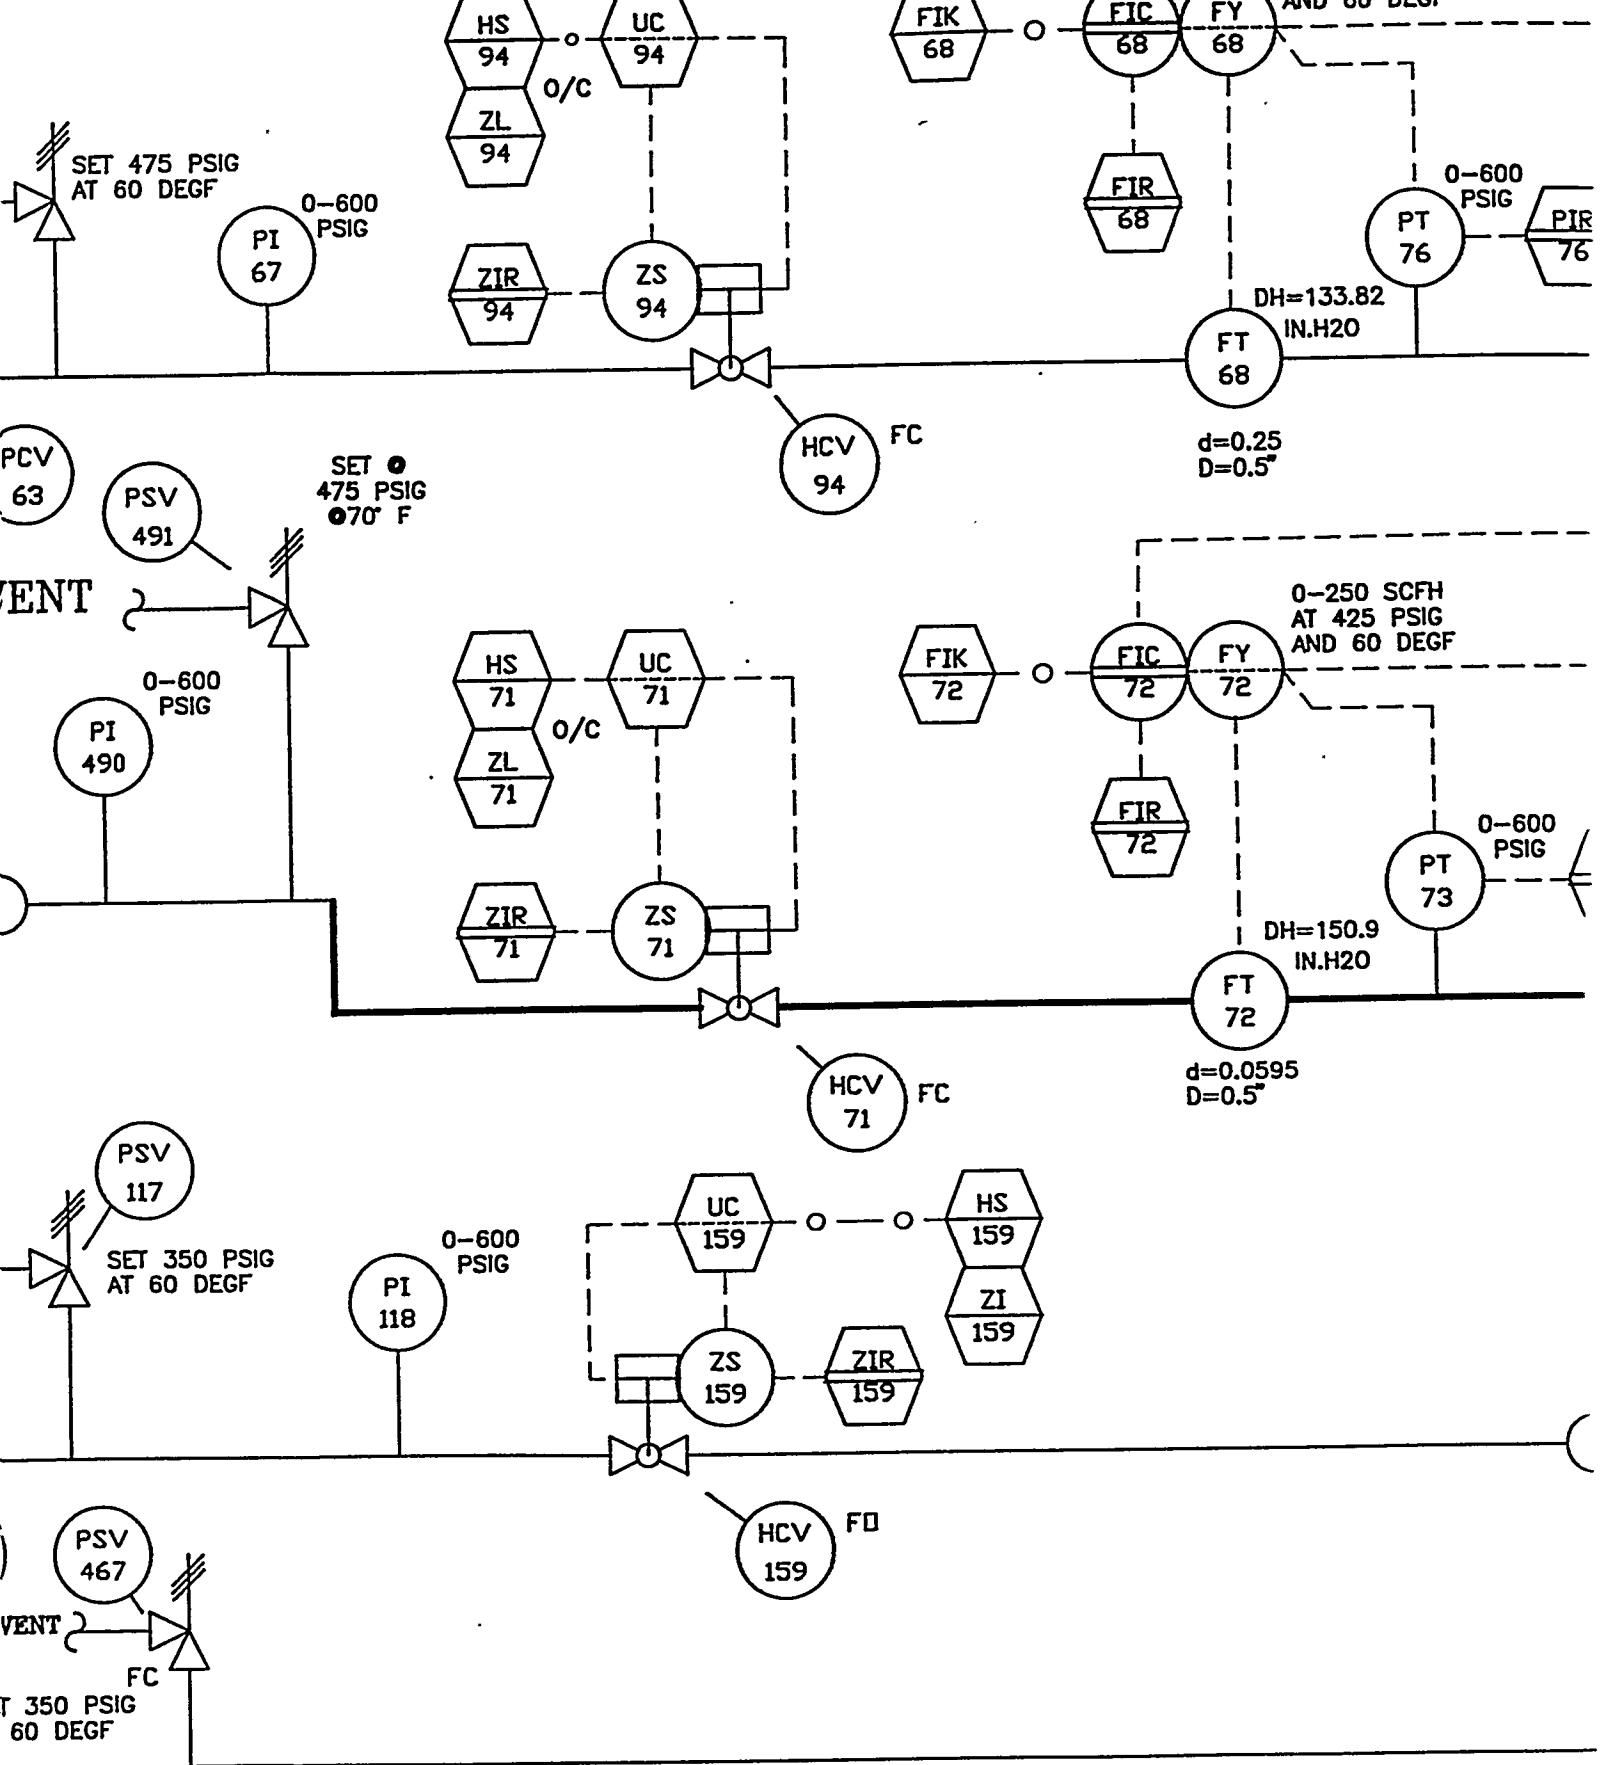


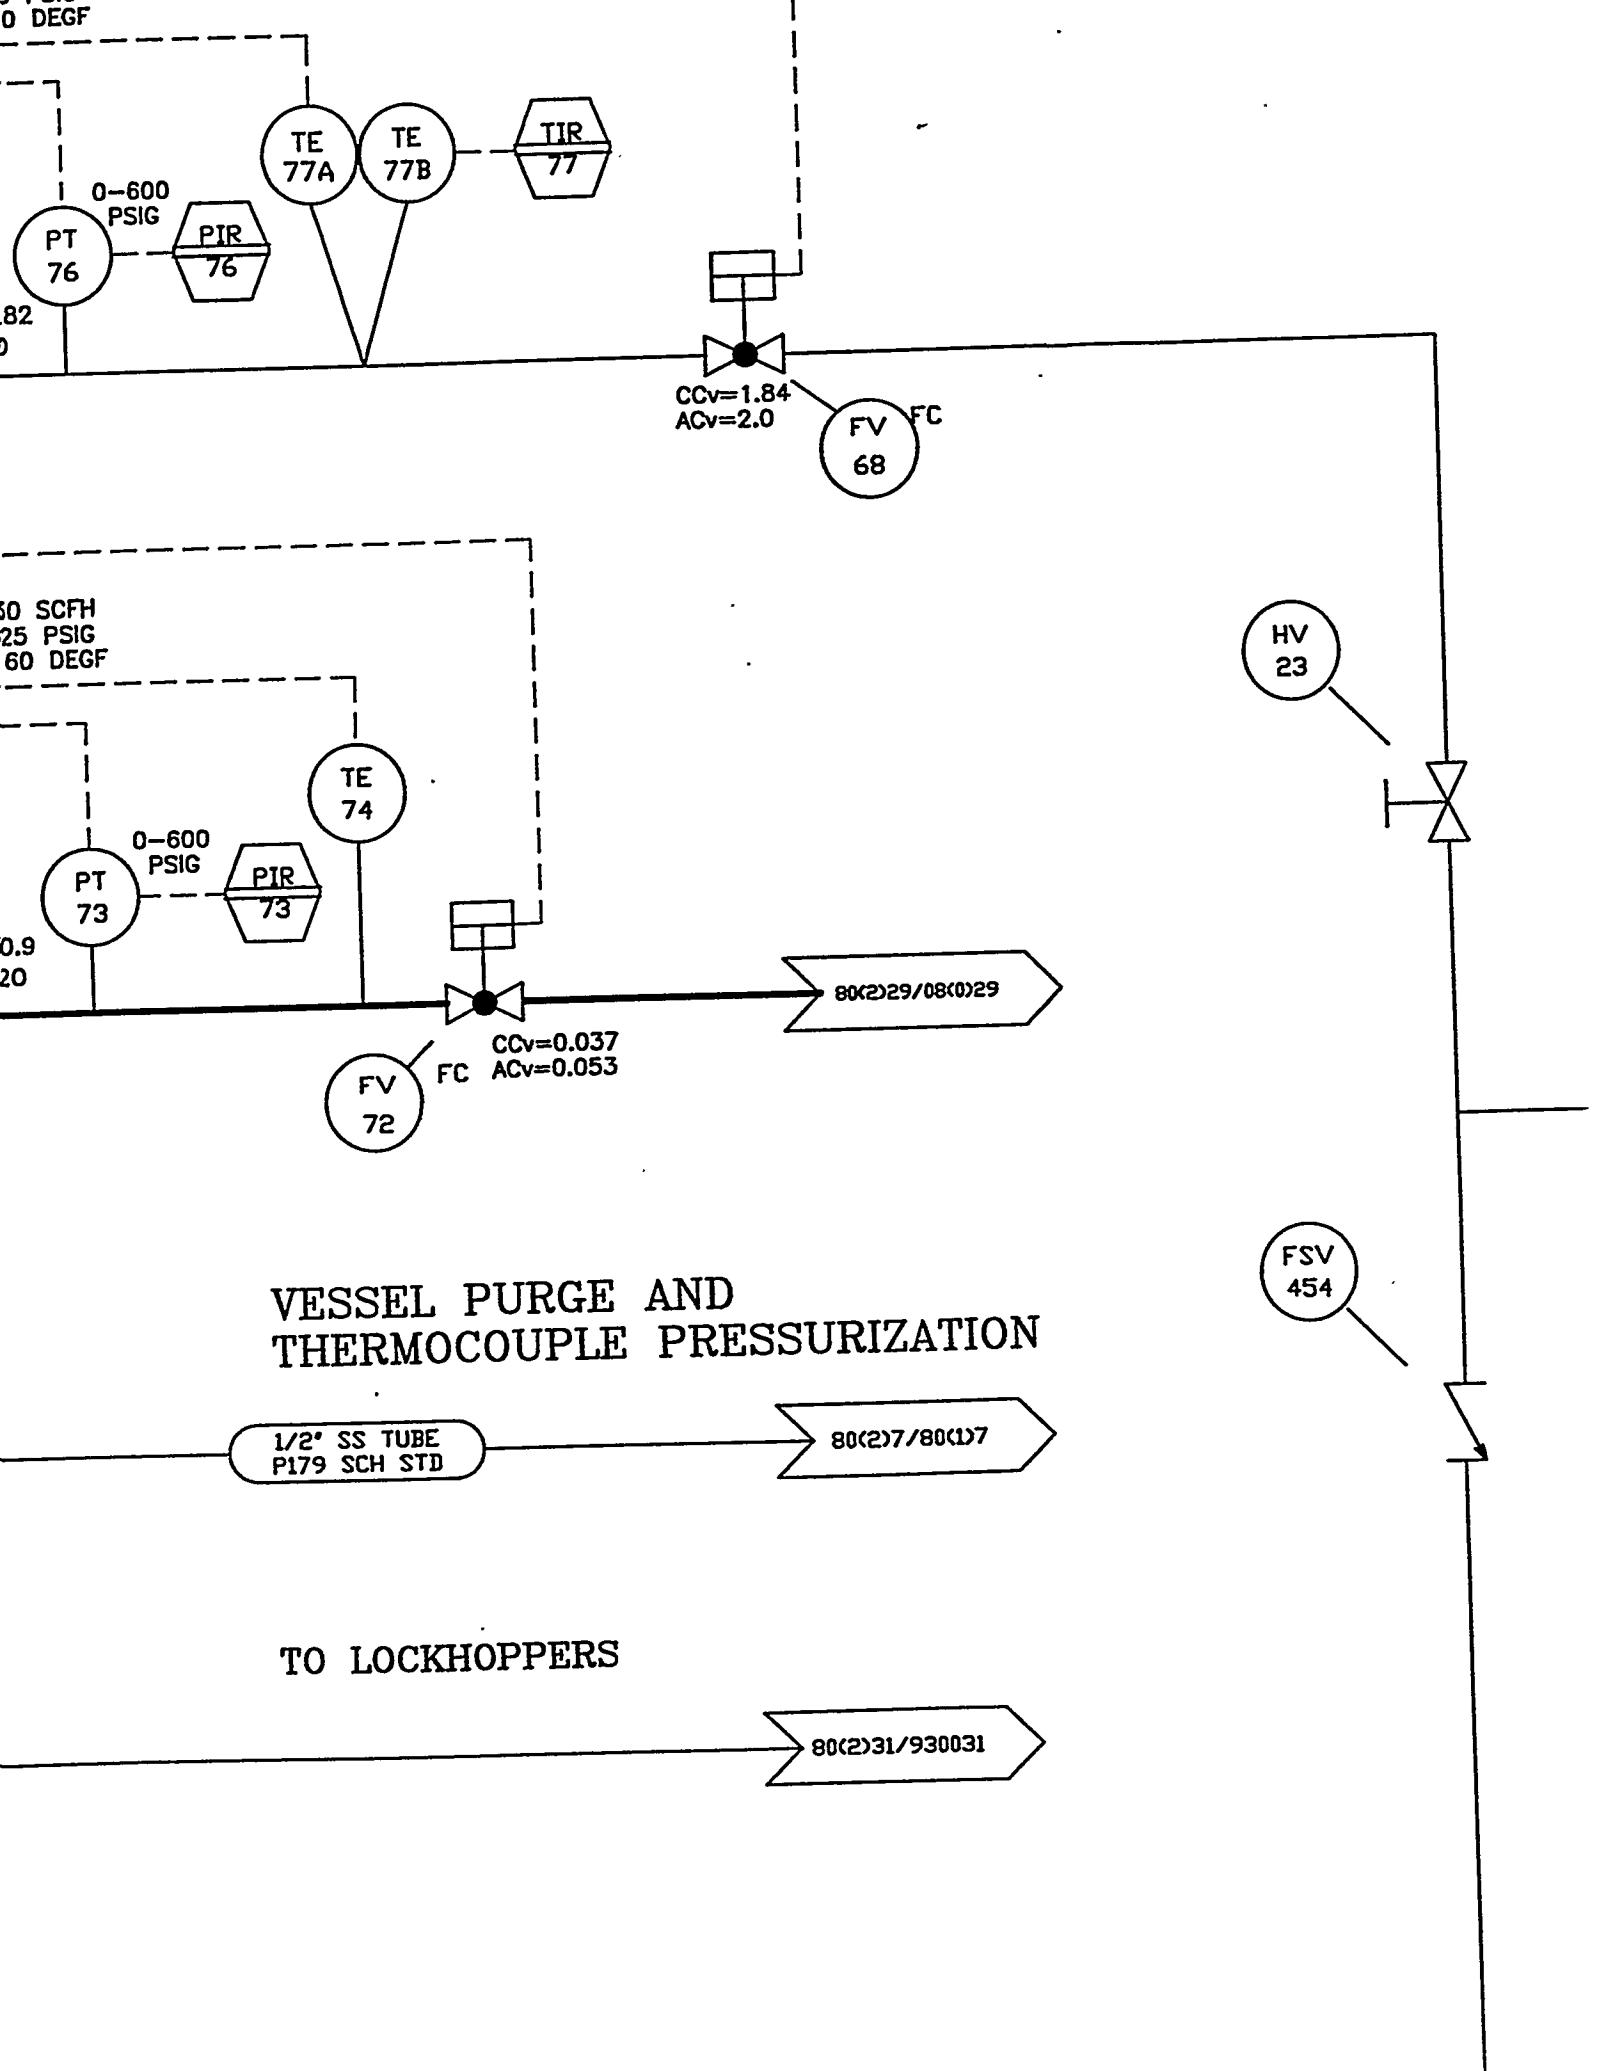

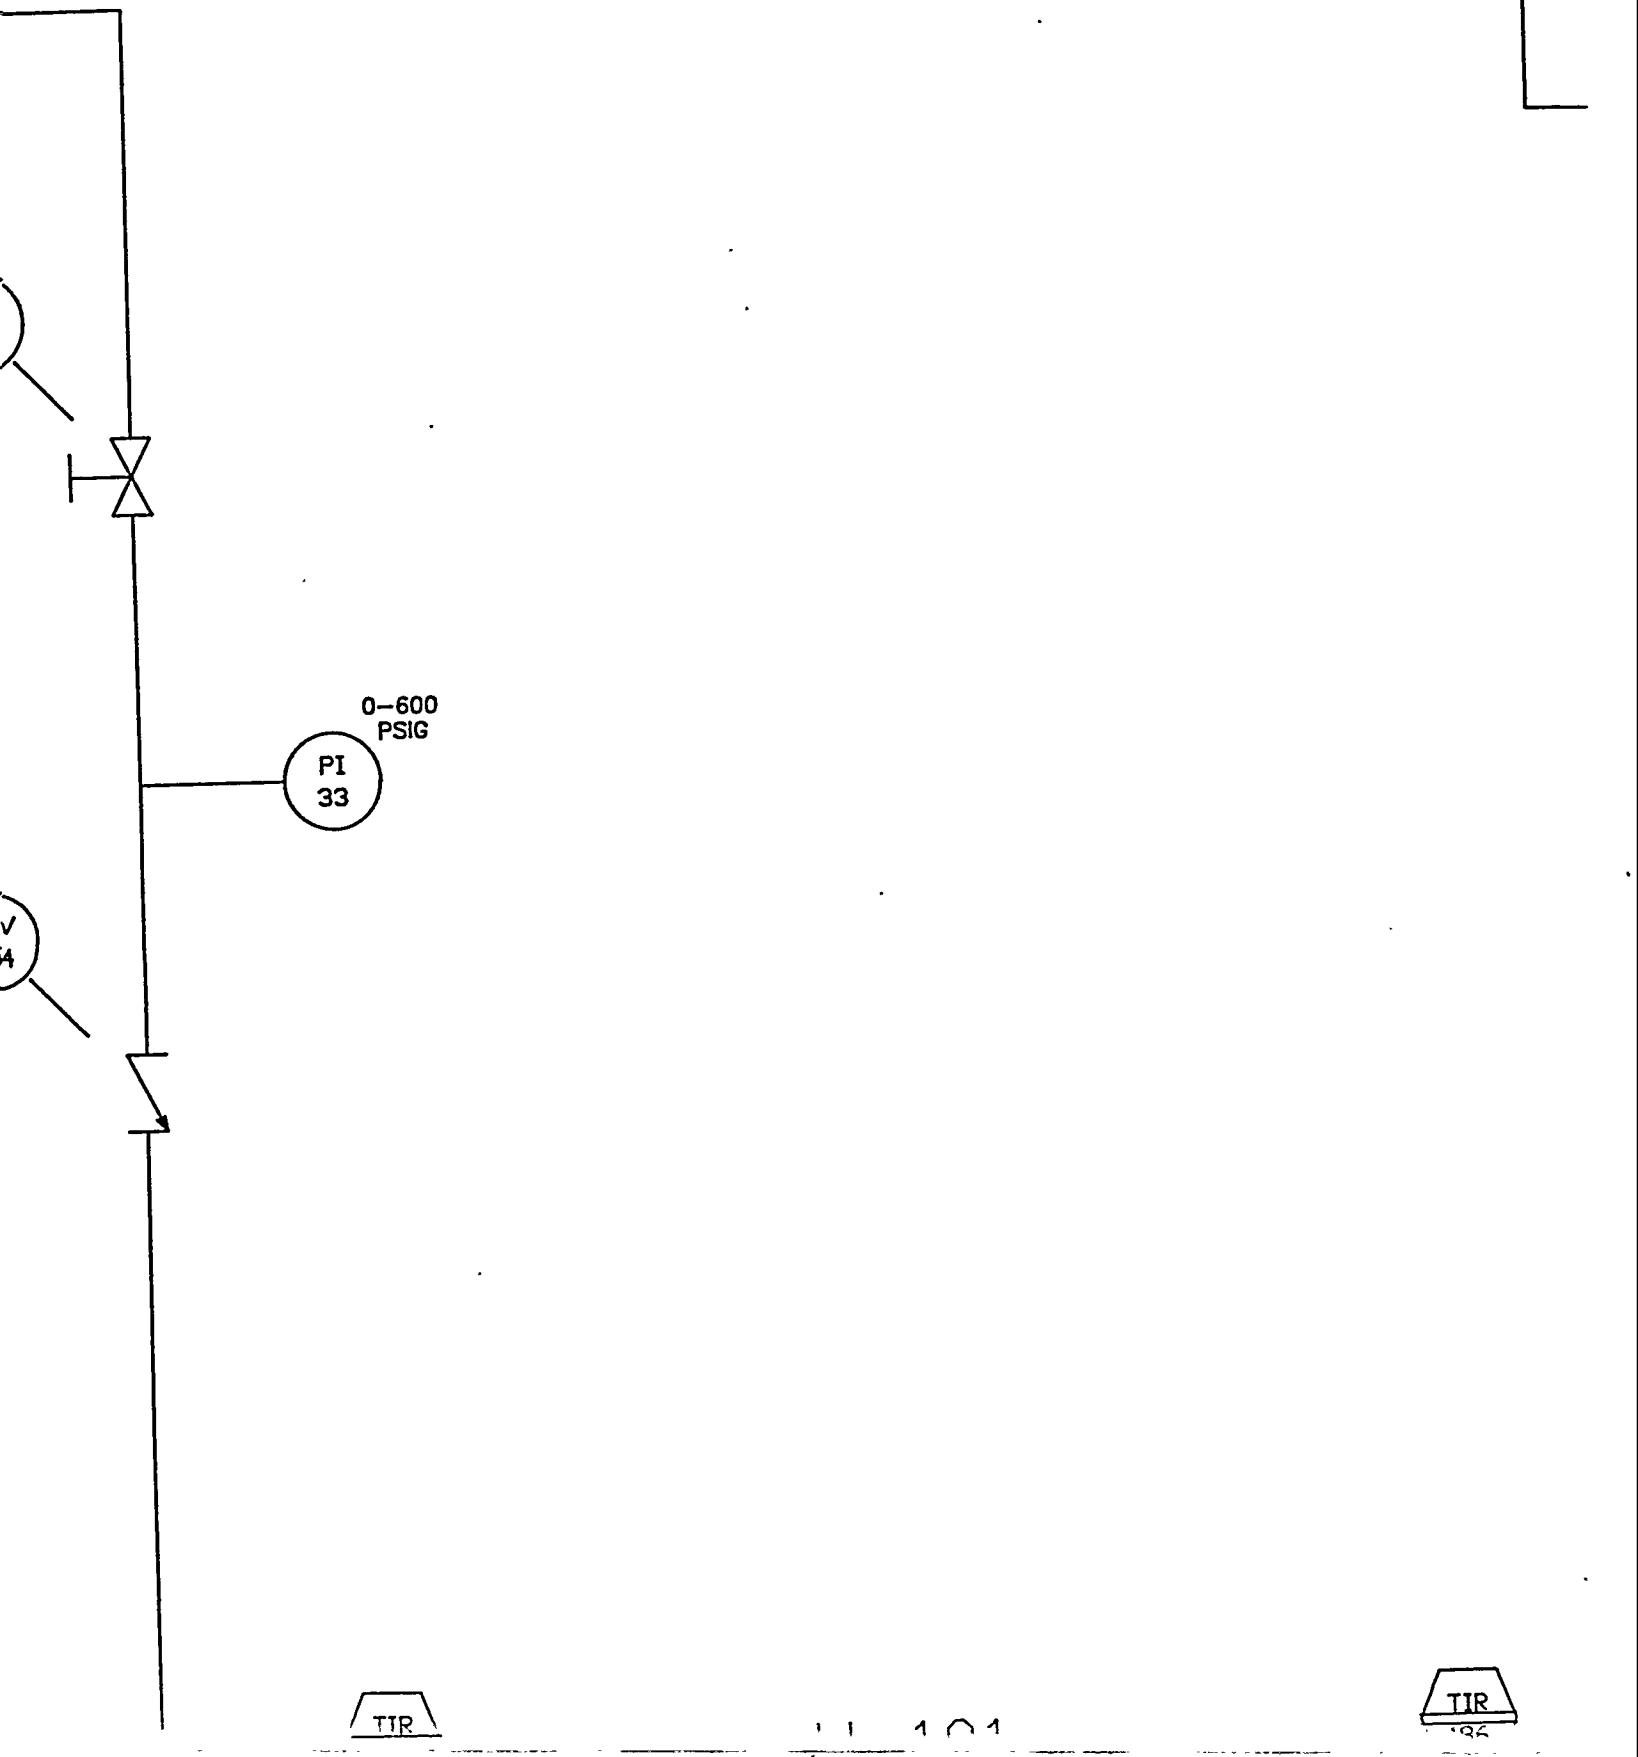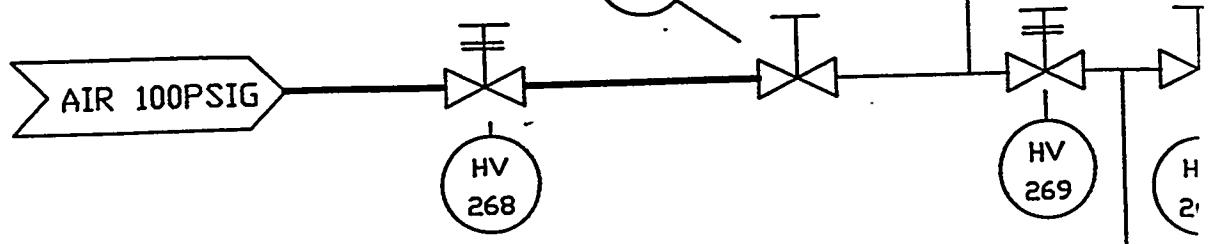

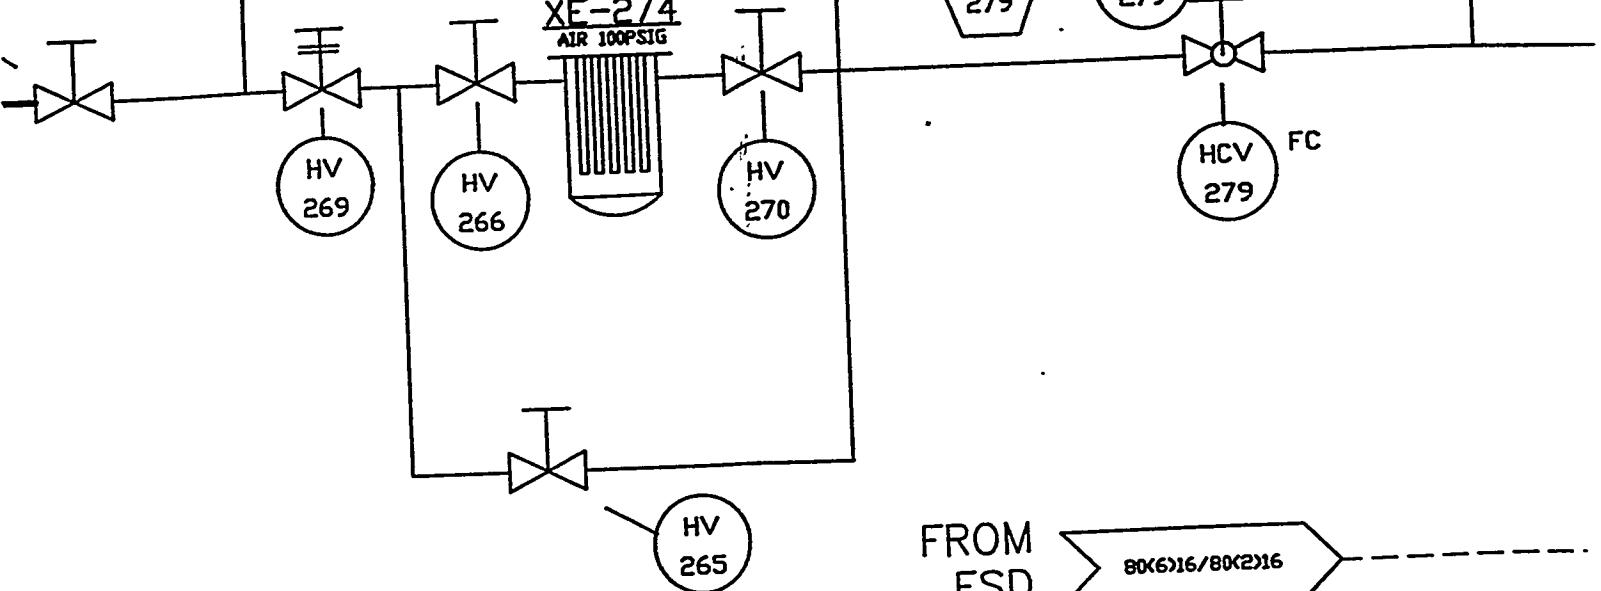


FROM
ESD

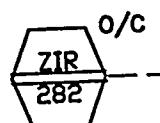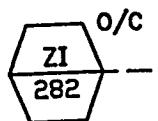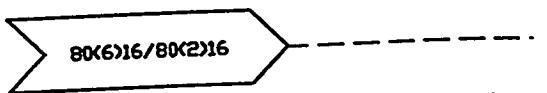

H-100



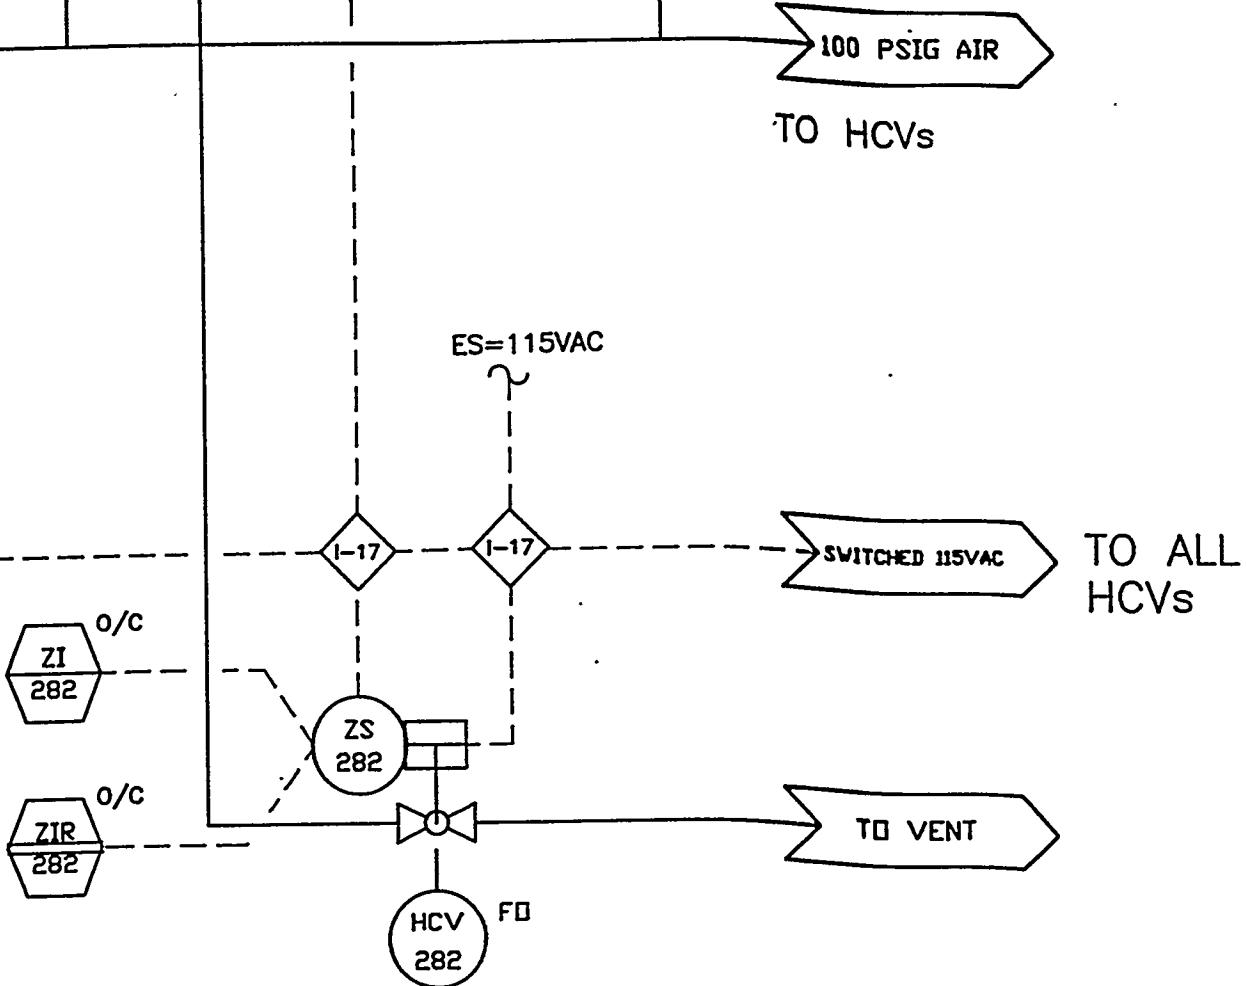

E

D

TIR
187

N2 6

AIR 700 PSIG

HV
125



HV
484

PI
137



FOR USE WITH CONTINOUS MODE


STEAM 350 PSIG

HV
198

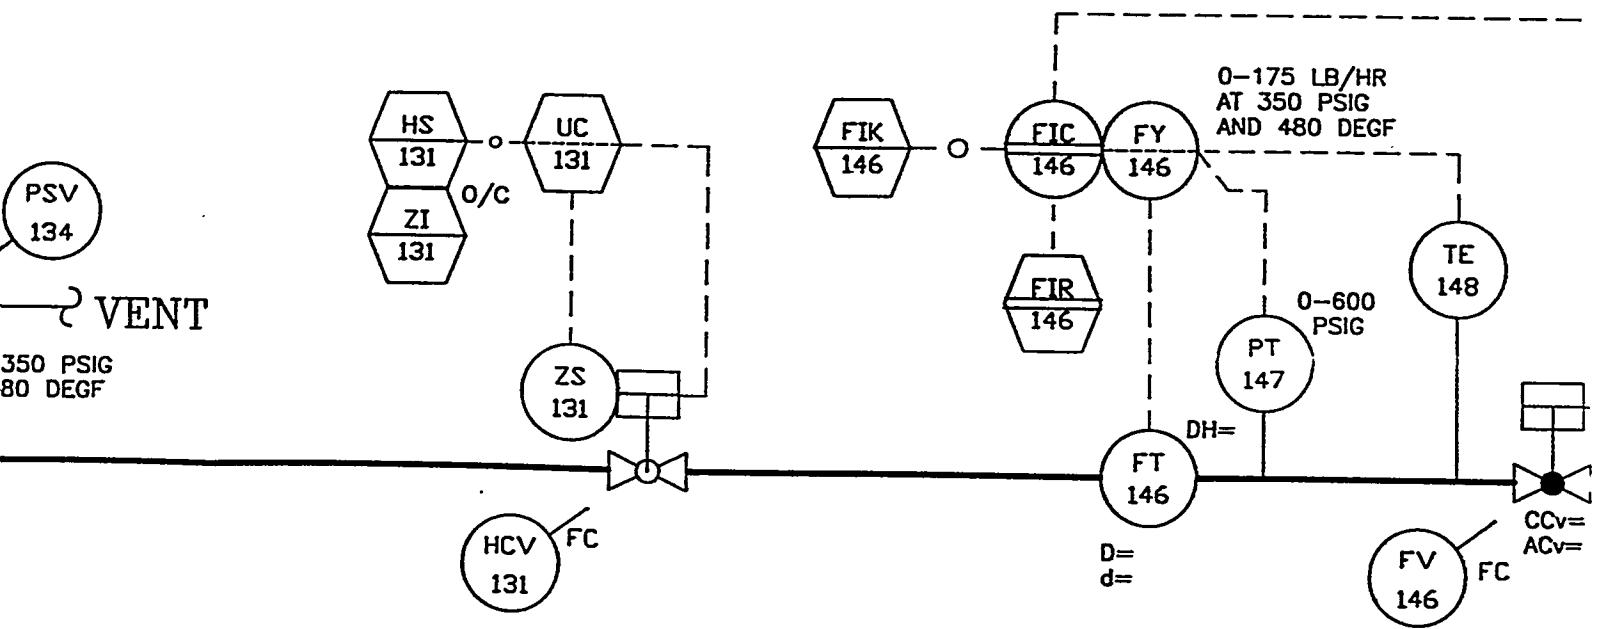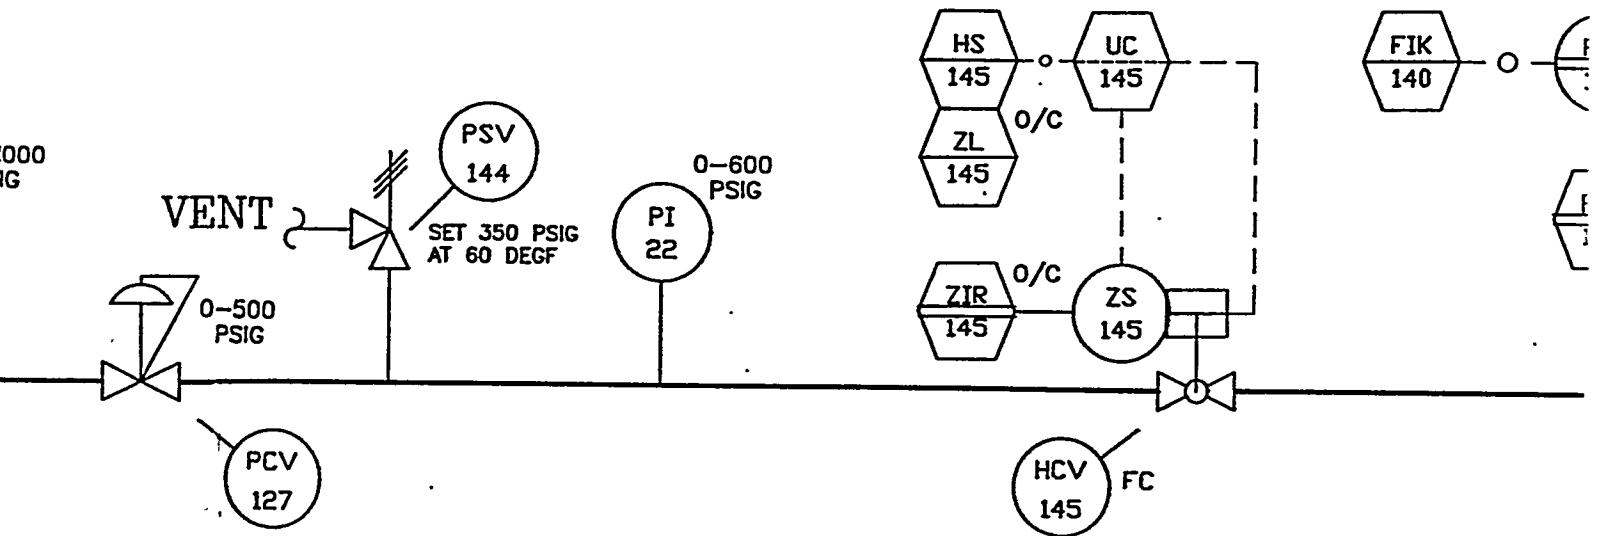


TE
185

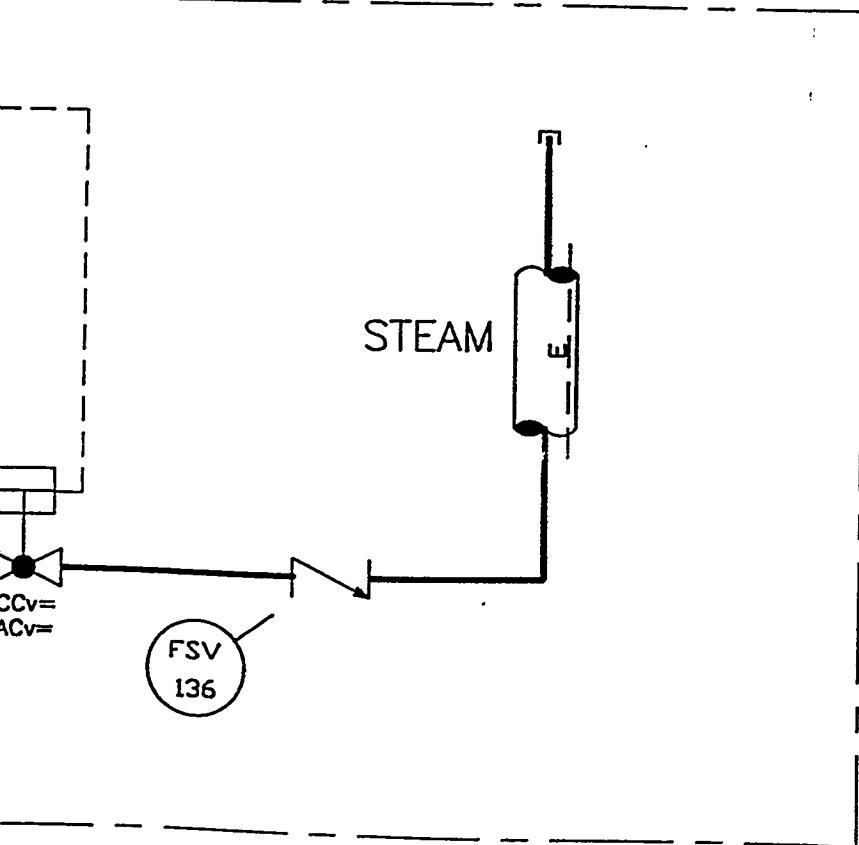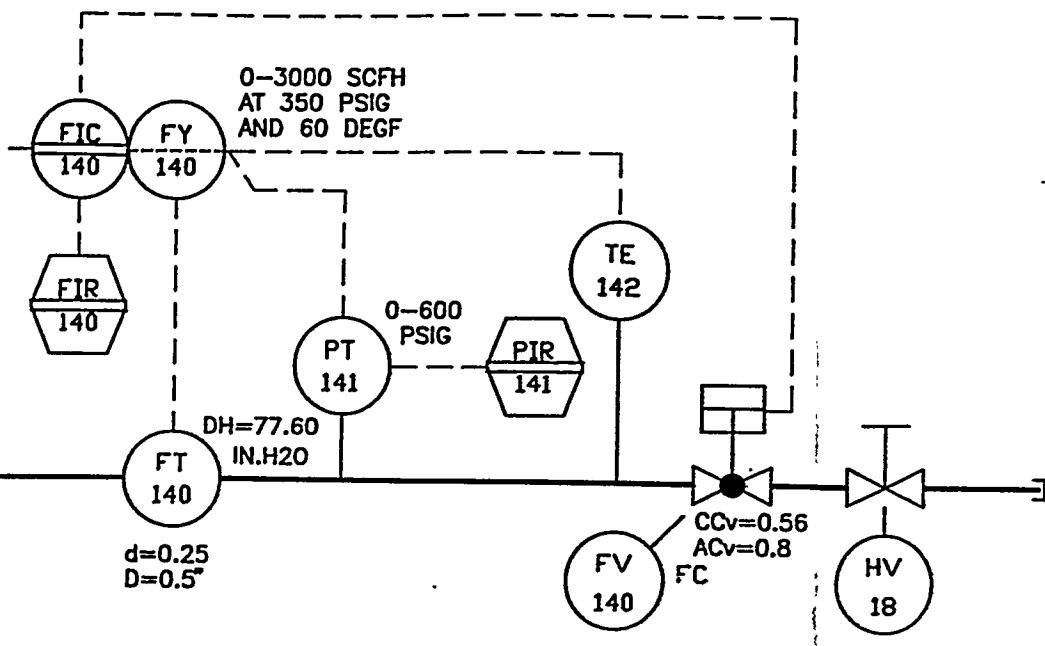

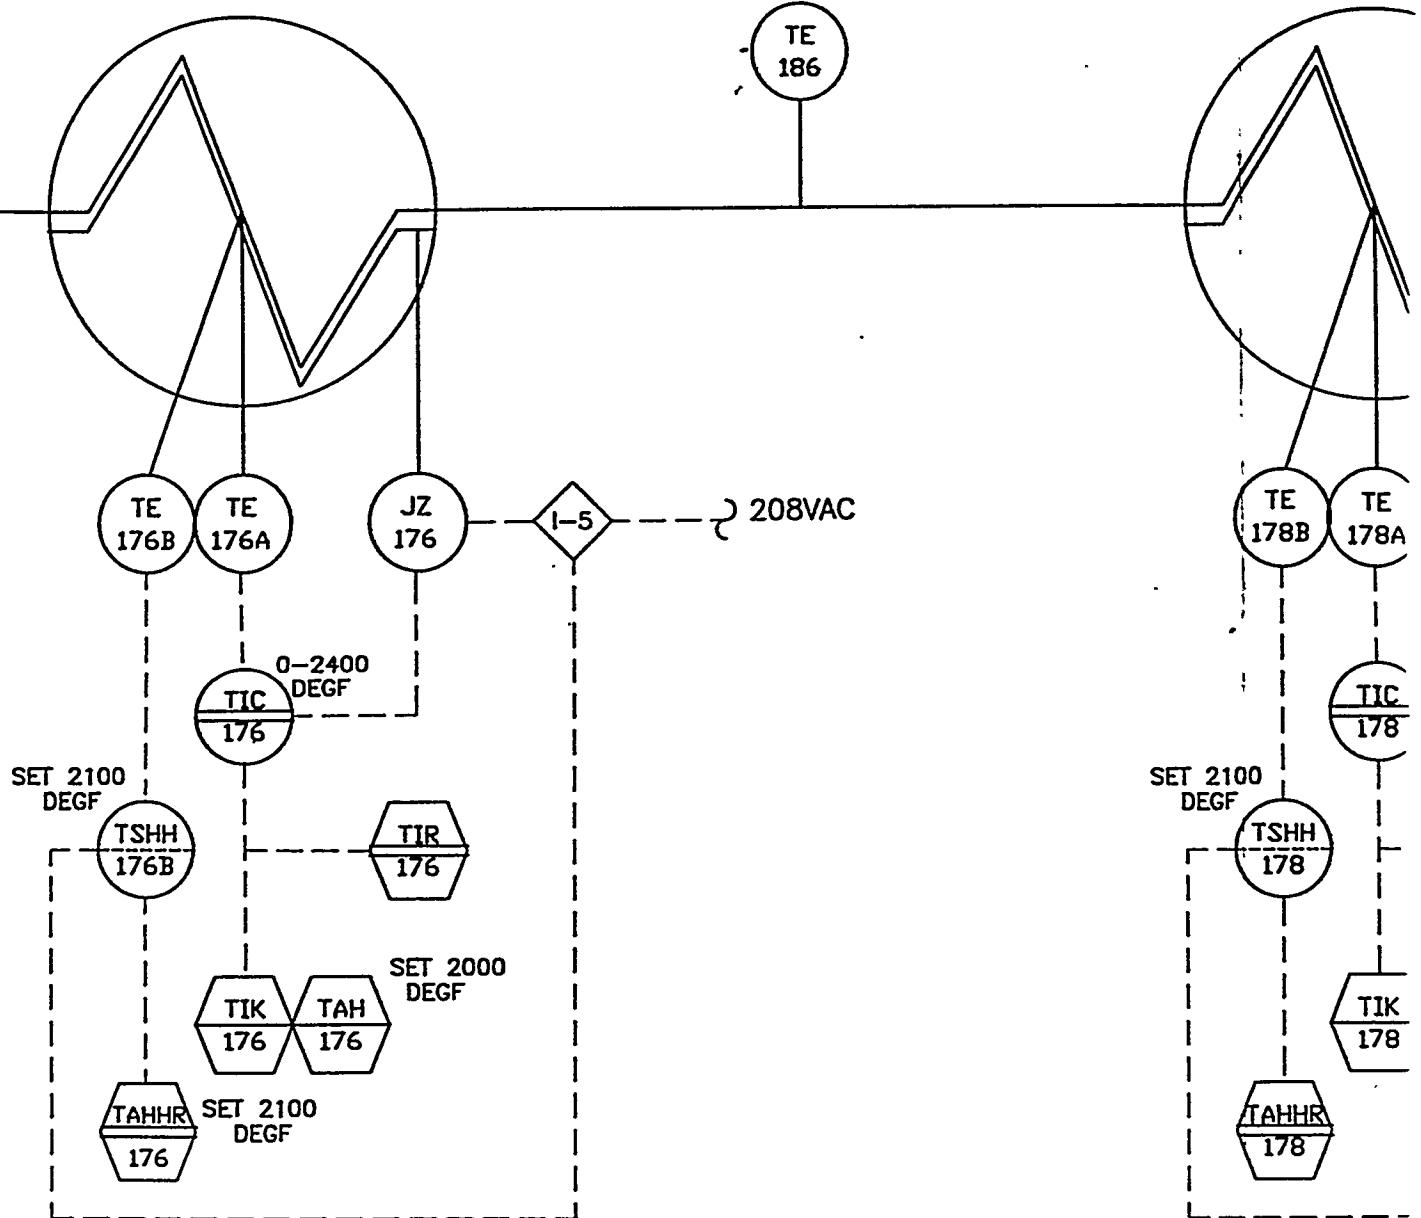

THIS DRAWING IS PART OF THE EG&G DOCUMENT CONTROL SYSTEM

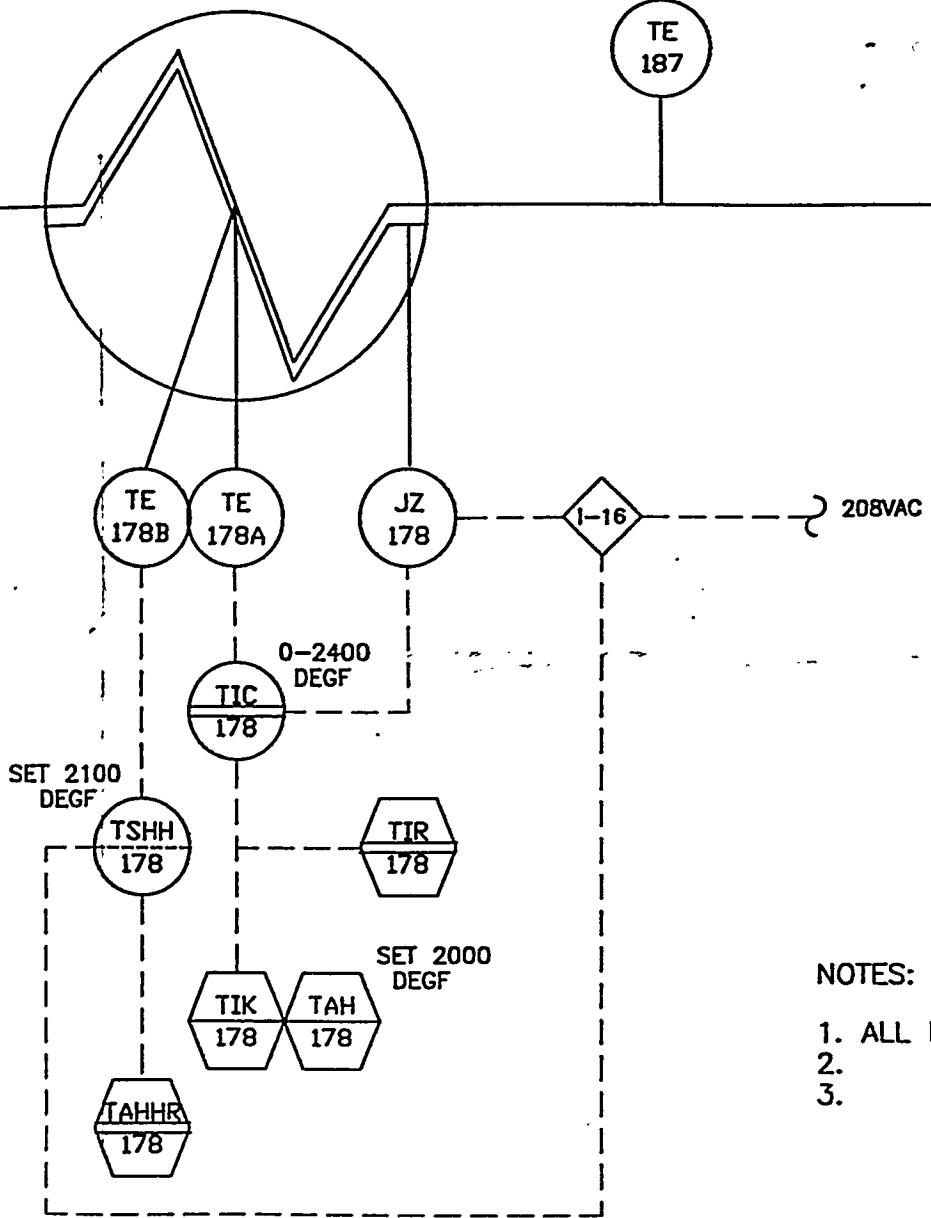

NOTES:

1. ALL IMPULSE LINES 3/8" SS UNLESS OTHERWISE
- 2.
- 3.

REFERENCE DRAWINGS	DRAFTER	DATE	UNITED STATES DEPARTMENT OF ENERGY MORGANTOWNSHIP, WEST VIRGINIA
	Jimmy Thorton	10/28/93	
	PROJECT ENGINEER	DATE	
	John Rockey	11/2/93	
	REQUESTOR	DATE	
	John Rockey	11/2/93	
	BRANCH MANAGER	DATE	TITLE: B-12 ADVANCED MODULAR GAS PROCESS AND DRAWING (P&ID2)
	Larry Strickland	11/2/93	
	ESTH	DATE	
	DOE	DATE	
	WJA John Rotunda	10/28/93	
	DATE	DATE	SIZE FSCM NO DVG NO
			E S

TE
187

80(2)6/80(3)6

N2 PREHEAT AND
FLUIDIZING

208VAC

NOTES:

1. ALL IMPULSE LINES 3/8" SS UNLESS OTHERWISE NOTED
- 2.
- 3.

C

Dwg No

STD920080.07

S

A

DRAFTER	Jimmy Thorton	DATE	10/28/93
PROJECT ENGINEER	John Rockey	DATE	11/2/93
REQUESTOR	John Rockey	DATE	11/2/93
BRANCH MANAGER	Larry Strickland	DATE	11/2/93
ESB		DATE	
DOE	WJA	DATE	10/28/93
		DATE	




United States Department of Energy
MORGANTOWN ENERGY TECHNOLOGY CENTER
Morgantown, WV

B-12 ADVANCED GASIFICATION FACILITY
MODULAR GAS CLEANUP RIG (MGCR)
PROCESS AND INSTRUMENTATION
DRAWING (P&ID2) FACILITY SERVICES


SIZE	FSCH NO
E	

STD920080.07

REV
7

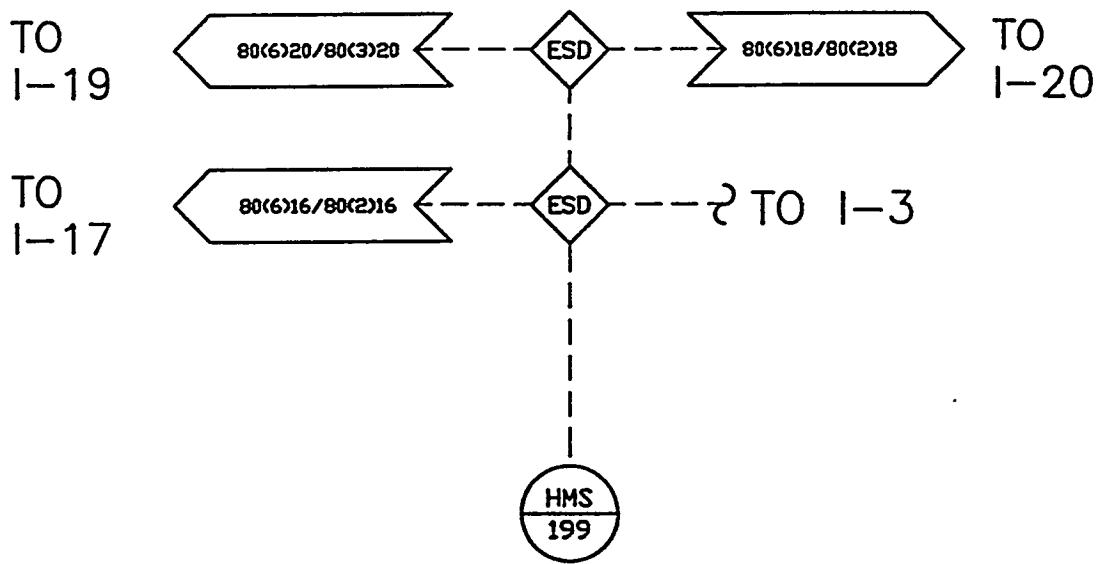

TO BE ADDED FOR CONTINUOUS MODE

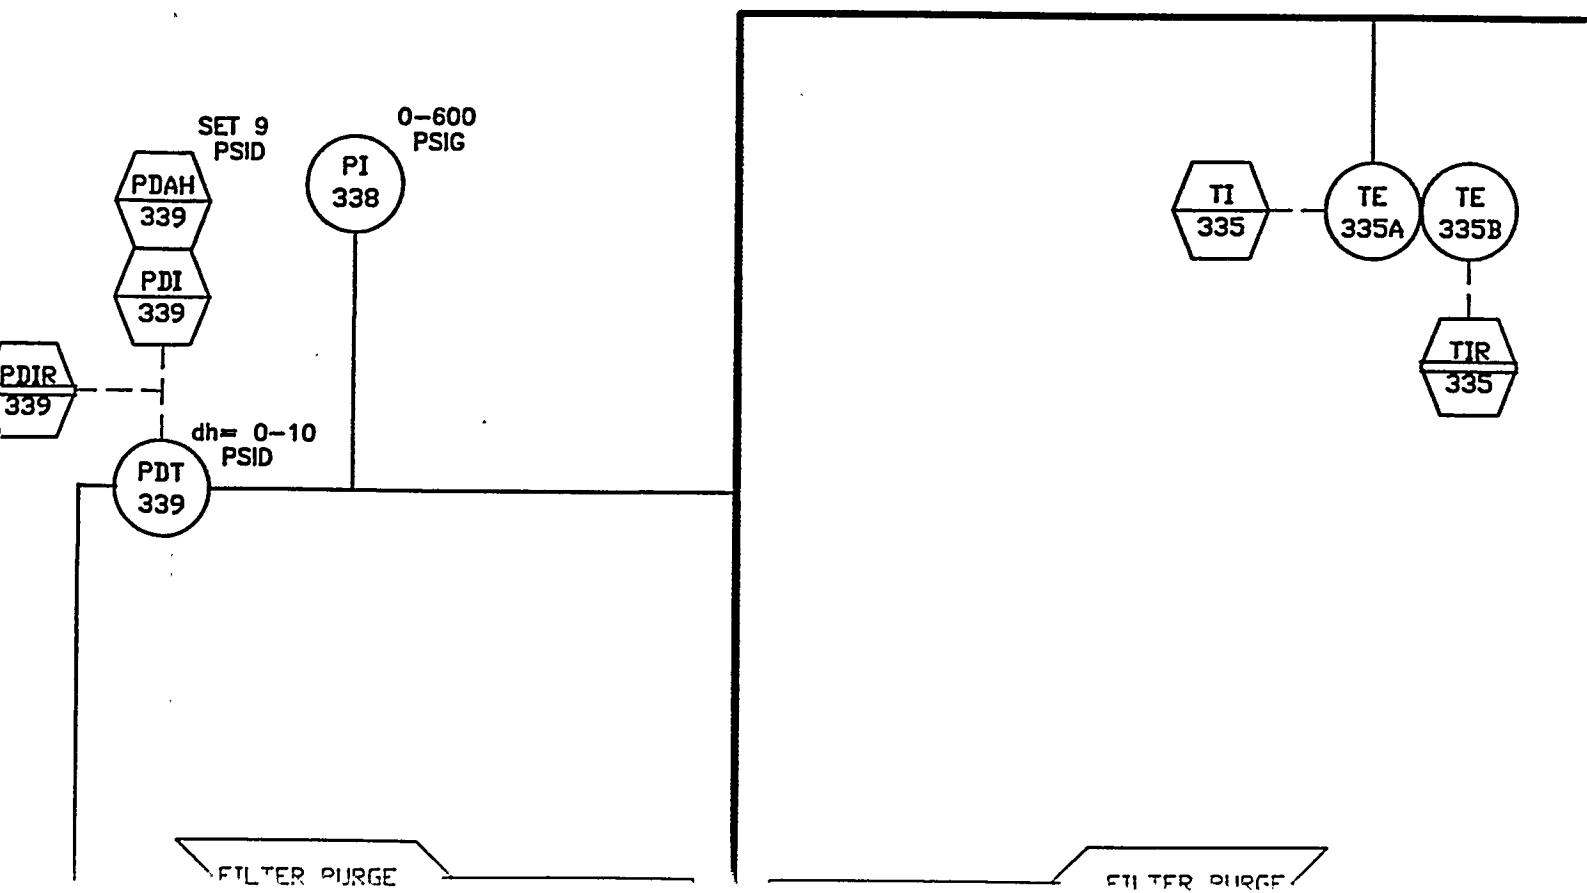

3/4" CS PIPE
P48 SCH 40

1/2" SS TUBE
P12 SCH STD

TI
192


TE
192A

TE
192B

TIR
192


ZONE	REV	
GEN.	6	1
DRAFTER		
GARY J. KULCHI		
EGG ESH		
W.E. LOWRY		
ZONE	REV	
GEN.	7	
DRAFTER		
GARY J. KULCHI		
EGG ESH 008		
Mattarollo		

FROM GAS
SAMPLING
SYSTEM

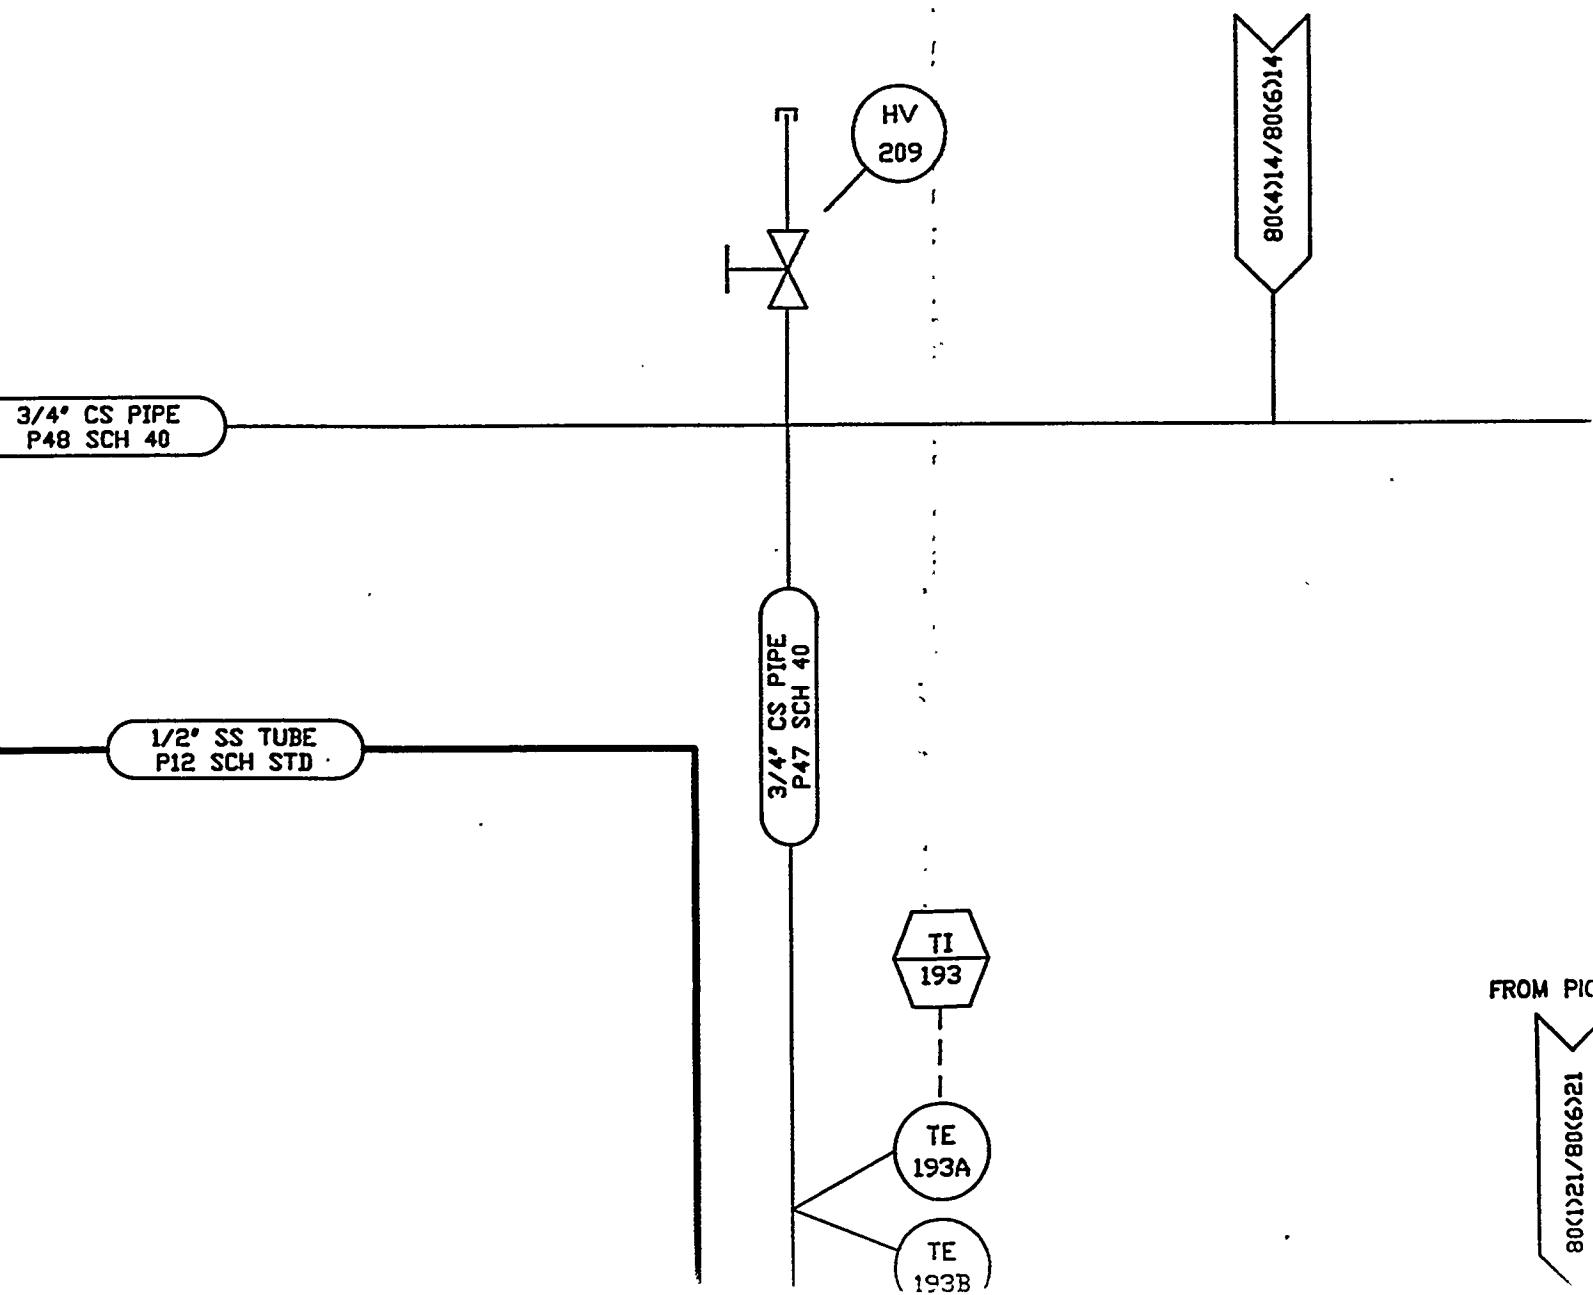

REVISION

ONE	REV	DESCRIPTION						DATE
EN.	6	MODIFIED AS PER MARKED PRINT; ISSUED FOR CONSTRUCTION						5/16/94
CHIEF DESIGNER		DATE 5/18/94	CHECKER S. CONKO	DATE 5/18/94	EG&G RESPONSIBLE ENGR. DAVID LUNIFELD	DATE 5/24/94	REVIEWER GARY J. KULCHOCK	DATE 5/18/94
ESHH		DATE 5/24/94	PROJECT ENGR. S. RENNIGER	DATE 5/18/94	BRANCH MANAGER JOHN M. ROCKEY	DATE 5/18/94	DOE (ECDSD) WJA	DATE 5/18/94
LOWRY		MODIFIED AS PER MARKED PRINT; ISSUED FOR CONSTRUCTION						9/30/94
CHIEF DESIGNER		DATE 10-3-94	CHECKER Gary J. Kulchock	DATE 10/3/94	EG&G RESPONSIBLE ENGR. David Lunifeld	DATE 10/5/94	REVIEWER John M. Rockey	DATE 10/5/94
ESHH		DATE 10/11/94	PROJECT ENGR. Scott Renniger	DATE 10/9/94	BRANCH MANAGER	DATE	DOE (ECDSD) WJA	DATE 10/5/94

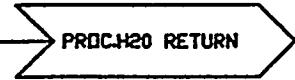

FROM PIC-254



FROM ESD

 
ASHH
323

I-3

H

G

F





SET 340
PSIG

AH
AA

PSH
AAA

I-19

XX>XXX/801XX

FILTER PURGE

INCIN.

SET 350 PSIG
AT 70 DEGF
AND 23760 SCFH


PSV
BBB


HV
202


0-2
PSI

PT
204

PIR
204

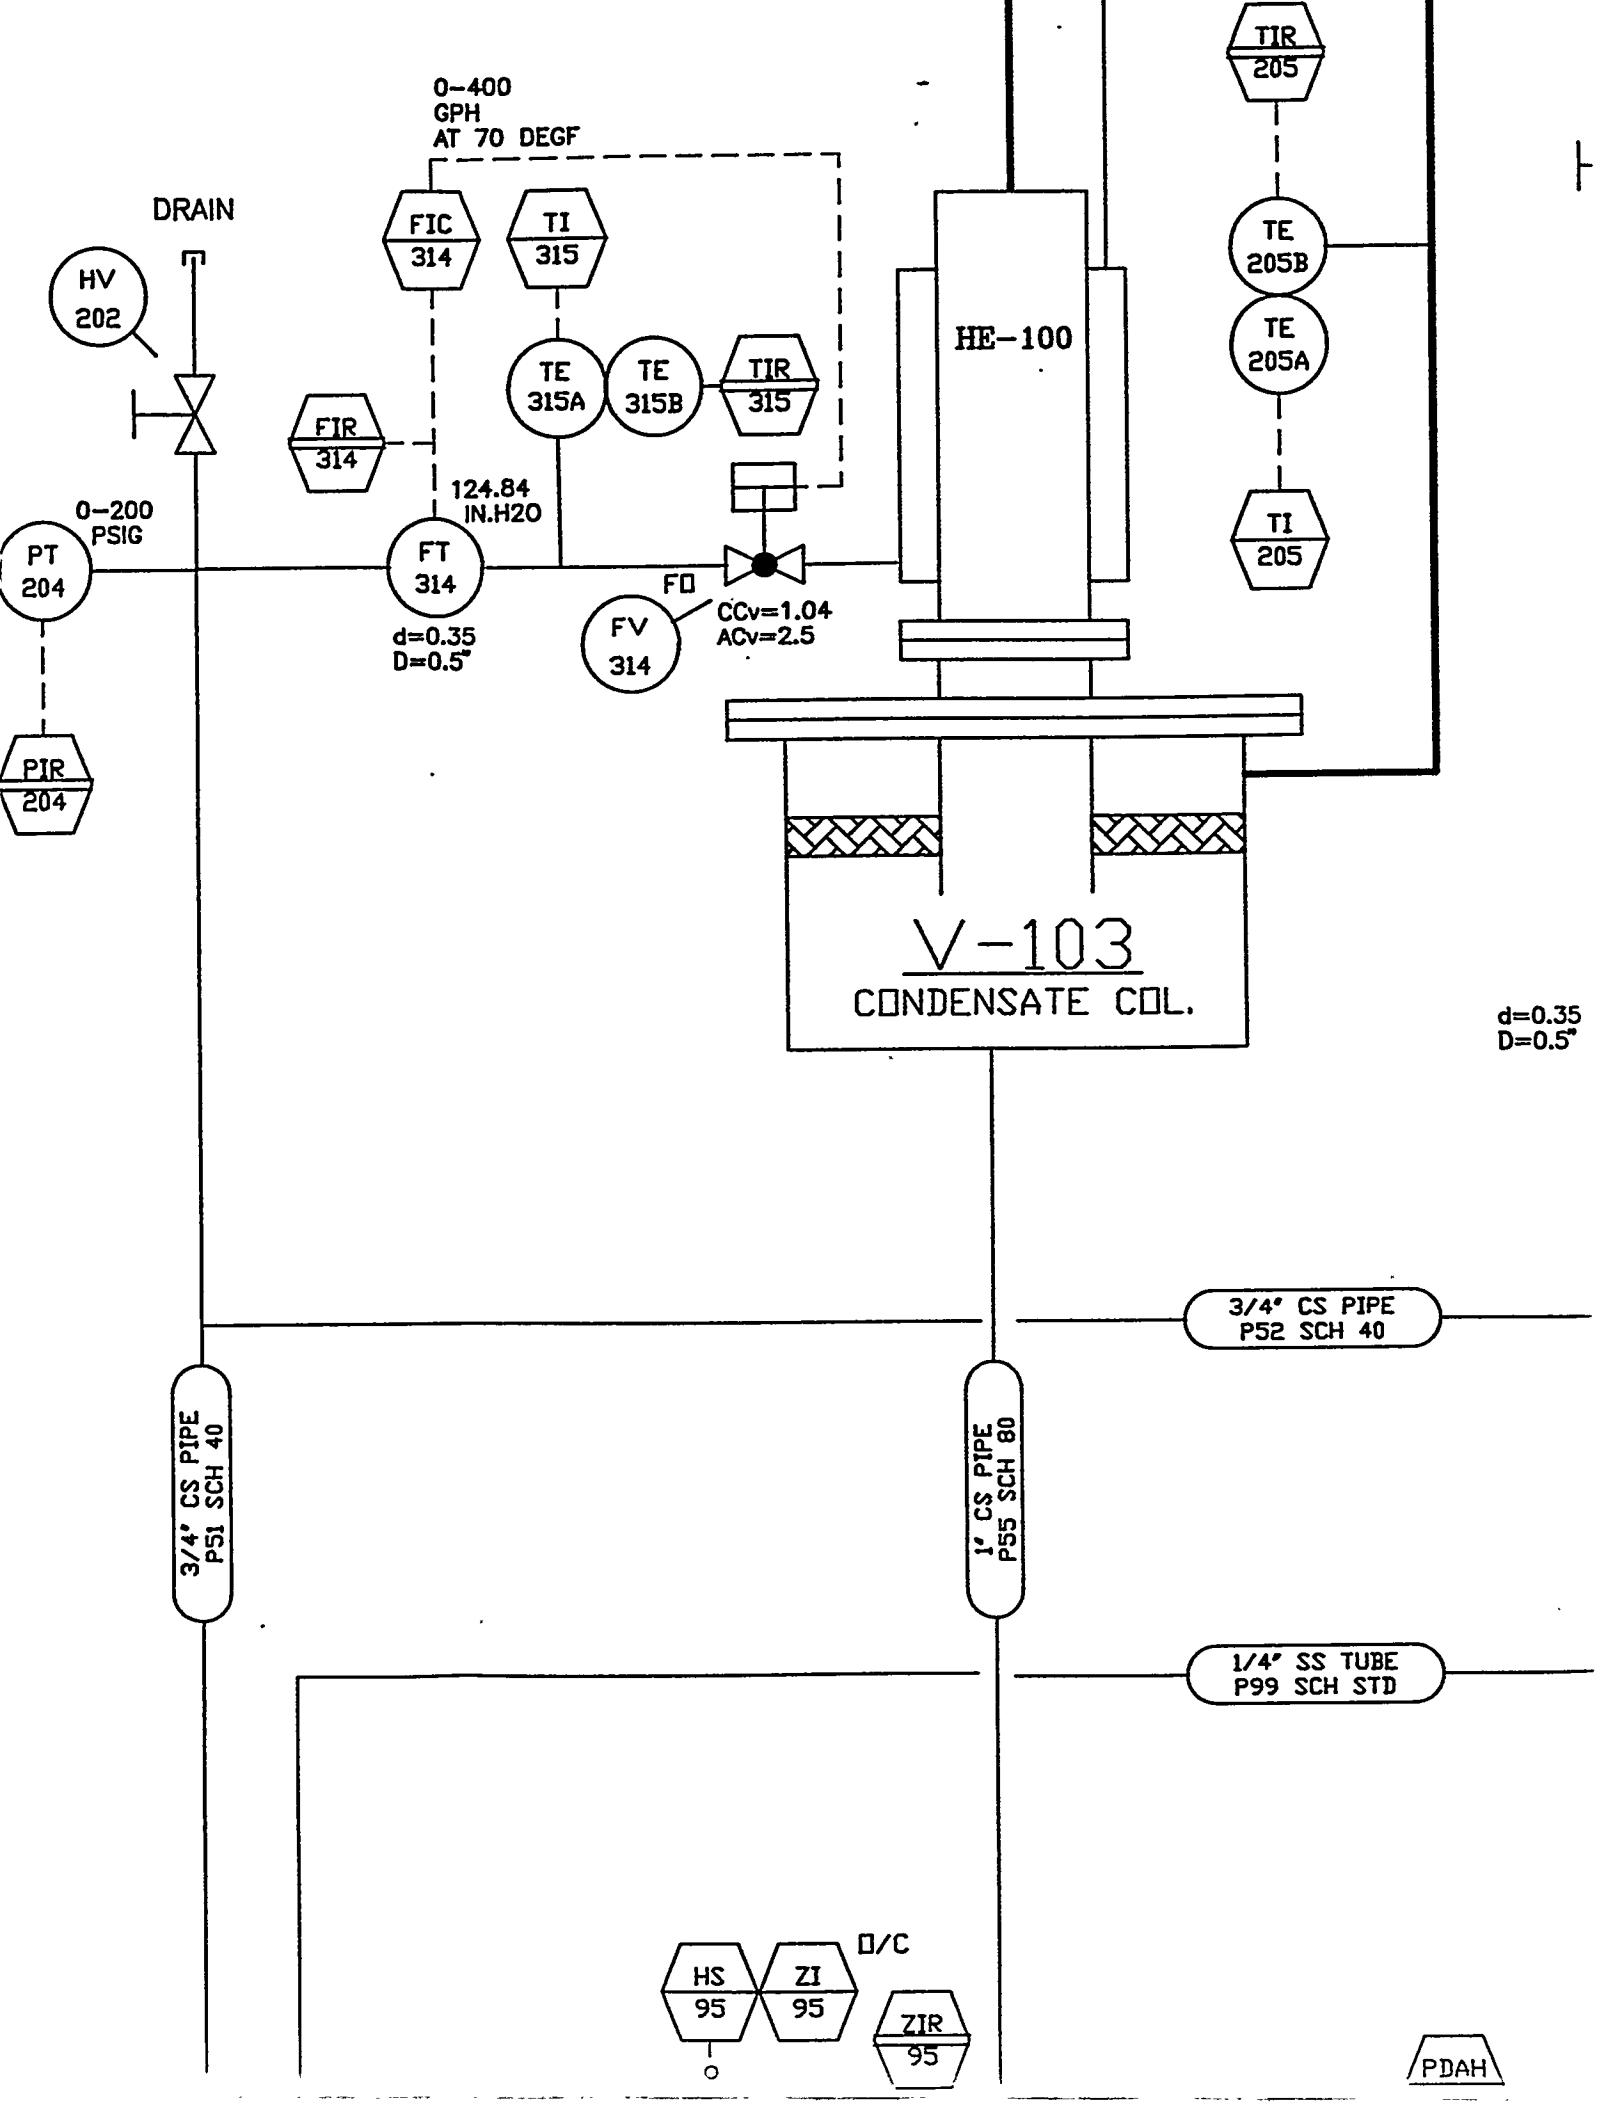

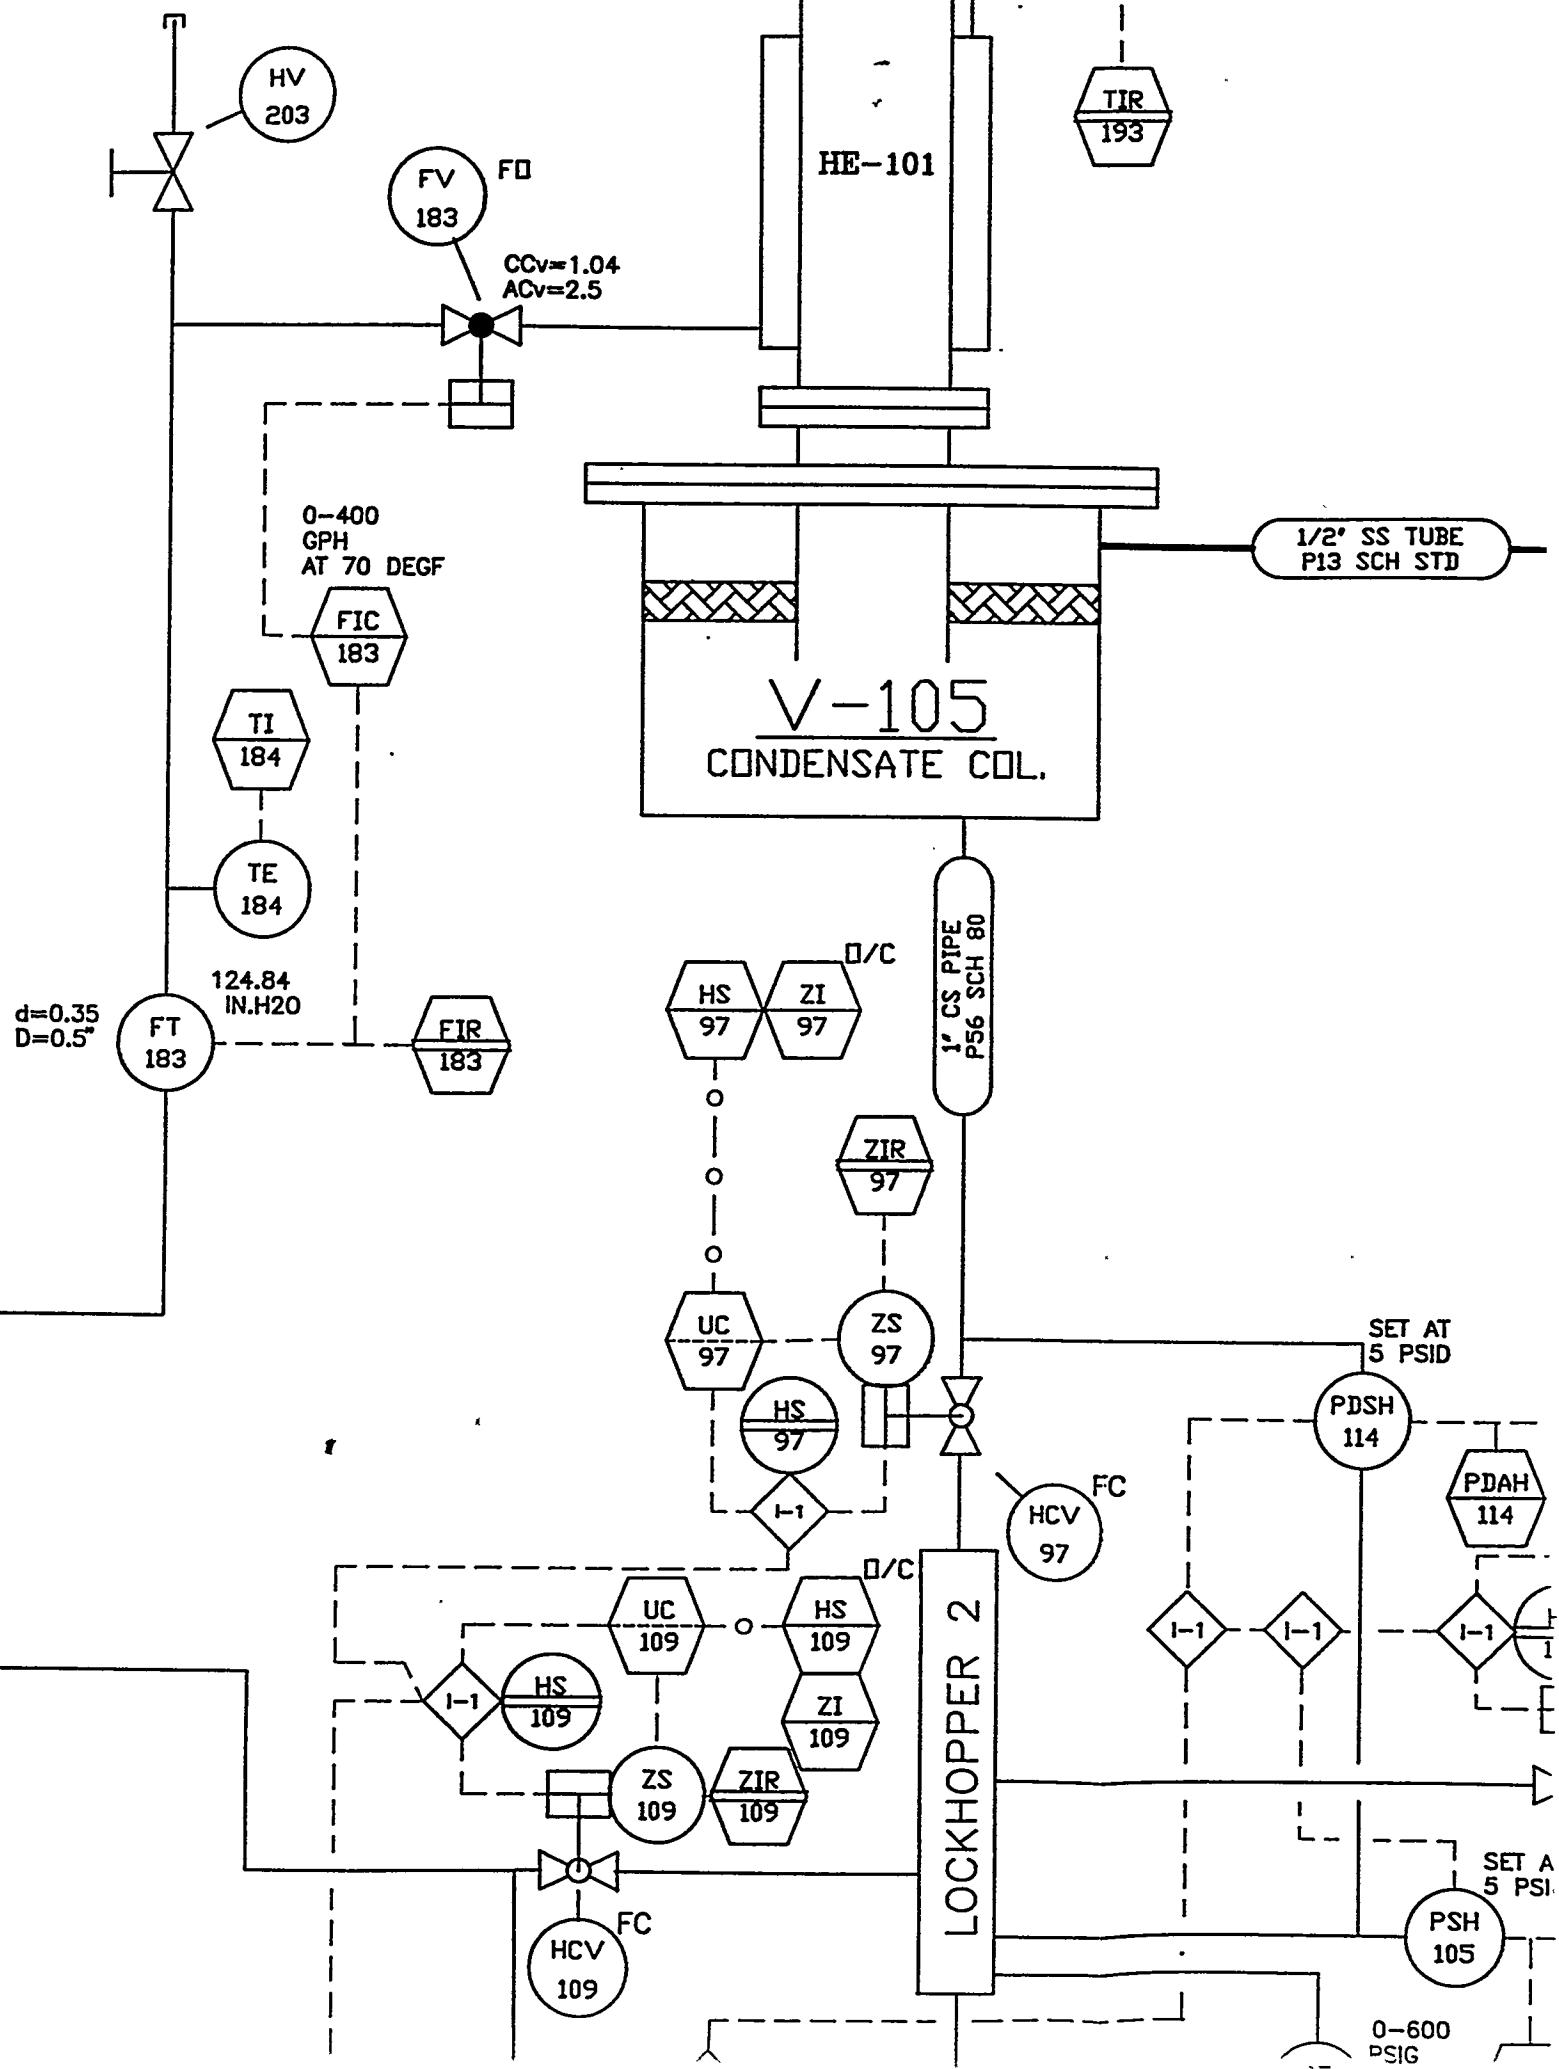


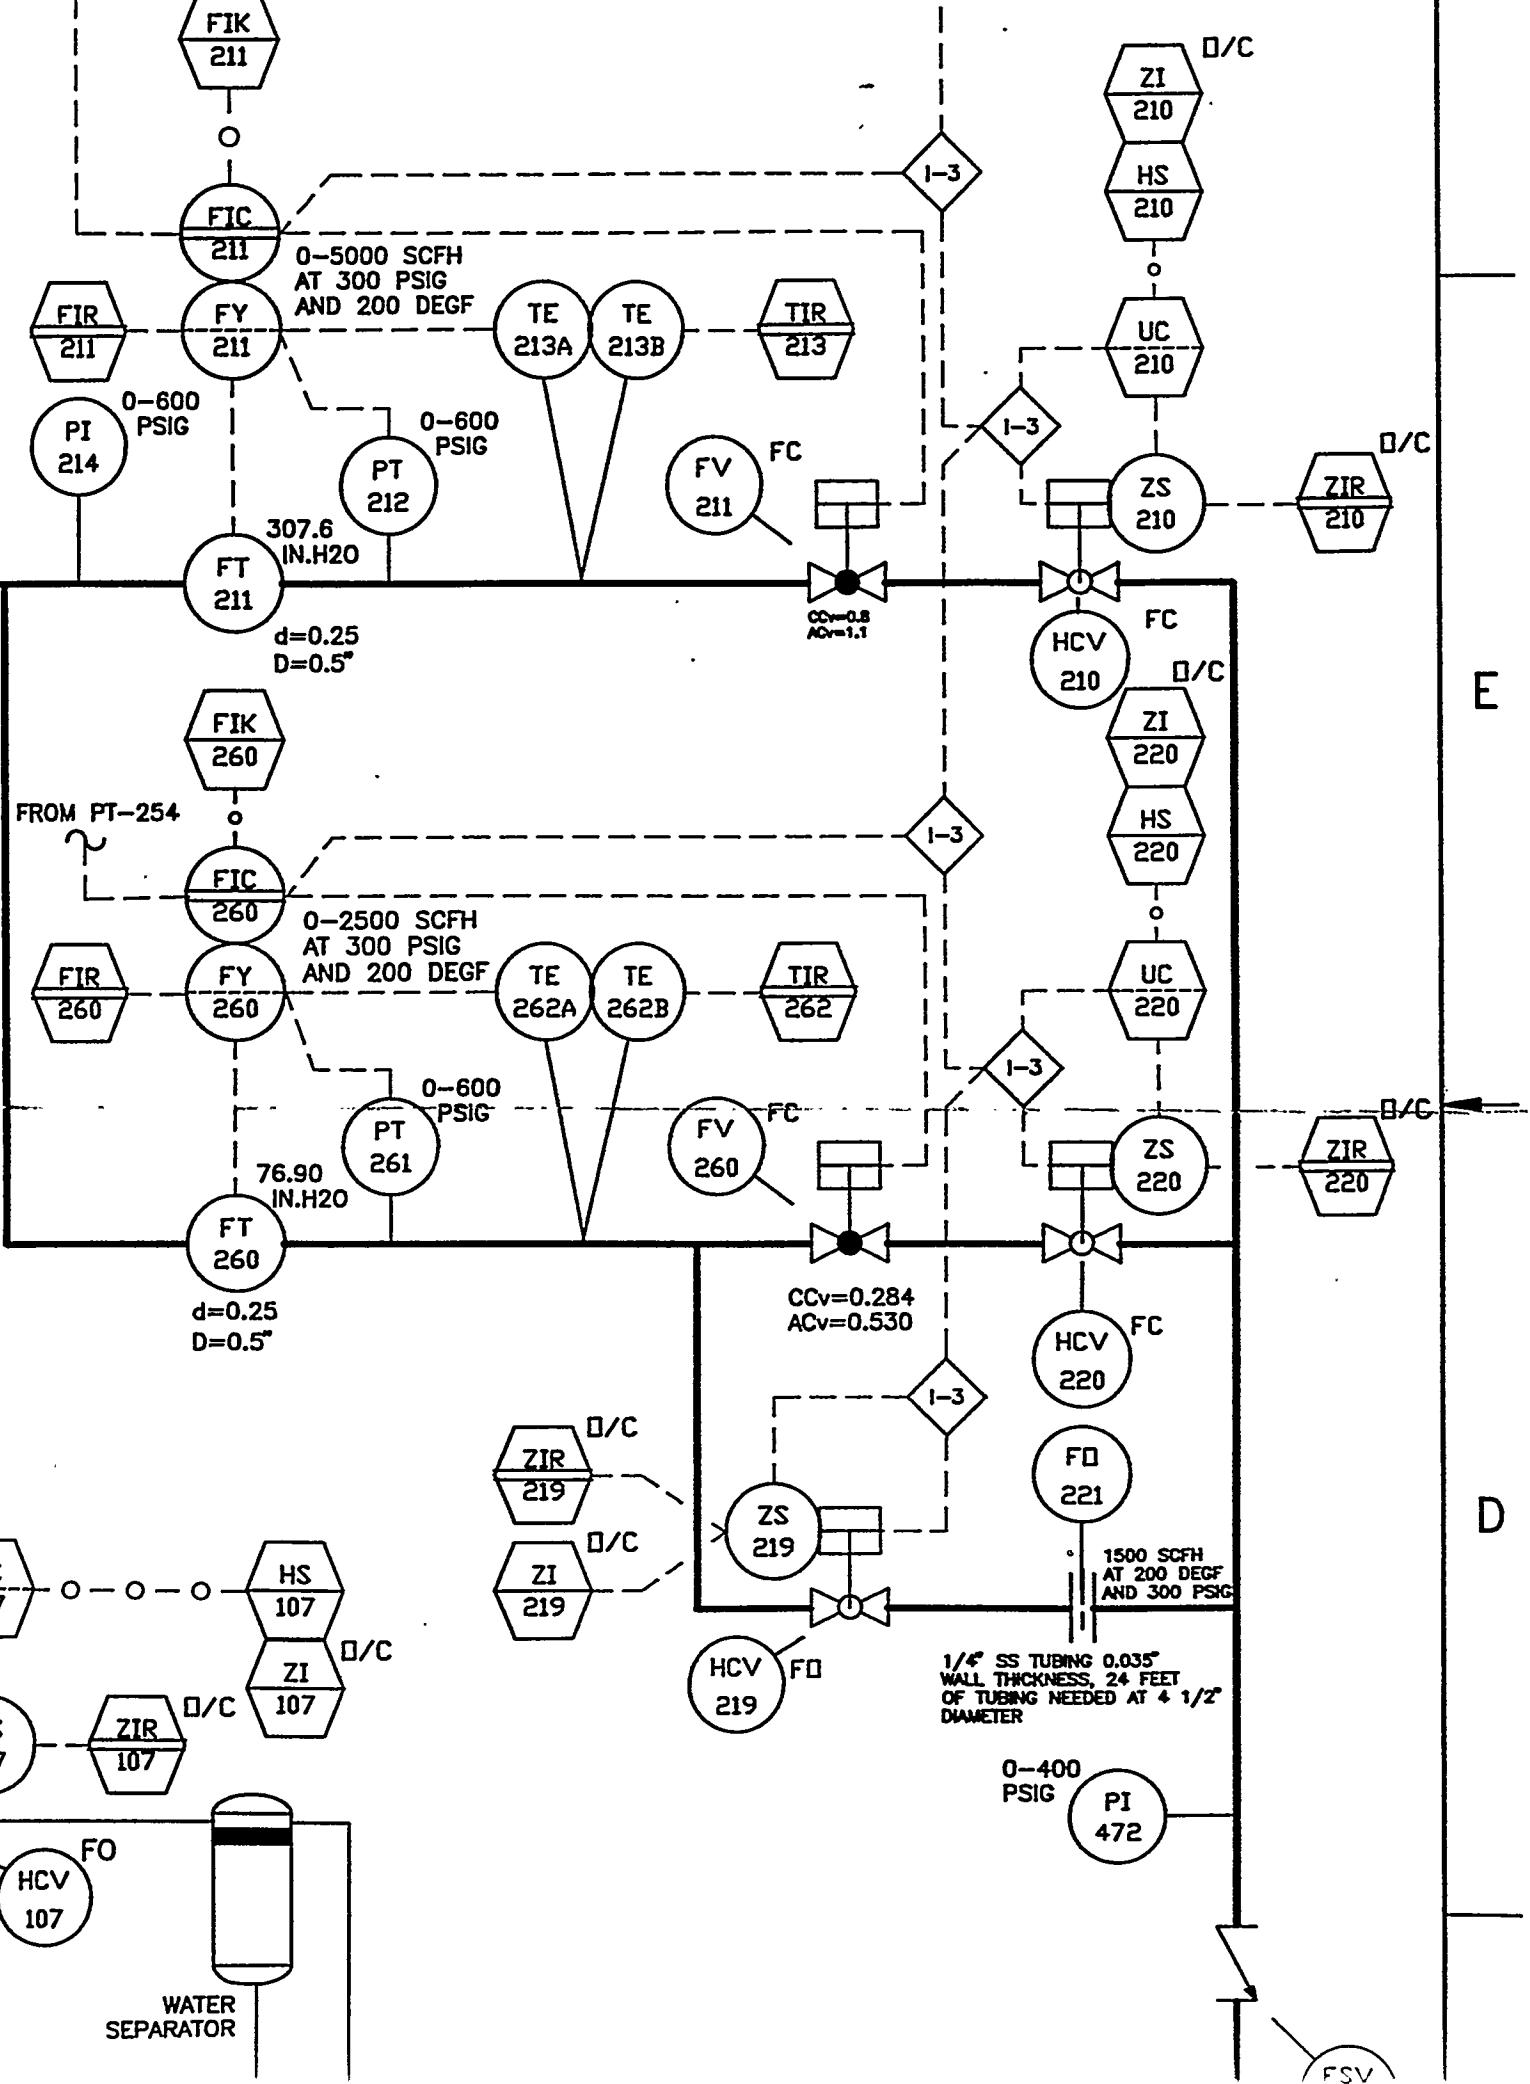



TO
F-100
OUTLET

C

FROM
CONT
MODE


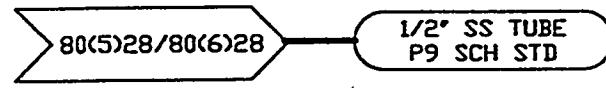



FROM
BATCH
MODE

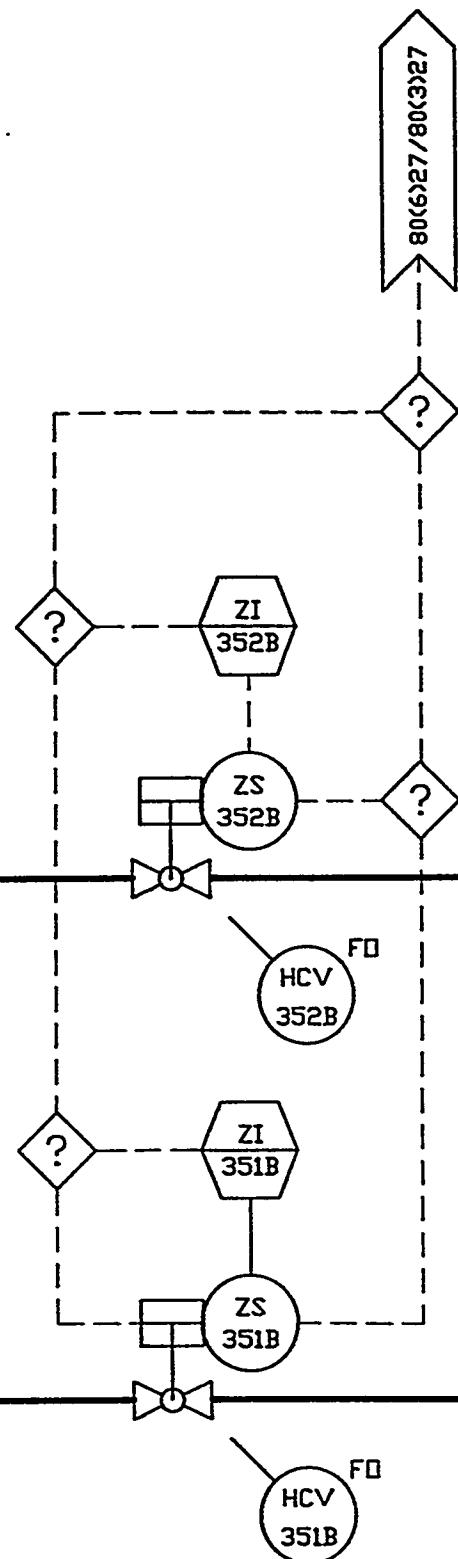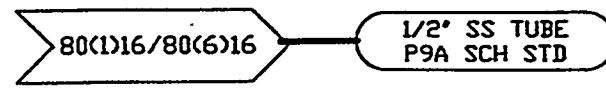


B

A

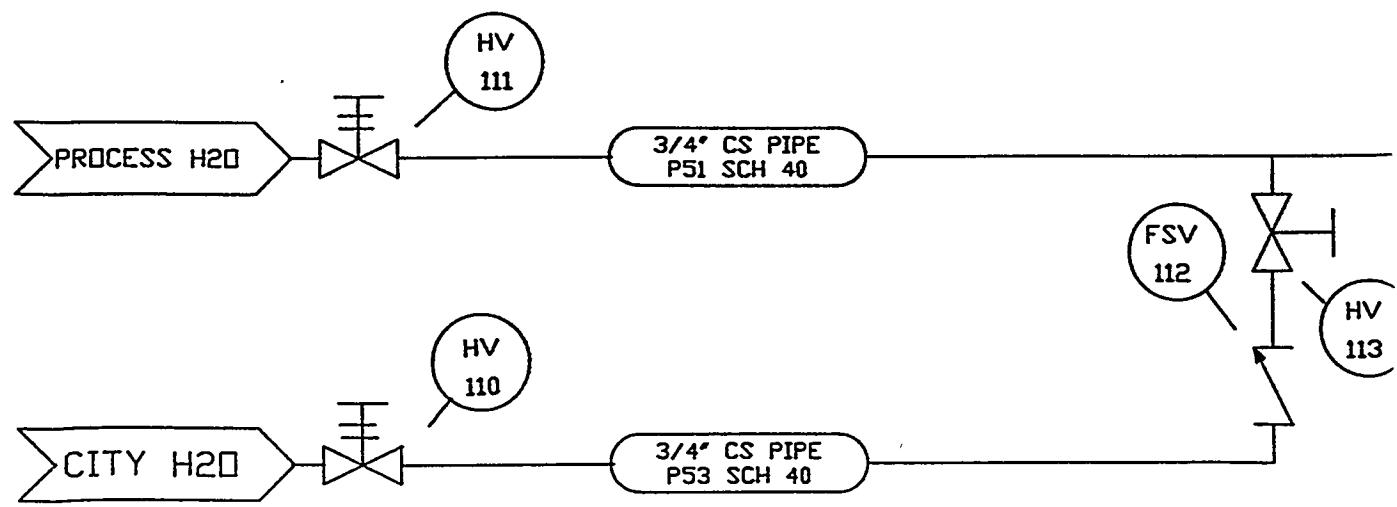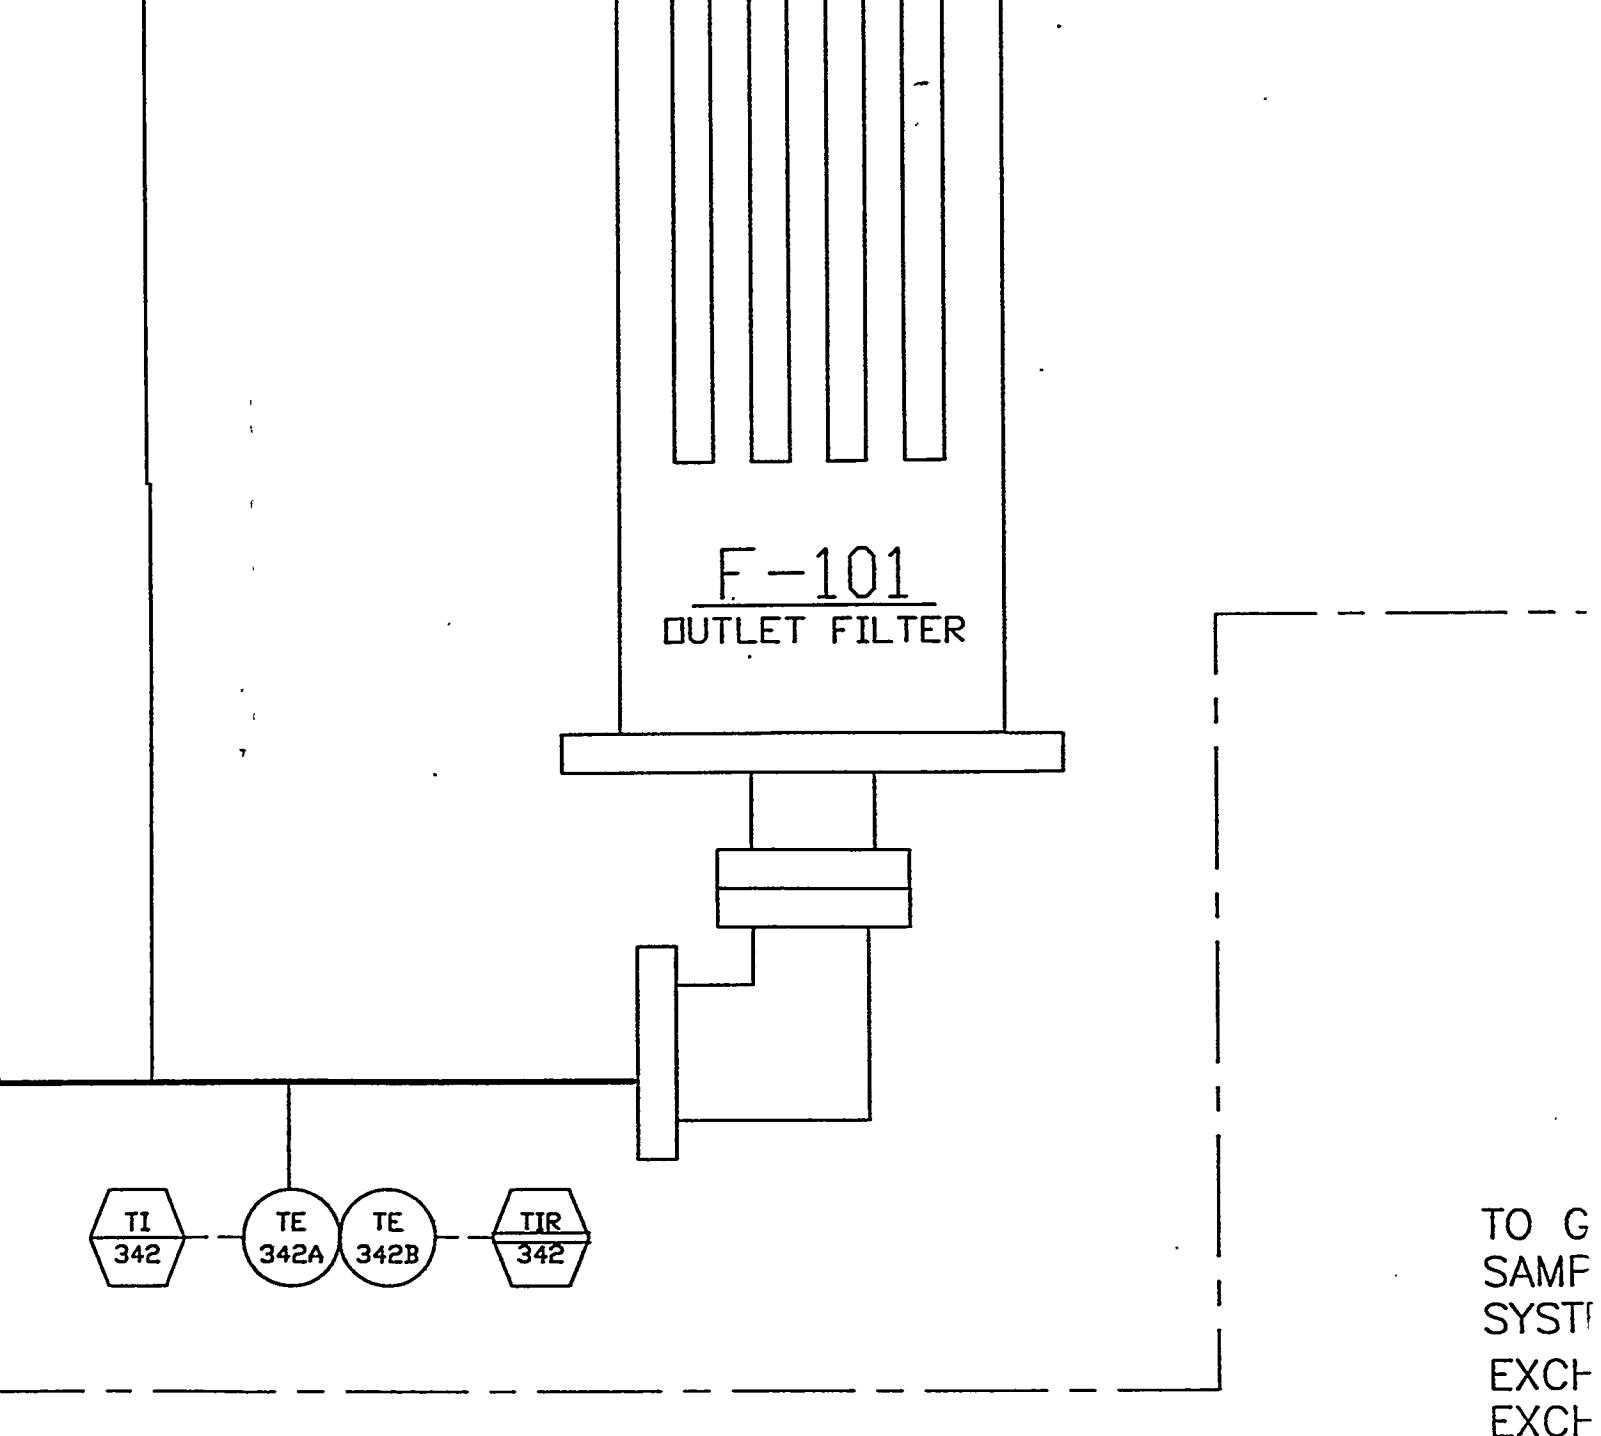

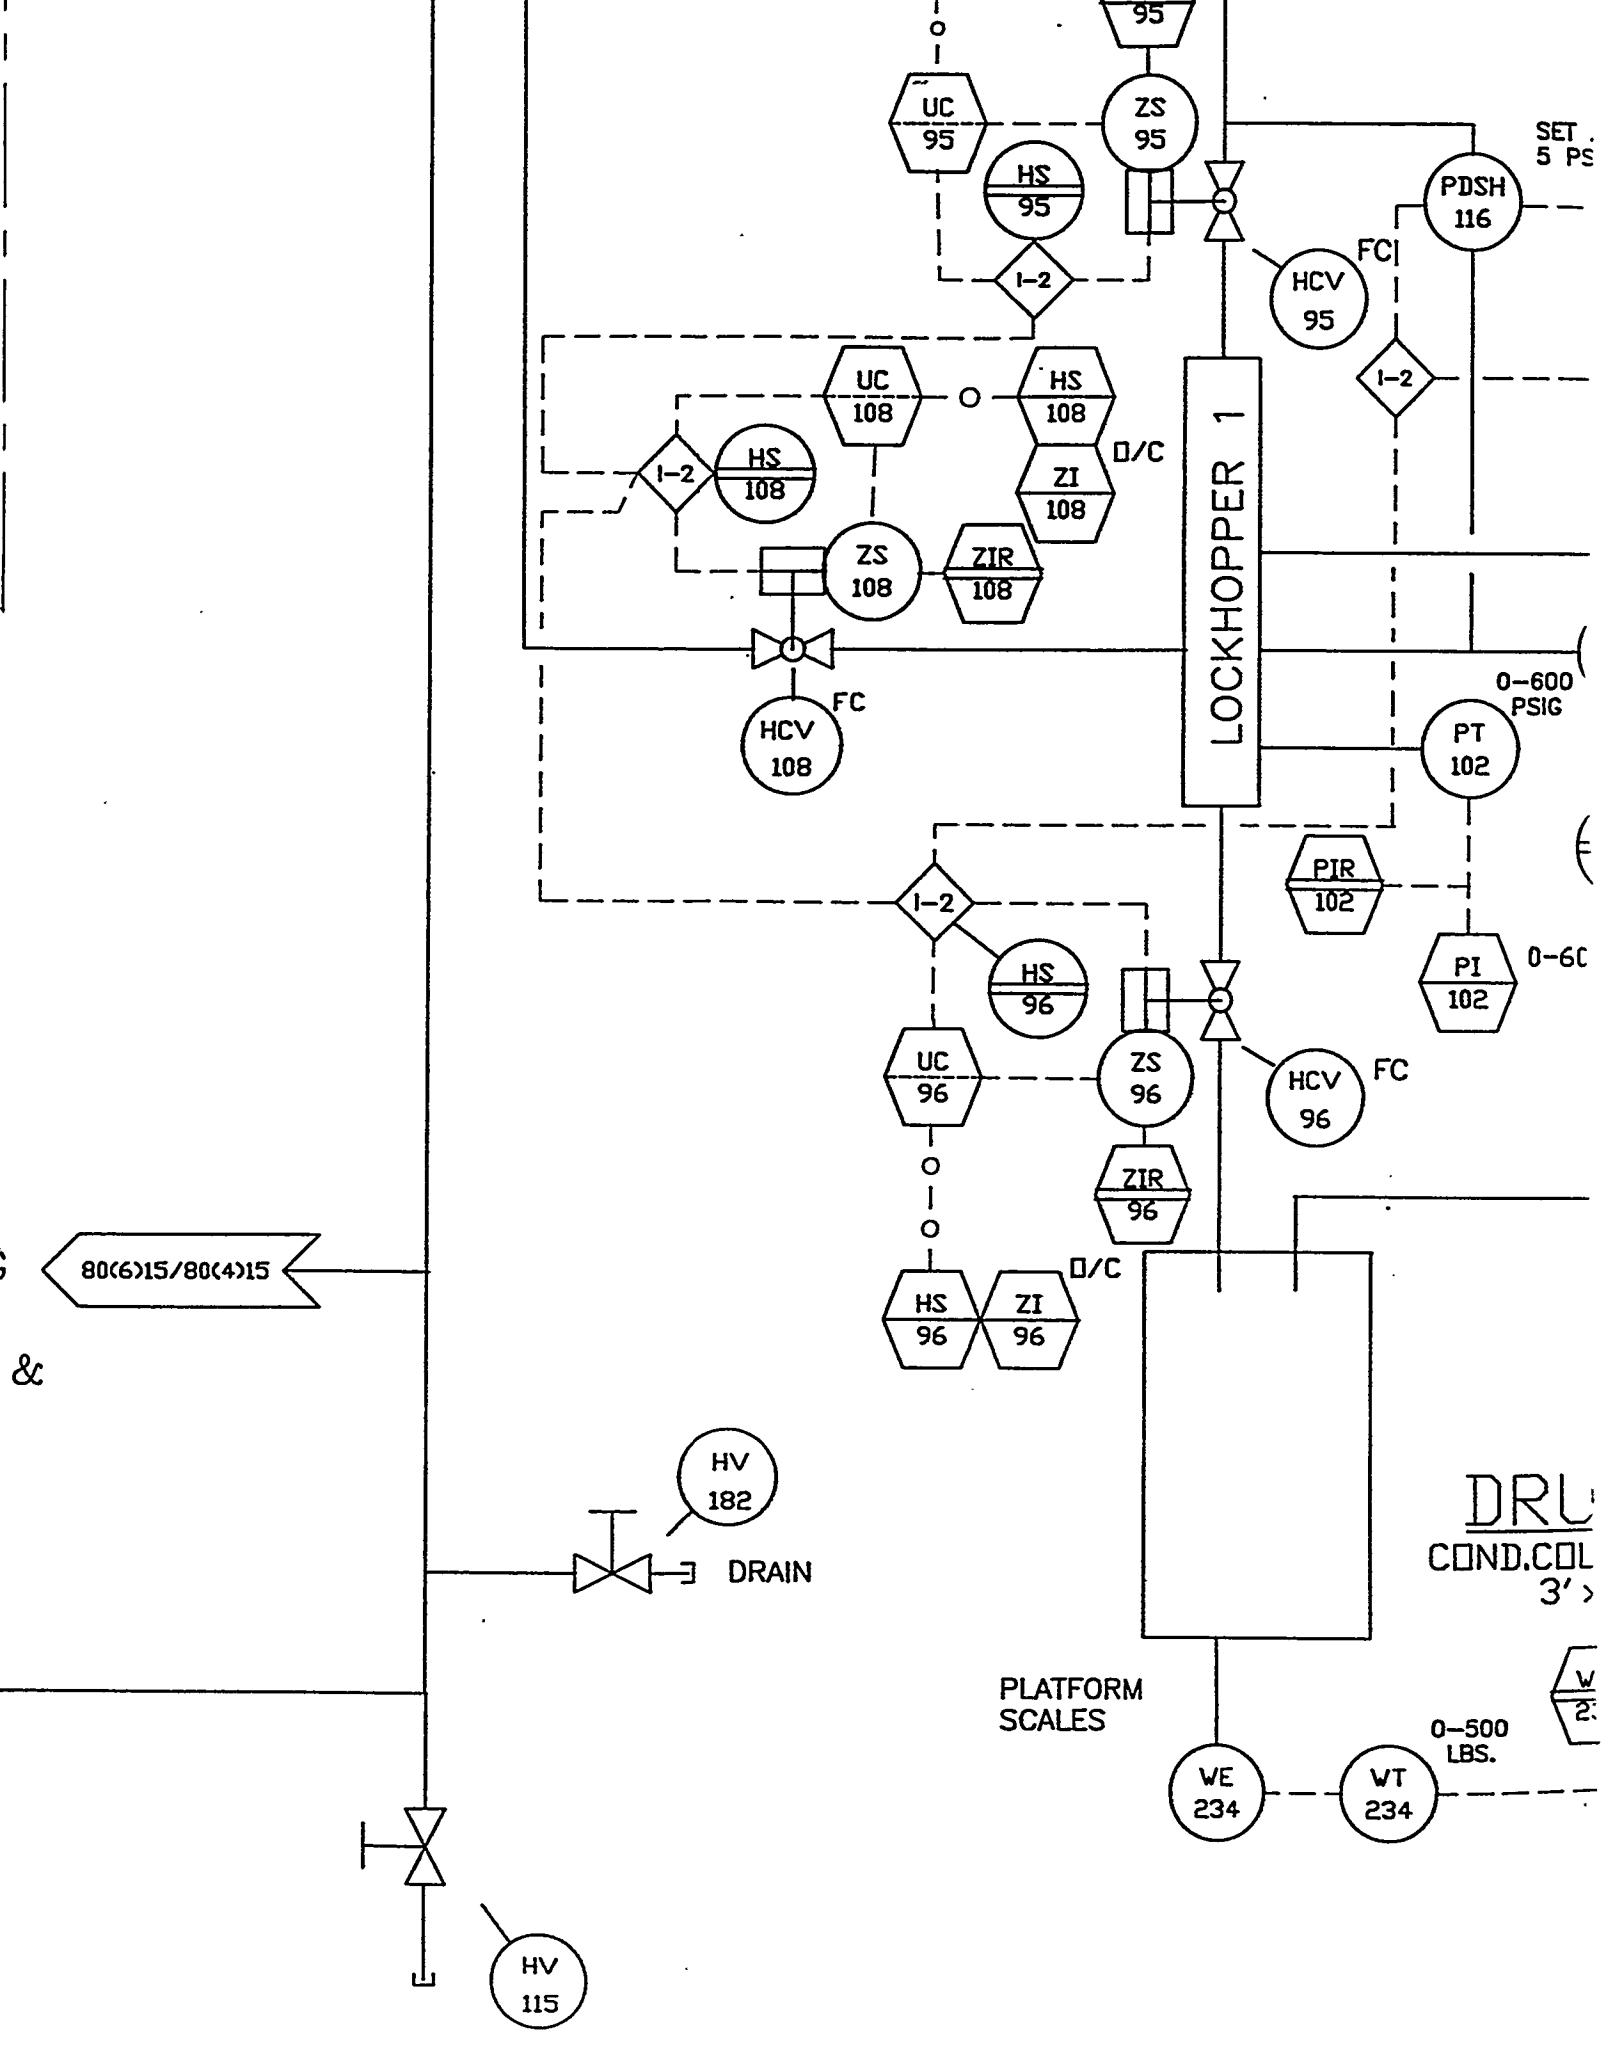

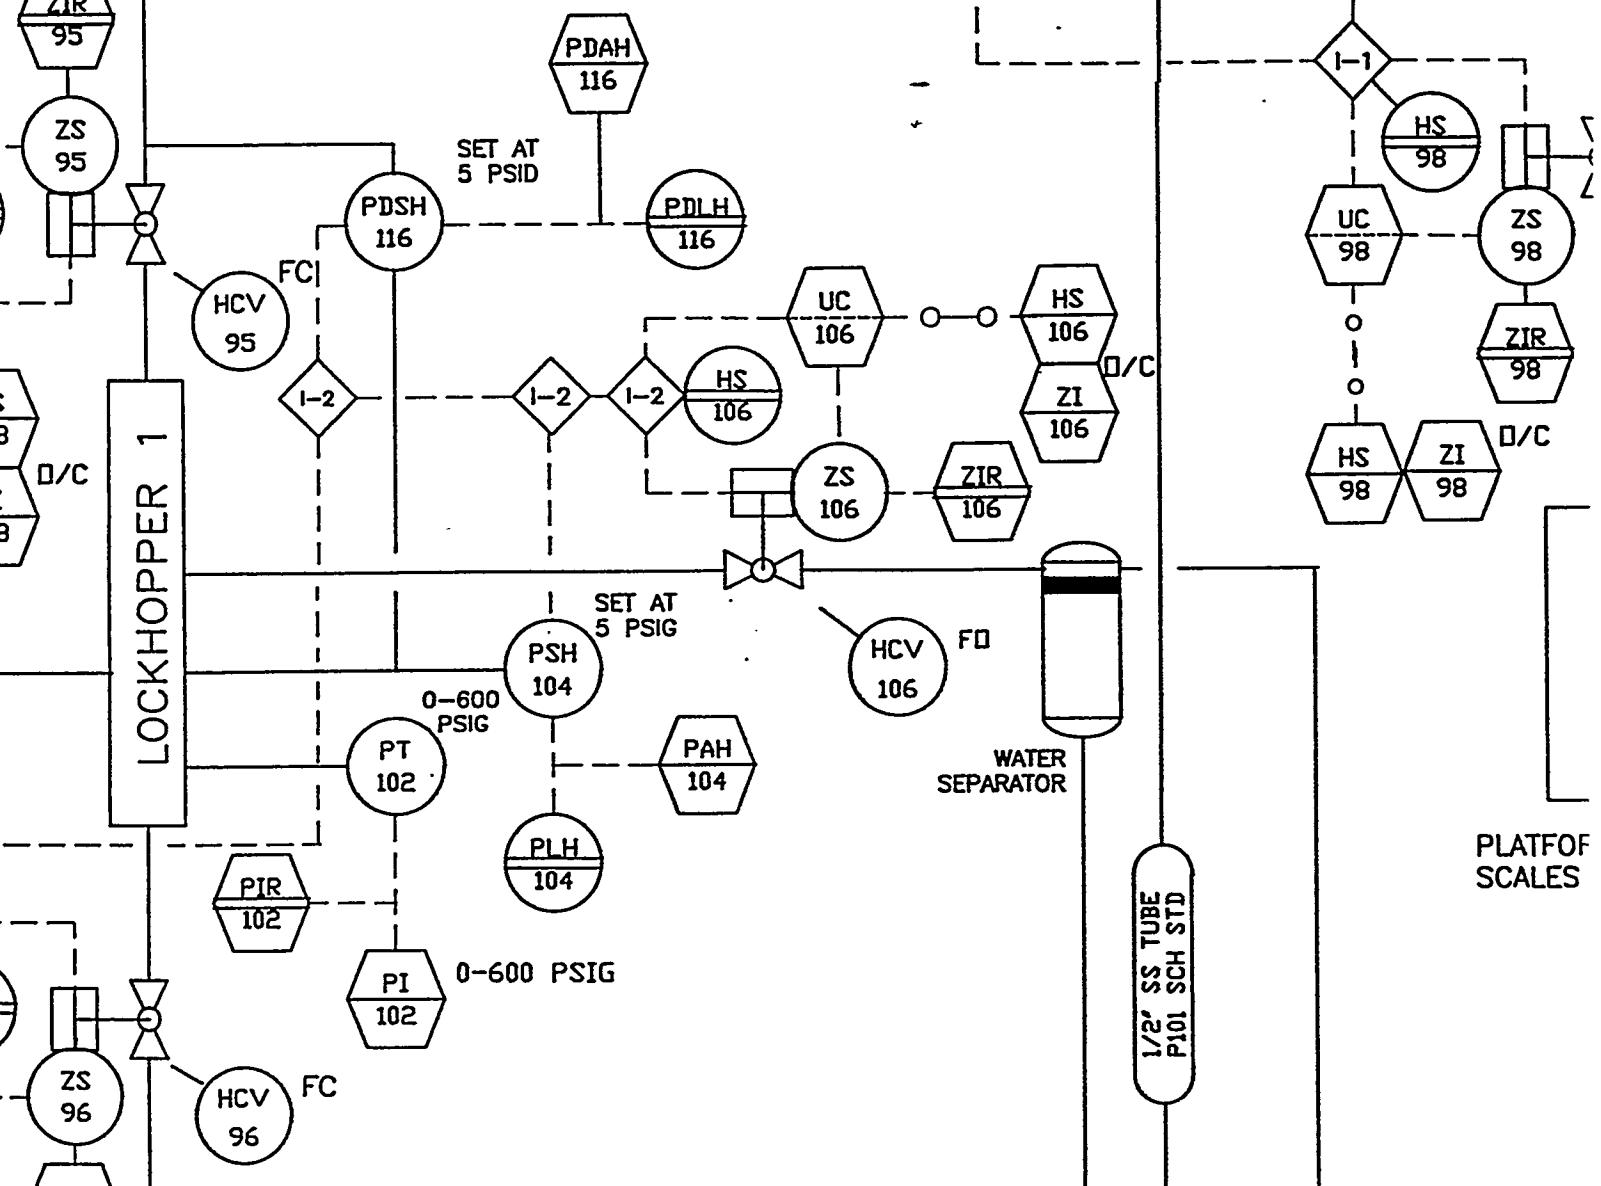

DRUM 1
COND.COLLECTION
3' x 2'

FORM
ES

WE
234

WT
234

**0-500
LBS.**


WIR
234

WI
234

80(2)7/80(1)7

PLATFORM
SCALES


THIS
OF

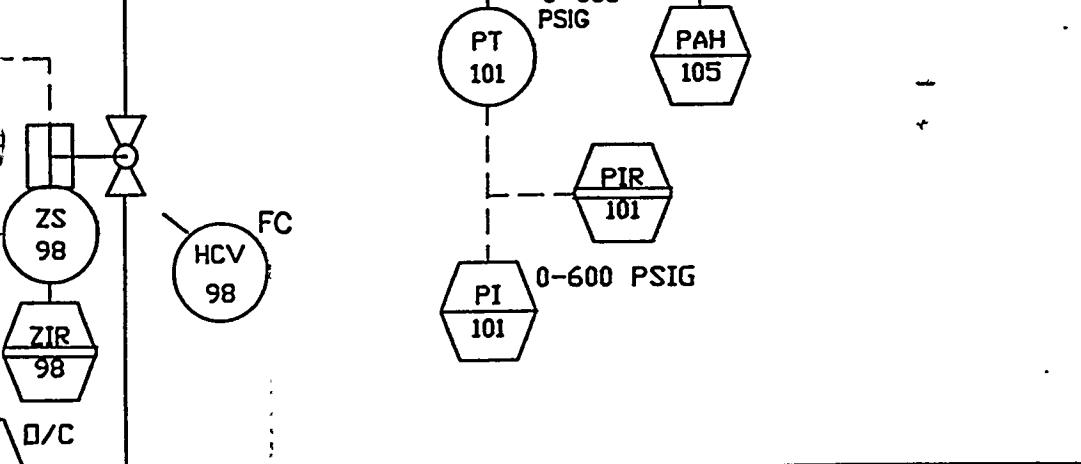

FROM SHT. 3

DRUM 2
COND.COLLECTION
3' x 2'

PLATFORM
SCALE

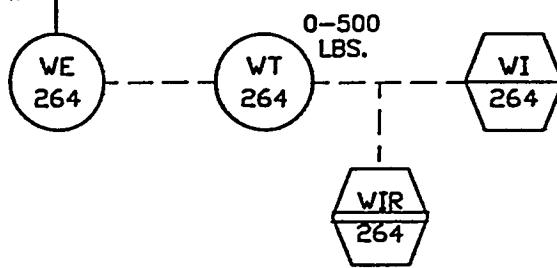

1" S.S.

NOTES:

1. ALL IMPULSE LINES ARE 3/8" SS TUBING UNLESS OTHERWISE NOTED.
- 2.
- 3.

REFERENCE DRAWINGS	DRAFTER	DATE	L M ORE 
	Jimmy Thorton	10/28/93	
	PROJECT ENGINEER John Rockey	11/2/93	
	REQUESTOR John Rockey	11/2/93	
	BRANCH MANAGER Larry Strickland	11/2/93	
	ESTH		
	DOE WJA John Rotunda	10/28/93	TITLE B-12 ADVAN MODULAR PROCESS AN (P&IDE)
			SIZE E
			FSCH NO

THIS DRAWING IS PART
OF THE EG&G DOCUMENT
CONTROL SYSTEM

FSV
457

FROM SHT. 3

C

ON 240

STD920080.07

6

1" CS PIPE
P13 SCH 40

INCINERATOR

FSV
486


INCINERATOR

1" S.S.

LINES ARE 3/8" SS TUBING UNLESS OTHERWISE NOTED.

NGS

DRAFTER	Jimmy Thornton	DATE	10/28/93
PROJECT ENGINEER	John Rockey	DATE	11/2/93
REQUESTOR	John Rockey	DATE	11/2/93
BRANCH MANAGER	Larry Strickland	DATE	11/2/93
ESD		DATE	
DOE	WJA John Rotunda	DATE	10/28/93
		DATE	

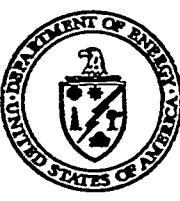

United States Department of Energy
MORGANTOWN ENERGY TECHNOLOGY CENTER
 Morgantown, WV

B-12 ADVANCED GASIFICATION FACILITY
 MODULAR GAS CLEANUP RIG (MGCR)
 PROCESS AND INSTRUMENTATION DRAWING
 (P&ID) OUTLET FILTRATION

SIZE
E

DWG NO

STD920080.07

REV
7

A

80(3)-28/40(0)-28

B-12j MGCR
PROBE #1

295 SCFH
1000° F
425 PSIG



1/2" TUBE-SSTL


H


G

F


E

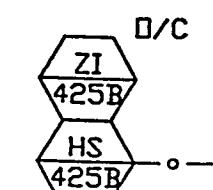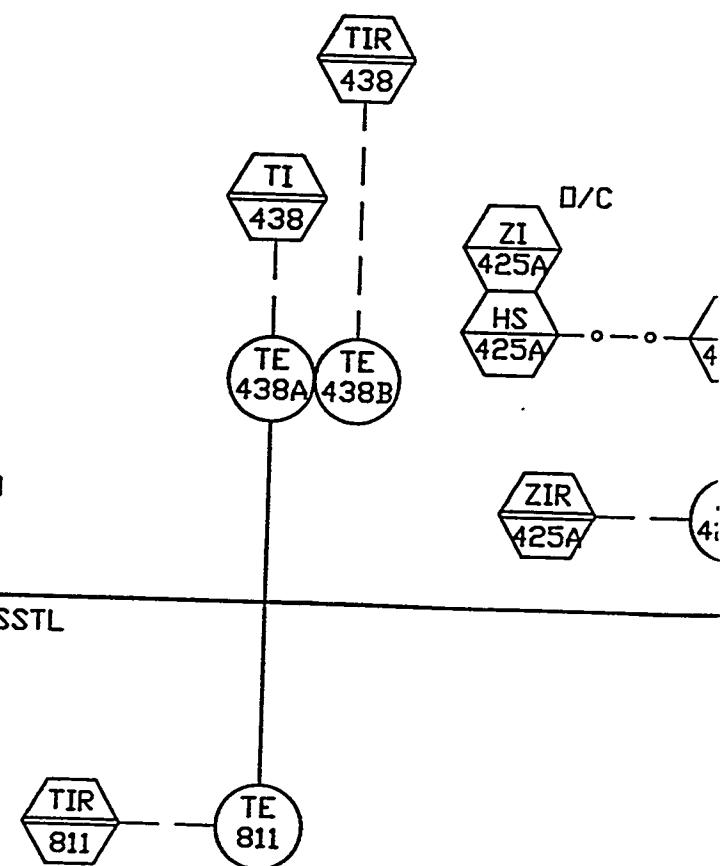

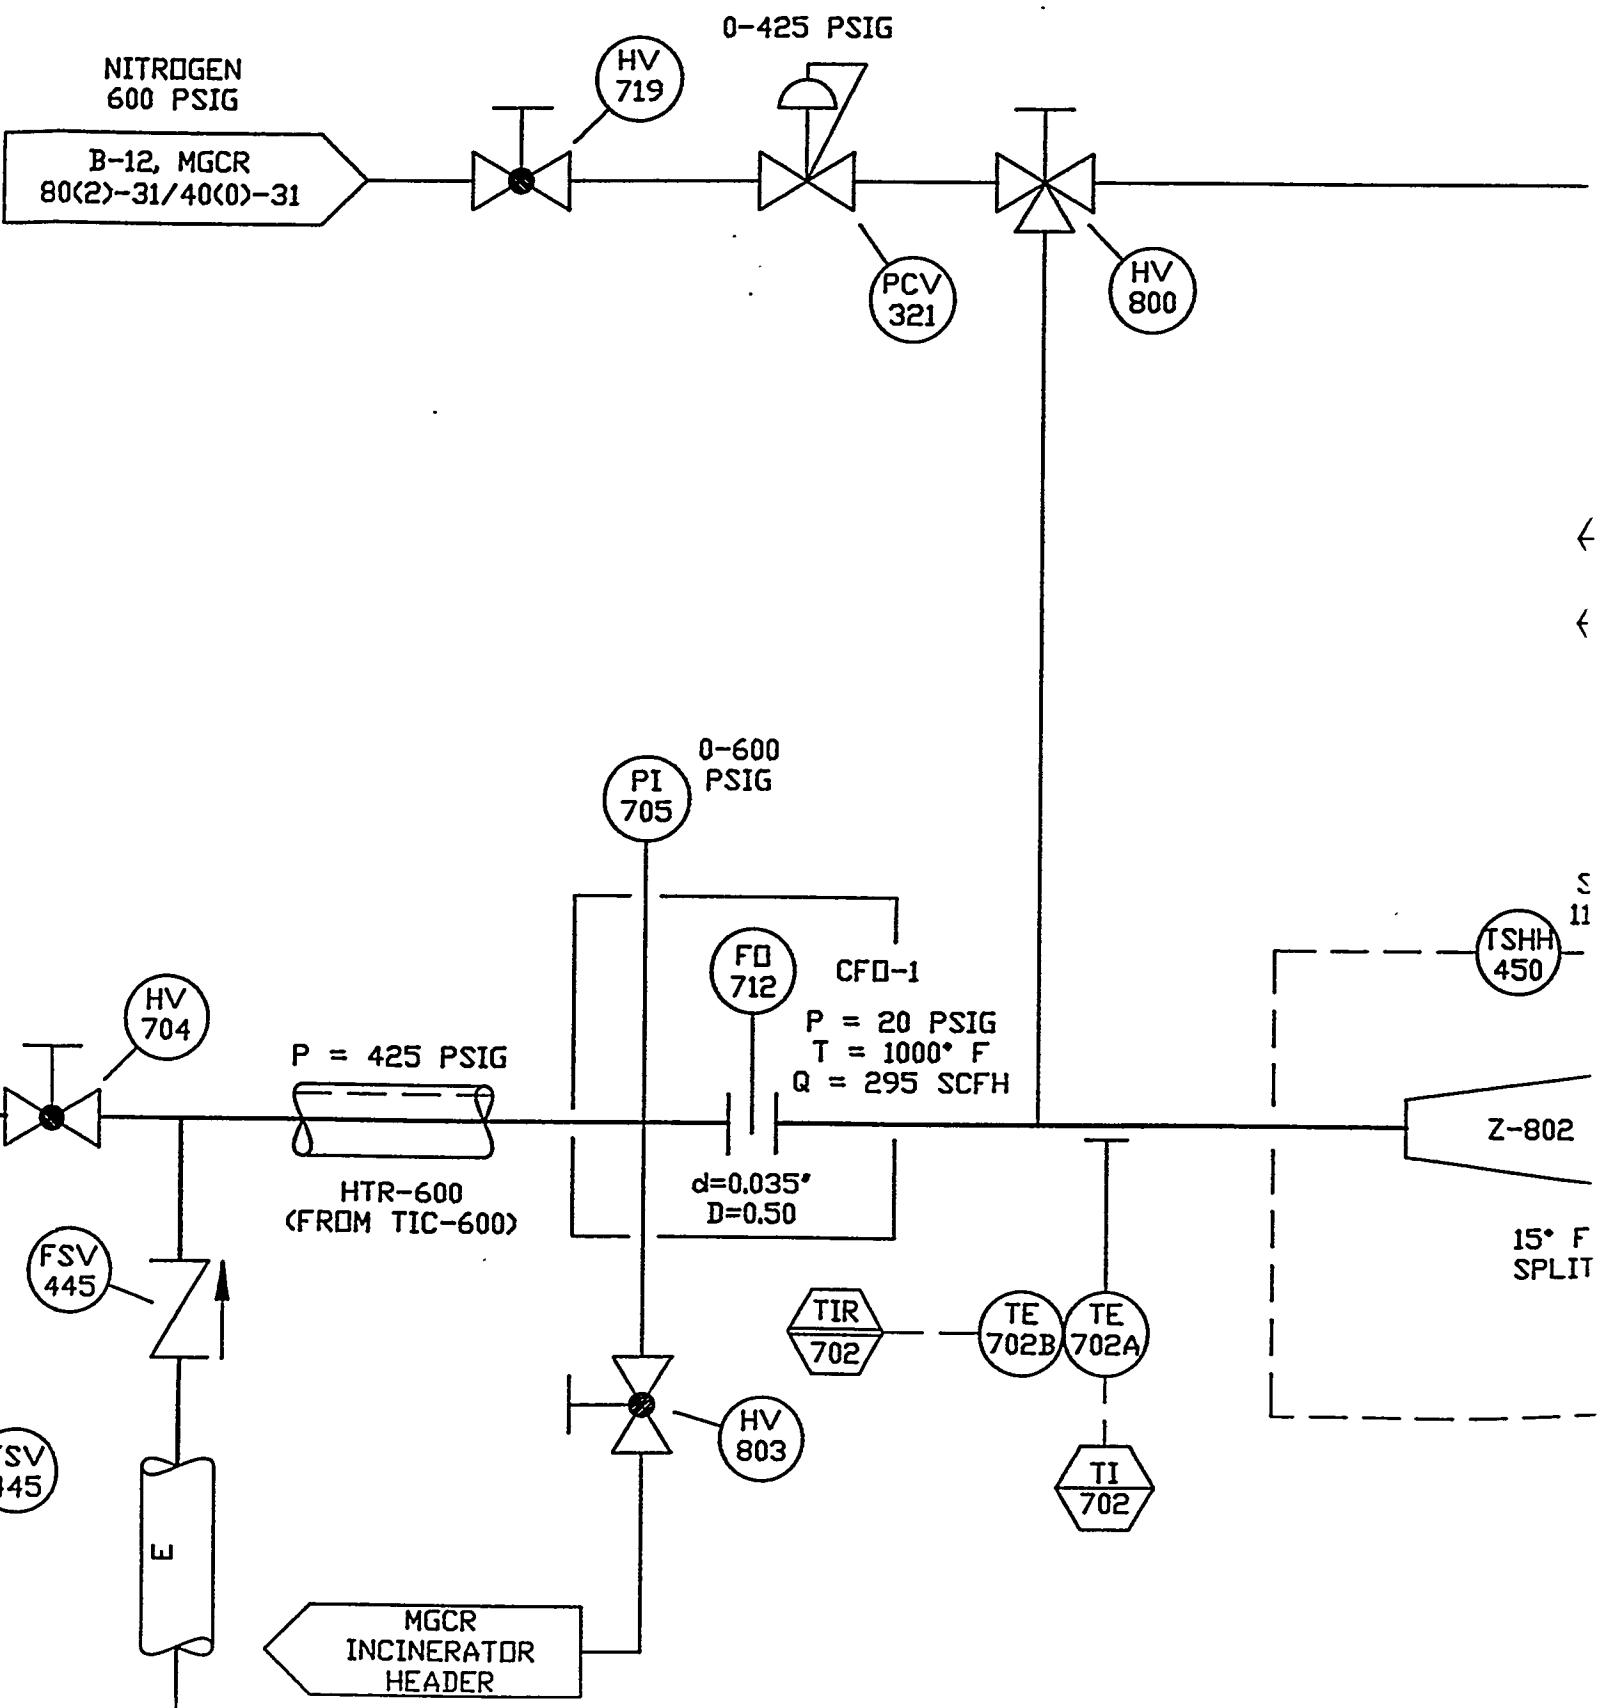

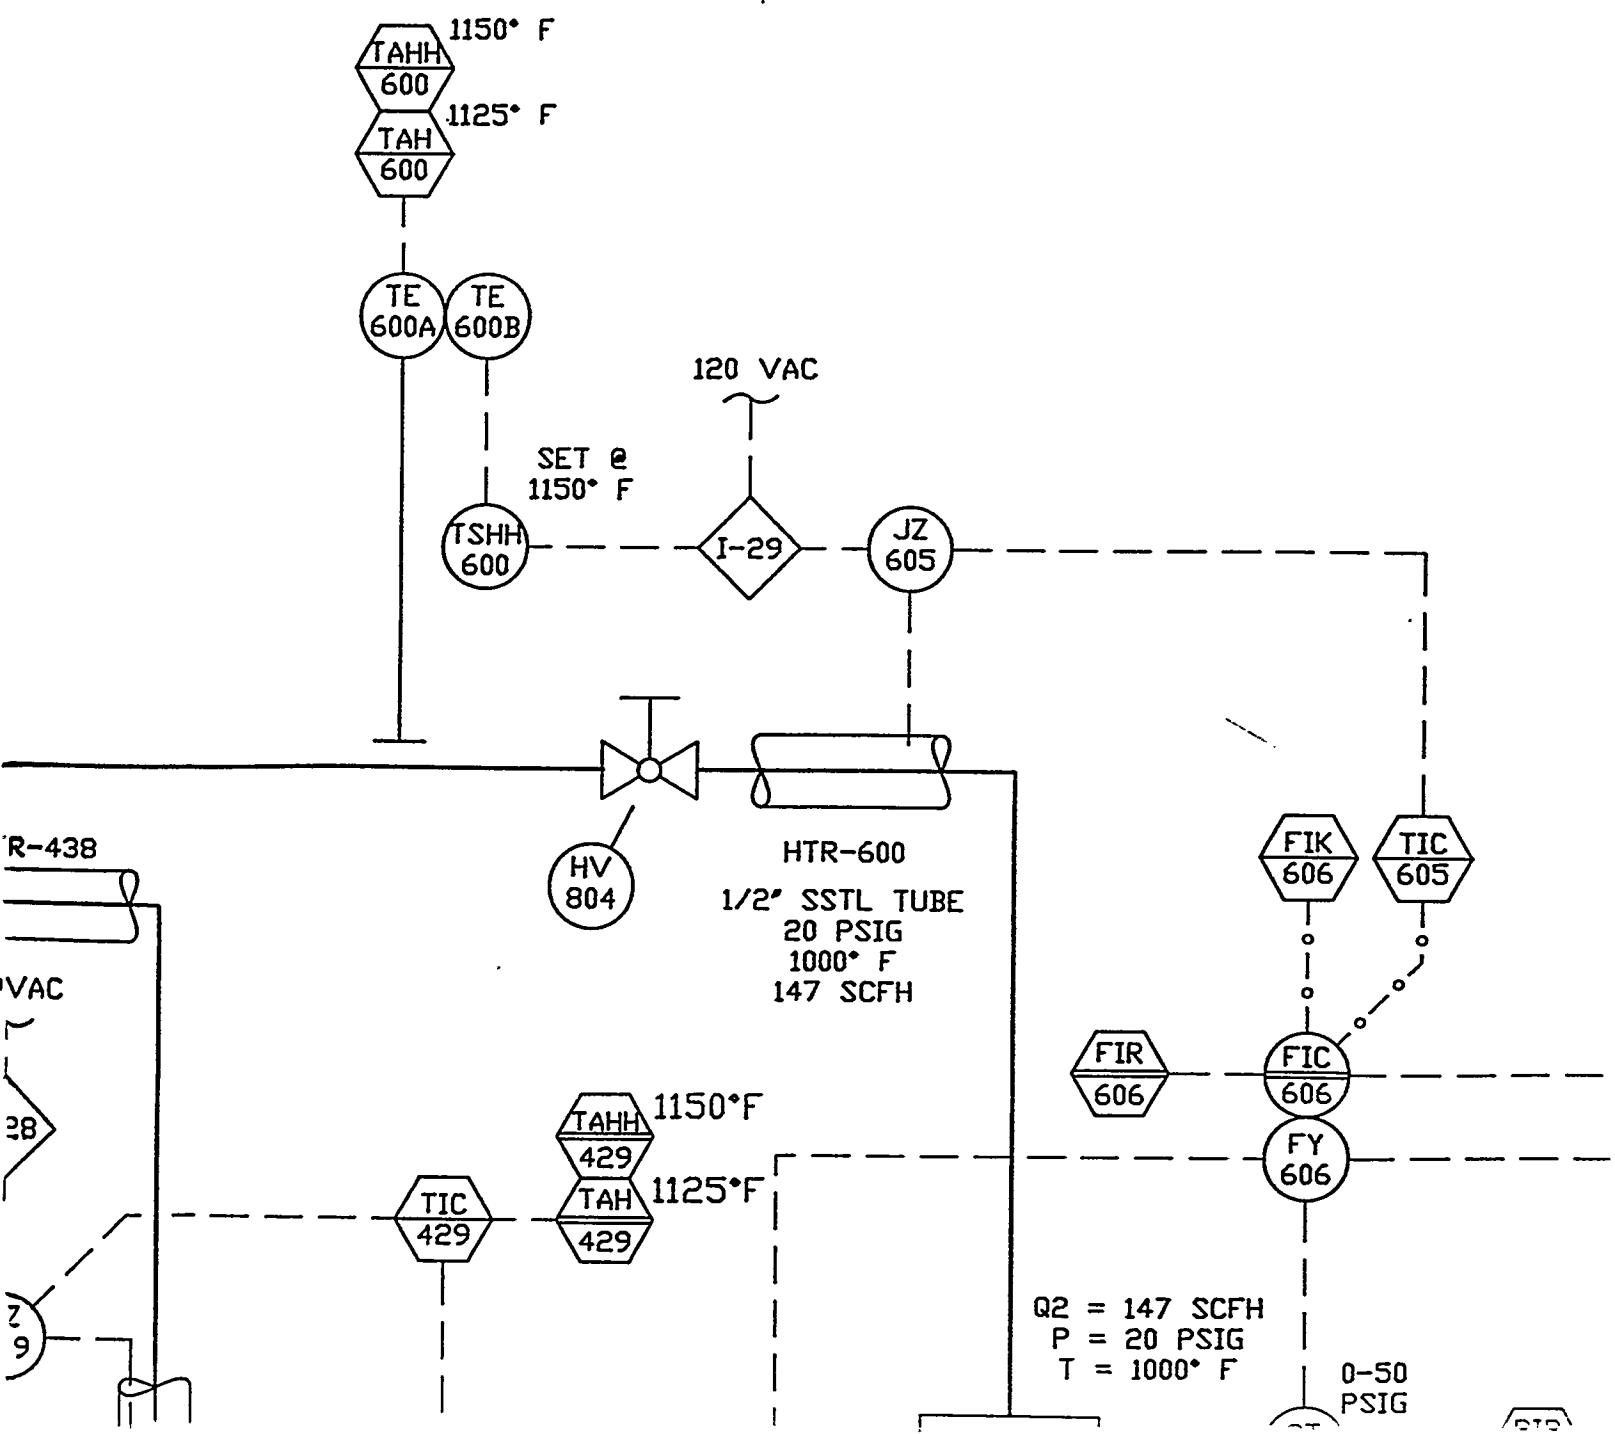

ZONE	REV	
GEN	0	ISSUED FOR CONSTRUCT
ZONE	REV	
GEN.	1	MODIFIED AS PER MARKED
DRAFTER	DATE	CHECKER
GARY J. KULCHOCK	6/30/94	S. CONK
ESR	DATE	DOE (EDS)
J.L. BUCKLEW	6/30/94	EDWIN
ZONE	REV	
GEN.	2	MODIFIED AS PER MARKED
DRAFTER	DATE	CHECKER
Gary Kulchuck	8/15/95	S. Conk
ESR	DATE	DOE (EDS)
J.L. BUCKLEW	9/8/95	gpk

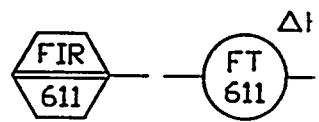

REVISION


ZONE	REV	DESCRIPTION						DATE
GEN	0	ISSUED FOR CONSTRUCTION						5/25/94
ZONE	REV	DESCRIPTION						DATE
GEN.	1	MODIFIED AS PER MARKED PRINT: ISSUED FOR CONSTRUCTION						6/24/94
AFTER GARY J. KULCHOCK	DATE 6/30/94	CHECKER S. CONKO	DATE 6/30/94	DESIGNER C. ELAINE EVERITT	DATE 6/30/94	RESPONSIBLE PERSON		DATE
TH J.L. BUCKLEW	DATE 6/30/94	DOE (EOSSD) EDWIN GALLOWAY	DATE 6/30/94	ROBERT ROMANSKY	DATE 7/1/94	JOHN ROTUNDA		DATE 6/30/94
ZONE	REV	DESCRIPTION						DATE
GEN.	2	MODIFIED AS PER MARKED PRINT: ISSUED FOR CONSTRUCTION						8/15/95
AFTER <i>Samuel V. Lebel</i>	DATE 8/15/95	CHECKER <i>S. Conko</i>	DATE 8-15-95	DESIGNER <i>C. Elaine Everitt</i>	DATE 8/30/95	RESPONSIBLE PERSON <i>Kirk Pineault</i>		DATE 9/1/95
TH <i>V.L. Gray</i>	DATE 9/8/95	DOE (EOSSD) <i>gk1/10/95</i>	DATE 9/3/95					

VENT

ANAL.
INST.

3

Q3 = 21 SCFH
 P3 = 0 PSIG
 T3 = 1000° F

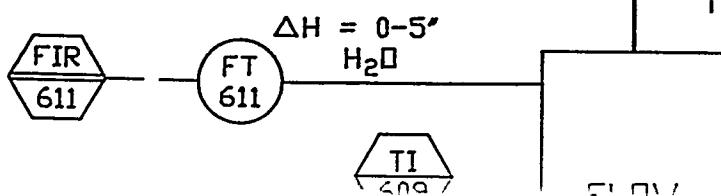

H

G

F

INCINERATOR
HEADER

208 VAC

PREHEAT NITROGEN
425 PSIG

80(2)-29/40(0)-29

PI
808


0-1000
PSIG

0-150 PSIG


PI
809


0-600
PSIG


75-100 PSIG

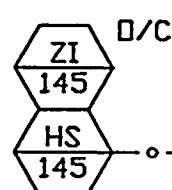



50 PSIG
P_f
4:
PIR
430
F
4:

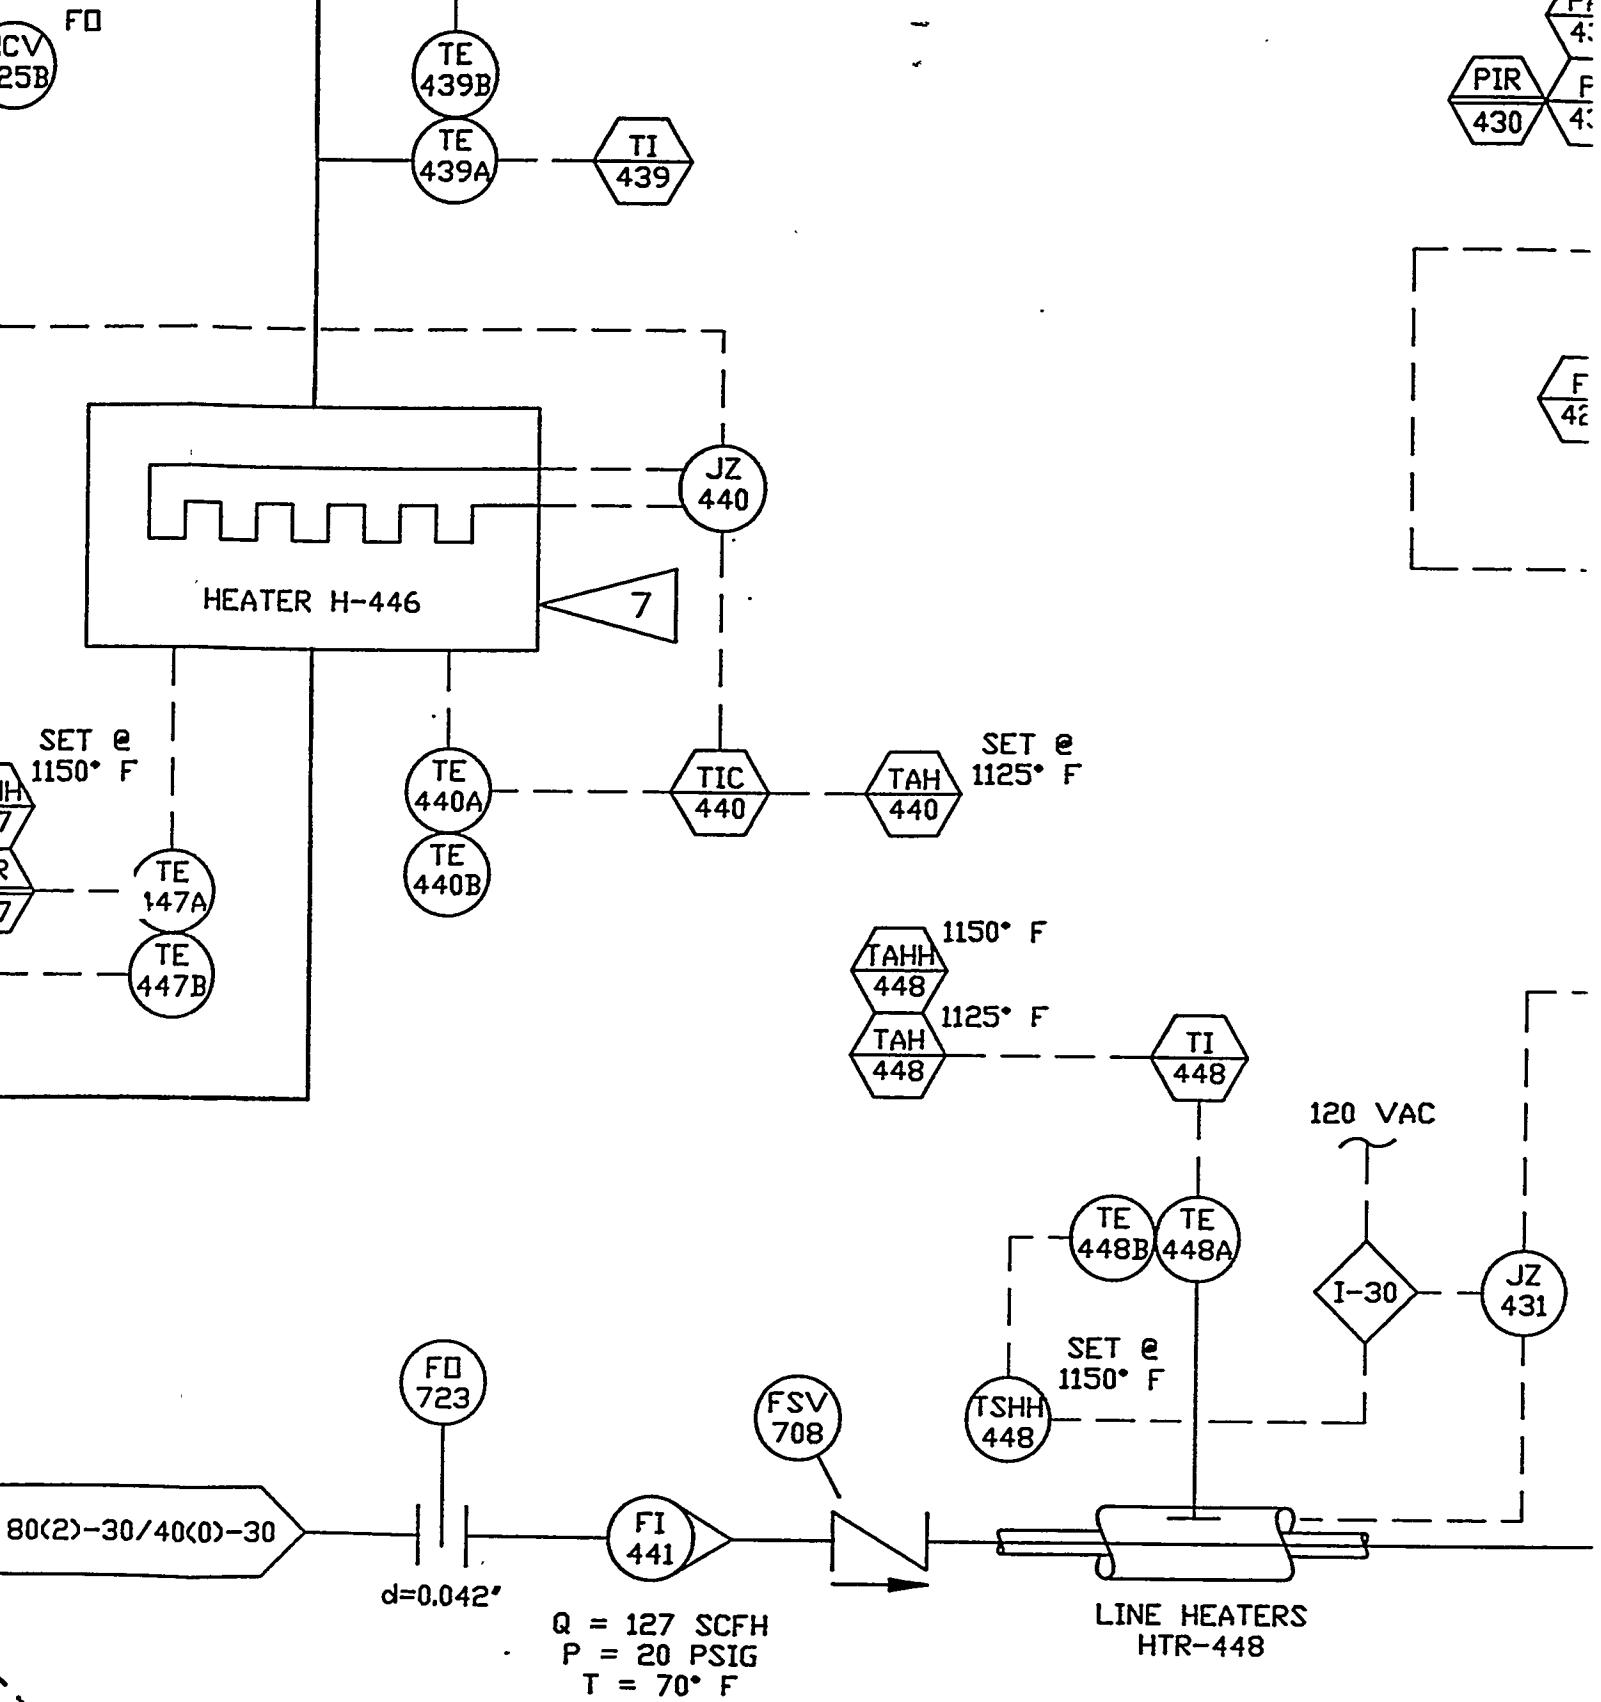


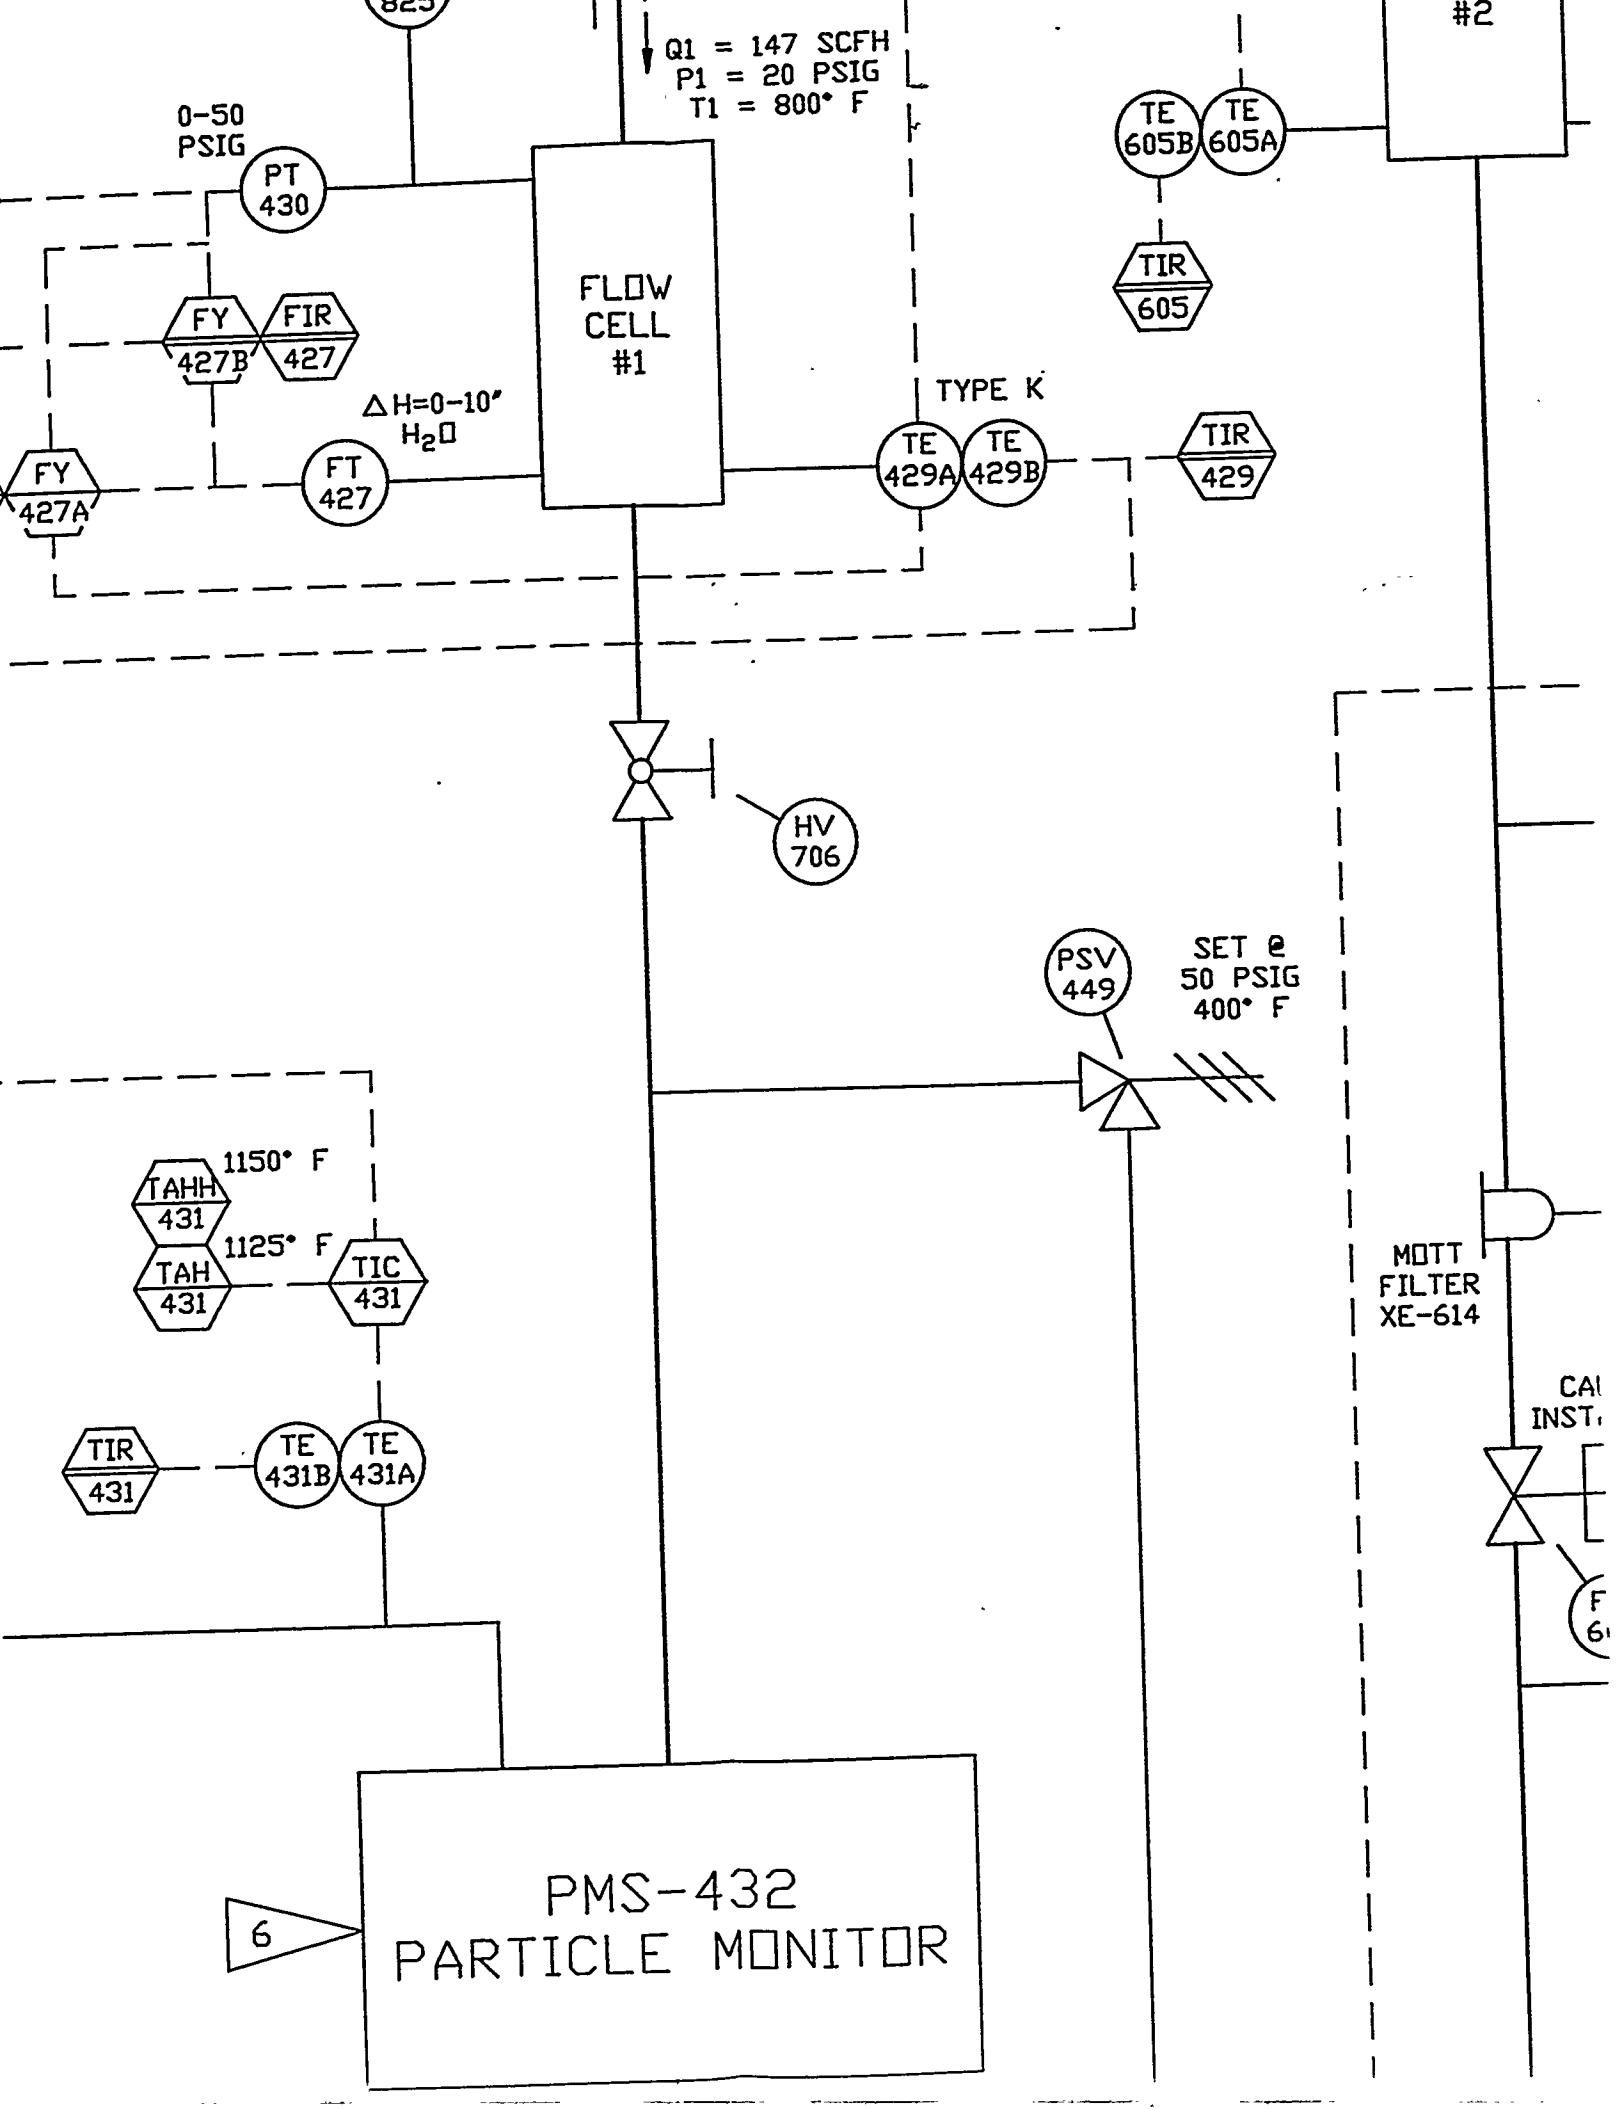


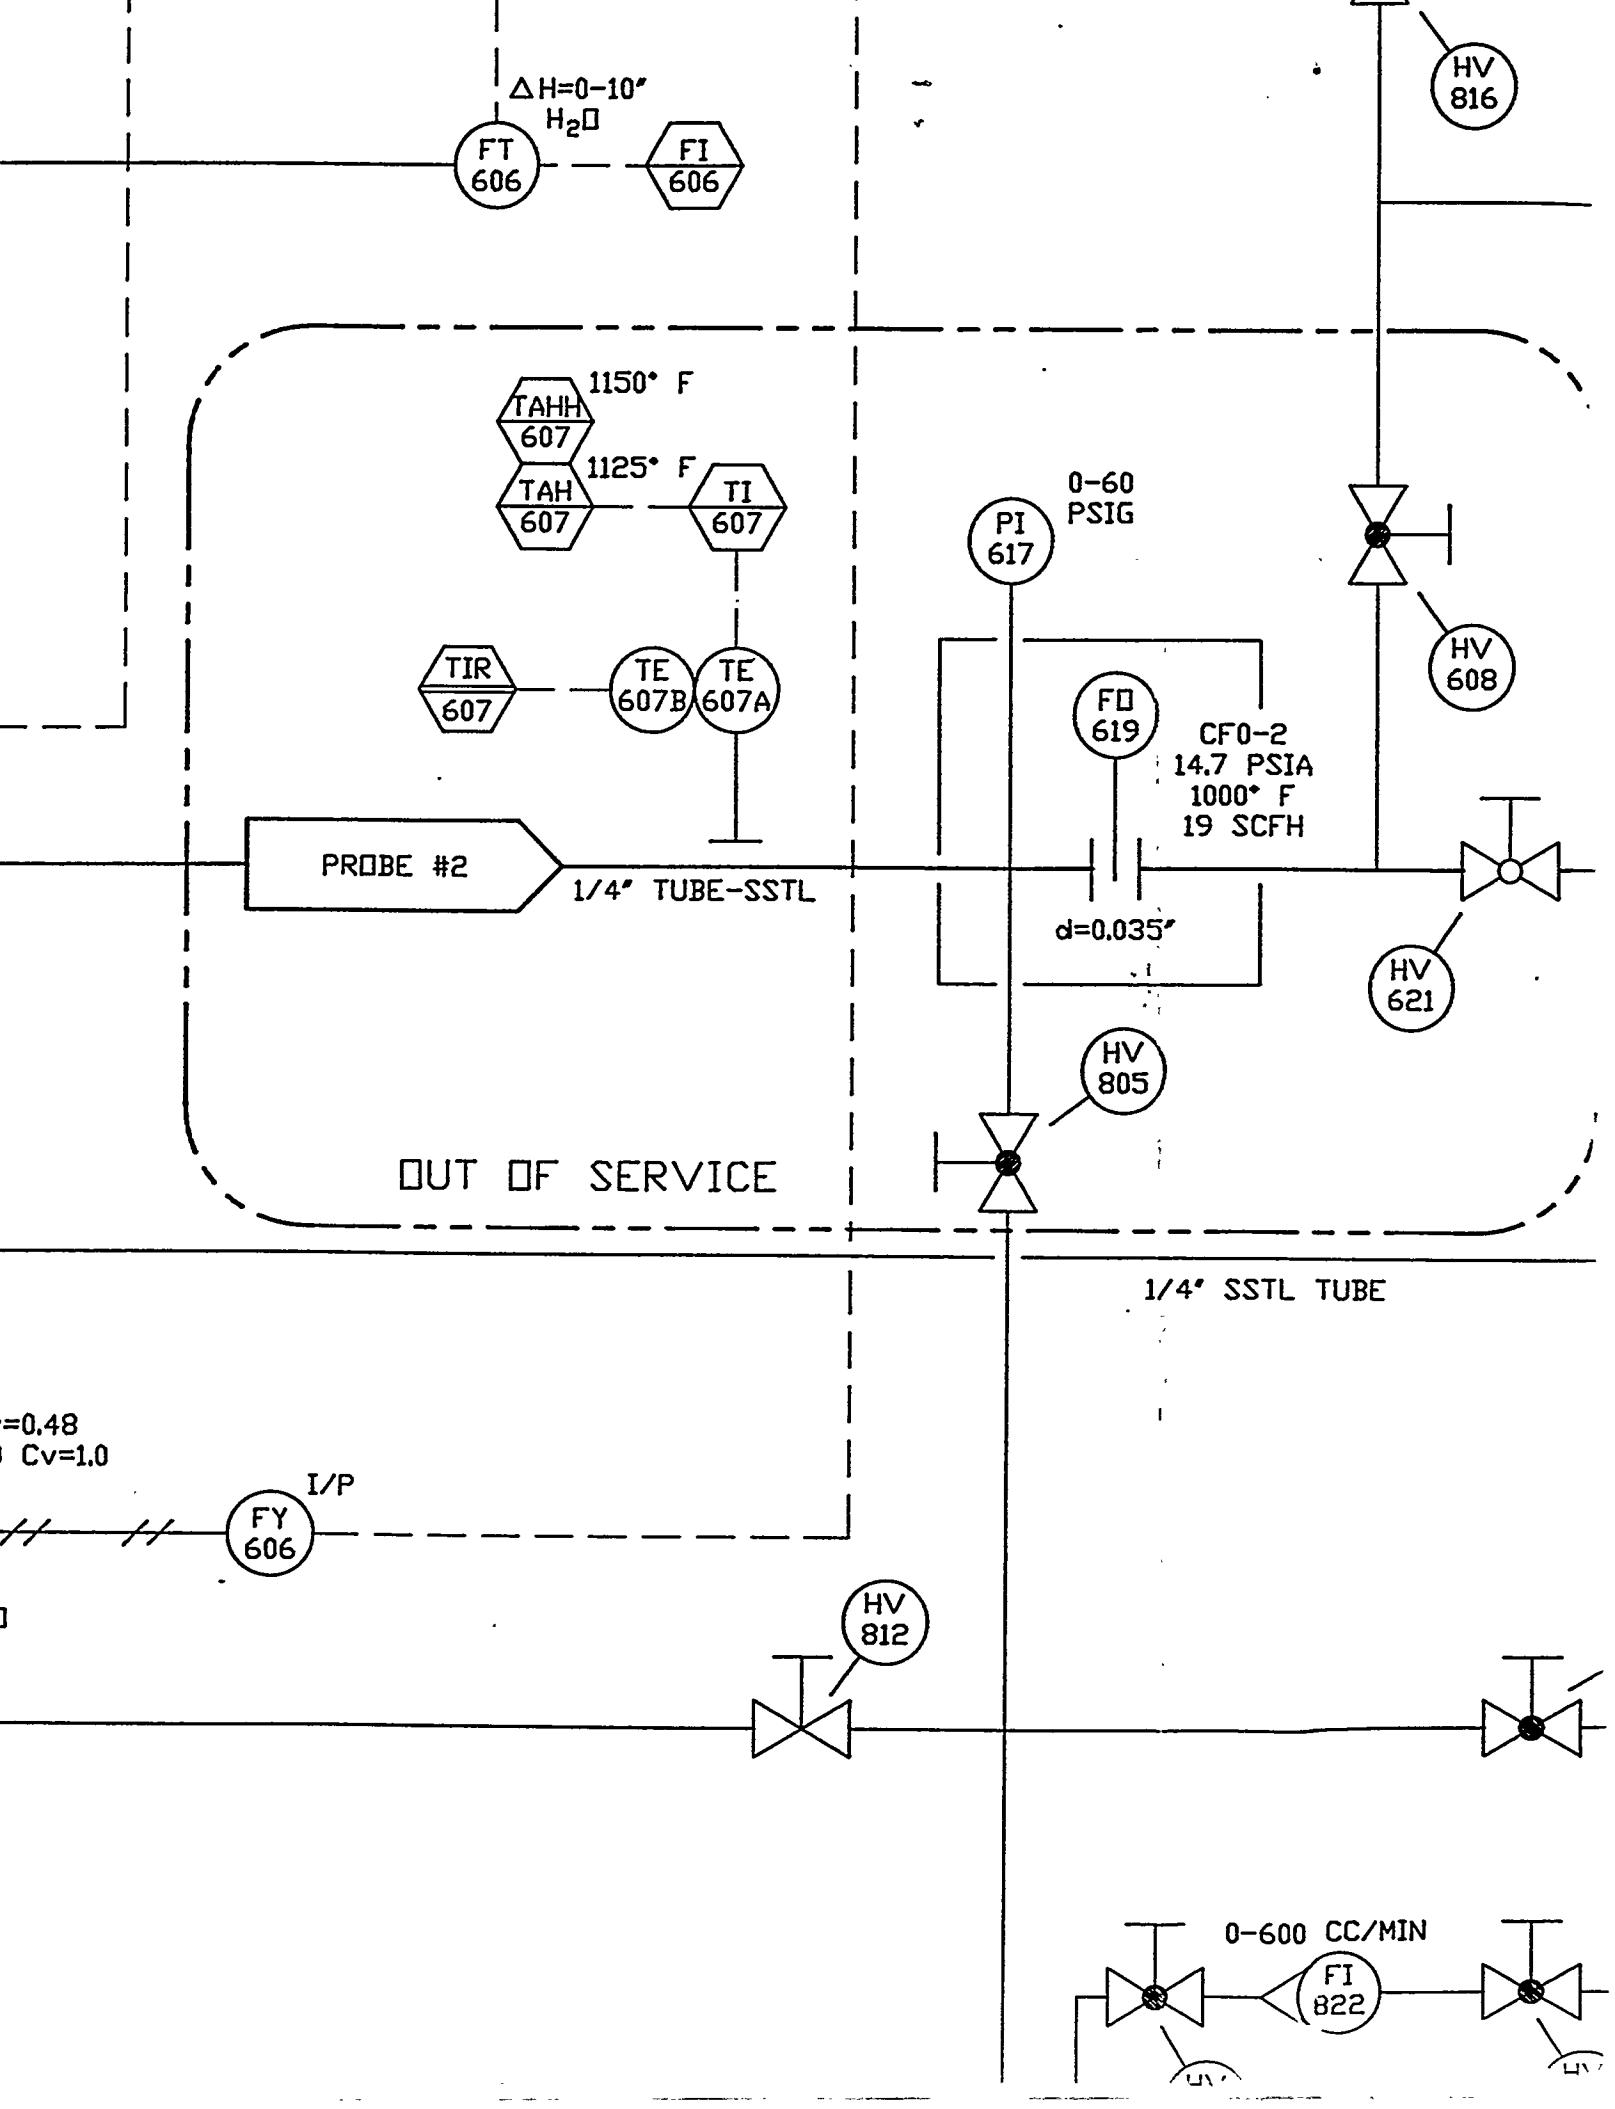

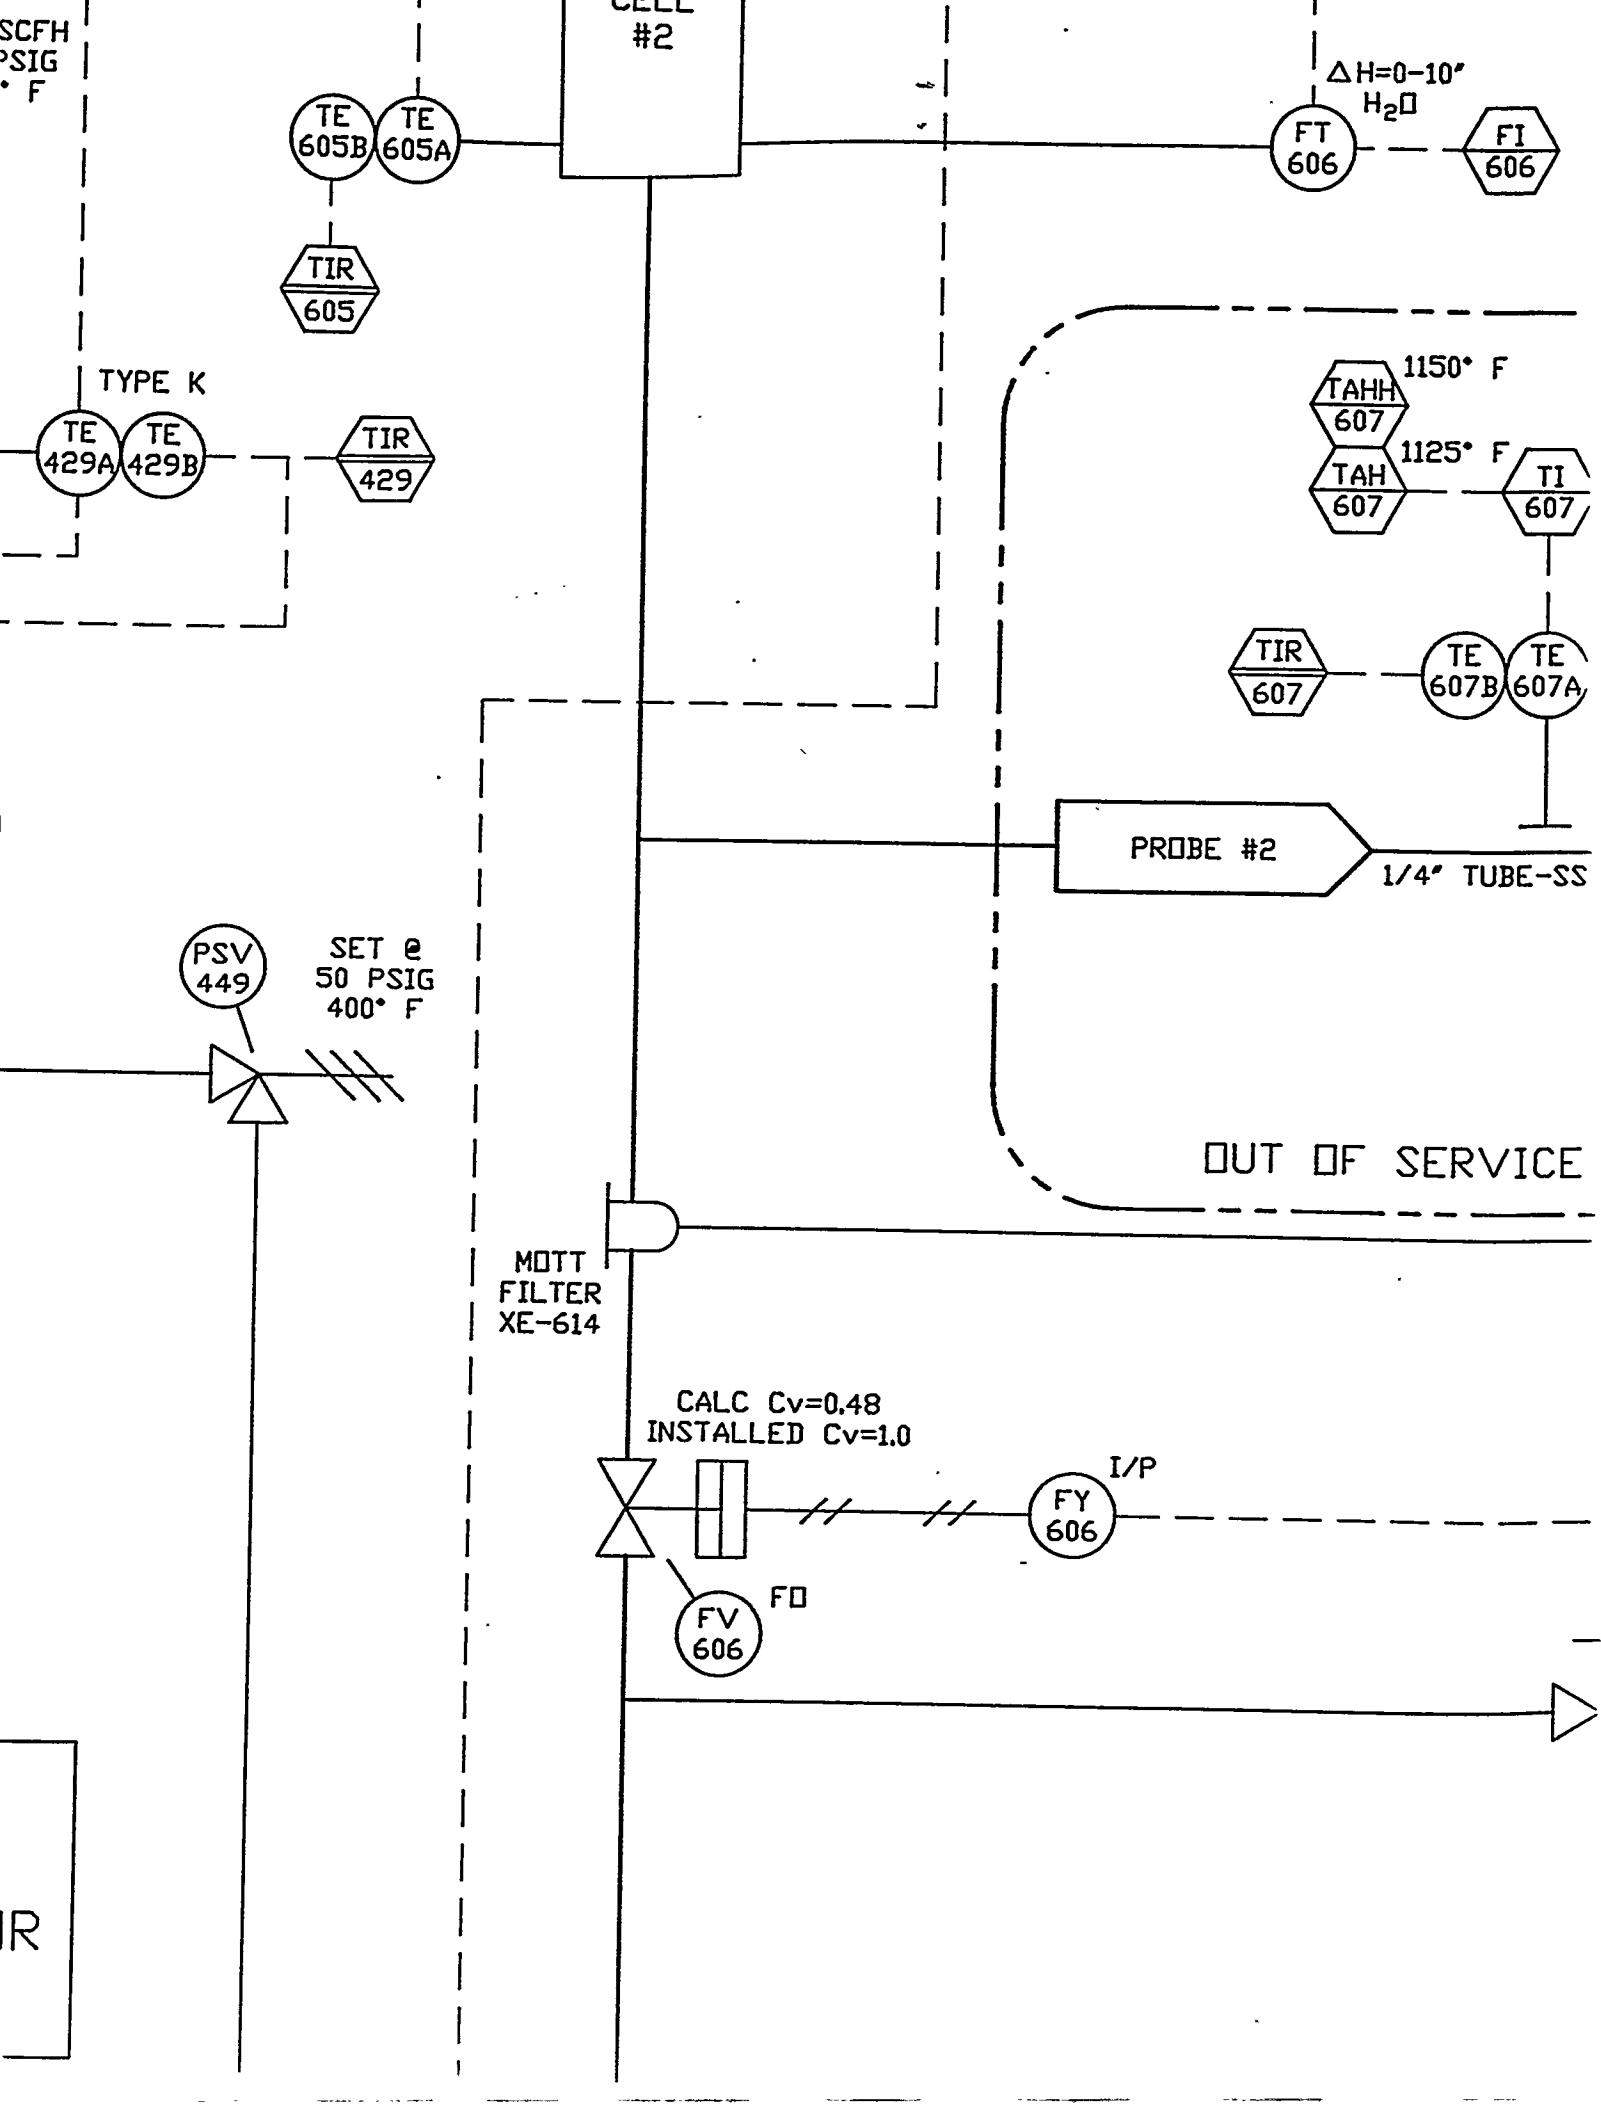

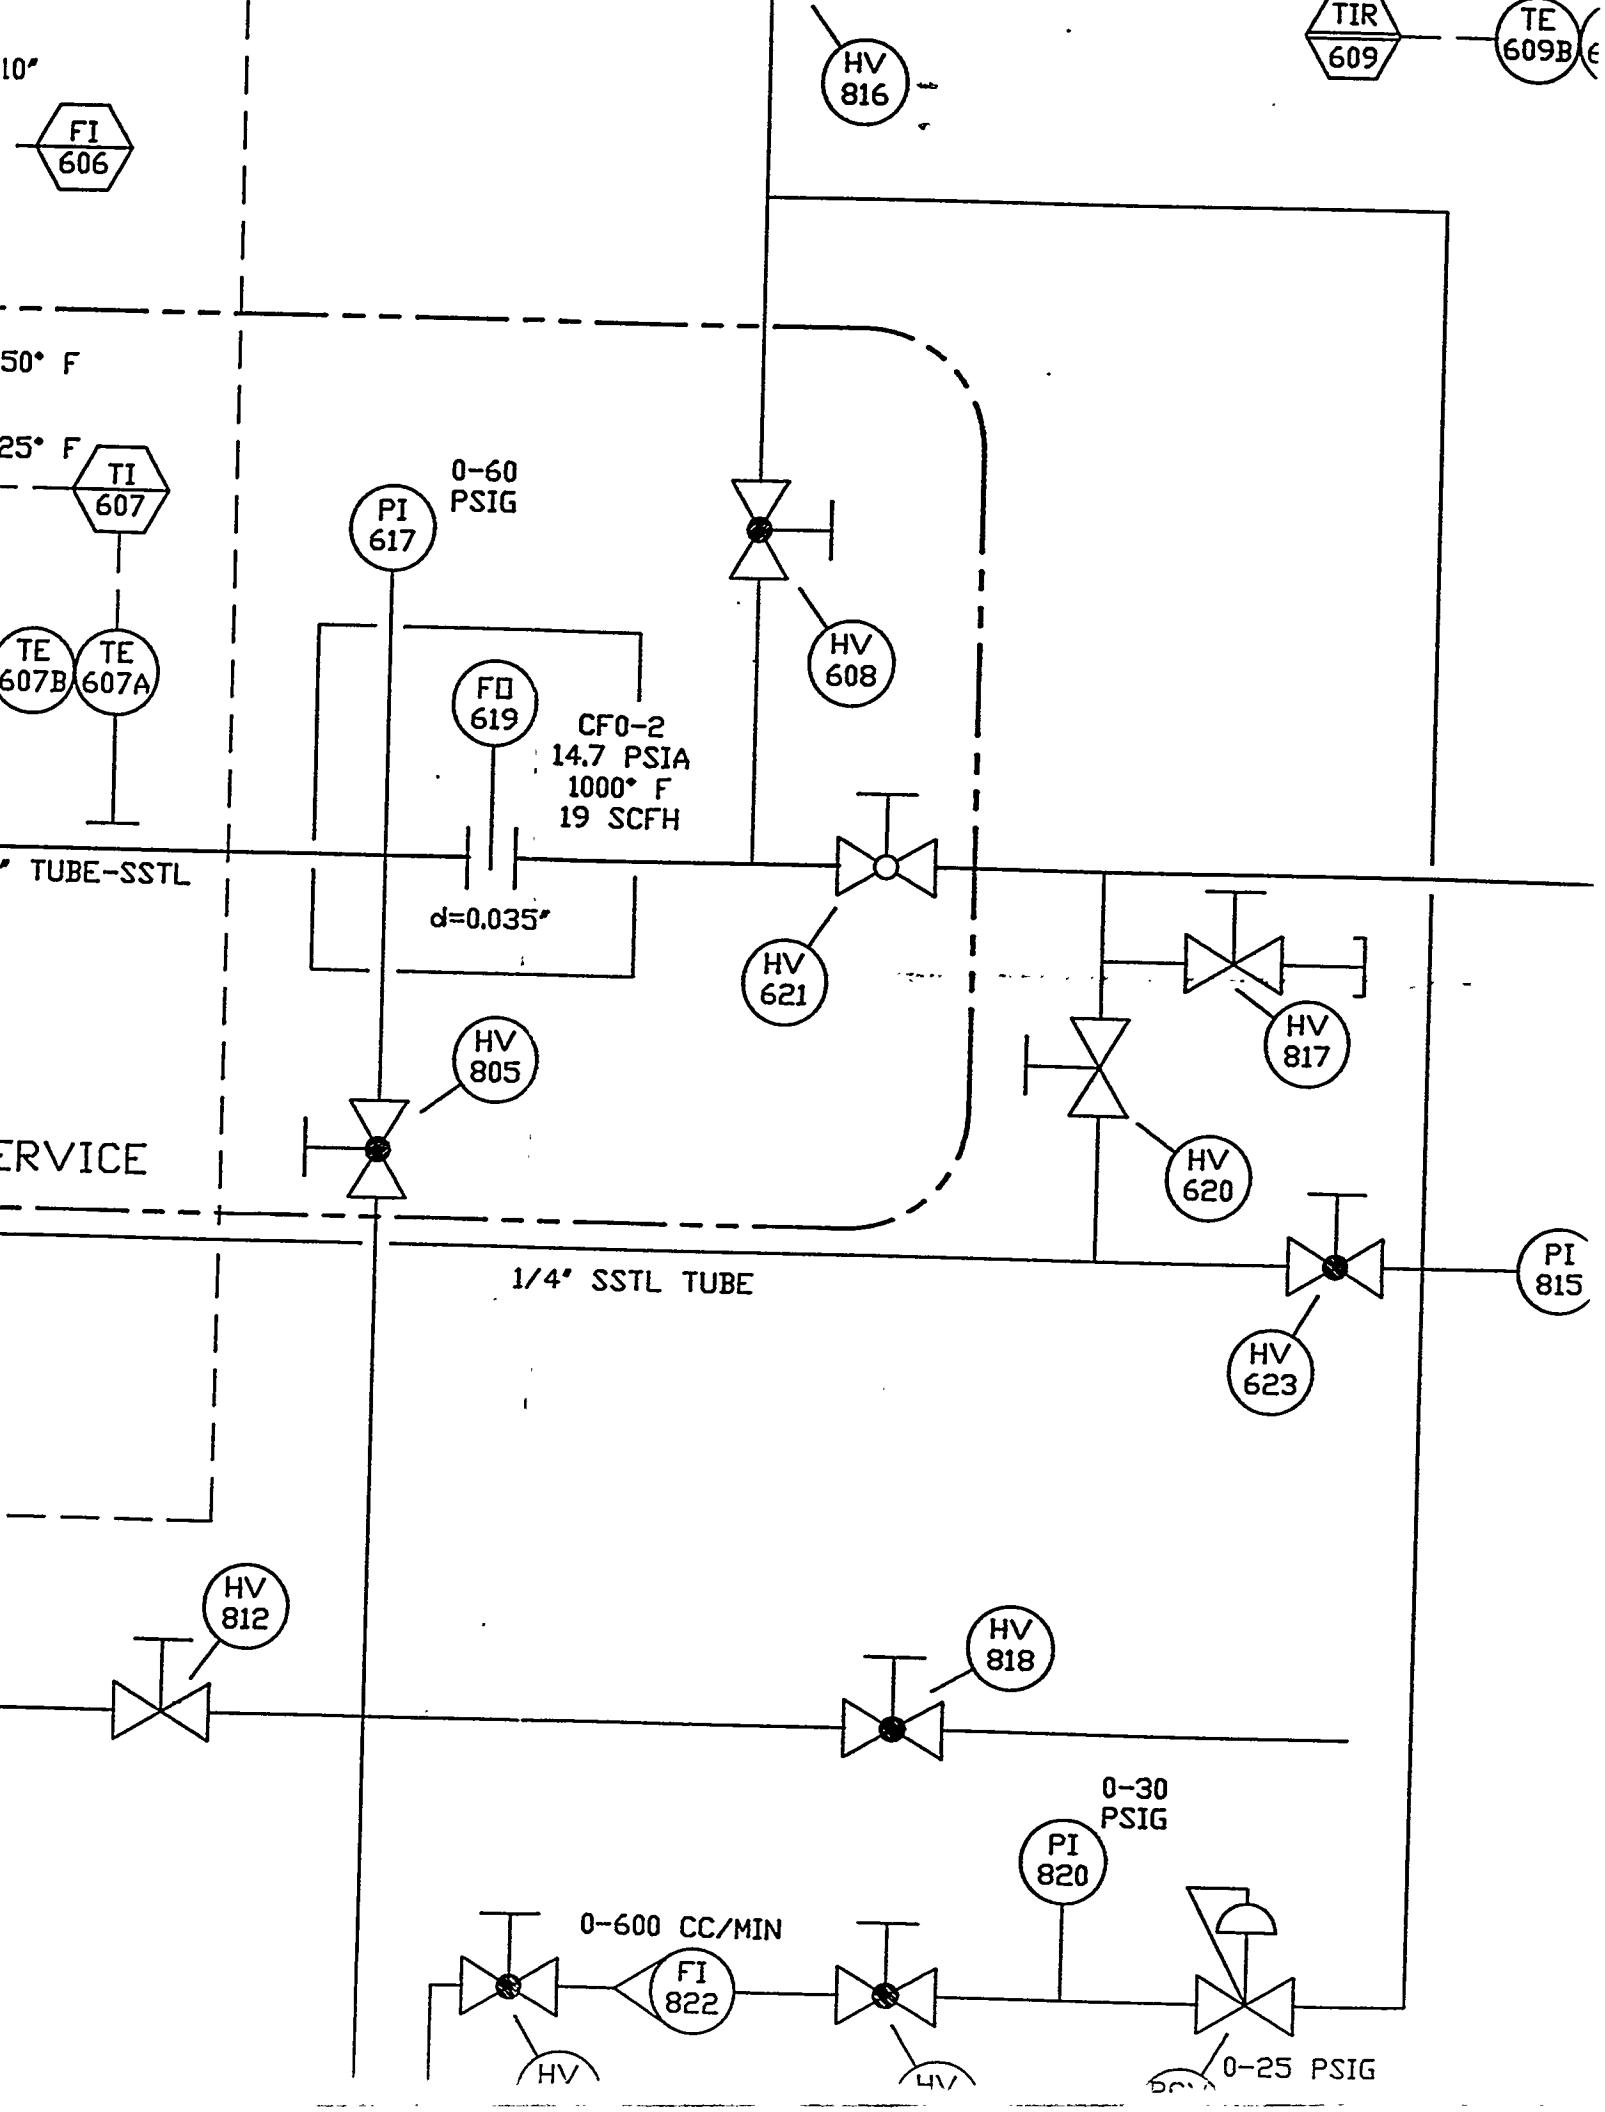

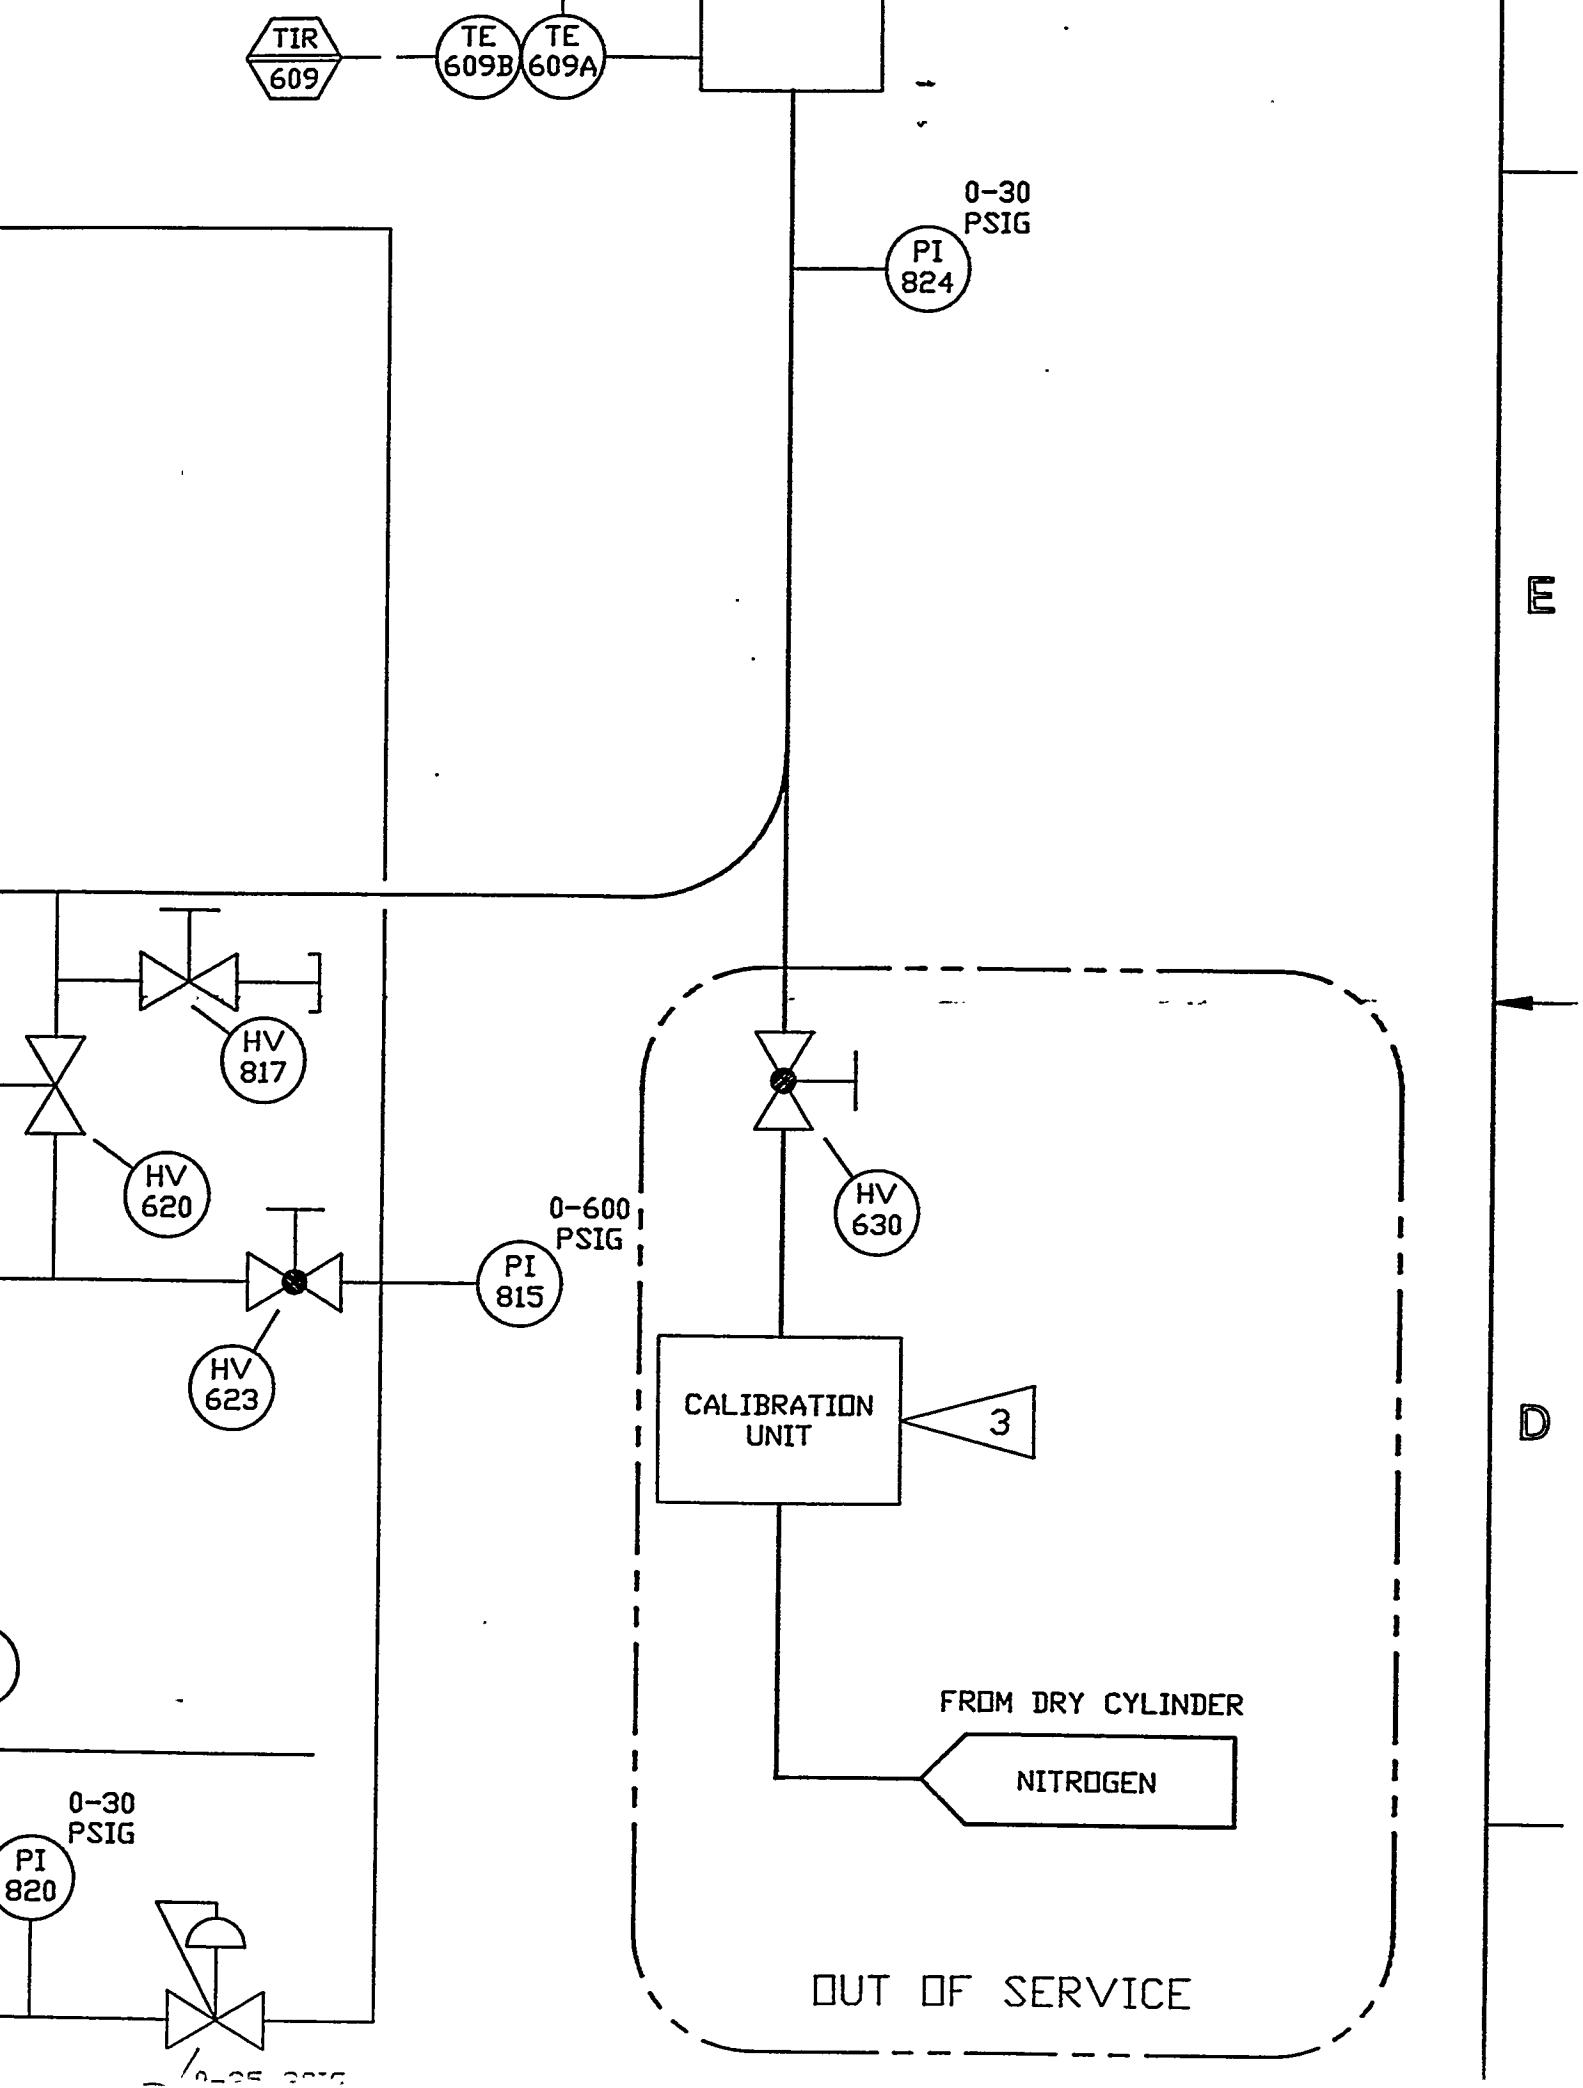

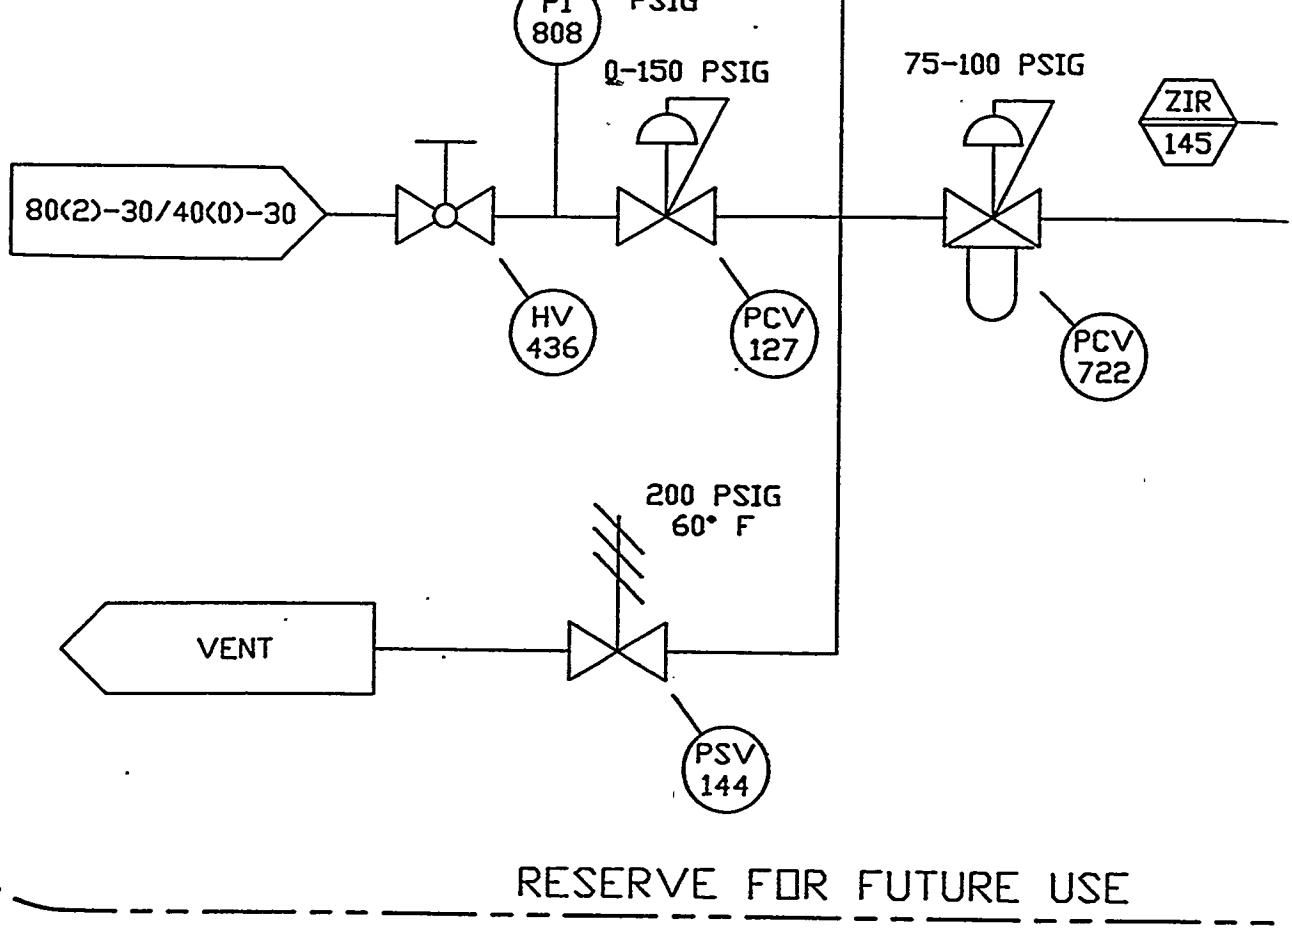

RESERVE FOR FUTURE USE

NOTES:

(1) "NOTE REMOVED"

(2) "NOTE REMOVED"

3 SUPPLIED BY AMES

(4) PREV. TAG # BLOCK RANGE ALLOCATED FOR THIS P&ID:
425-450, 600-650, 701-725
CURRENT BLOCK RANGE 800-850


(5) LAST TAG No. USED: HV-826


6 COMMERCIALLY PURCHASED UNIT: MODEL No. PMS CSASP +

7 COMMERCIALLY PURCHASED UNIT: MODEL LINDBERG; TYPE


(8) TIR-609 AND FIR-611 ARE USED FOR MASS FLOW CALCUL

PMS-432 PARTICLE MONITOR

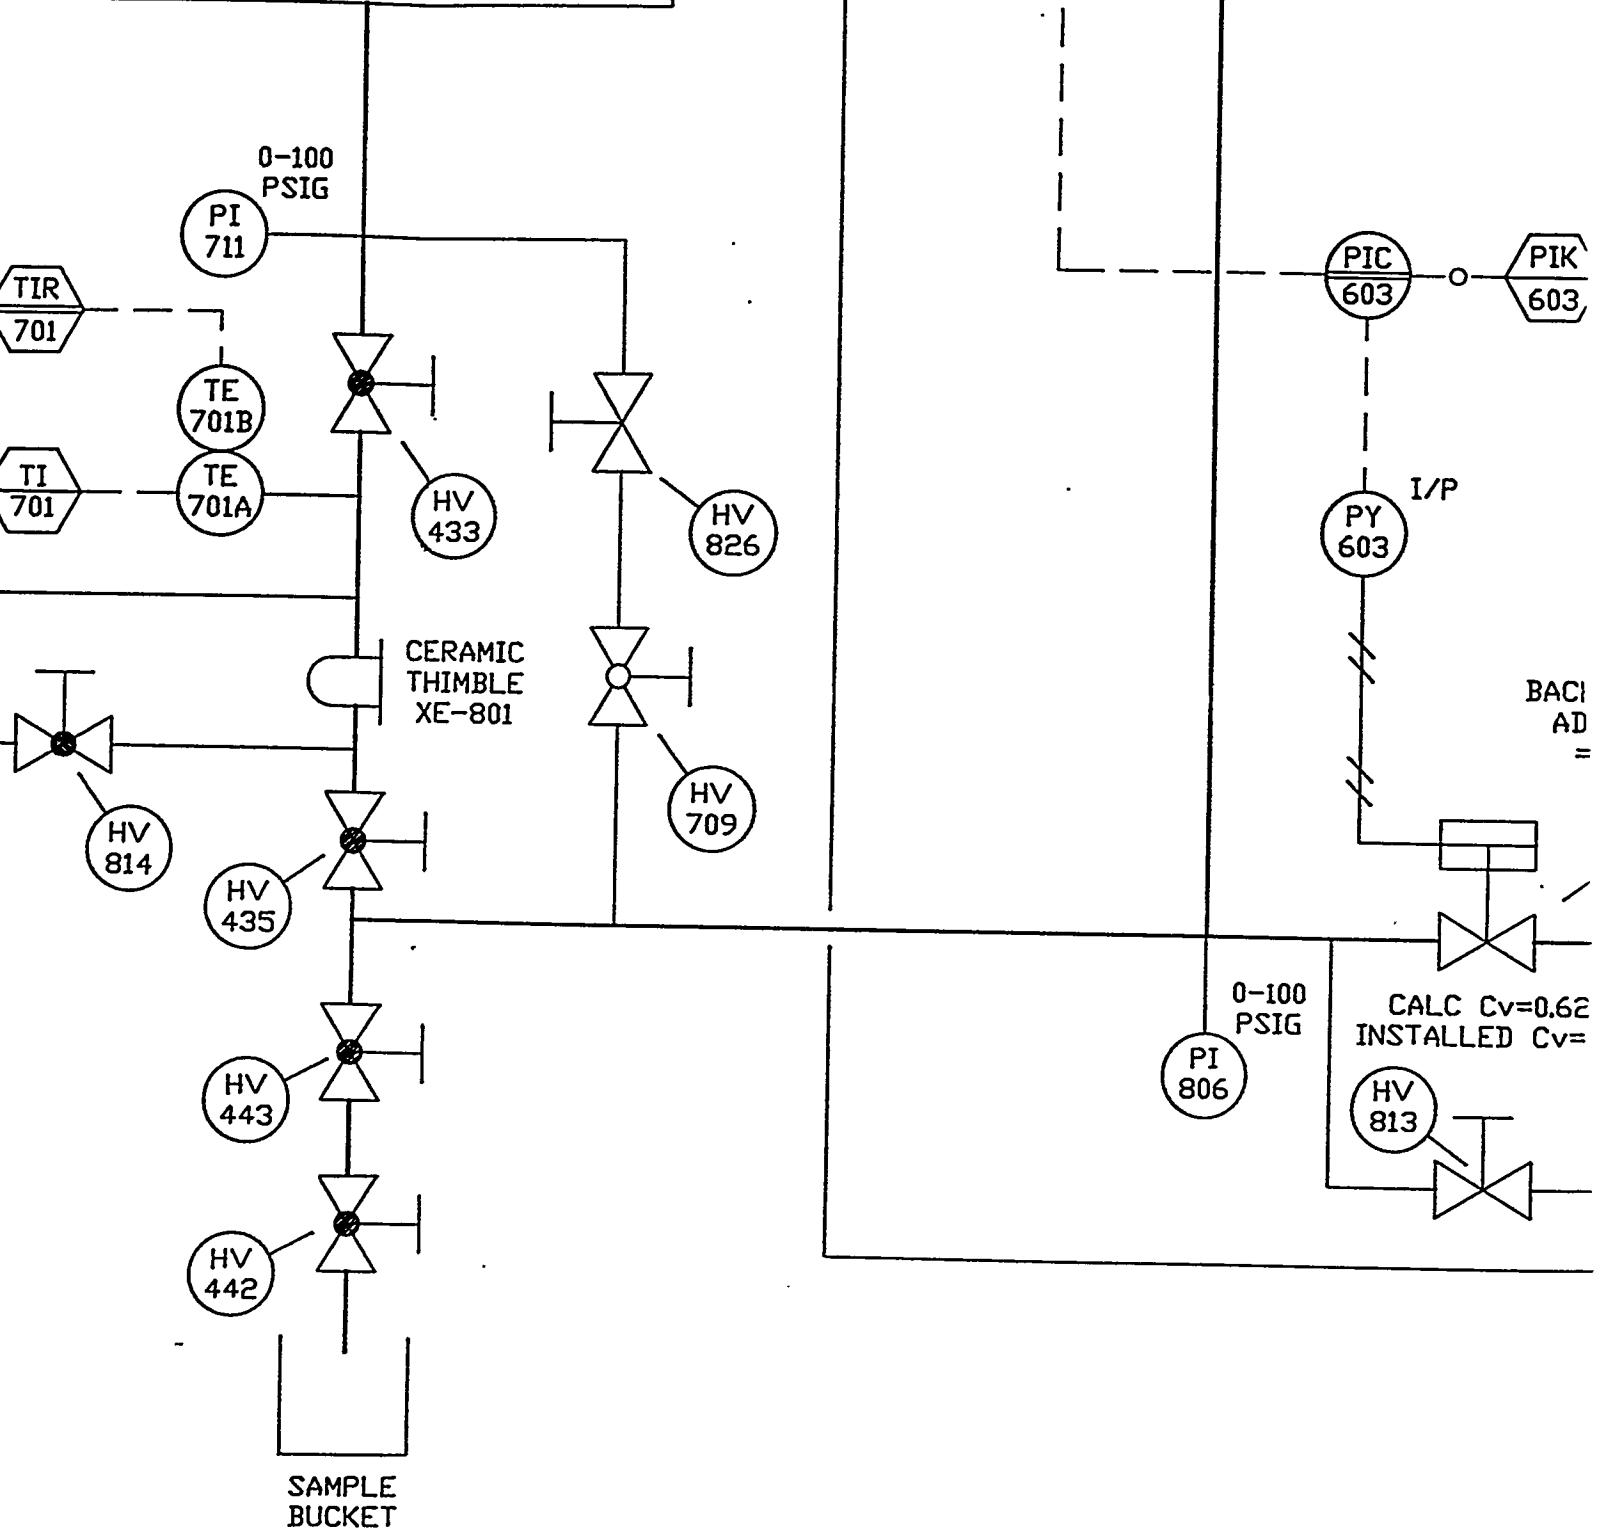

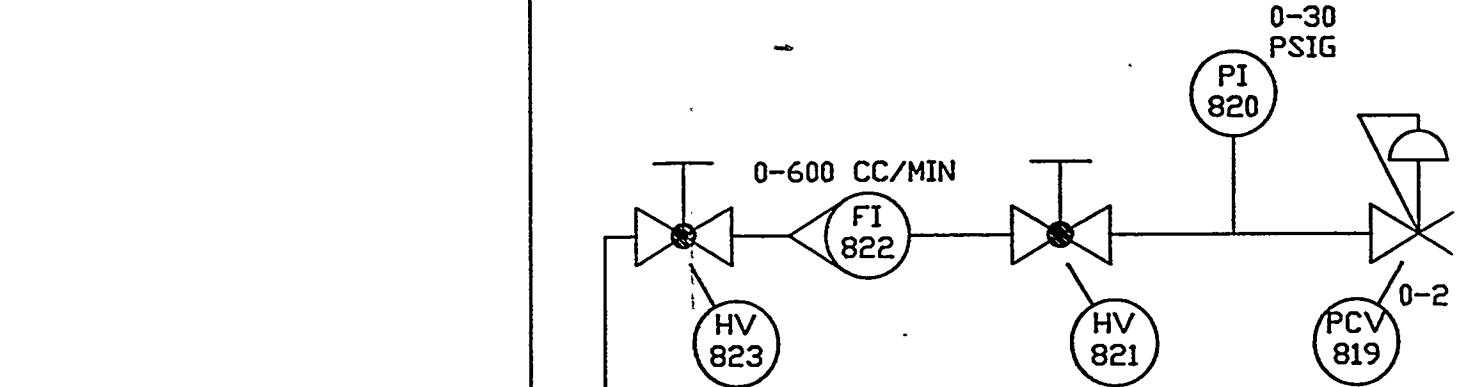

SET @
0 PSIG

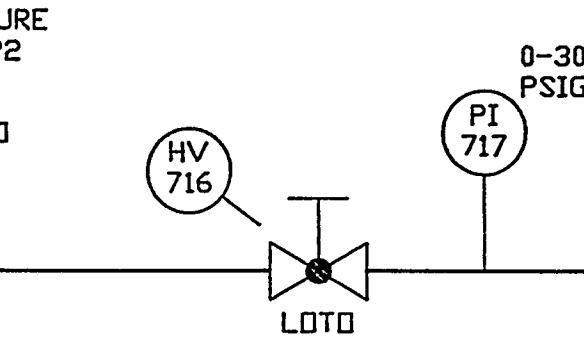


MGCR
INCINERATOR
HEADER

REDRAWN FROM

ECN NO	DESCRIPTION	REFERENCE DRAWINGS
1		
2		

DRAFTER
Gary Kulchc
CHECKER
S. Canko
DESIGNER
Dave Lunife
RESPONSIBLE PERSON
-NA-
ESTH

NITROGEN

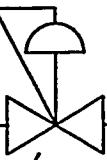0-30
PSIGPI
820

0-25 PSIG

PCV
819

OUT OF SERVICE

C

Dwg No

E 940040

1
SH

WN FROM DRAWINGS STD930075 AND STD930008
WITH CHANGES

DRAFTER	Gary Kulchock	DATE	5/26/94
CHECKER	S. Canko	DATE	5/26/94
DESIGNER	Dave Lunifeld	DATE	5/26/94
RESPONSIBLE PERSON	-NA-	DATE	-NA-





United States Department of Energy
MORGANTOWN ENERGY TECHNOLOGY CENTER

Morgantown, WV

BUILDING 12


MCPP PARTICLE MEASURING

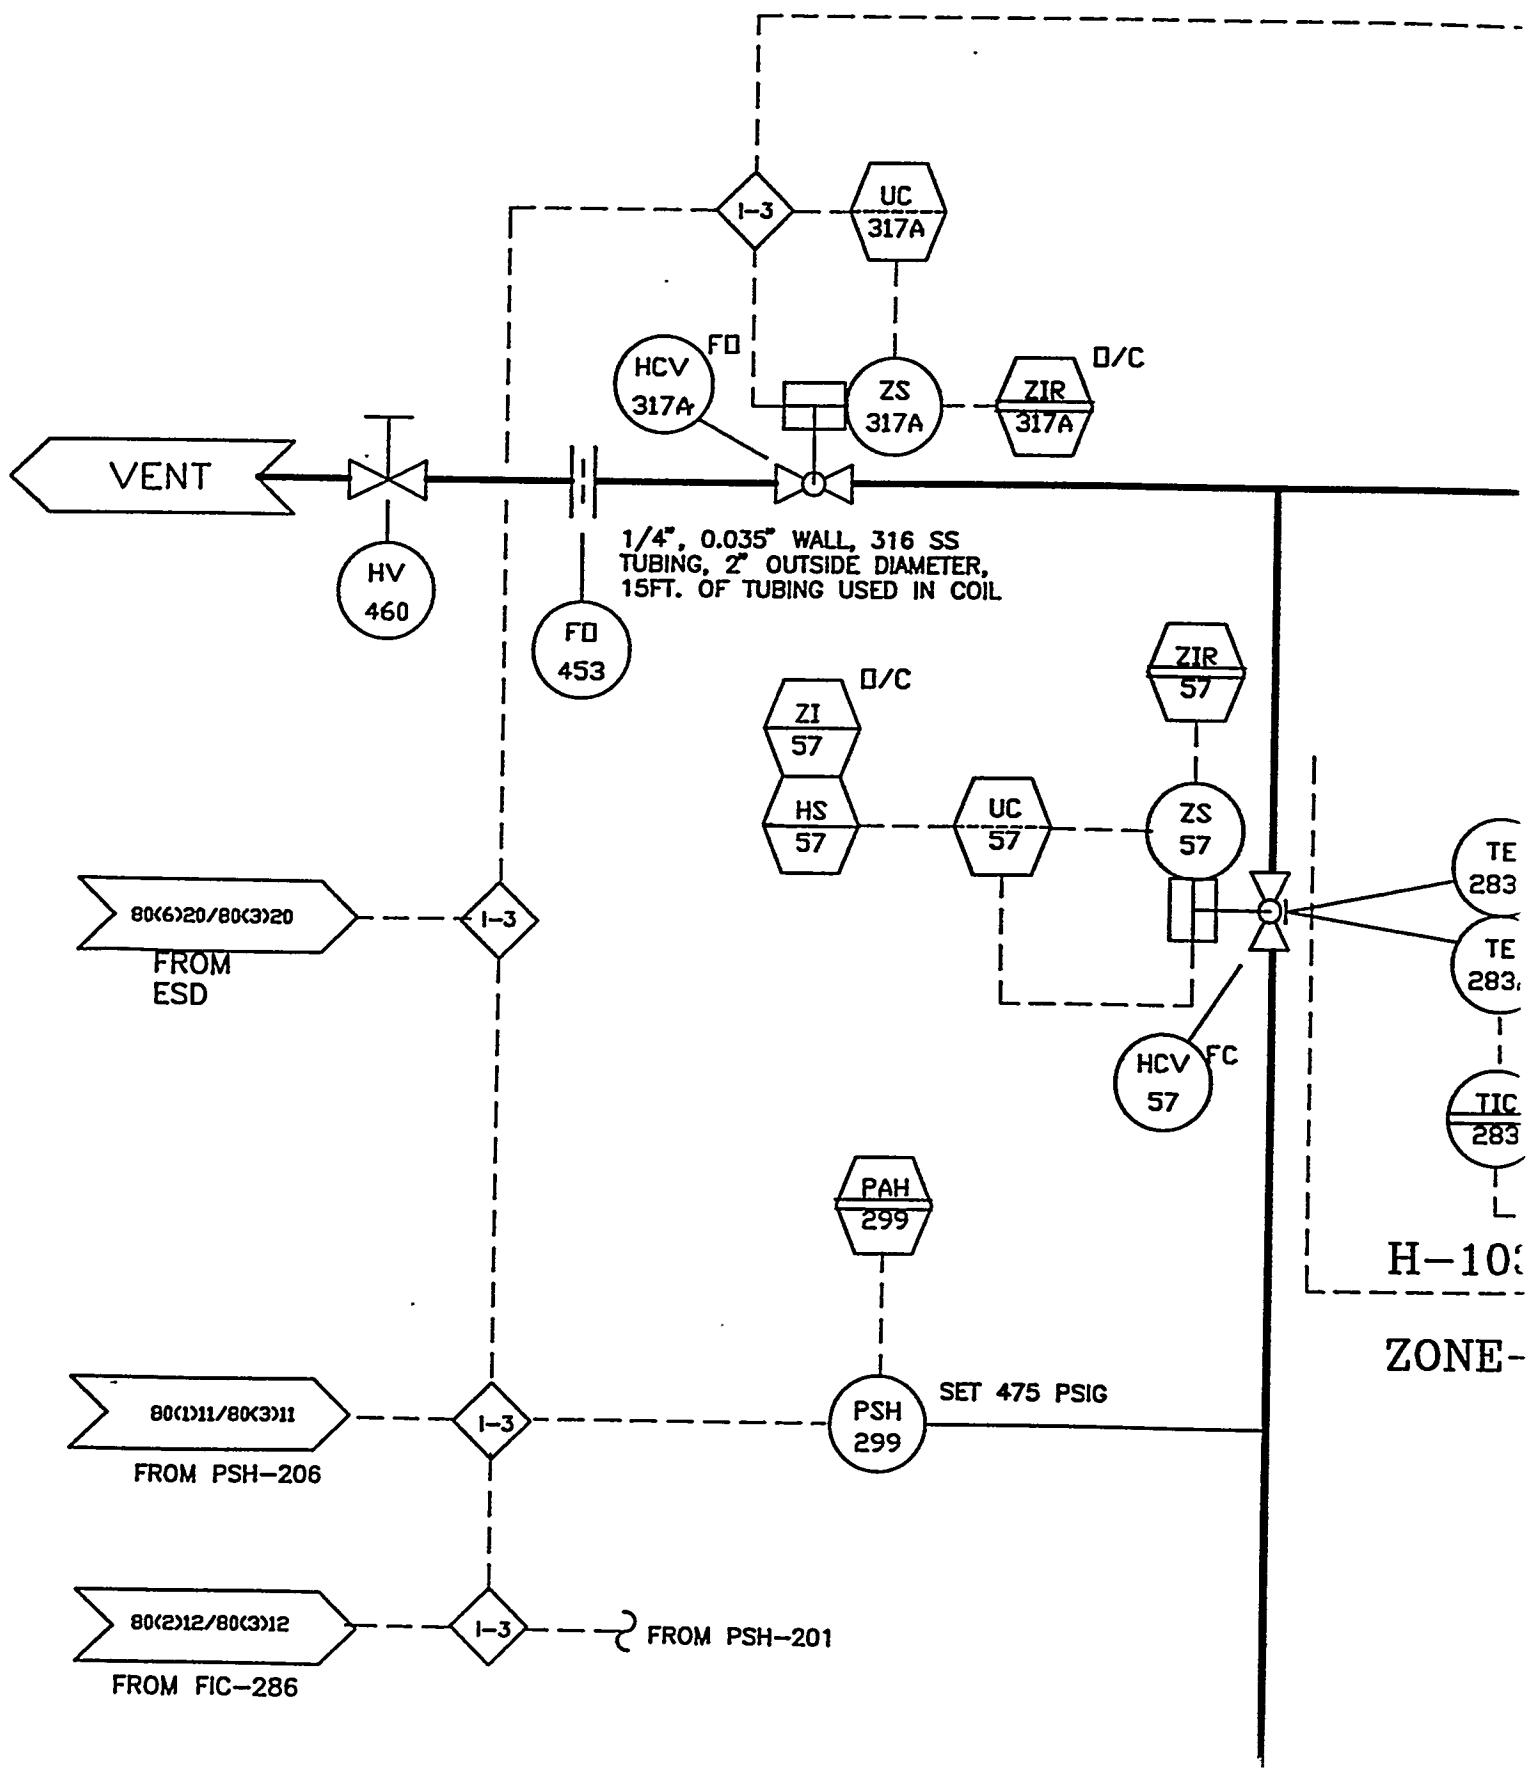

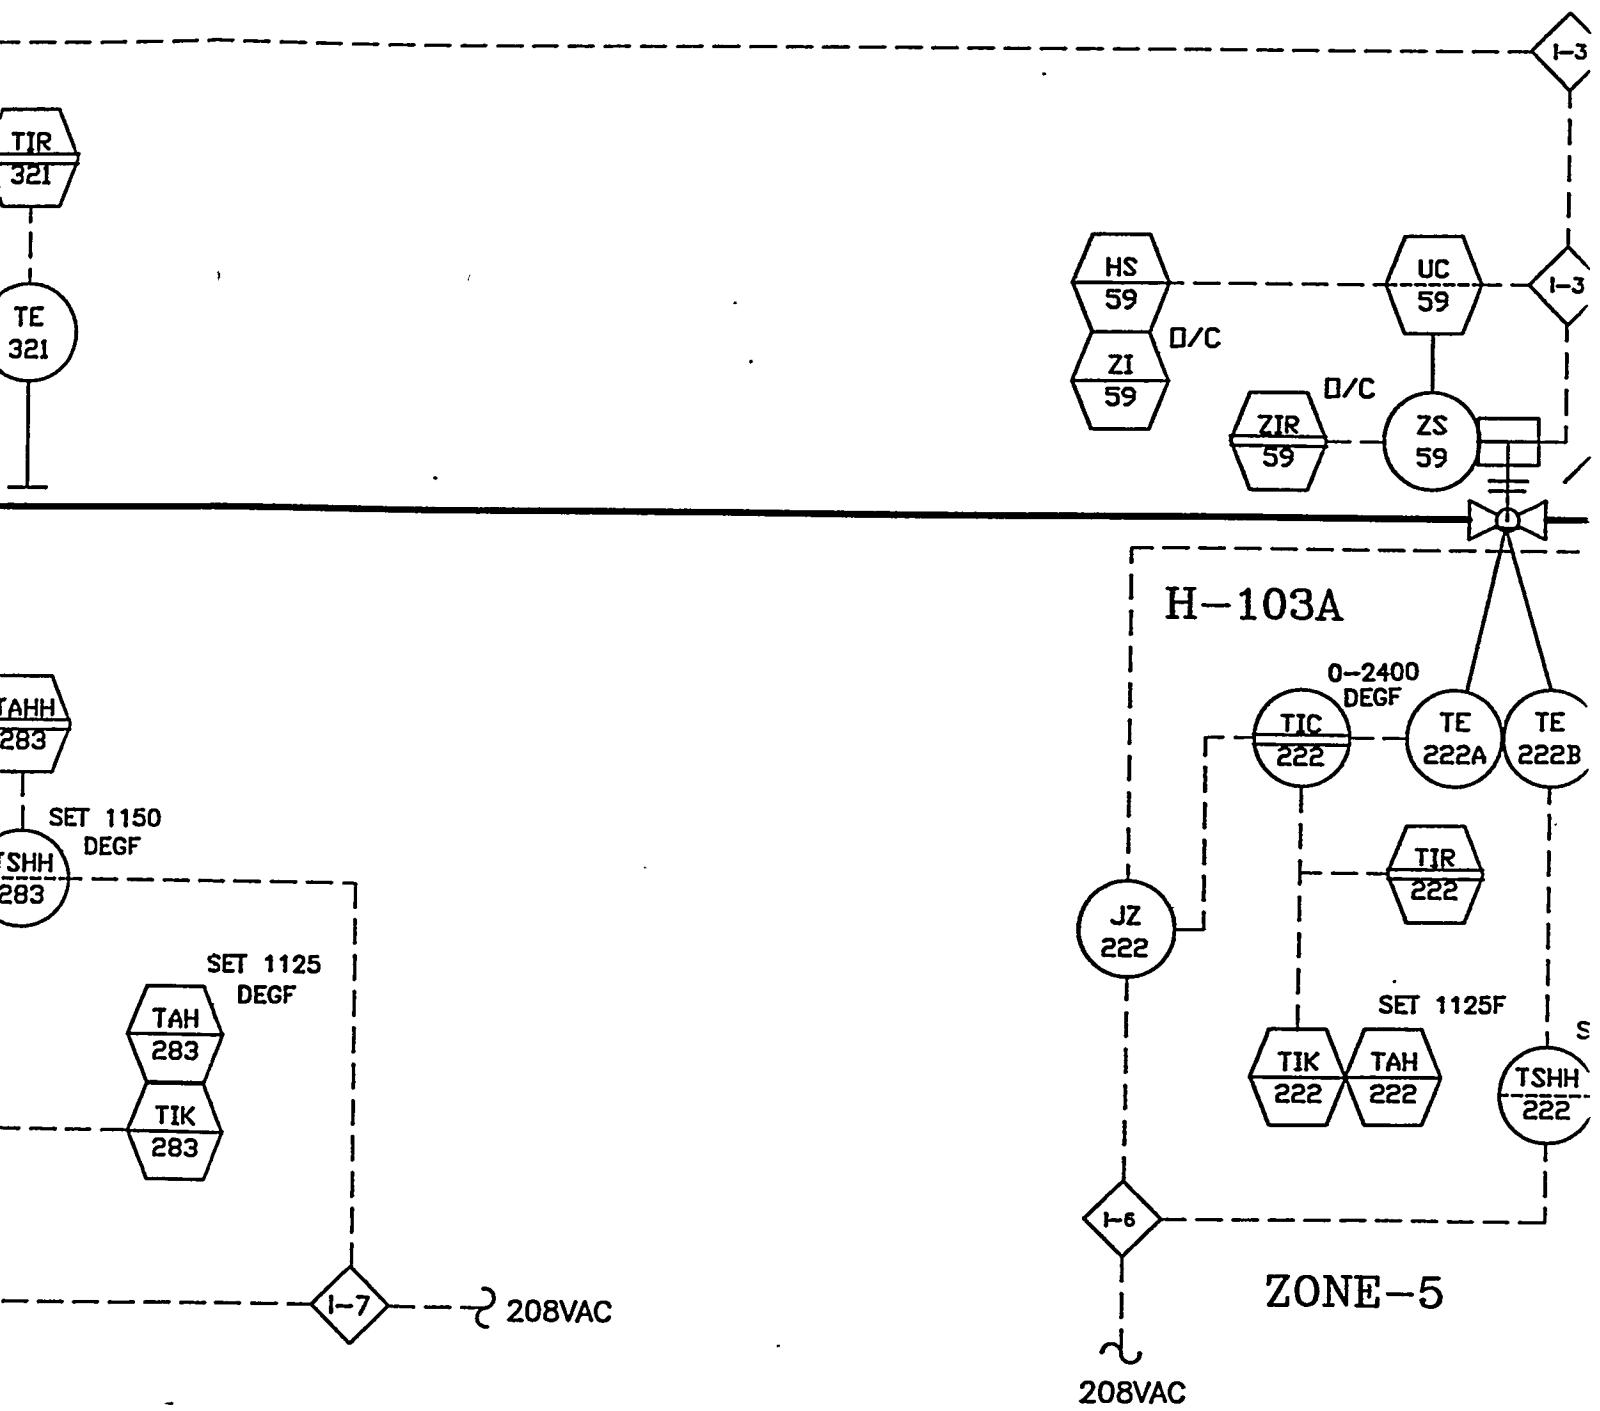

FC
CV
9150F
TAHH
2221" SS PIPE
P7 SCH 80BLIND
FLANG1/4", 0.035" WALL, 316 SS
TUBING, 2" OUTSIDE DIAMETER,
14FT. OF TUBING USED IN COIL.

TO INCINERATOR

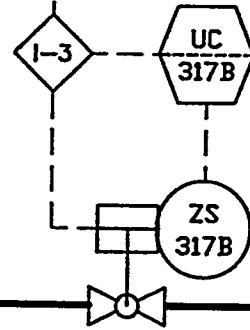FSV
452FD
451

FO

HCV
317B

FILTER BLOWBACK LINE

80(2)2/80(3)2 FROM YZ-82

80(2)3/80(3)3 FROM YZ-81

80(2)4/80(3)4 FROM YZ-80


80(2)5/80(3)5 FROM YZ-79

ZONE
GEN.
DRAFTER GARY
EGG ESI W.E. L
ZONE
GEN.
DRAFTER C.J.
EGG ESI N.O.

GASIFIER

SIDESTREAM

TO I-3

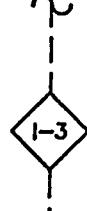

PSH
201

PAHR
201

SET 340
PSIG

80(3)22/80(2)22

I-20

PSL
152

SET 250
PSIG

PALR
152


PDIR
155


REVISION



ZONE	REV	DESCRIPTION						DATE
GEN.	6	MODIFIED AS PER MARKED PRINT; ISSUED FOR CONSTRUCTION						5/16/94
RAFTER GARY J. KULCHOCK	DATE 5/18/94	CHECKER S. CONKO	DATE 5/18/94	EG&G RESPONSIBLE ENGR. DAVID LUNIFELD	DATE 5/24/94	REVIEWER		DATE
G&G E&SH W.E. LOWRY	DATE 5/24/94	PROJECT ENGR. S. RENNINGER	DATE 5/18/94	BRANCH MANAGER JOHN M. RICKY	DATE 5/18/94	DOE (EDSTD) JOHN R. ROTUNDA	WJA	DATE 5/18/94
ZONE	REV	DESCRIPTION						DATE
GEN.	7	MODIFIED AS PER MARKED PRINT; ISSUED FOR CONSTRUCTION						9/30/94
DRAFTER G.J. Kulchock	DATE 10-3-94	CHECKER S. Conko	DATE 10/3/94	EG&G RESPONSIBLE ENGR. David Lunifeld	DATE 10/5/94	REVIEWER		DATE
G&G E&SH W.E. Lowry	DATE 10/11/94	PROJECT ENGR. S. Renninger	DATE 10/11/94	BRANCH MANAGER	DATE	DOE (EDSTD) G.L. / A.C. - WJA		DATE 10/15/94

TO BE ADDED FOR CONTINOUS MODE OPERATIONS

FROM
F-101
INLET

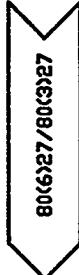


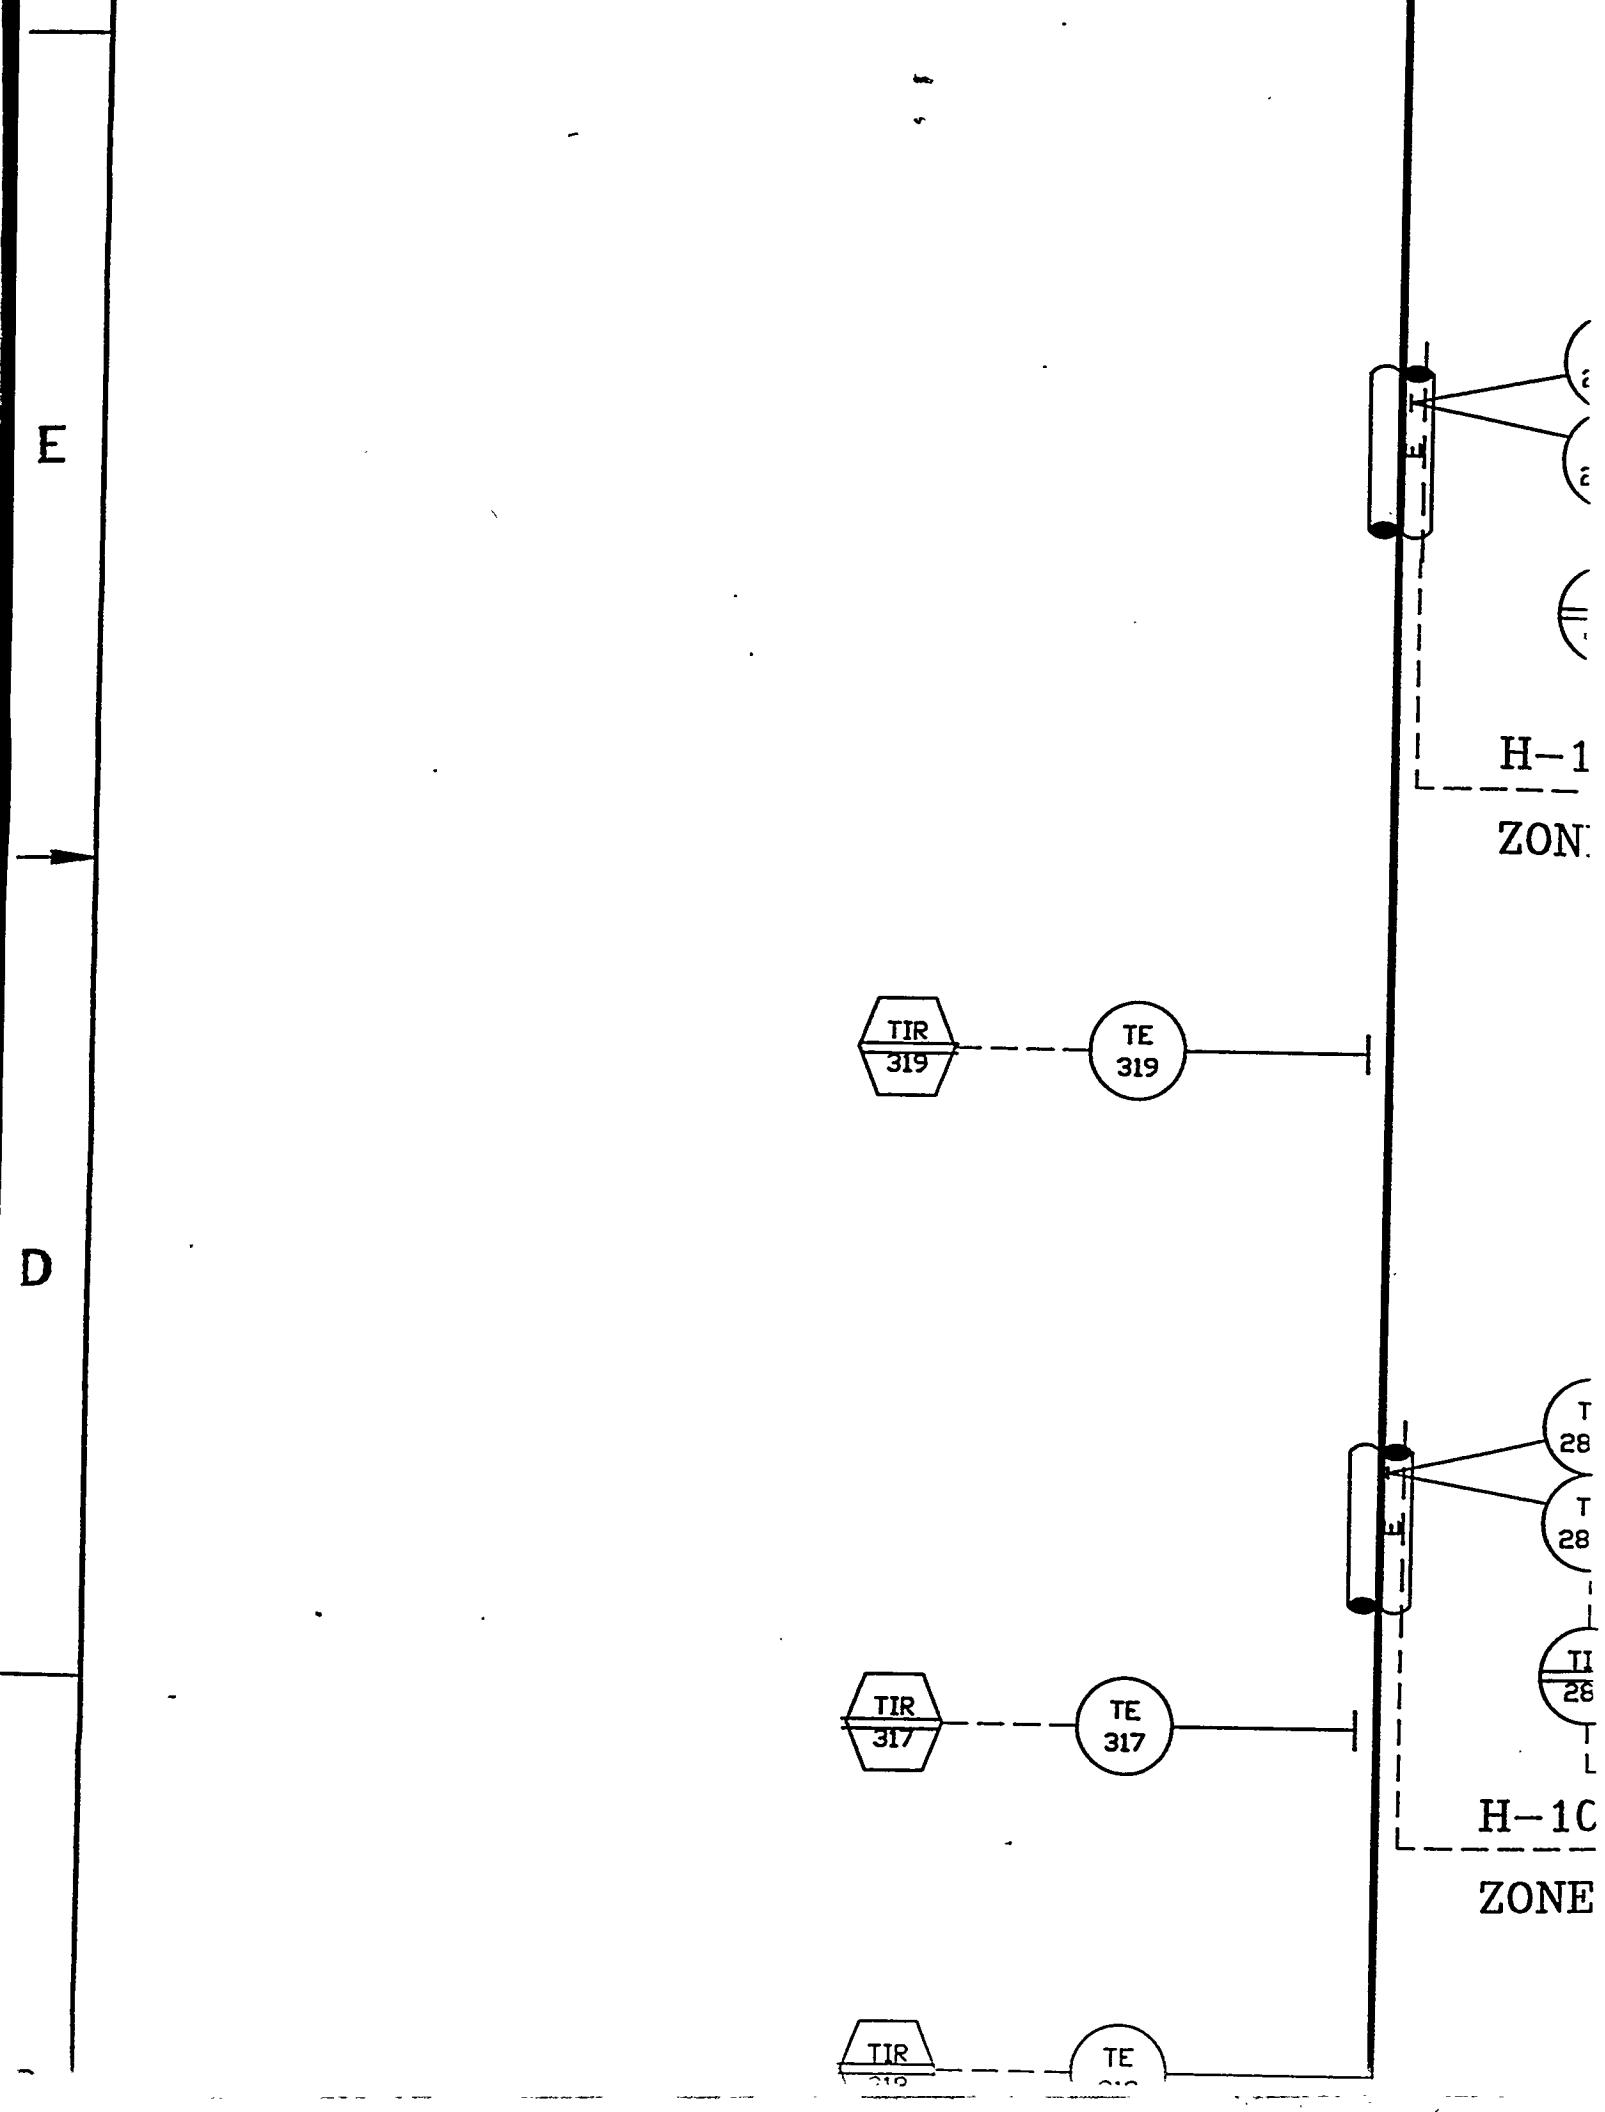


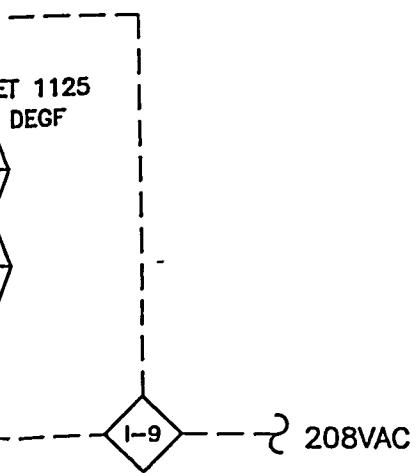
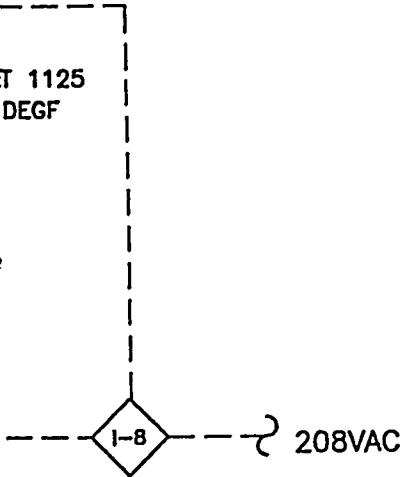




0-60
PSIC

RUPTL
350 PS

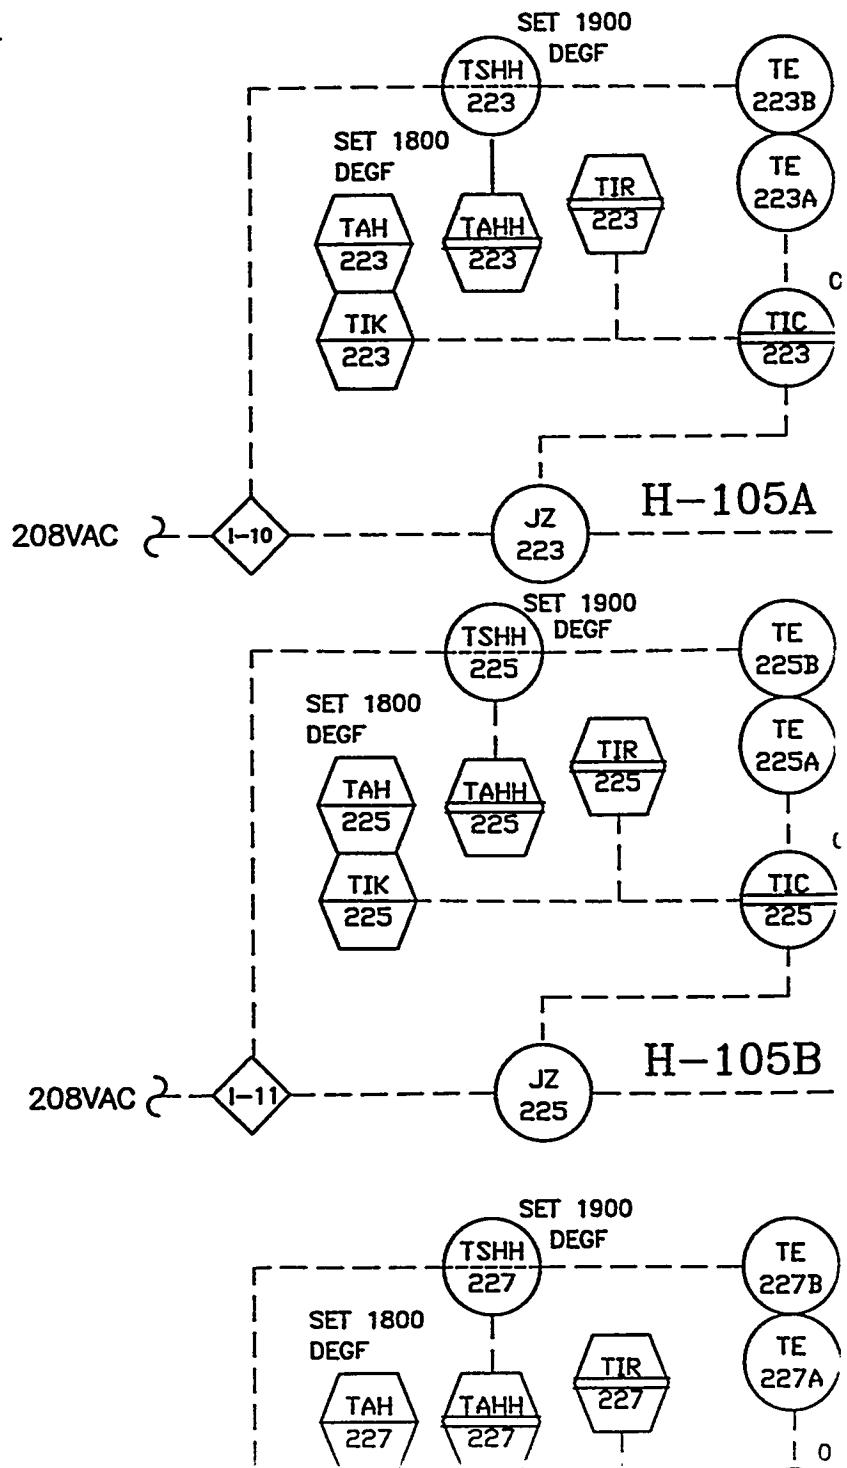


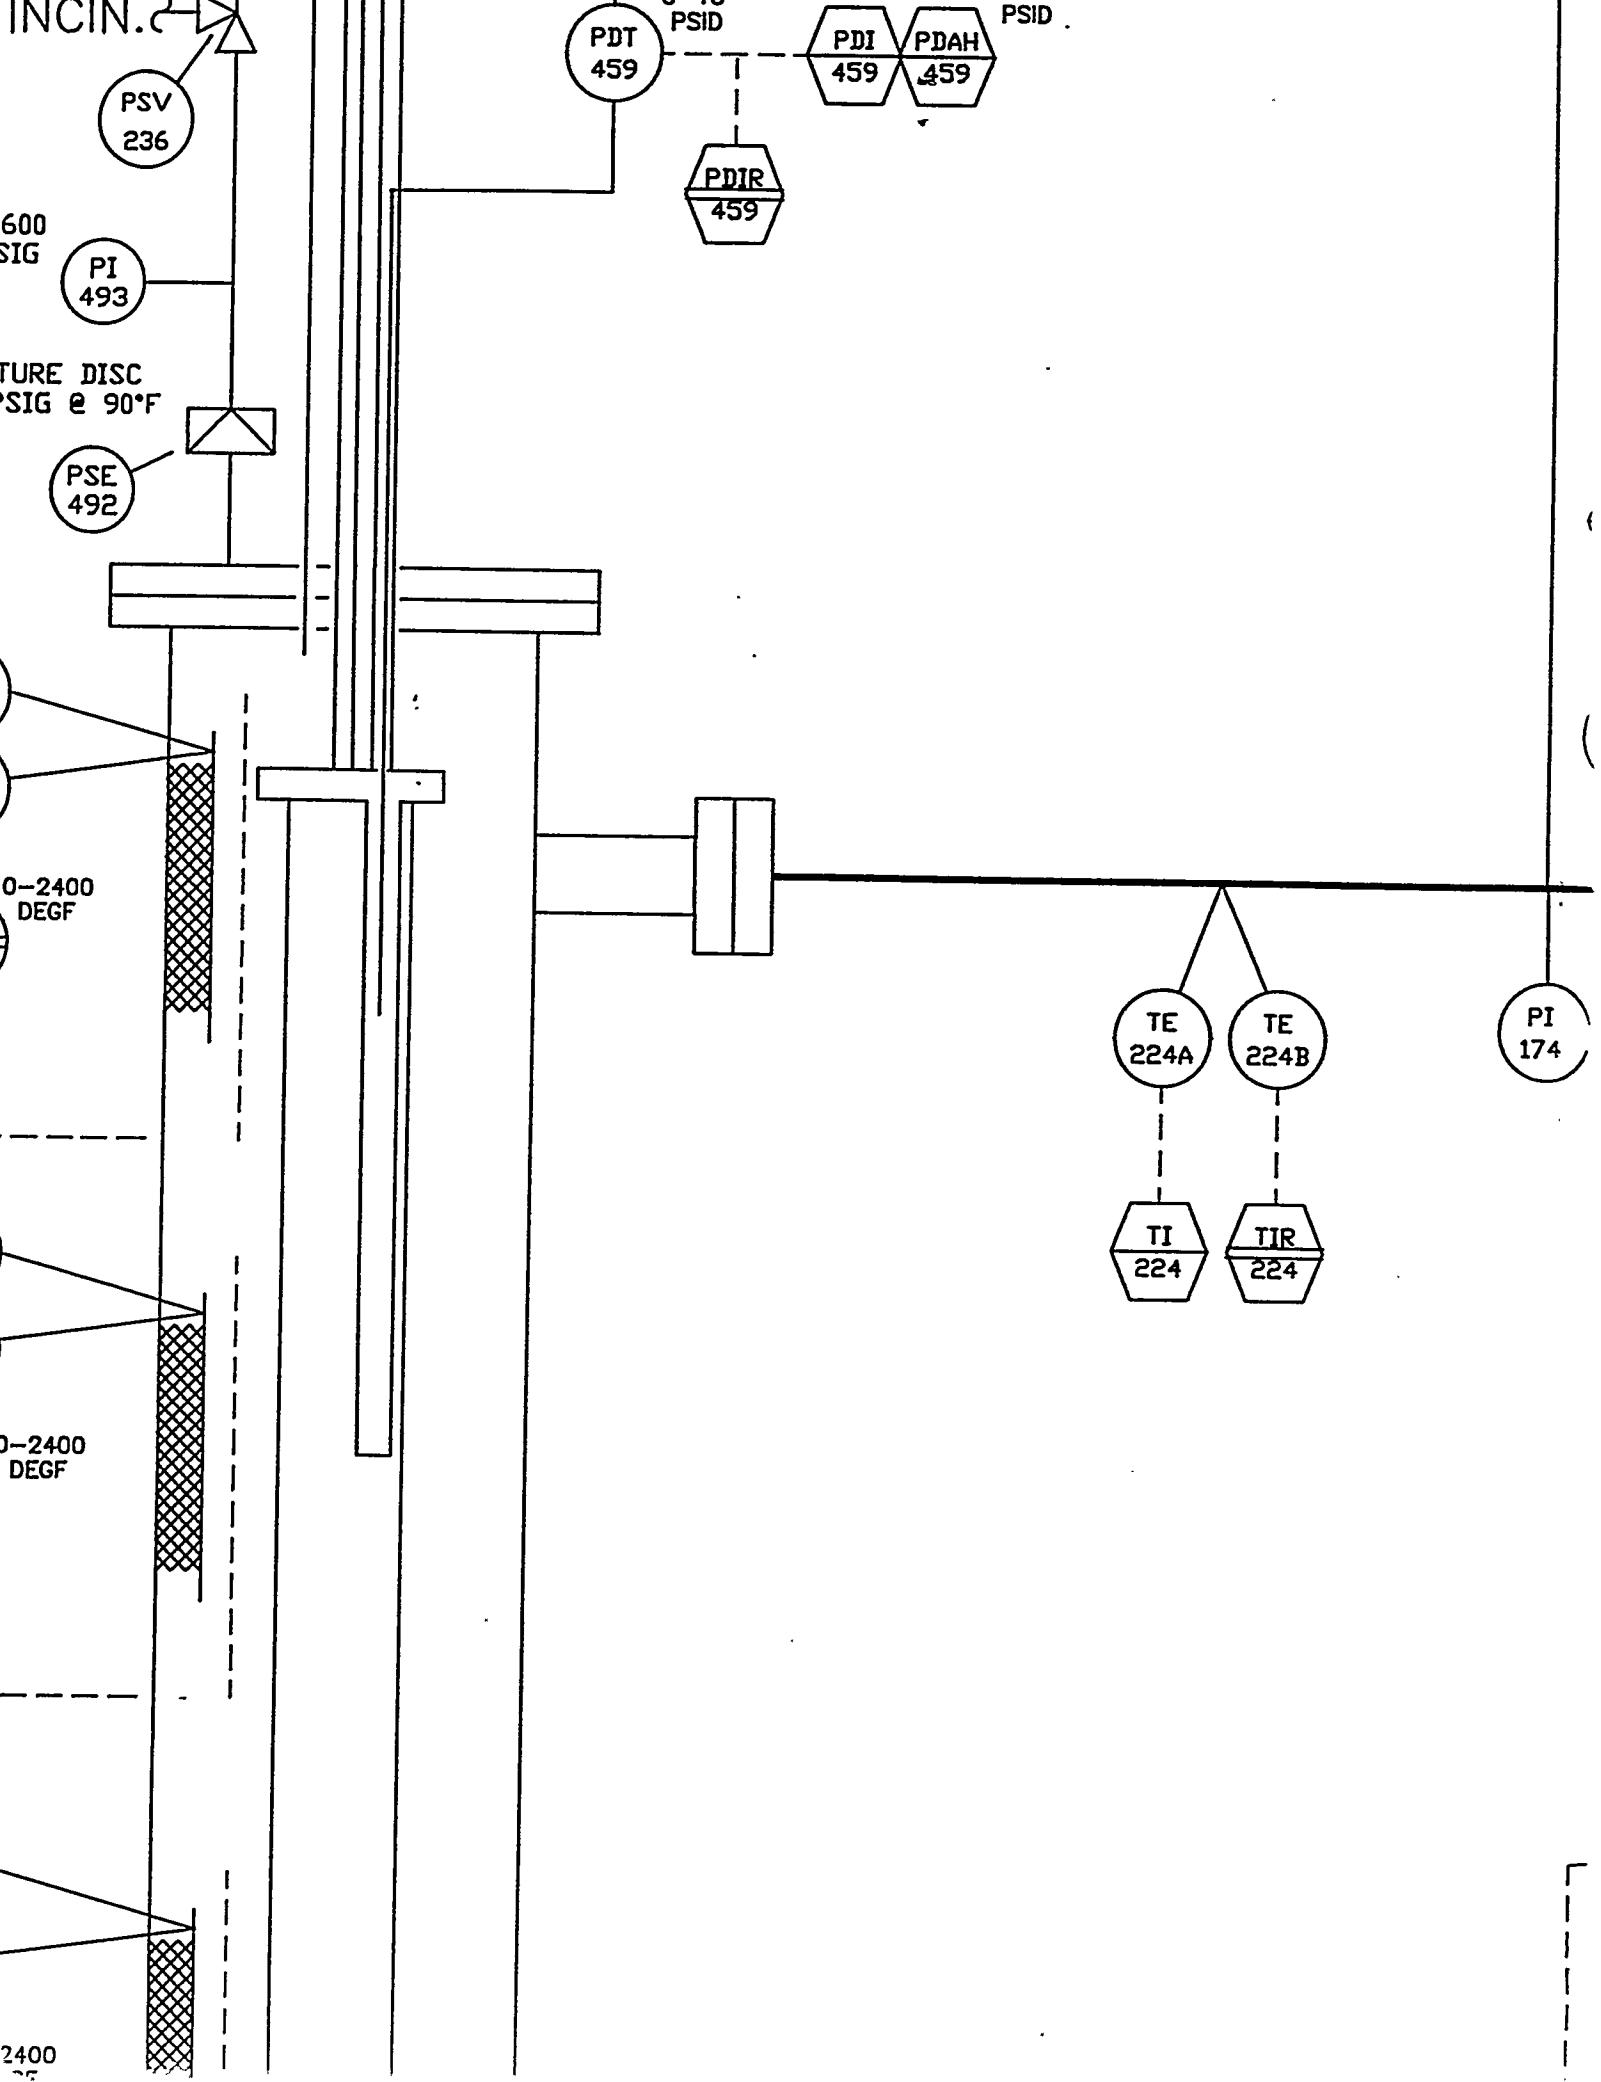

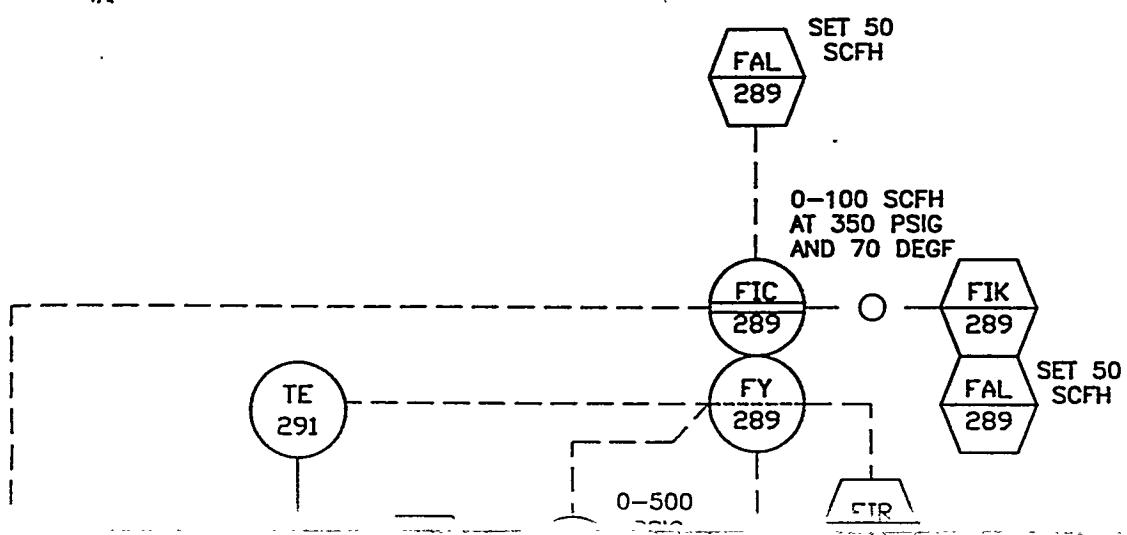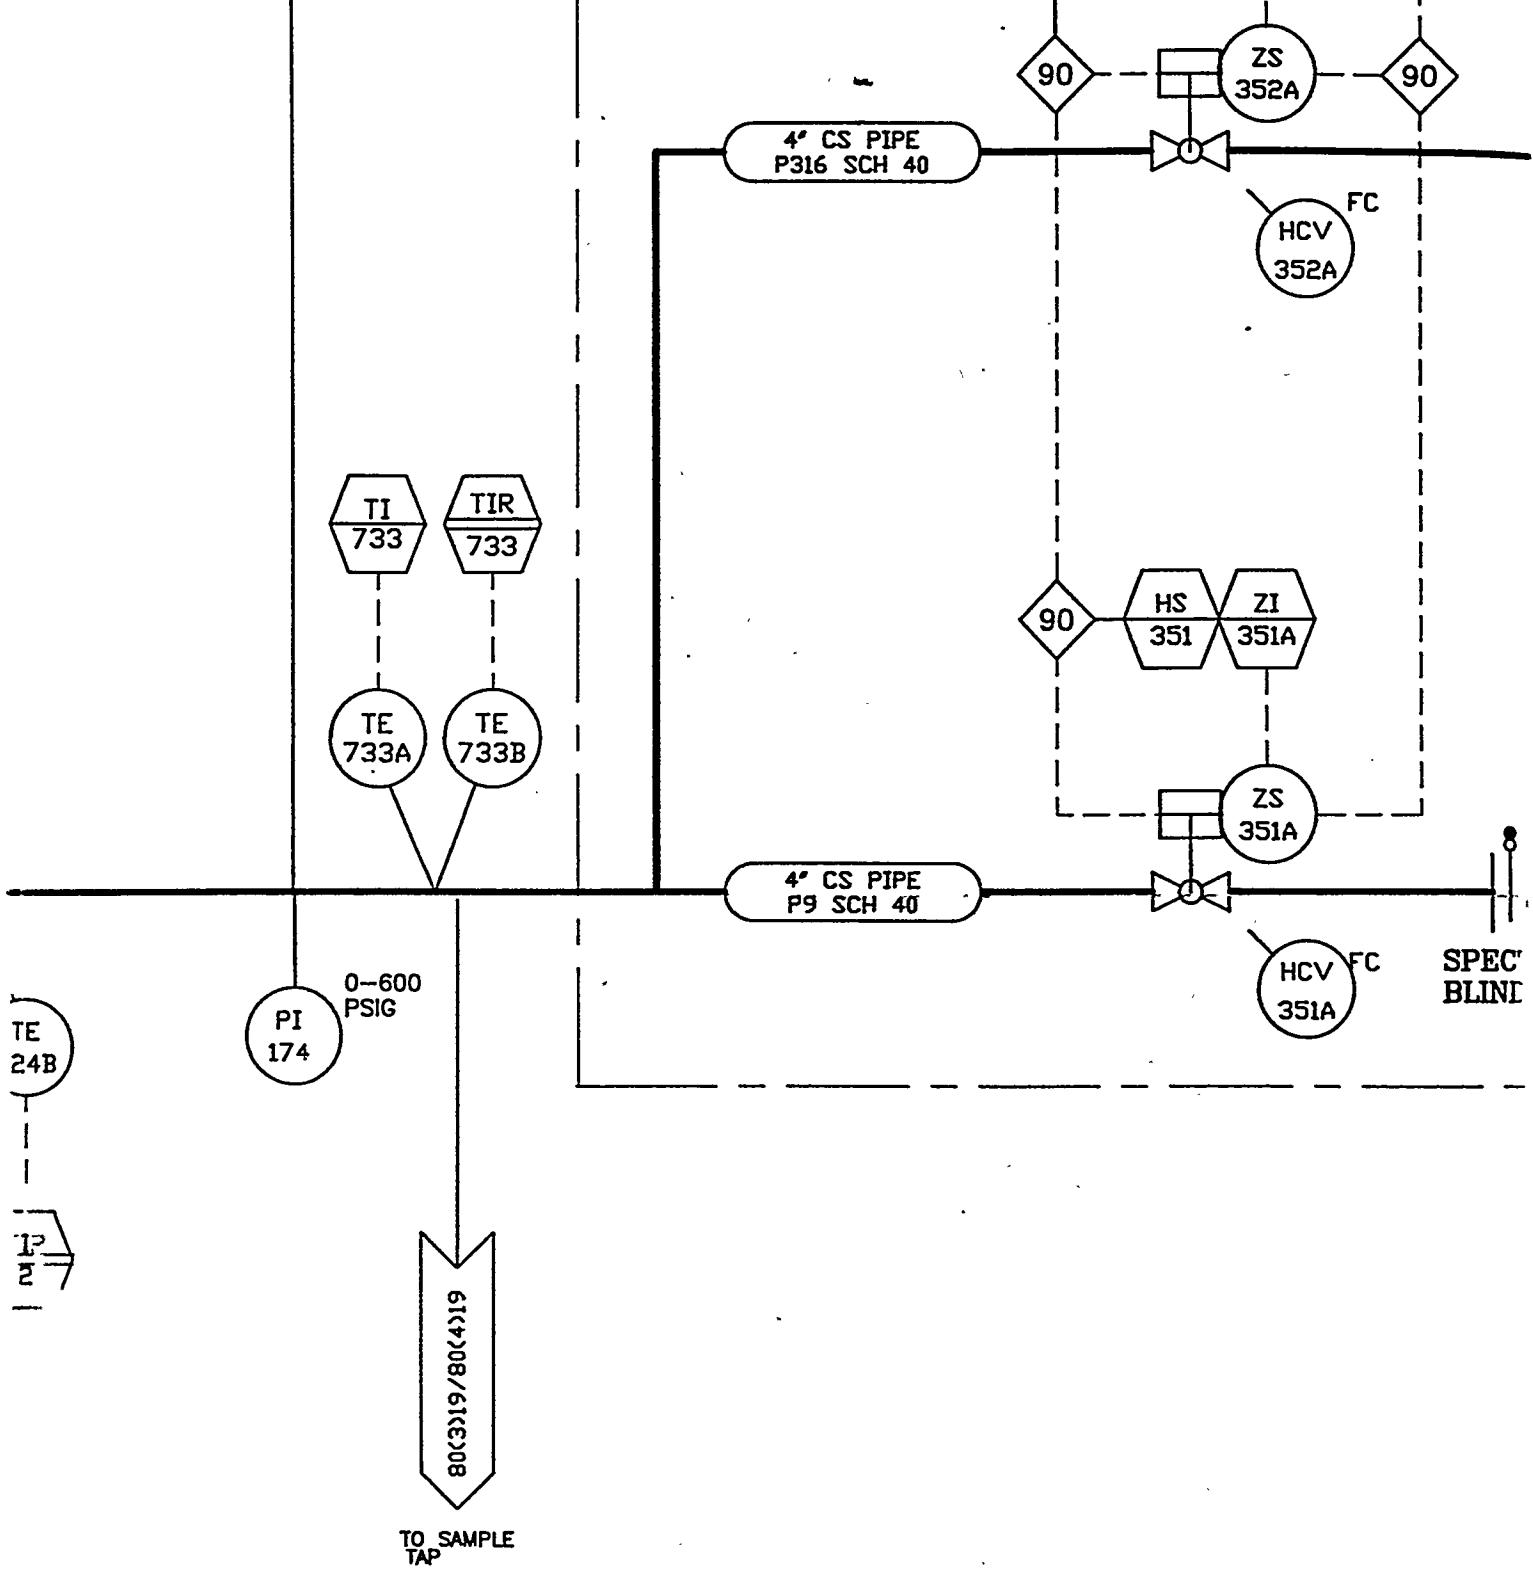

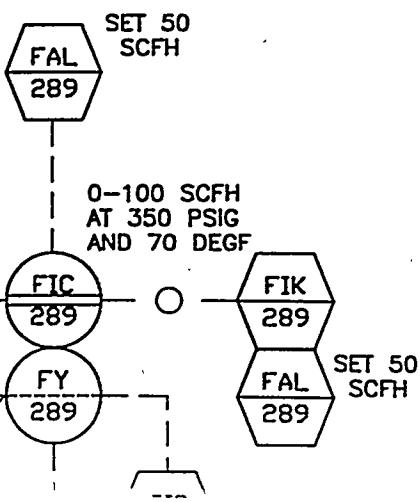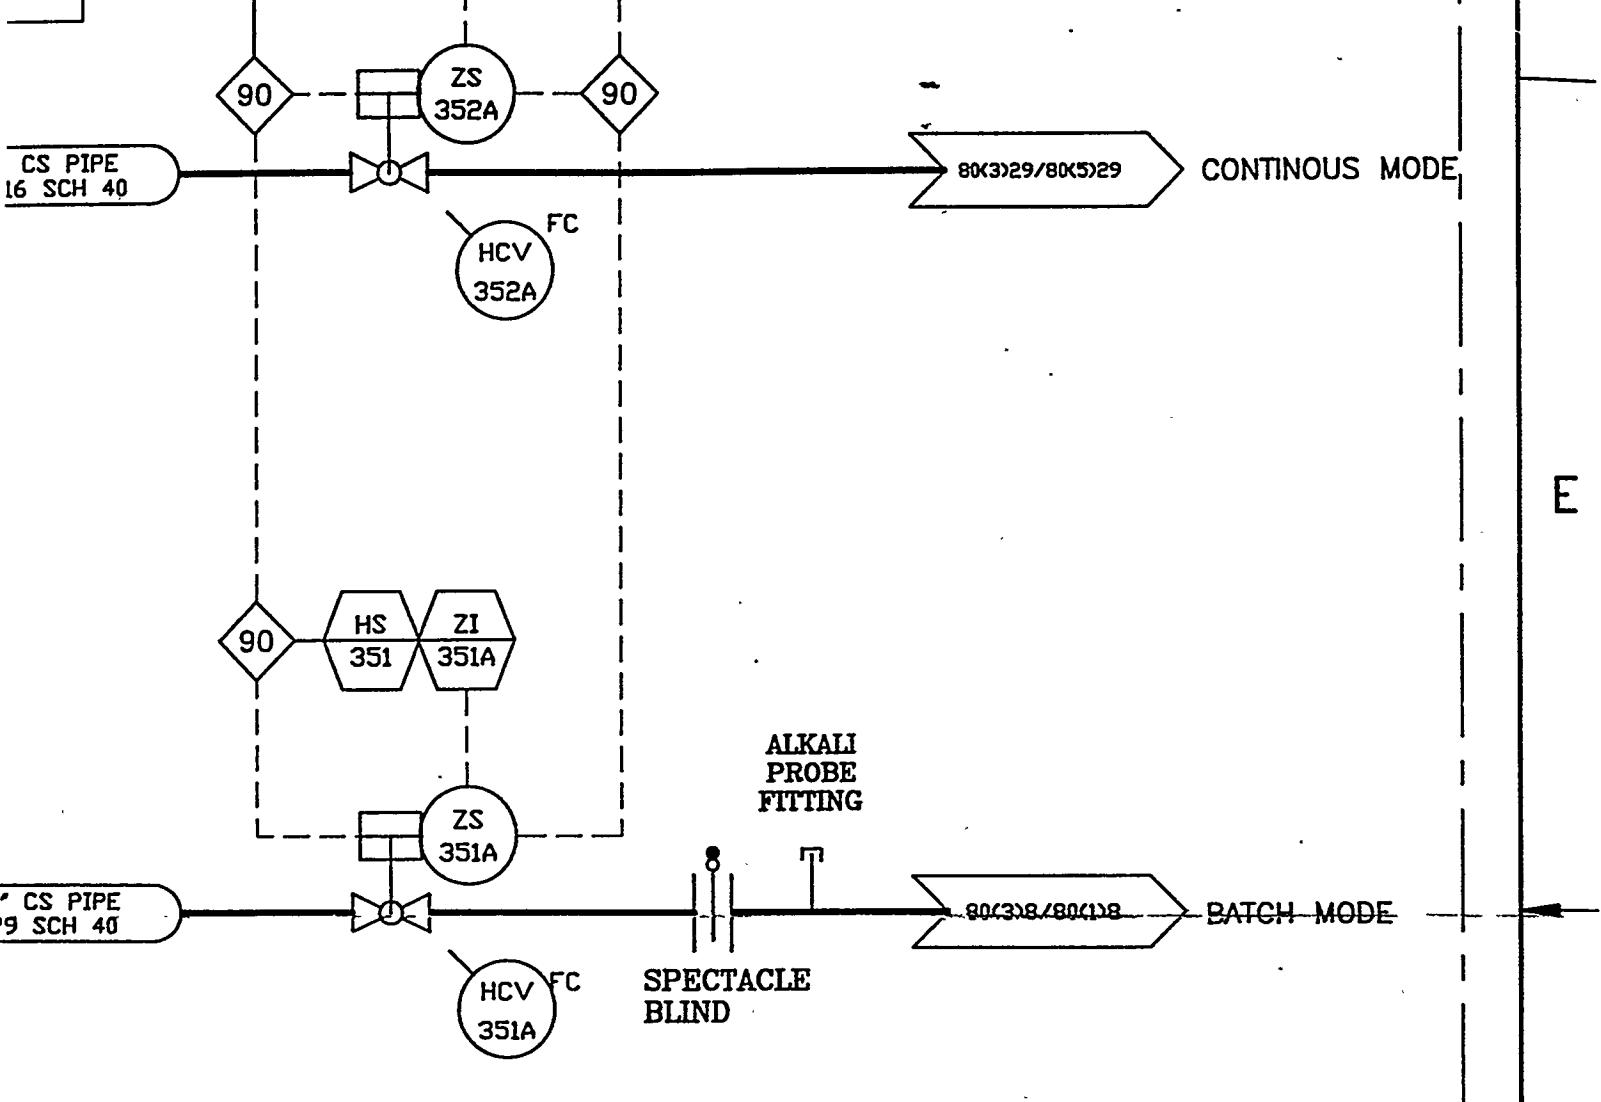

ZONE

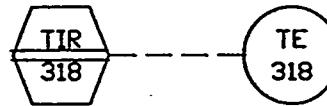

C
TO ALKALI
SAMPLE SYSTEM
AND PMS SYSTEM

80(3)28/08(0)28

B
0-600 PS:


PI
461





A
FROM N2
PREHEATERS

911208/912208

FROM PIC-254
V-100 OUTLET

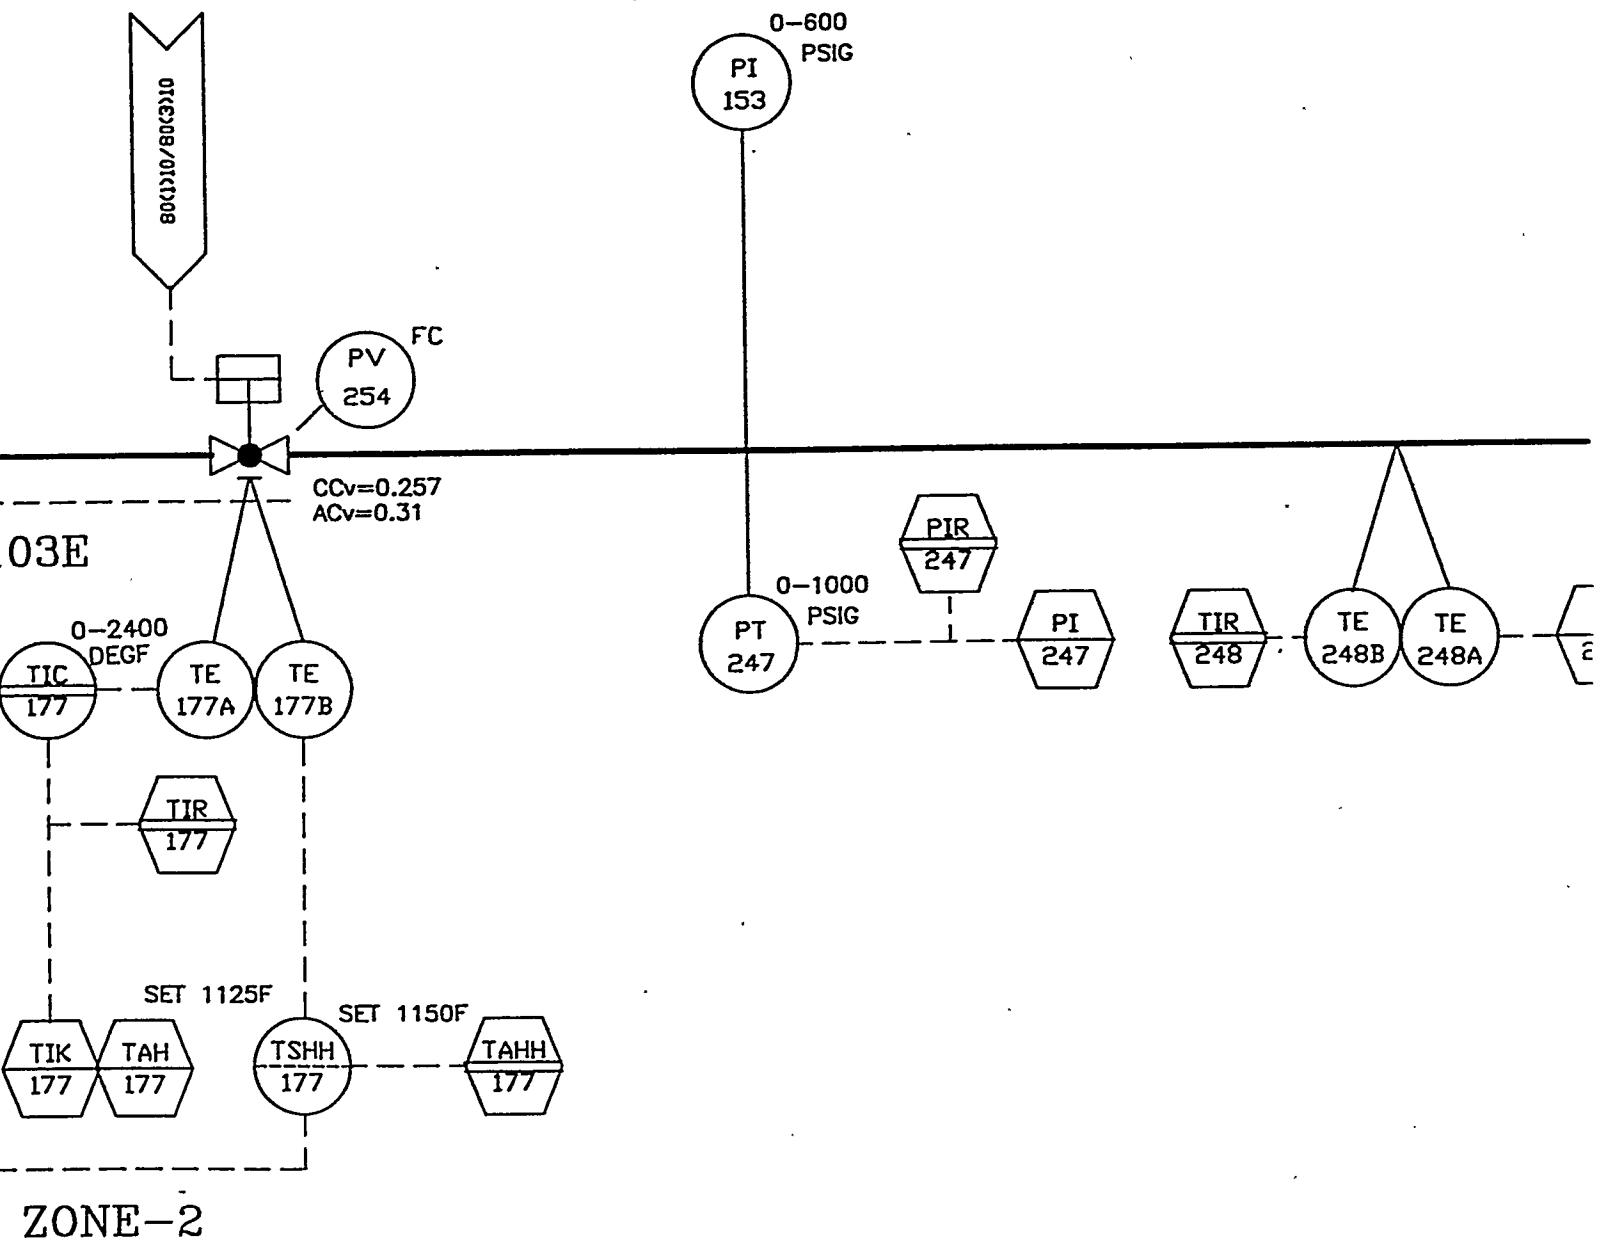

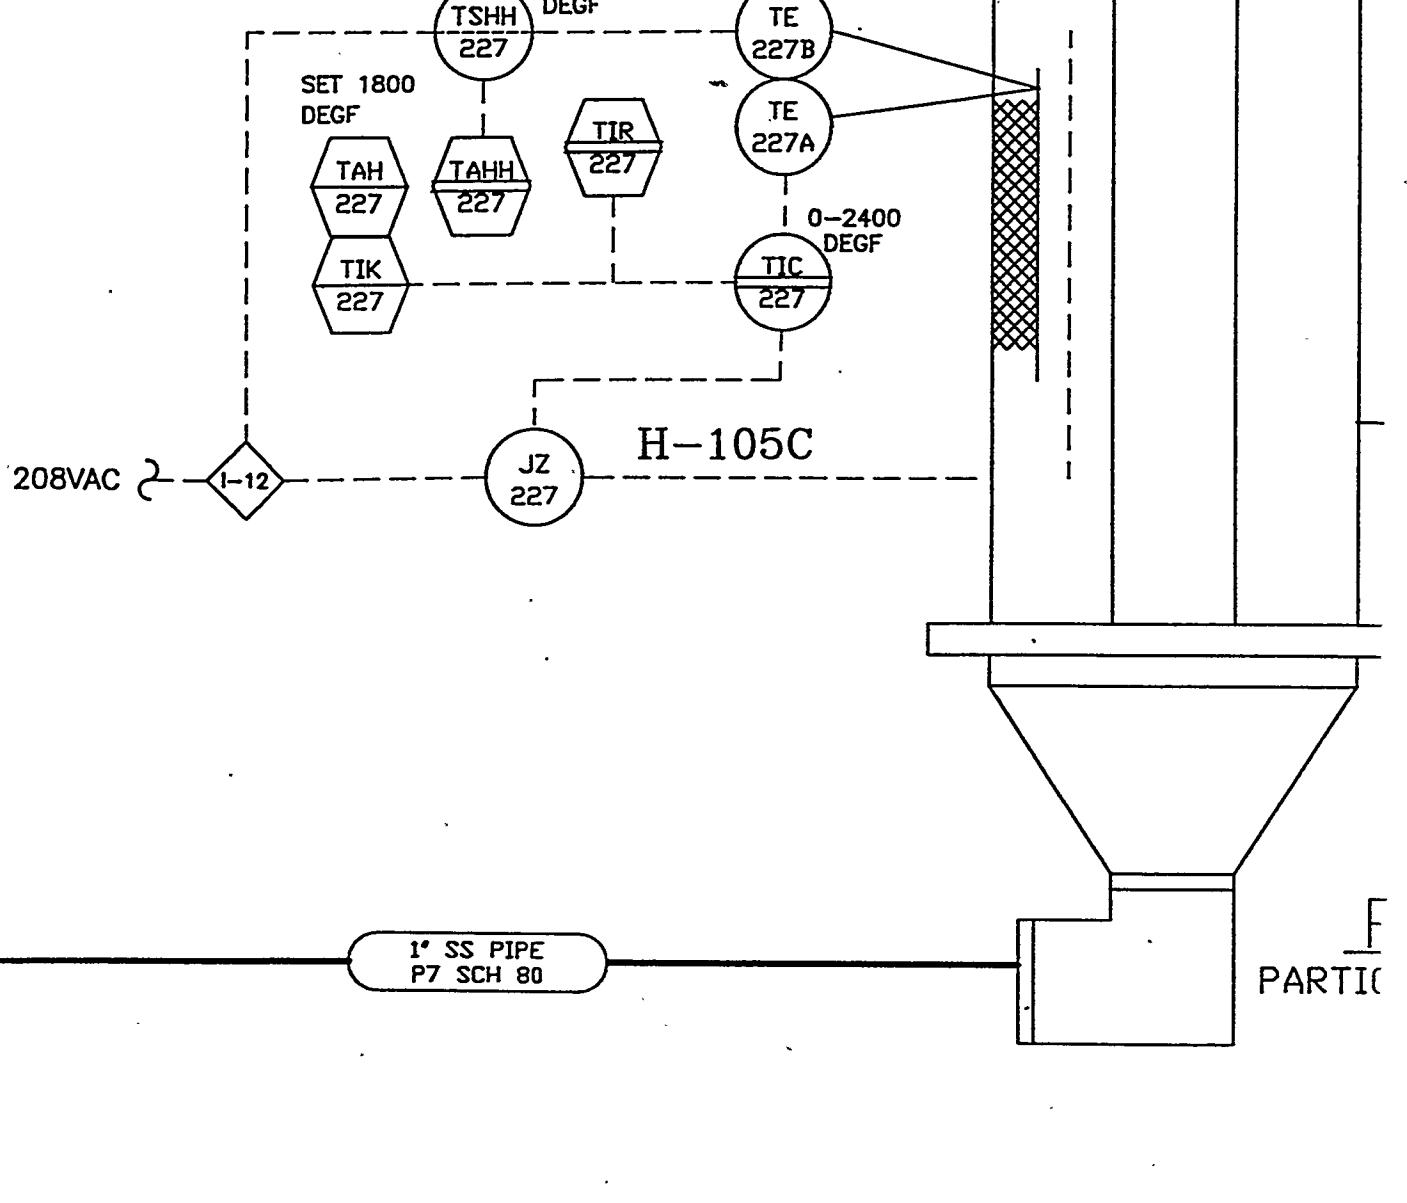


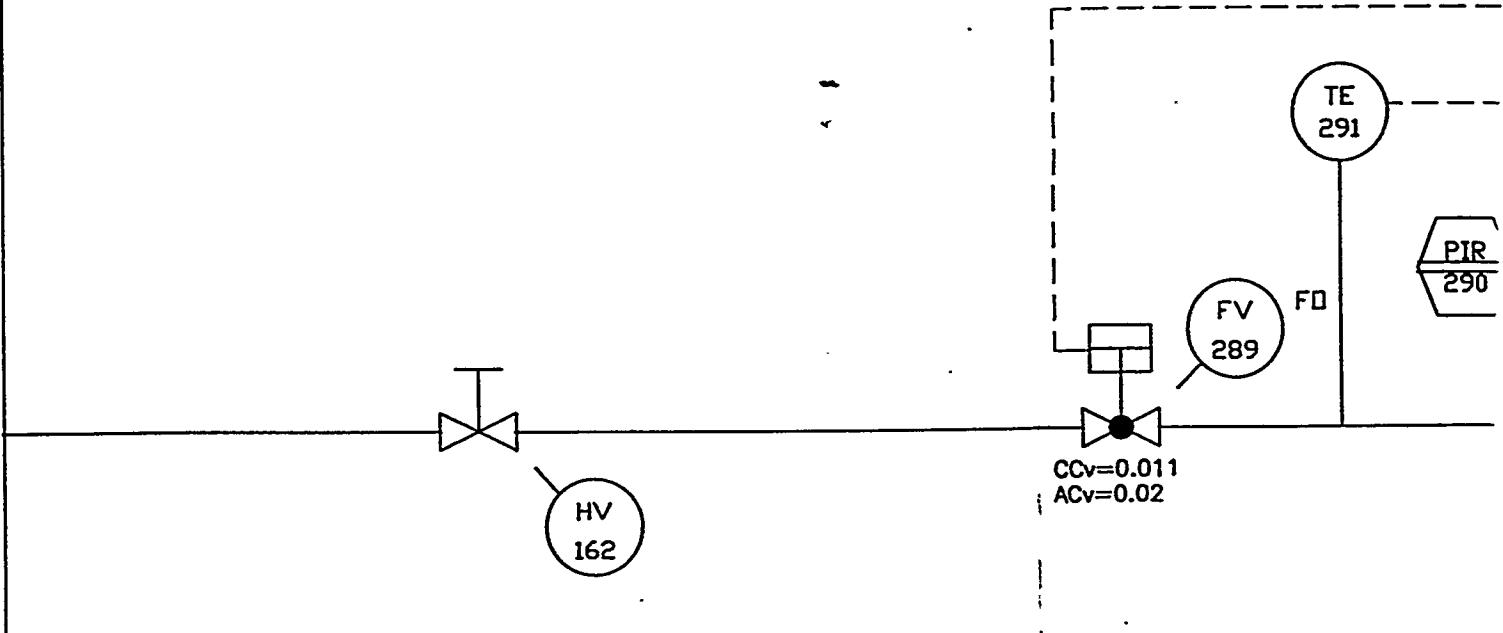

F-100
PARTICULATE FILTER

REFERENCE DR

THIS DRAWING IS PART
OF THE EG&G DOCUMENT
CONTROL SYSTEM

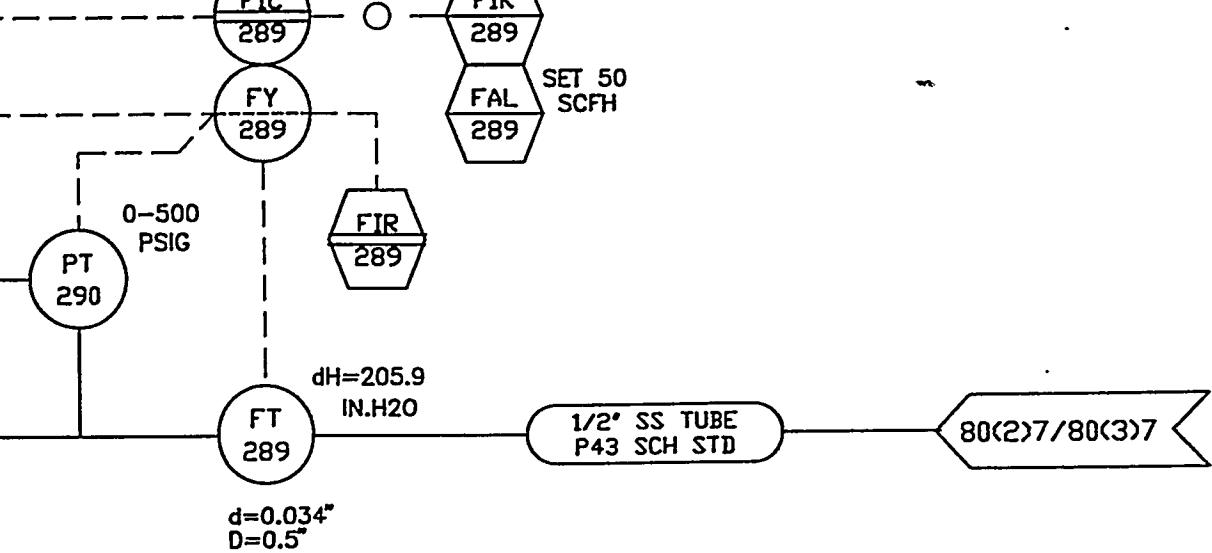

NOTES:

1. ALL IMPULSE LINES ARE 3/8" SS UNLESS OTHERWISE NOTED.
- 2.
- 3.

C


DRAWN BY


STD920080.07

3

A


GS	DRAFTER Jimmy Thornton	DATE 10/28/93	 <p>United States Department of Energy MORGANTOWN ENERGY TECHNOLOGY CENTER Morgantown, WV</p>
	PROJECT ENGINEER John Rockey	DATE 11/2/93	
	REQUESTOR John Rockey	DATE 11/2/93	
	BRANCH MANAGER Larry Strickland	DATE 11/2/93	
	ESTD	DATE	
	DOE WJA John Rotunda	DATE 10/28/93	
	DATE	SIZE E	REV 7
	DATE	FSCH NO	DWG NO STD920080.07

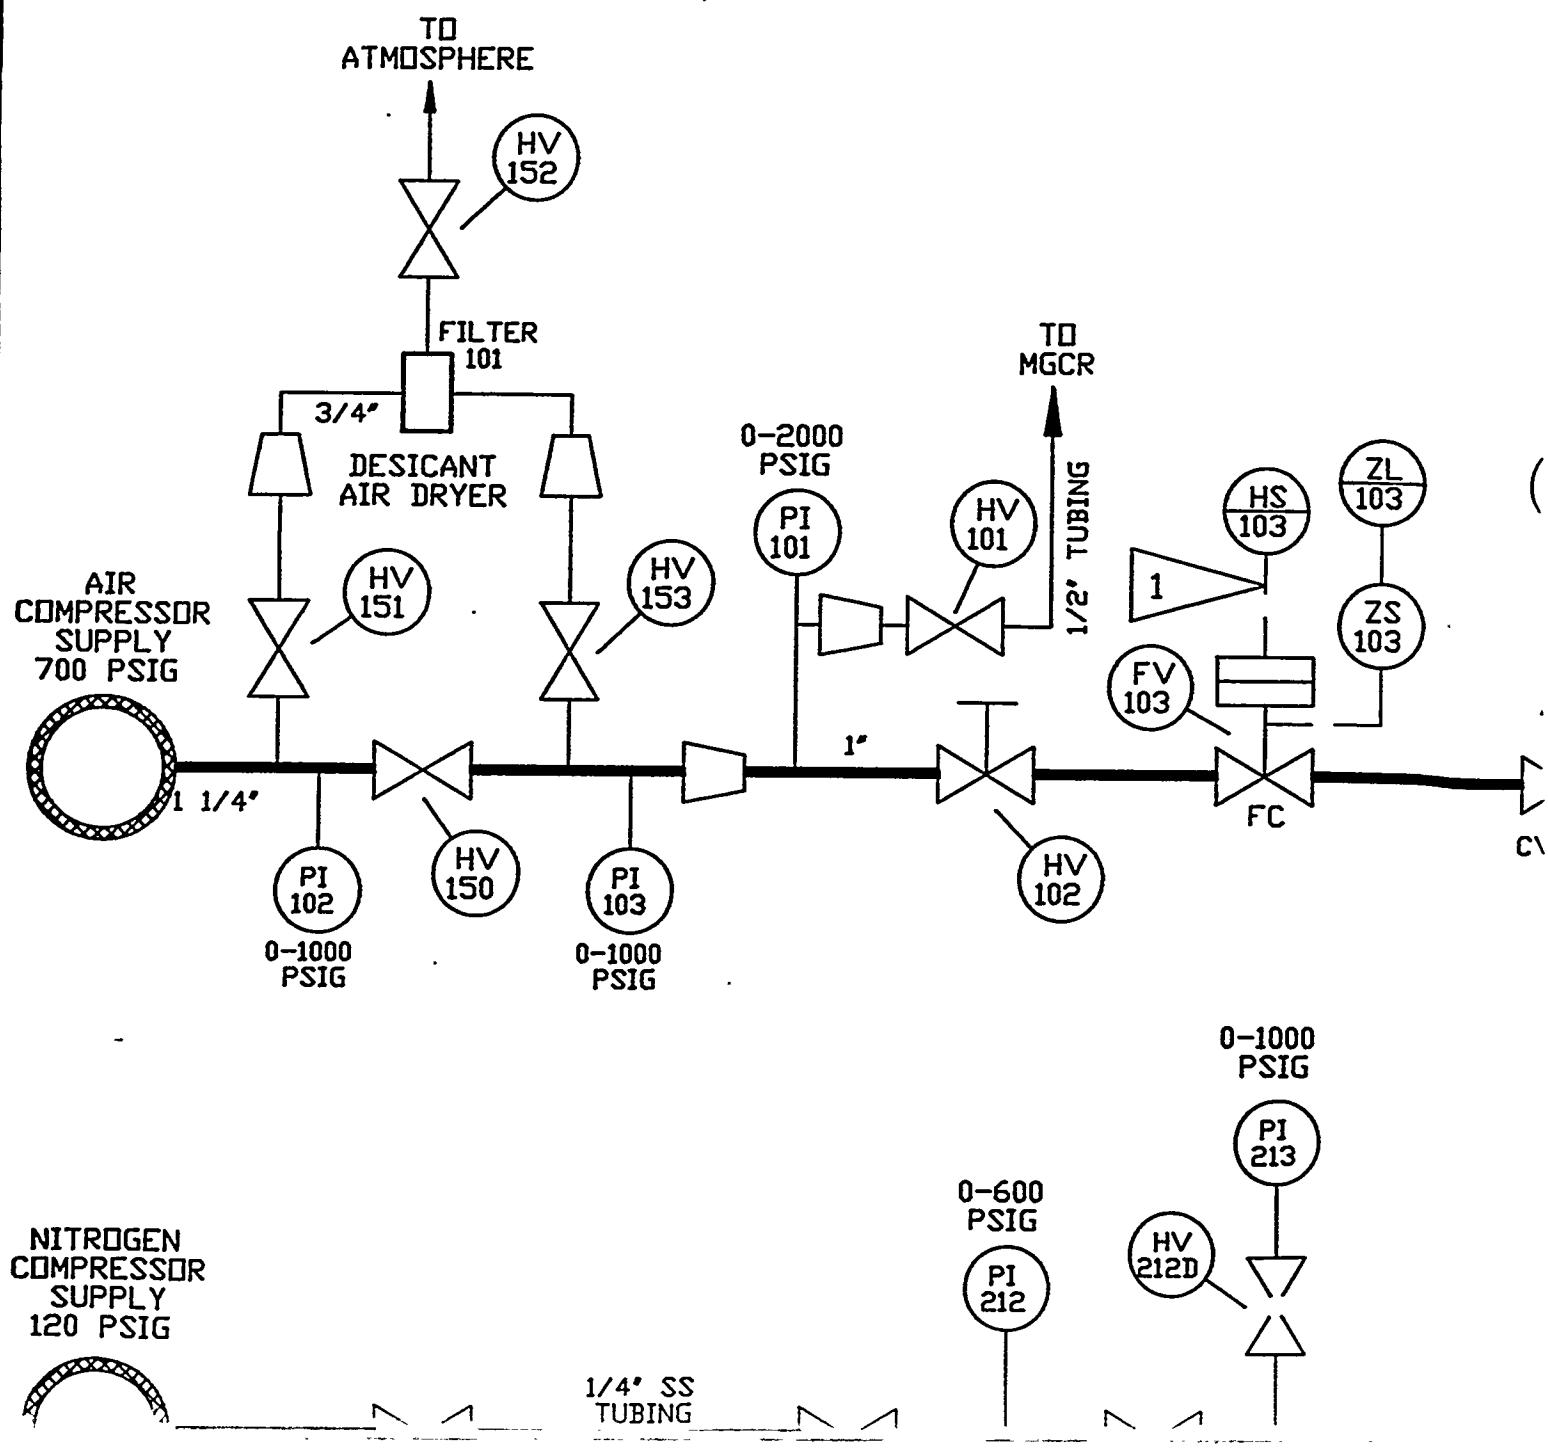

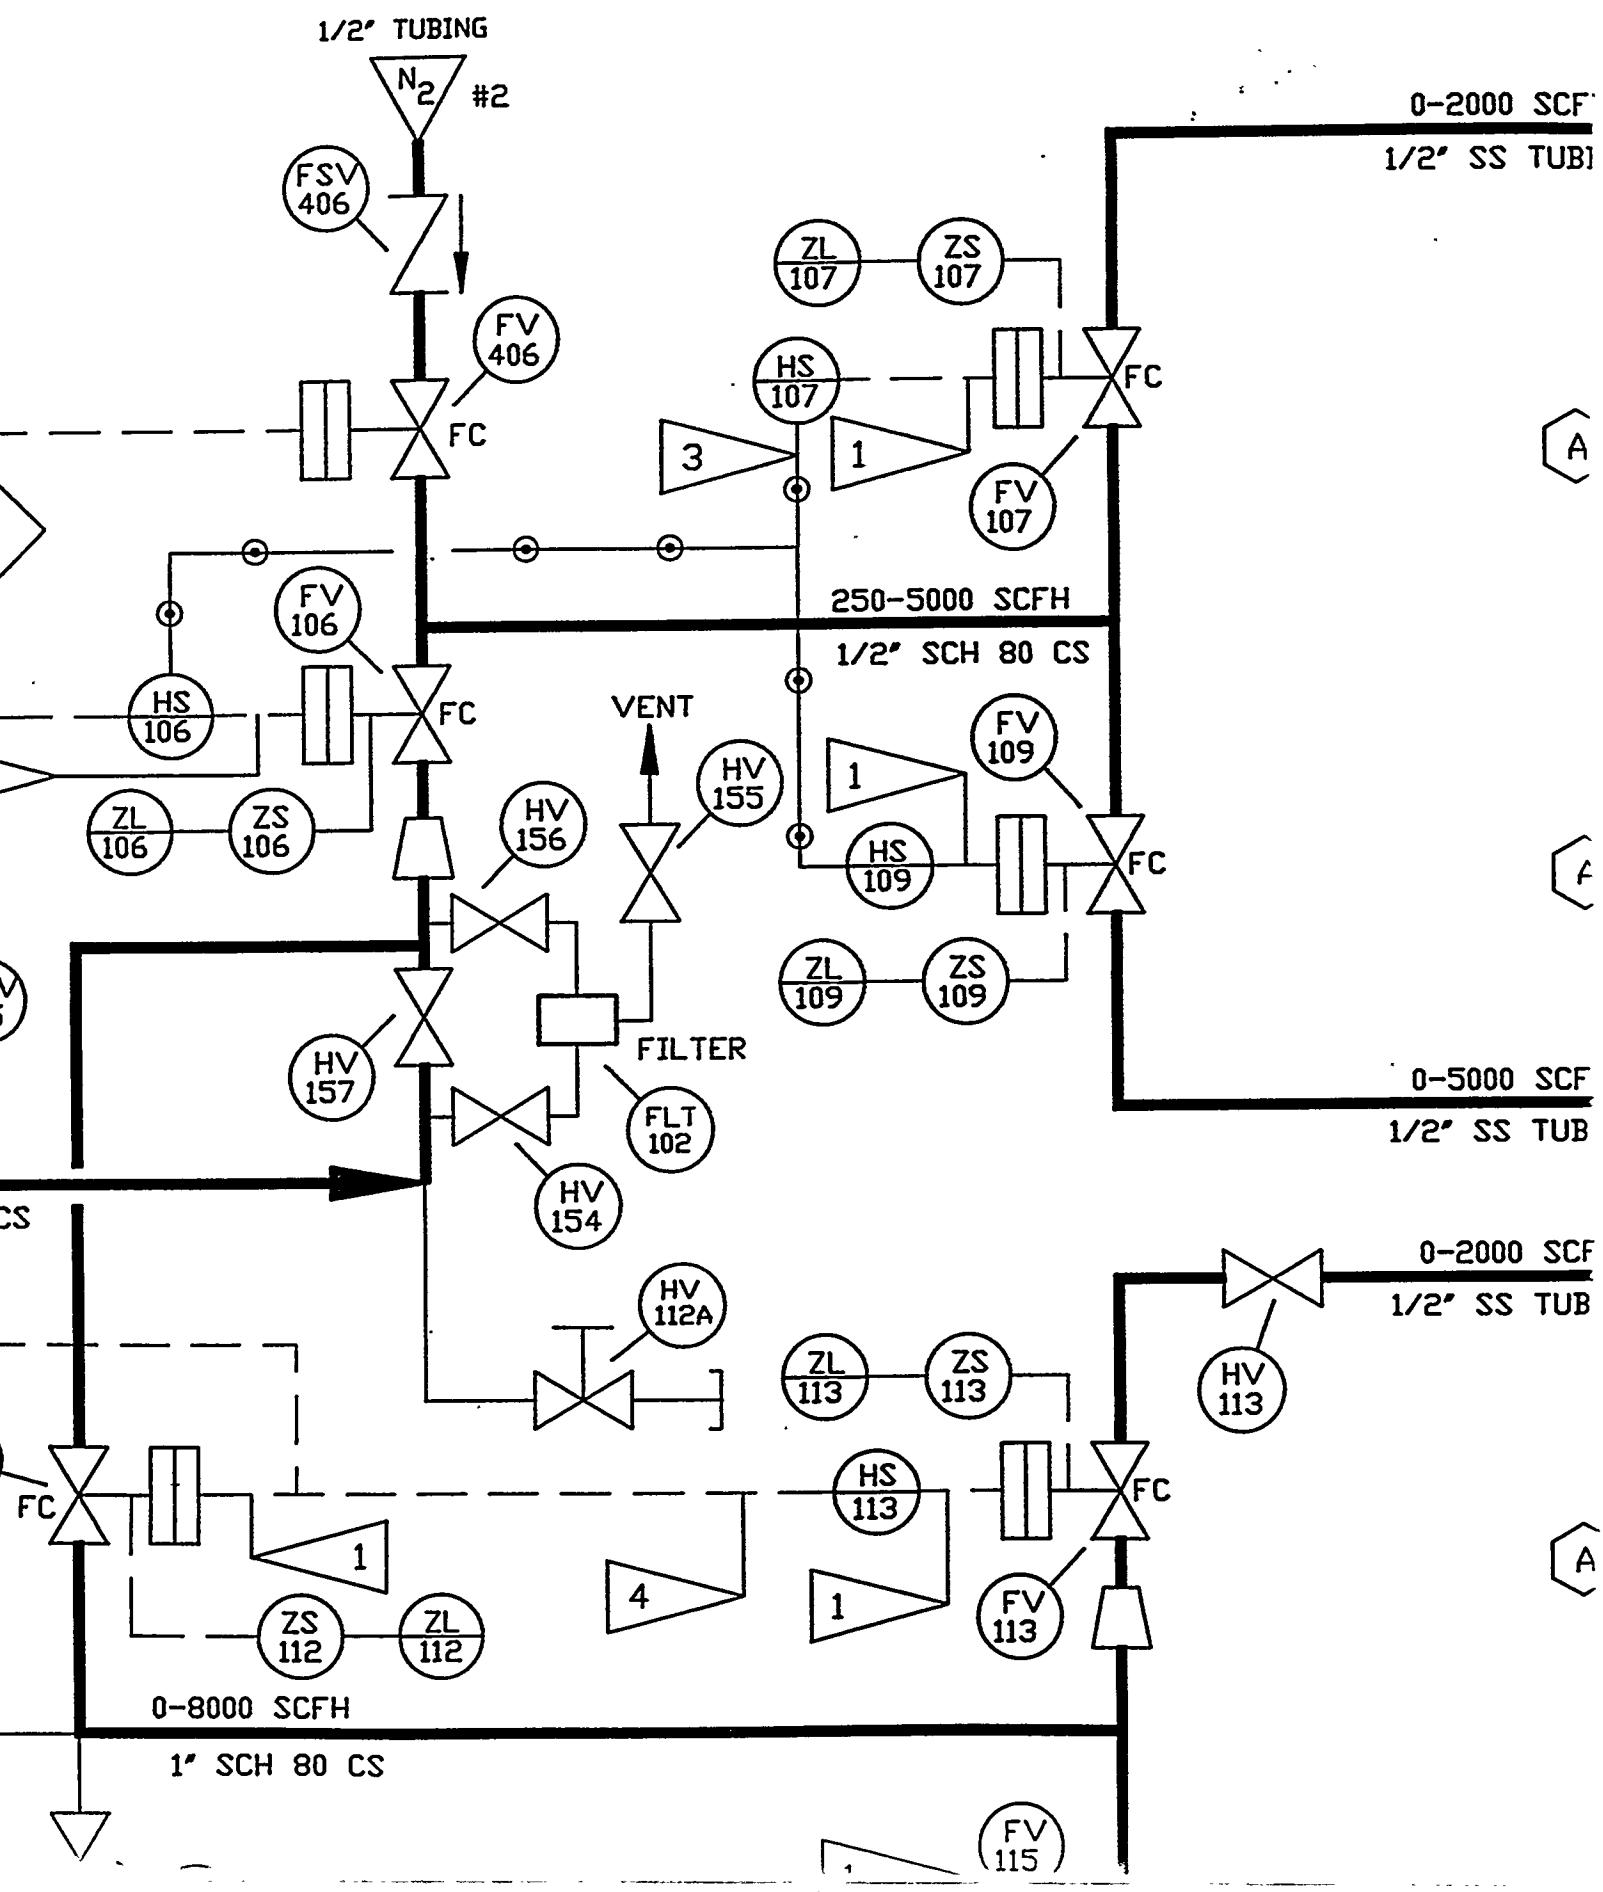


$d=0.159''$
 $h=223'' H_2O$


1/2" SS TUBING

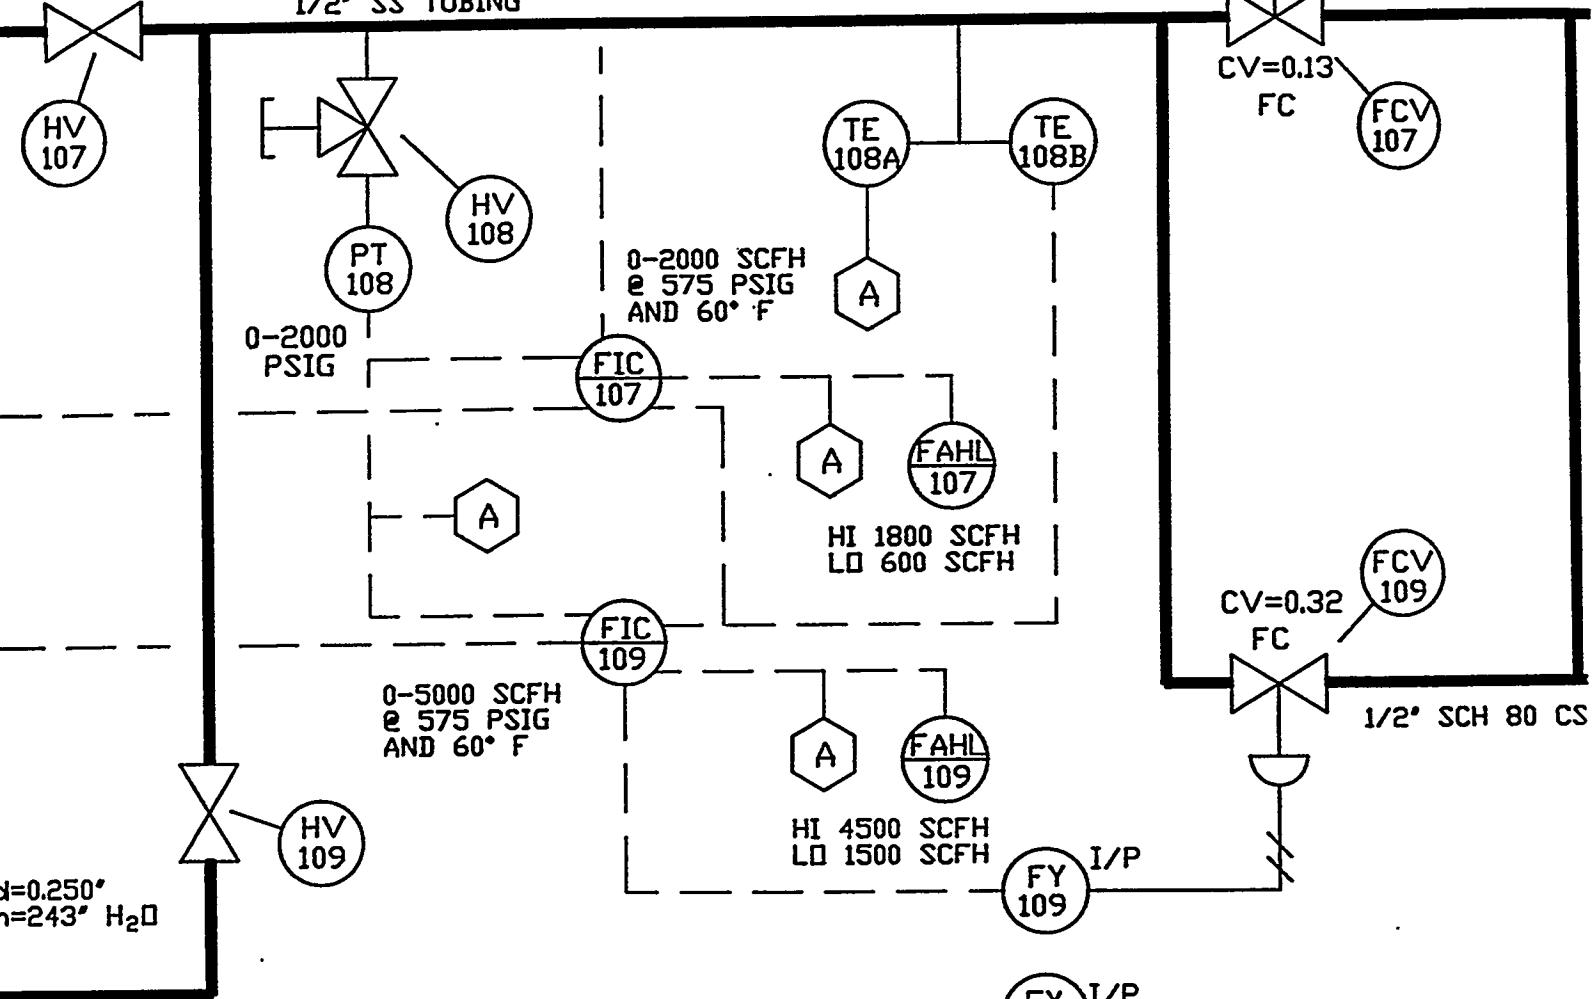


$d=0.159''$
 $h=223'' H_2O$

1" SCH 80 CS

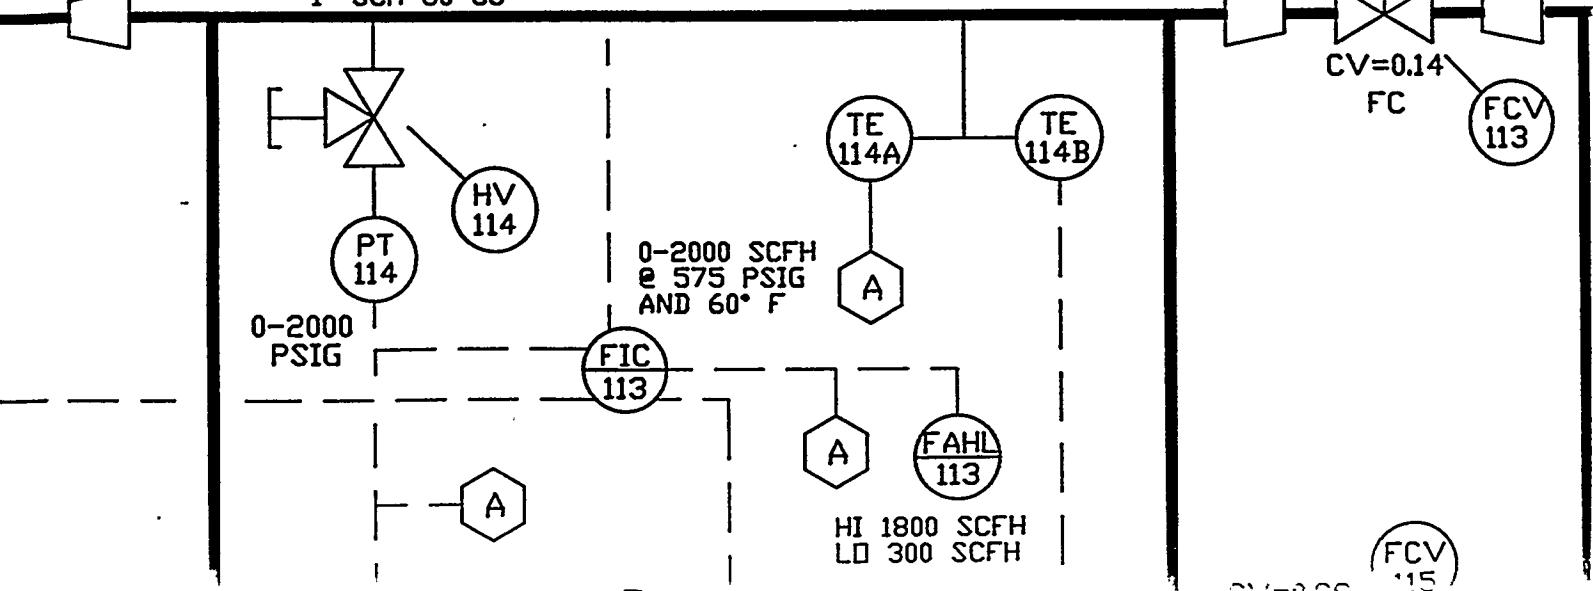

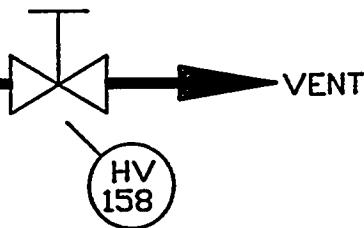

1 80 CS

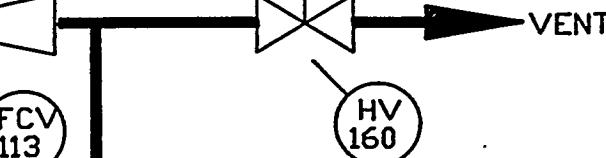FCV
113

ZONE	REV	
GEN		UPDATED AS PER MARK
GEN	1	REVISED PER MARKED F REMOVED HV-201 & PI- REROUTED LINE BETWEEN RELOCATED CAPPED LIN ADDED STEAM SITE LIN ADDED HV-402, 402A, 4K
DRAFTER	S.P.C.	DATE 12/10/90 CHECK
		DATE
ZONE	REV	
GEN		UPDATED AS PER MARK
GEN	2	ADDED NEW DWG. FORM UPDATED AS PER MARK
GEN		UPDATED AS PER MARK
B-2		ADDED NOTE 8 AND NC
C-7		MODIFIED FILTER #208
GEN		ISSUED FOR CUSTOMER
DRAFTER	JIMMY SMITH	DATE 7/17/92 CHECK
EG&G RESPON SECT SUPV	BURTON W. HARRELL	DATE 7/20/92 EG&G
ZONE	REV	
A-1		CHANGED DWG. TITLE
GEN	3	UPDATED AS PER MARK
GEN		ISSUED FOR CONSTRUC
E-7		ADDED ENTRAINED BOI
G-7		'PI-104' WAS 'PI-105,
F-7		'650 PSIG' ON PAHL-E
D-6		ADDED 'HS-217' TO '
A-8		ADDED NOTE TO 'HV-
GEN		REVISED DESIGNATION BEHIND PANEL'
DRAFTER	GARY J. KULCHOCK	DATE 11/18/92 CHECK
EG&G ESTM	J. L. BUCKLEW	DATE 11/19/92 PROJ
ZONE	REV	
GEN	4	REVISED SHTR-201 T REMOVED ALL NUMBER MODIFIED VARIOUS S ADDED FT-406, PT-4
DRAFTER	GARY J. KULCHOCK	DATE 4/5/93 CHECK
EG&G ESTM	J. L. BUCKLEW	DATE 4/7/93 PROJ
ZONE	REV	
GEN	5	ADDED NOTE 10, REV REVISED LINETYPE E ADDED '#2' TO N ₂ , 2 PAHL-214, 700 PSIG ADDED FSV-412, FV- ISSUED FOR CONSTR
DRAFTER	Gary Kulchock	DATE 9/10/93 CHECK
EG&G ESTM	Larry Bucklew	DATE 9/17/93 PROJ
ZONE	REV	
GEN	6	EXTENSIVE CHANGES ISSUED FOR CONSTRUC
DRAFTER	John H. Kulchock	DATE 10/7/93 CHECK
EG&G ESTM	Larry Bucklew	DATE 10/11/93 PROJ


REVISION


REV	DESCRIPTION						DATE
1	UPDATED AS PER MARKED PRINT REVISED PER MARKED PRINT REMOVED HV-201 & PI-201 REROUTED LINE BETWEEN HV-480 & PCV-308 RELOCATED CAPPED LINE ADDED STEAM SITE LINE, HV & CV ADDED HV-402, 402A, 403A & 404						4/25/90
							10/11/90
S.P.C.	DATE 12/10/90	CHECKER G.J.K.	DATE 12/10/90	PROJECT ENGR. J.P.K.	DATE 2/13/91		DATE
	DATE		DATE		DATE		DATE
REV	DESCRIPTION						DATE
2	UPDATED AS PER MARKED PRINT WITH W.D. #68547 ADDED NEW DWG. FORMAT UPDATED AS PER MARKED PRINT WITH W.D. #70756 UPDATED AS PER MARKED PRINT WITH WORK PLAN ADDED NOTE 8 AND NOTE DESIGNATIONS MODIFIED FILTER #208 SYMBOL ISSUED FOR CUSTOMER REVIEW AND COMMENT						10/3/91
							1/10/92
							3/6/92
							7/17/92
JIMMY SMITH	DATE 7/17/92	CHECKER GARY J. KULCHOCK	DATE 7/17/92	EG&G RESPON ENGR. JAY RUTTEN	DATE 7/17/92	EG&G REVIEWER D. LUNIFIELD	DATE 7/17/92
RTON W. HARRELL	DATE 7/20/92	EG&G ESTH J. L. BUCKLEW	DATE 7/20/92		DATE		DATE
REV	DESCRIPTION						DATE
3	CHANGED DWG. TITLE UPDATED AS PER MARKED PRINT WITH WORK PLAN ISSUED FOR CONSTRUCTION ADDED ENTRAINED BOILER, VALVE HV-0601A, AND TIC-201 "PI-104" WAS "PI-105, AND "PI-105" WAS "PI-104" "650 PSIG" ON PAHL-214 WAS "500 PSIG" ADDED "HS-217" TO "JC-217" ADDED NOTE TO "HV-401A" REVISED DESIGNATIONS ON ALL FLOW COMPUTERS FROM "MOUNTED ON PANEL" TO "MOUNTED BEHIND PANEL"						9/16/92
							11/16/92
LARY J. KULCHOCK	DATE 11/18/92	CHECKER S. CONKO	DATE 11/18/92	EG&G RESPONSIBLE ENGR. JAY RUTTEN	DATE 11/19/92	REVIEWER D. LUNIFIELD	DATE 11/19/92
L. BUCKLEW	DATE 11/19/92	PROJECT ENGR. ESTH	DATE	BRANCH MANAGER	DATE	DOE (EEDSD) JOHN ROTUNDA	DATE 11/24/92
REV	DESCRIPTION						DATE
4	REVISED SHTR-201 TO INCLUDE THE MAX. PRESS. AND TEMP. REMOVED ALL NUMBERS FROM ADACS SYMBOLS MODIFIED VARIOUS SCFH RATINGS ADDED FT-406, PT-406, HV-406A, HV-406B, HV-406C, TE-406A, TE-406B, AND ASSOCIATED ADACS SYMBOLS						4/1/93
LARY J. KULCHOCK	DATE 4/5/93	CHECKER S. CONKO	DATE 4/5/93	EG&G RESPONSIBLE ENGR. JAY RUTTEN	DATE 4/7/93	REVIEWER D. LUNIFIELD	DATE 4/7/93
L. BUCKLEW	DATE 4/7/93	PROJECT ENGR. JOHN ROCKEY	DATE 5/27/93	BRANCH MANAGER LARRY STRICKLAND	DATE 5/27/93	DOE (EEDSD) JOHN ROTUNDA	DATE 5/27/93
REV	DESCRIPTION						DATE
5	ADDED NOTE 10, REVISED BOLD LINETYPE ON YY-209, PI-207, & PI-208 REVISED LINETYPE IN FV-103; REVISED LINE ROUTING IN ZONE G-6 ADDED "#2" TO N. 2 PLACES PAHL-214, 700 PSIG RATING WAS 650 PSIG ADDED FSV-412, FV-412, AND ASSOCIATED PIPING ISSUED FOR CONSTRUCTION						8/24/93
Larry Kulchock	DATE 9/10/93	CHECKER S. Conko	DATE 9/14/93	EG&G RESPONSIBLE ENGR. Jay Ruttten	DATE 9/15/93	REVIEWER Dave Lunifeld	DATE 9/20/93
Larry Bucklew	DATE 9/17/93	PROJECT ENGR. John Rockey	DATE 9/21/93	BRANCH MANAGER Larry Shadle	DATE 9/21/93	DOE (EEDSD) John Rotunda/WJA	DATE 9/20/93
REV	DESCRIPTION						DATE
6	EXTENSIVE CHANGES AS PER MARKED PRINT REDLINED BY JAY RUTTEN ON 15 FEB 94. ISSUED FOR CONSTRUCTION						9/29/94
Larry Kulchock	DATE 10/7/94	CHECKER S. Conko	DATE 10-7-94	EG&G RESPONSIBLE ENGR. Jay Ruttten	DATE 10-11-94	REVIEWER D. Lunifeld	DATE 10/11/94
Larry Bucklew	DATE 10-11-94	PROJECT ENGR. John Rockey	DATE 10-13-94	BRANCH MANAGER Larry Shadle	DATE 10-18-94	DOE (EEDSD) John Rotunda/WJA	DATE 10-11-94



H



G

F

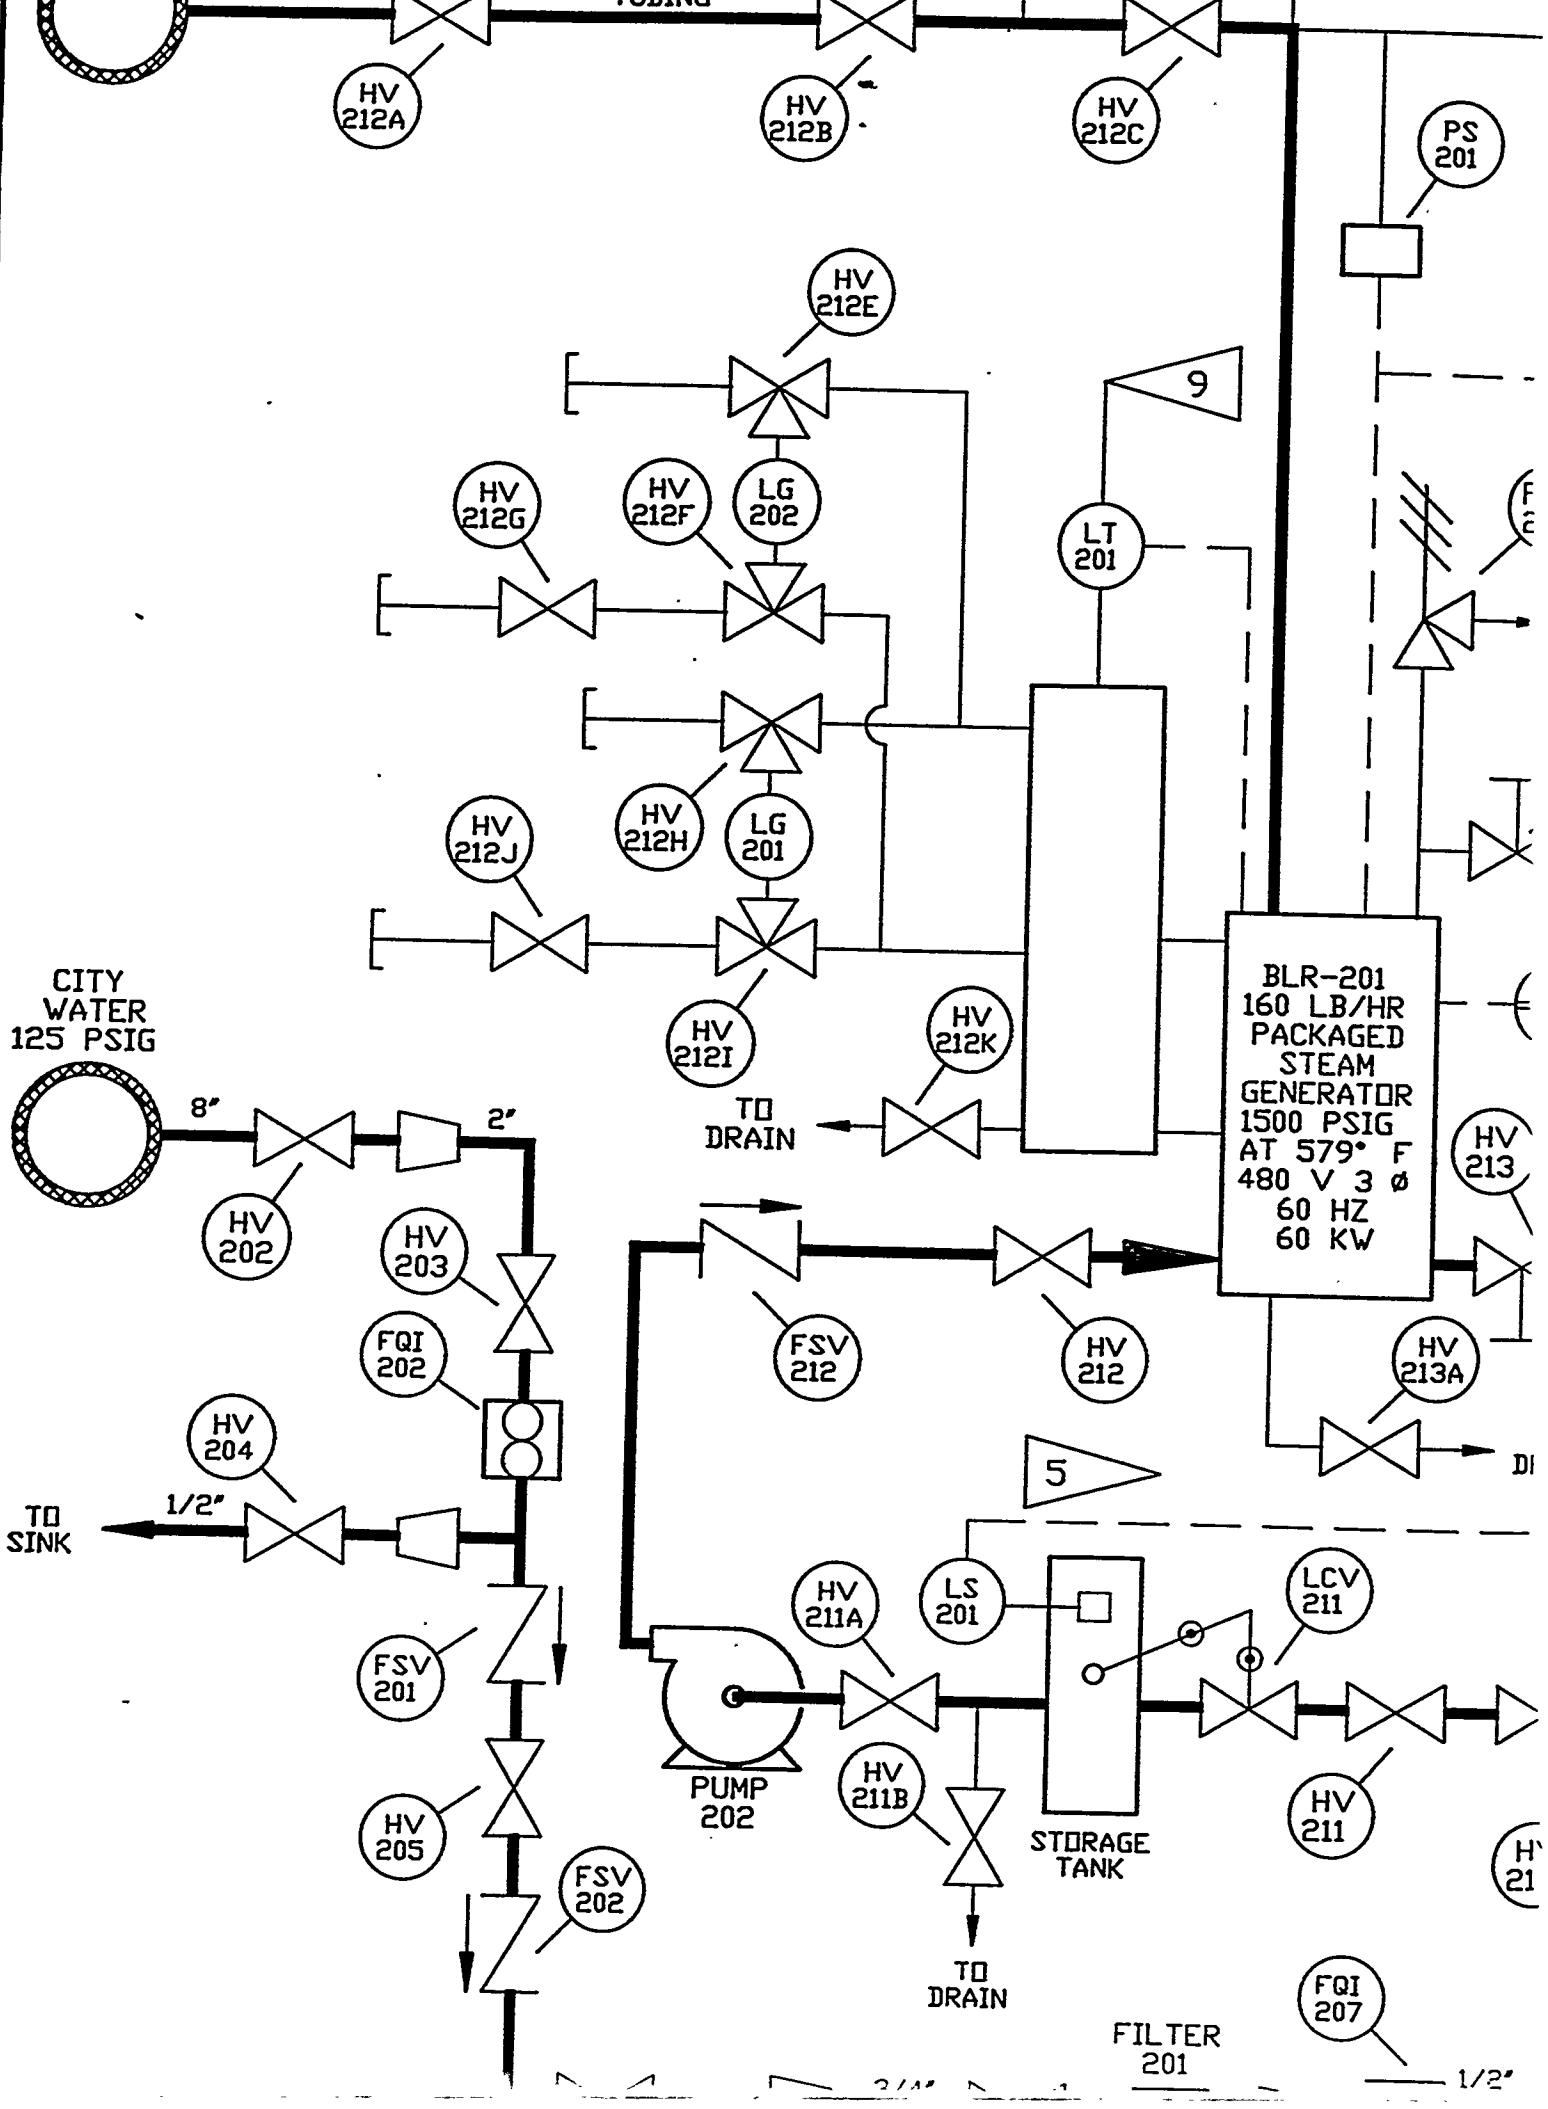

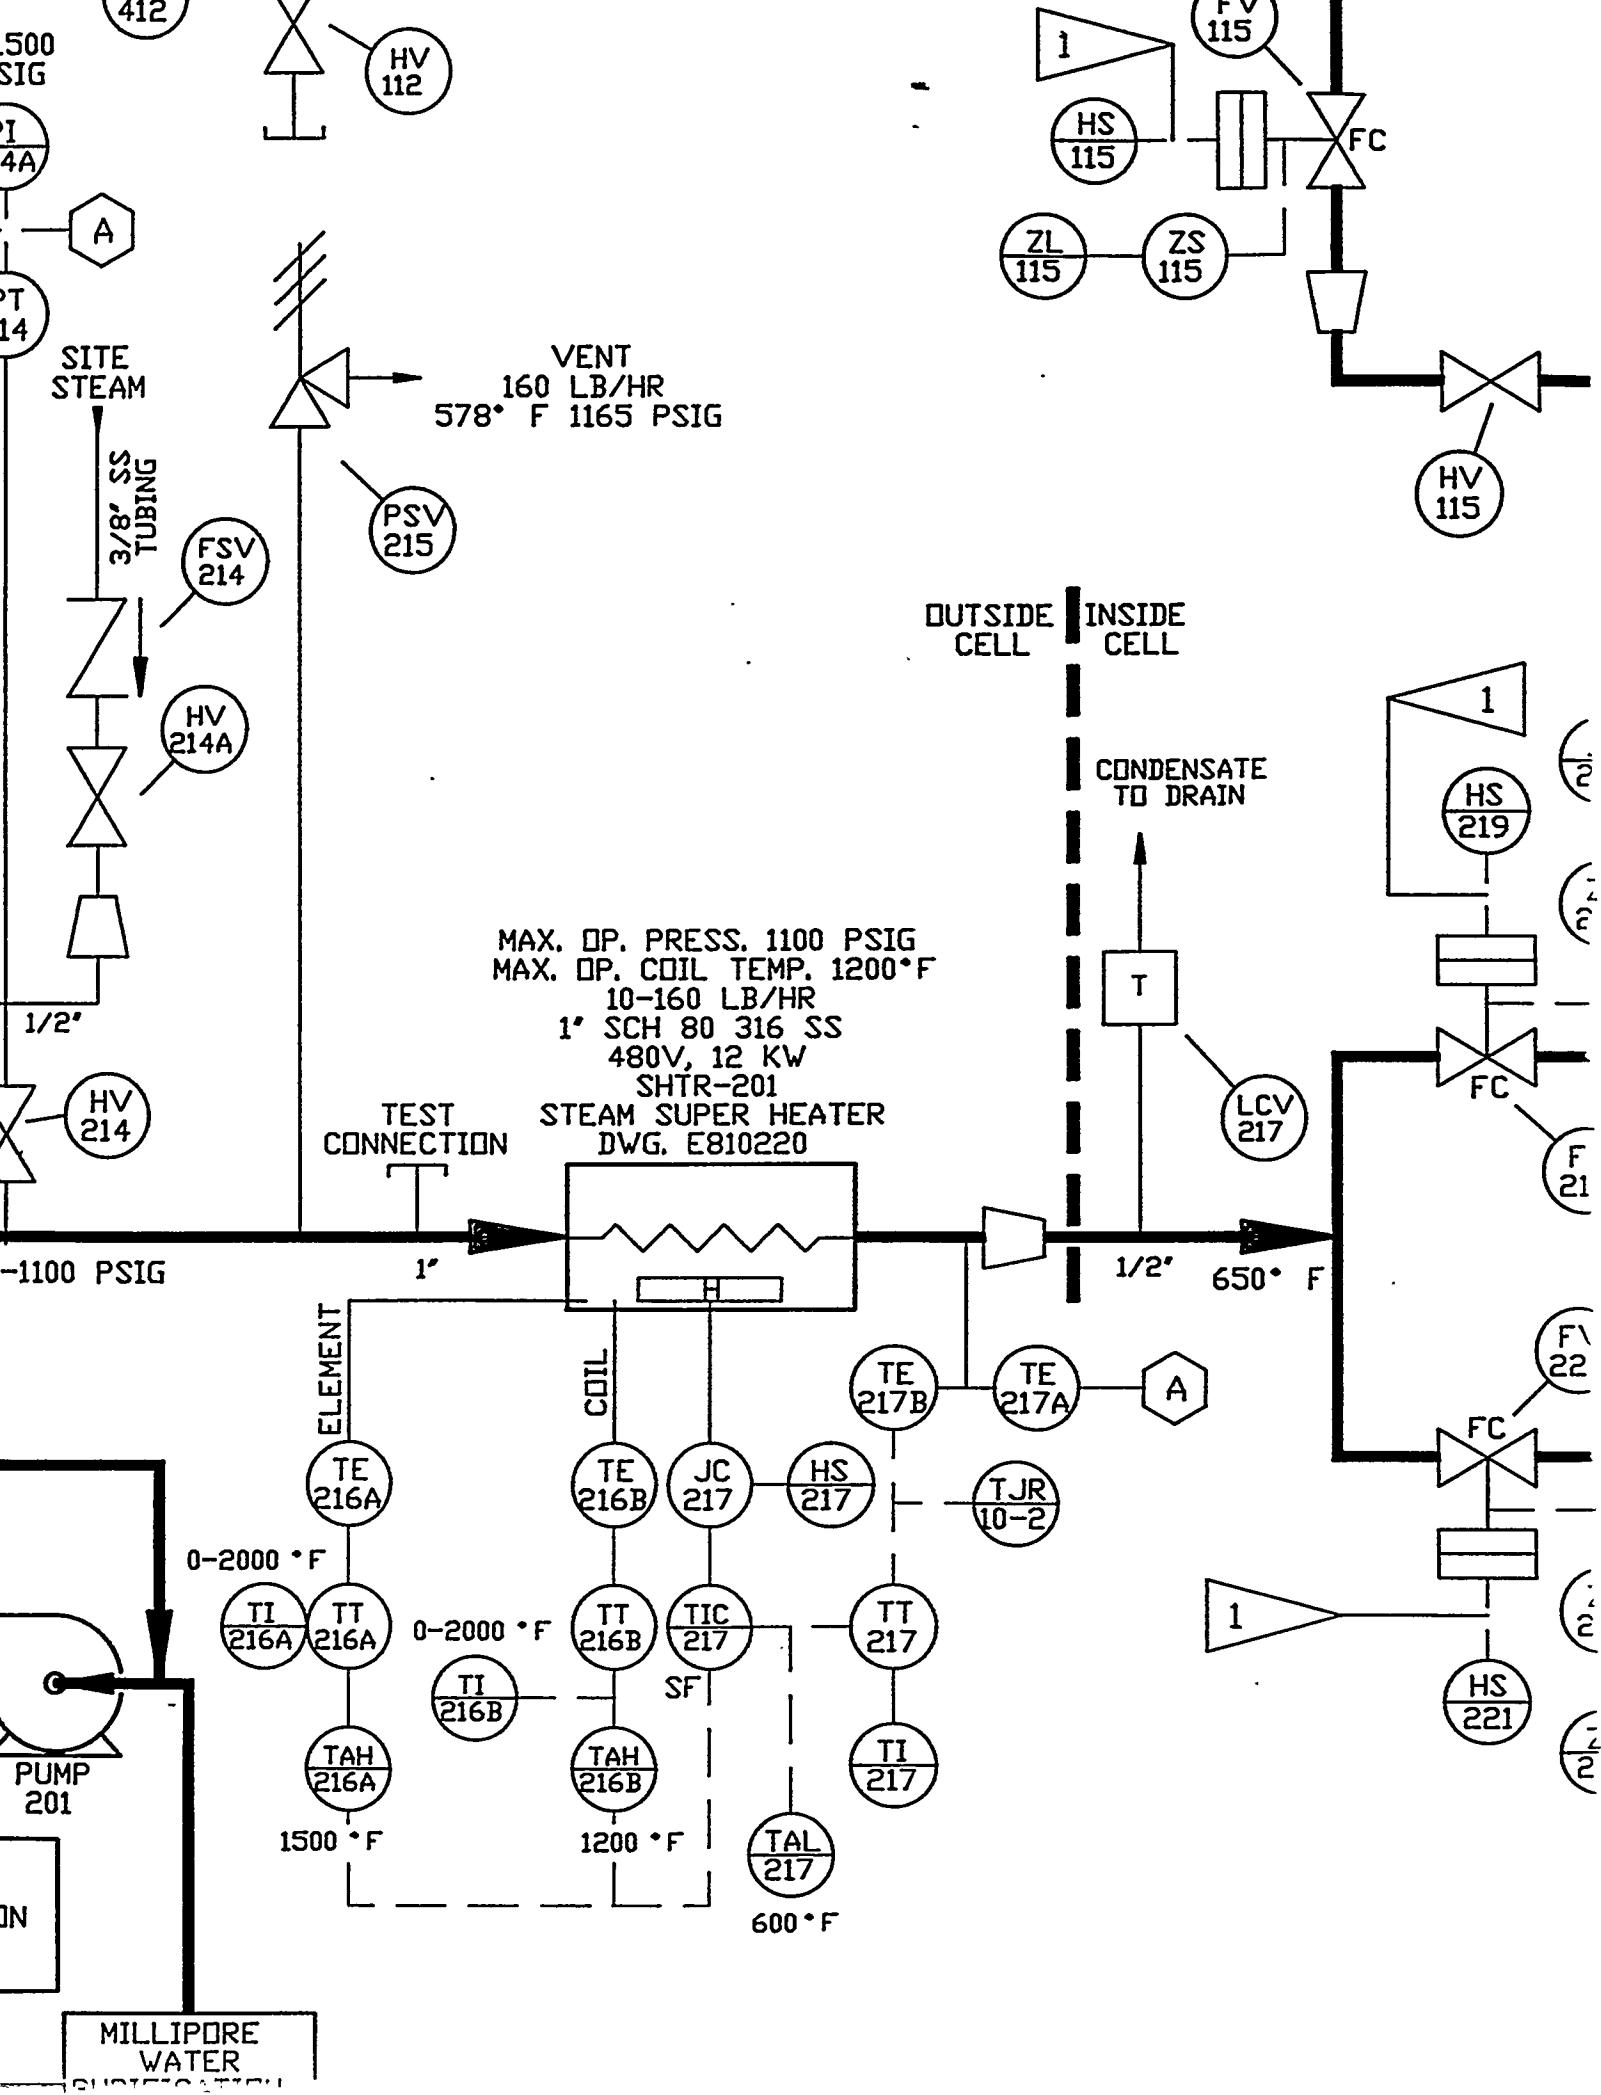

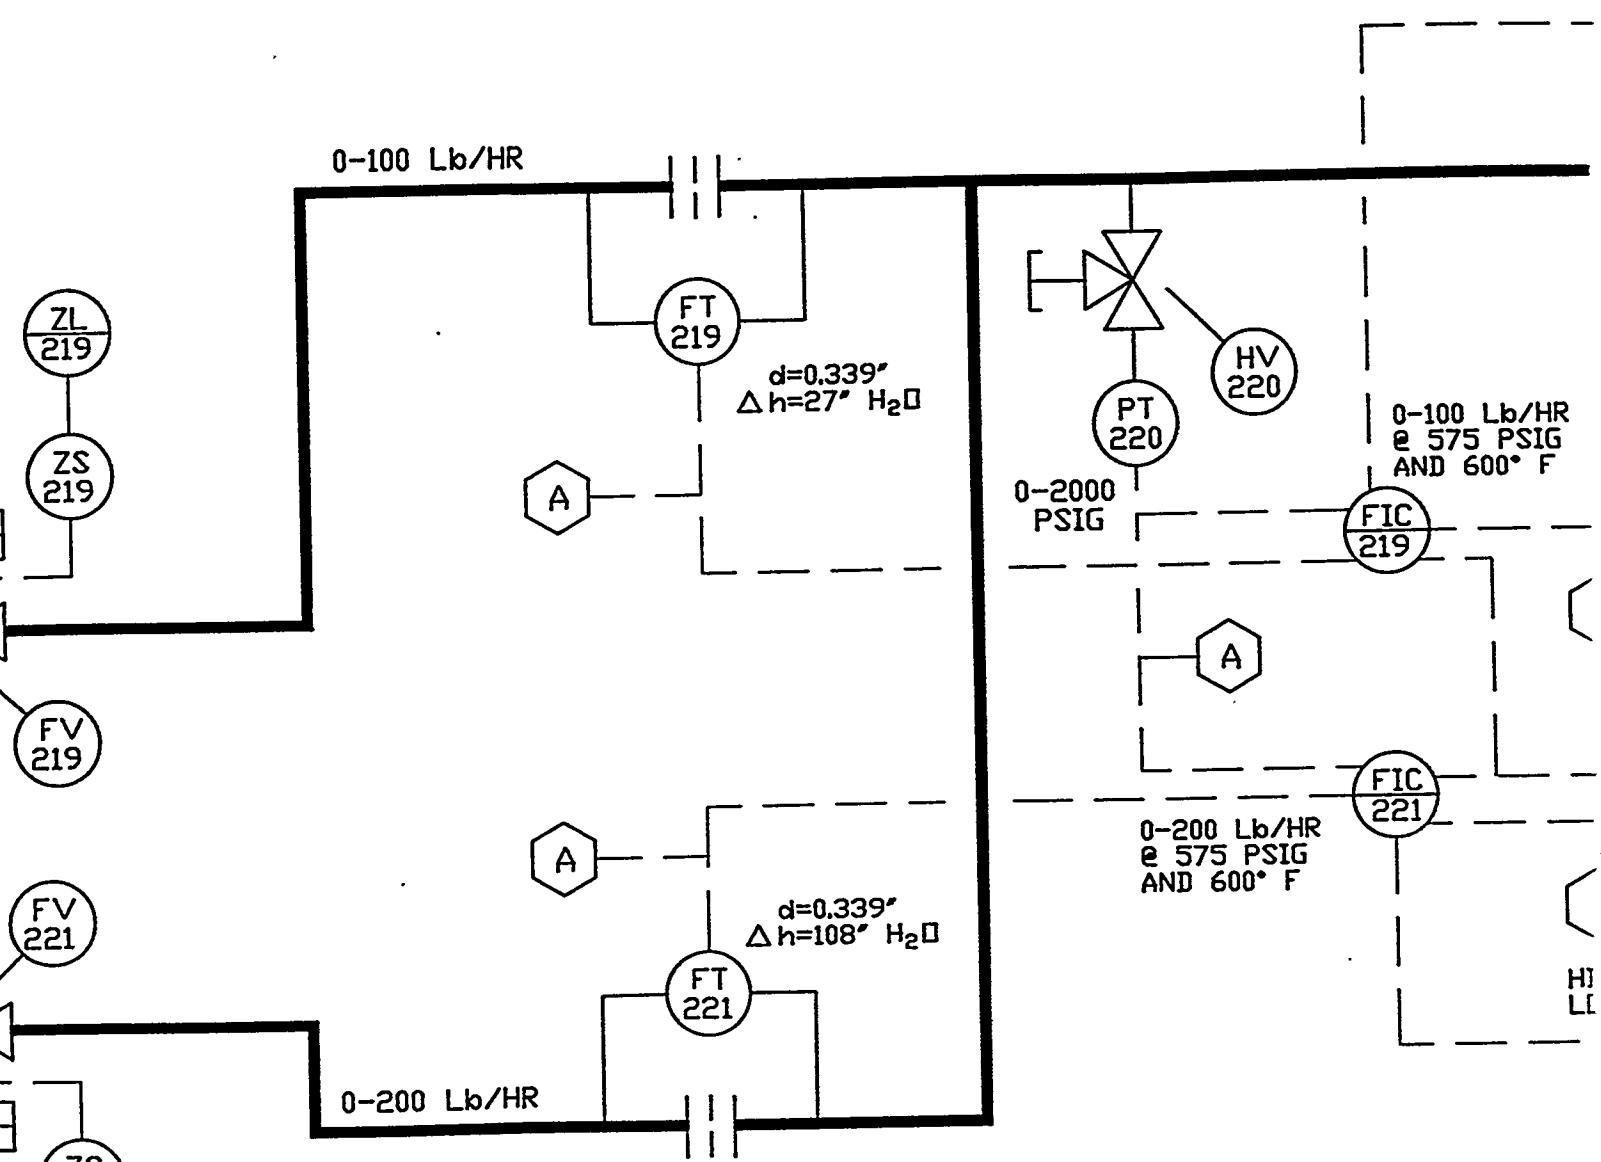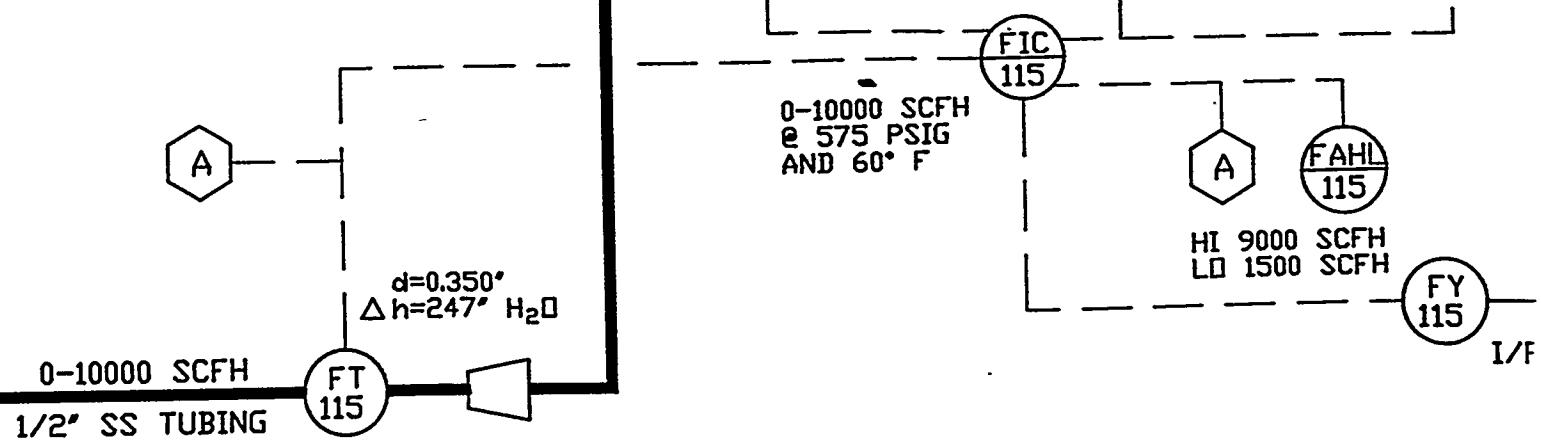

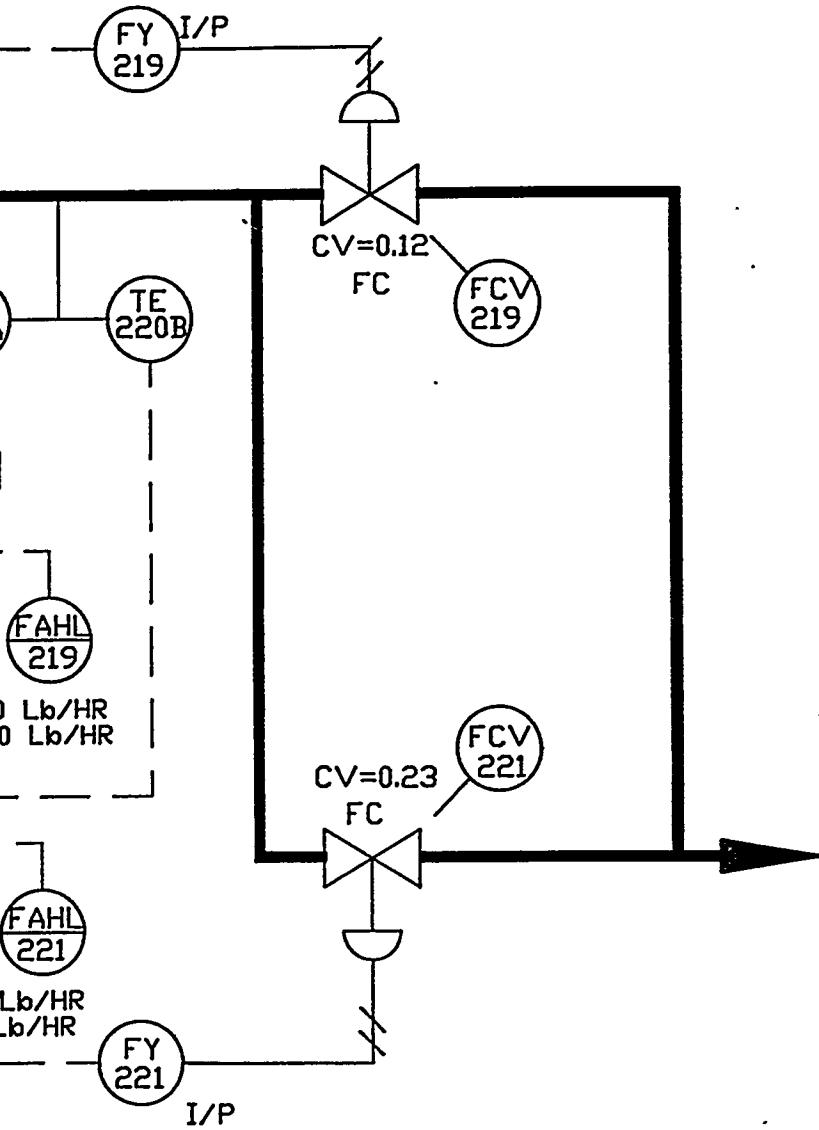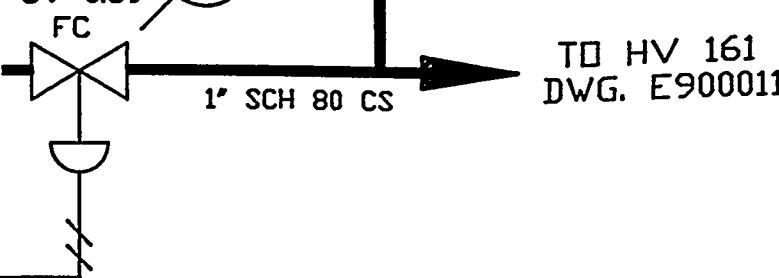


N


E


D


NOTES:

THIS FLAGGED NOTE DESIGNATES THE FOLLOWING EQUIPMENT
TO BE DELETED FROM THIS PAGE FOR CLARITY.

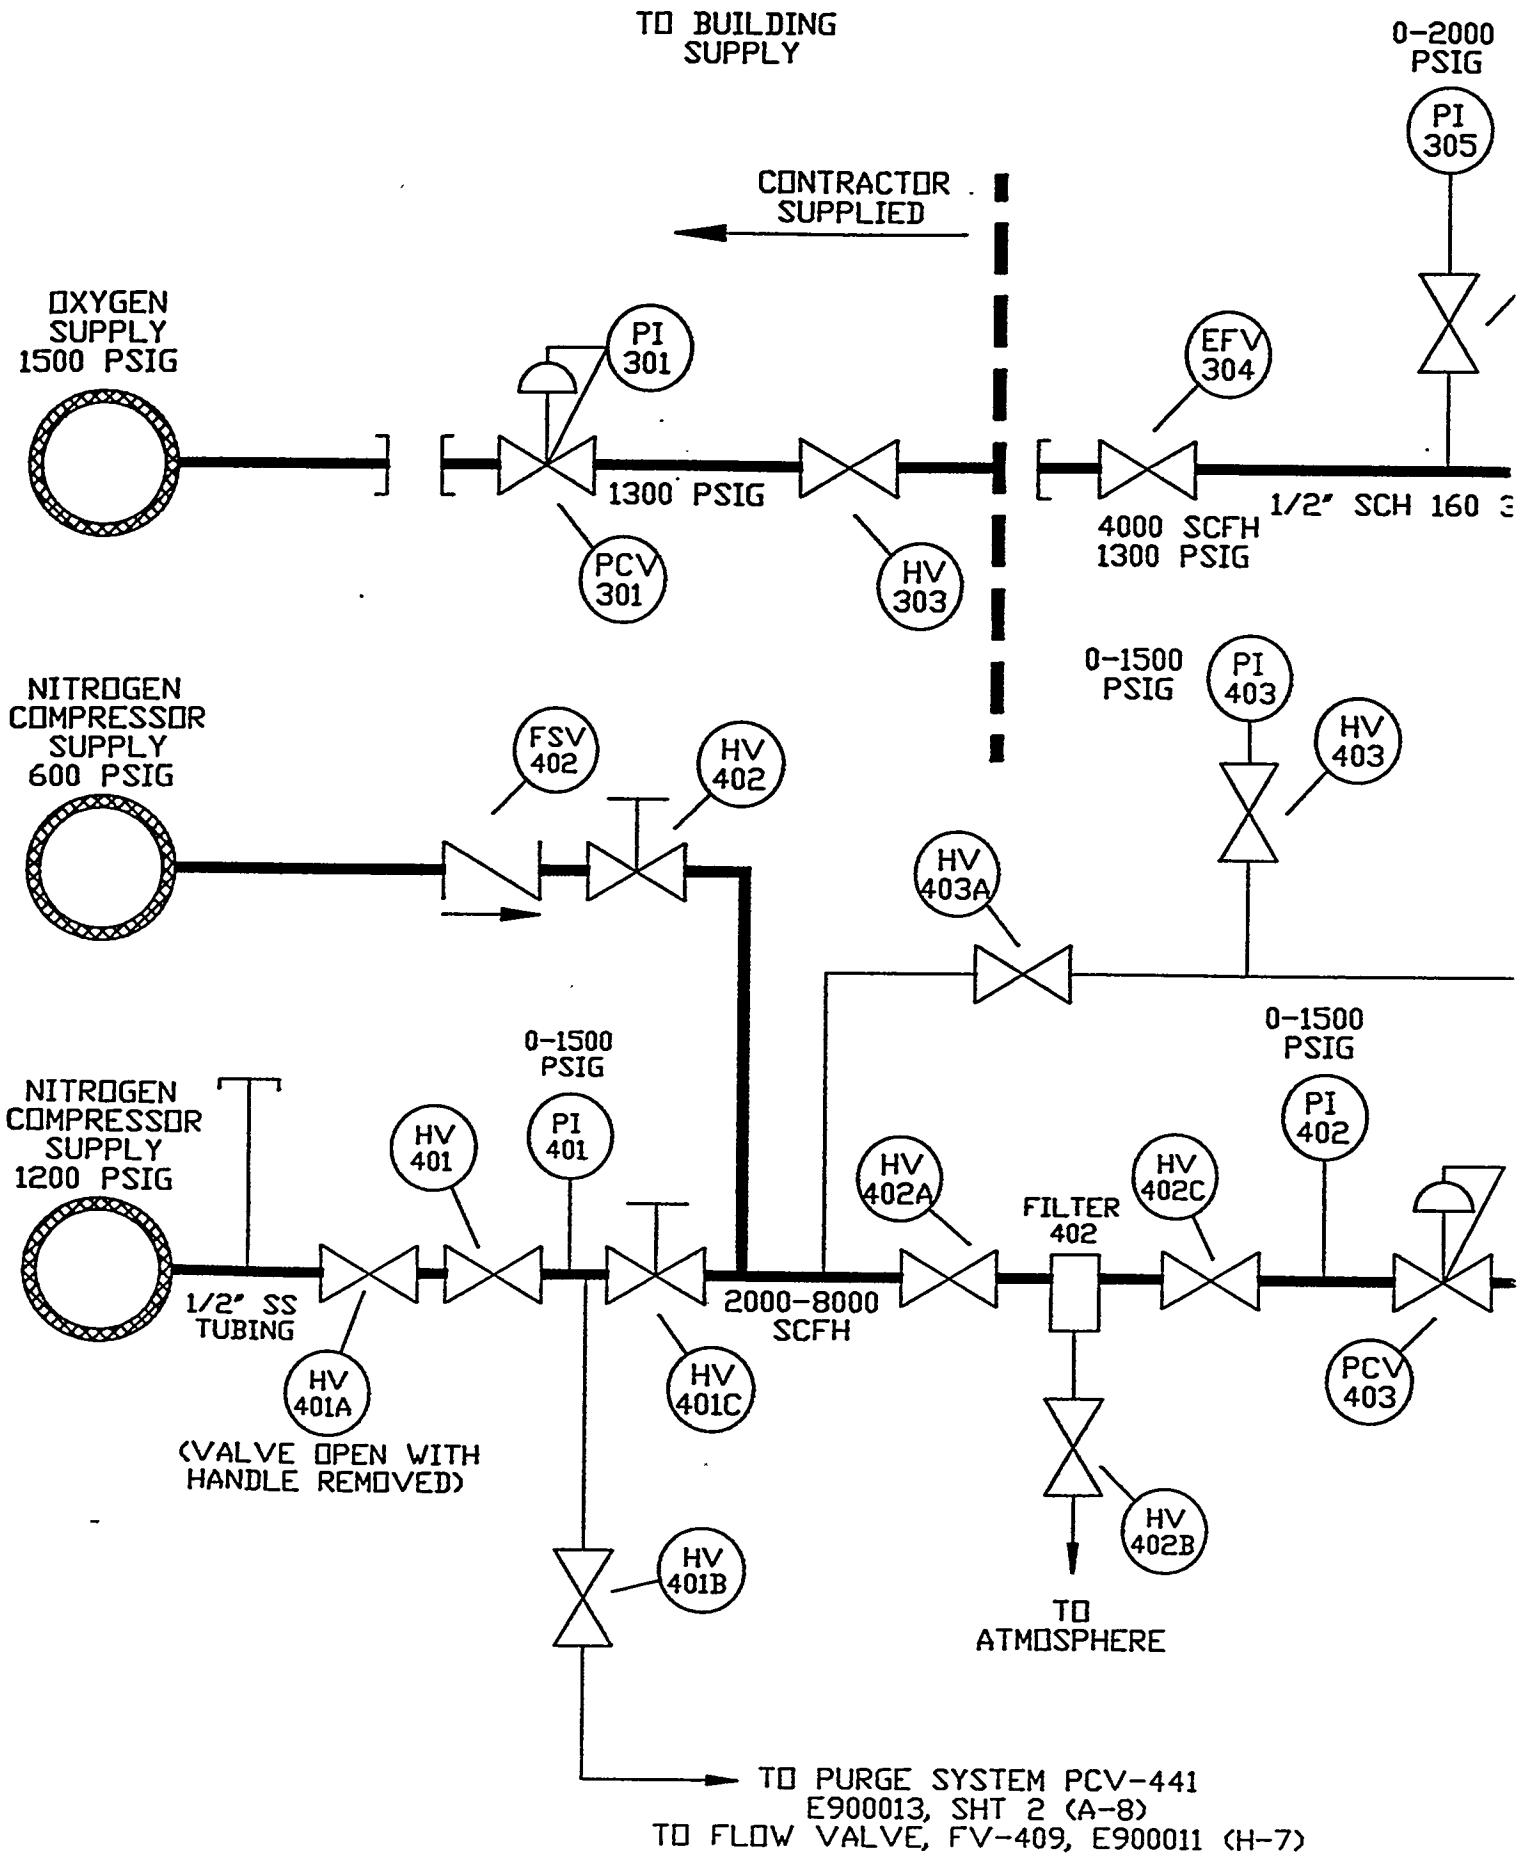

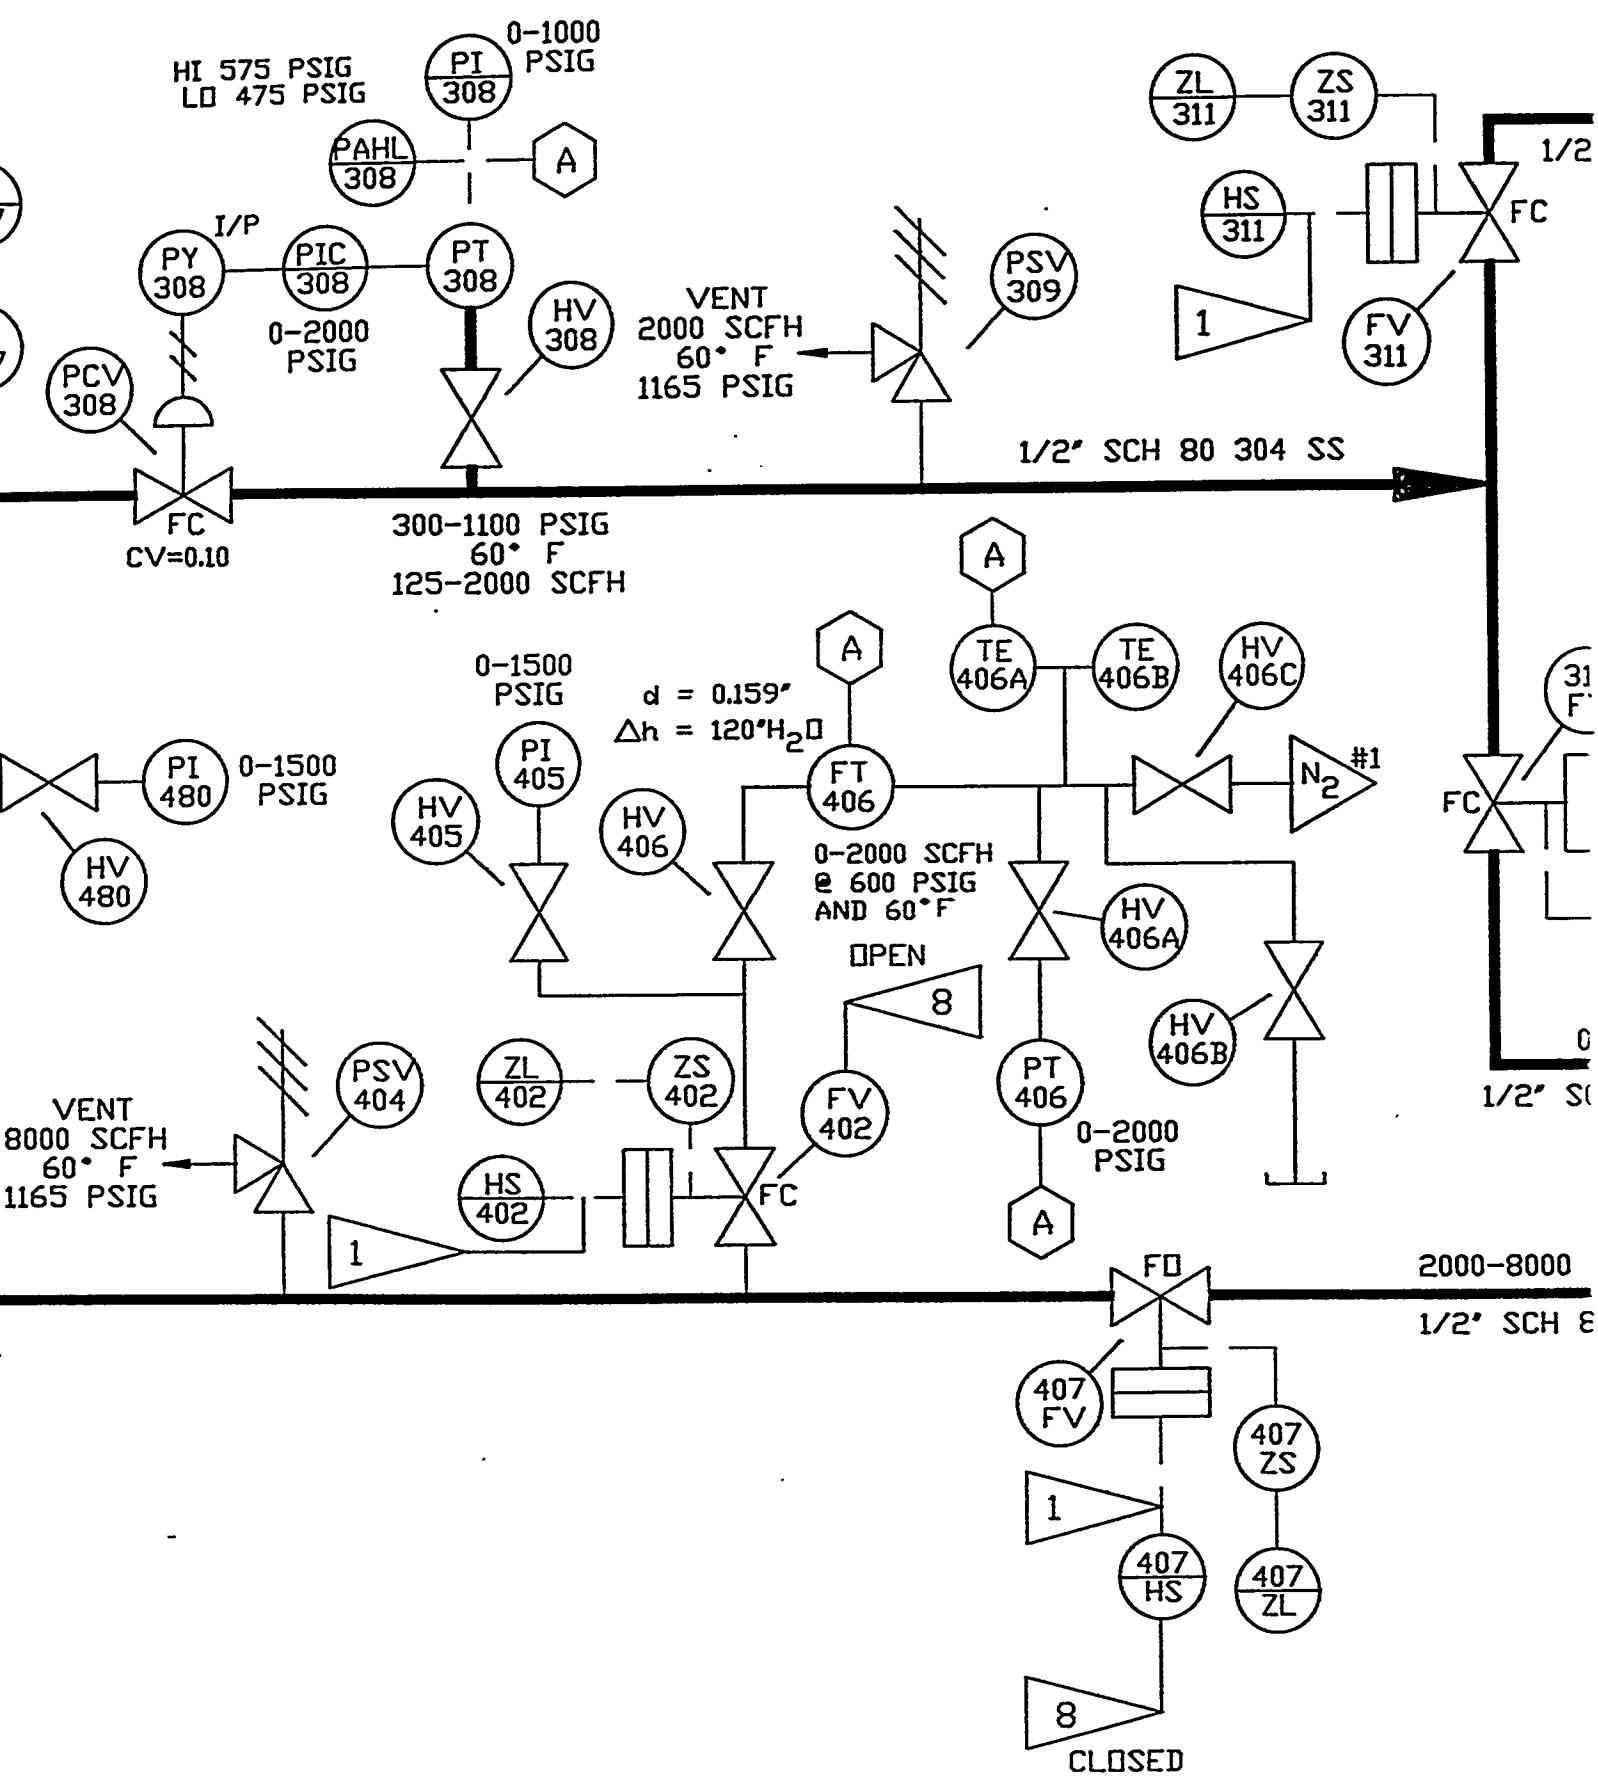

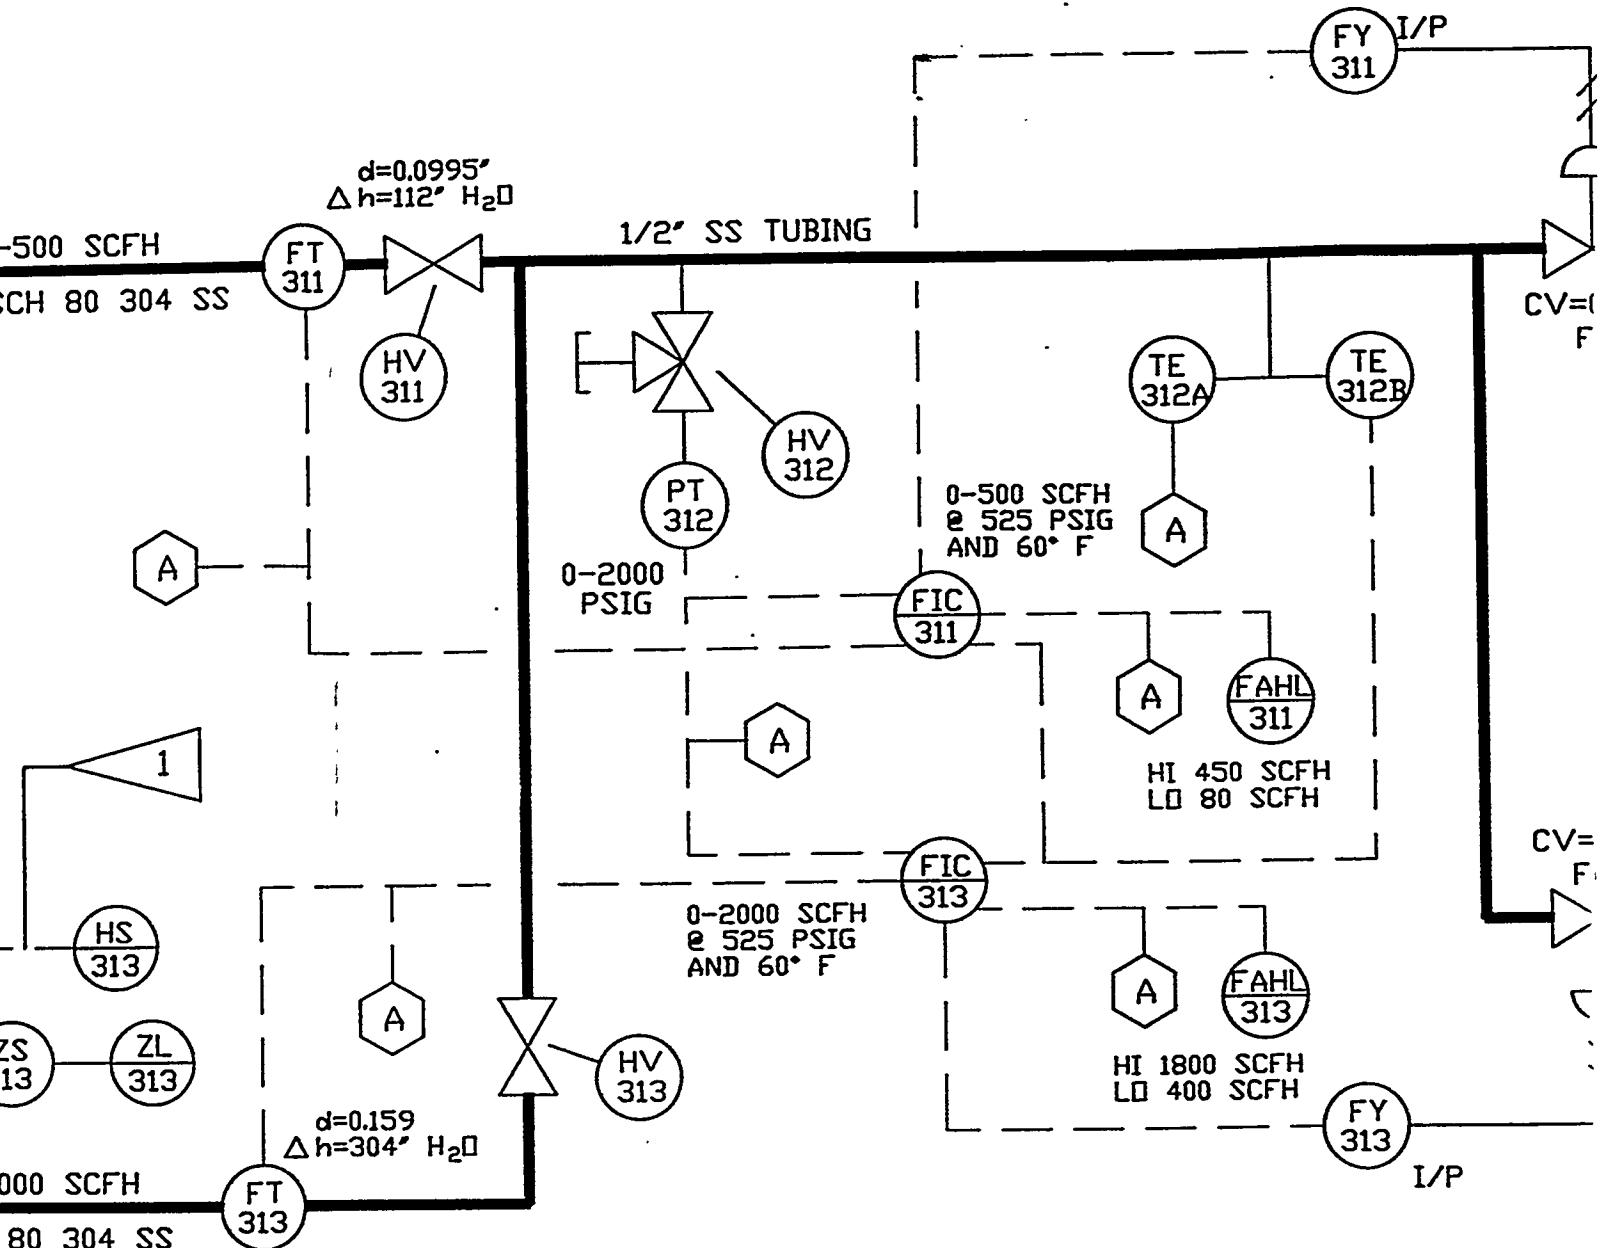

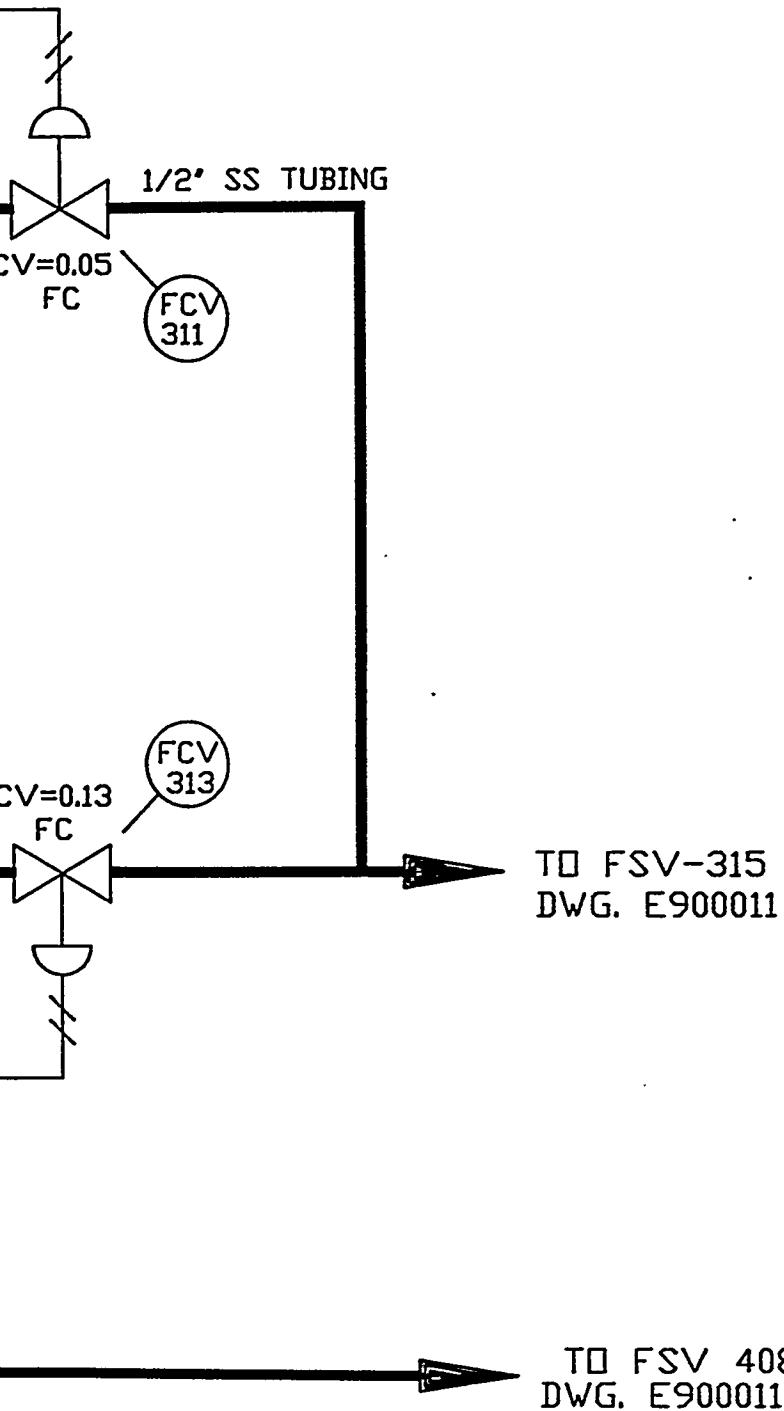

1
2
3
4
5
6
7
8
9
10
11

REFERENCE DRAWINGS	DRAFTER
	S.
E900011	CHECKER
E900012	A. R
E900013	PROJECT EN
	J. P.

THIS DRAWING IS PART
OF THE EG&G DOCUMENT
CONTROL SYSTEM

1 WHICH IS NOT SHOWN ON THIS DWG. FOR CLARITY)
PANEL-MOUNTED ON/OFF STATION (HAND SWITCH WITH
POSITION INDICATION LAMPS), 24 VDC RELAY, 117 VAC
60 HZ SOLENOID VALVE.

2 FV-106 & FV-406 ARE ELECTRICALLY SELECTED BY A
PANEL-MOUNTED 2-POSITION TOGGLE SWITCH. ONLY ONE
VALVE CAN BE OPEN AT A TIME. REF. PRINT DWG
D820030 SHTS 3 & 17.

3 HS-106, HS-107, AND HS-109 ARE ELECTRICALLY INTERLOCKED.
FV-106 OPENS WHEN EITHER FV-107 OR FV-109 IS OPENED.
FV-107 AND FV-109 CAN BOTH BE OPEN AT THE SAME TIME.

4 HS-112, HS-113 AND HS-115 ARE ELECTRICALLY INTERLOCKED.
FV-112 OPENS WHEN EITHER FV-113 OR FV-115 IS OPENED.
FV-113 AND FV-115 CAN BOTH BE OPEN AT THE SAME TIME.

5 WATER LEVEL SWITCH CONTROLS RELAY TO 117 VAC 60 HZ
3-WAY SOLENOID VALVE

6 LB/HR = (lb mass / hour)

7 THIS DWG. & DWGS. E900011, E900012 & E900013
SUPERCEDES DWG. R800524 (SEE DWG. E900013 FOR
NOTES, TUBING & PIPING SUMMARY).


8 DESIGNATES THE CONTROL PANEL SWITCH IS PHYSICALLY
LOCKED TO PREVENT ACCIDENTAL ACTUATION.

9 BOILER WATER LEVEL IS CONTROLLED BY 3 CAPACITANCE
PROBES. SHORTEST PROBE SHUTS BOILER FEED WATER
PUMP OFF. MIDDLE PROBE TURNS BOILER FEED WATER
PUMP ON. LONGEST PROBE SHUTS THE BOILER DOWN.

10 FV-112 & FV-412 ARE ELECTRICALLY SELECTED BY A
PANEL-MOUNTED 2-POSITION TOGGLE SWITCH. ONLY ONE
VALVE CAN BE OPEN AT A TIME.

11 "NOTE REMOVED"

DRAFTER	S. CONKO	DATE	3/6/90
CHECKER	A. R. KUBALA	DATE	3/6/90
PROJECT ENGINEER	J. P. KANOISKY	DATE	3/6/90
		DATE	

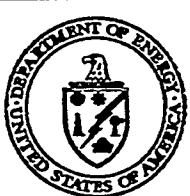


United States Department of Energy
MORGANTOWN ENERGY TECHNOLOGY CENTER
Morgantown, WV


B-12 P&ID
FLUIDIZED BED GASIFIER
A.G.C., CONCEPTUAL

DATE	SIZE	FSCH NO	DWG NO	REV
	E		E900010	6

H

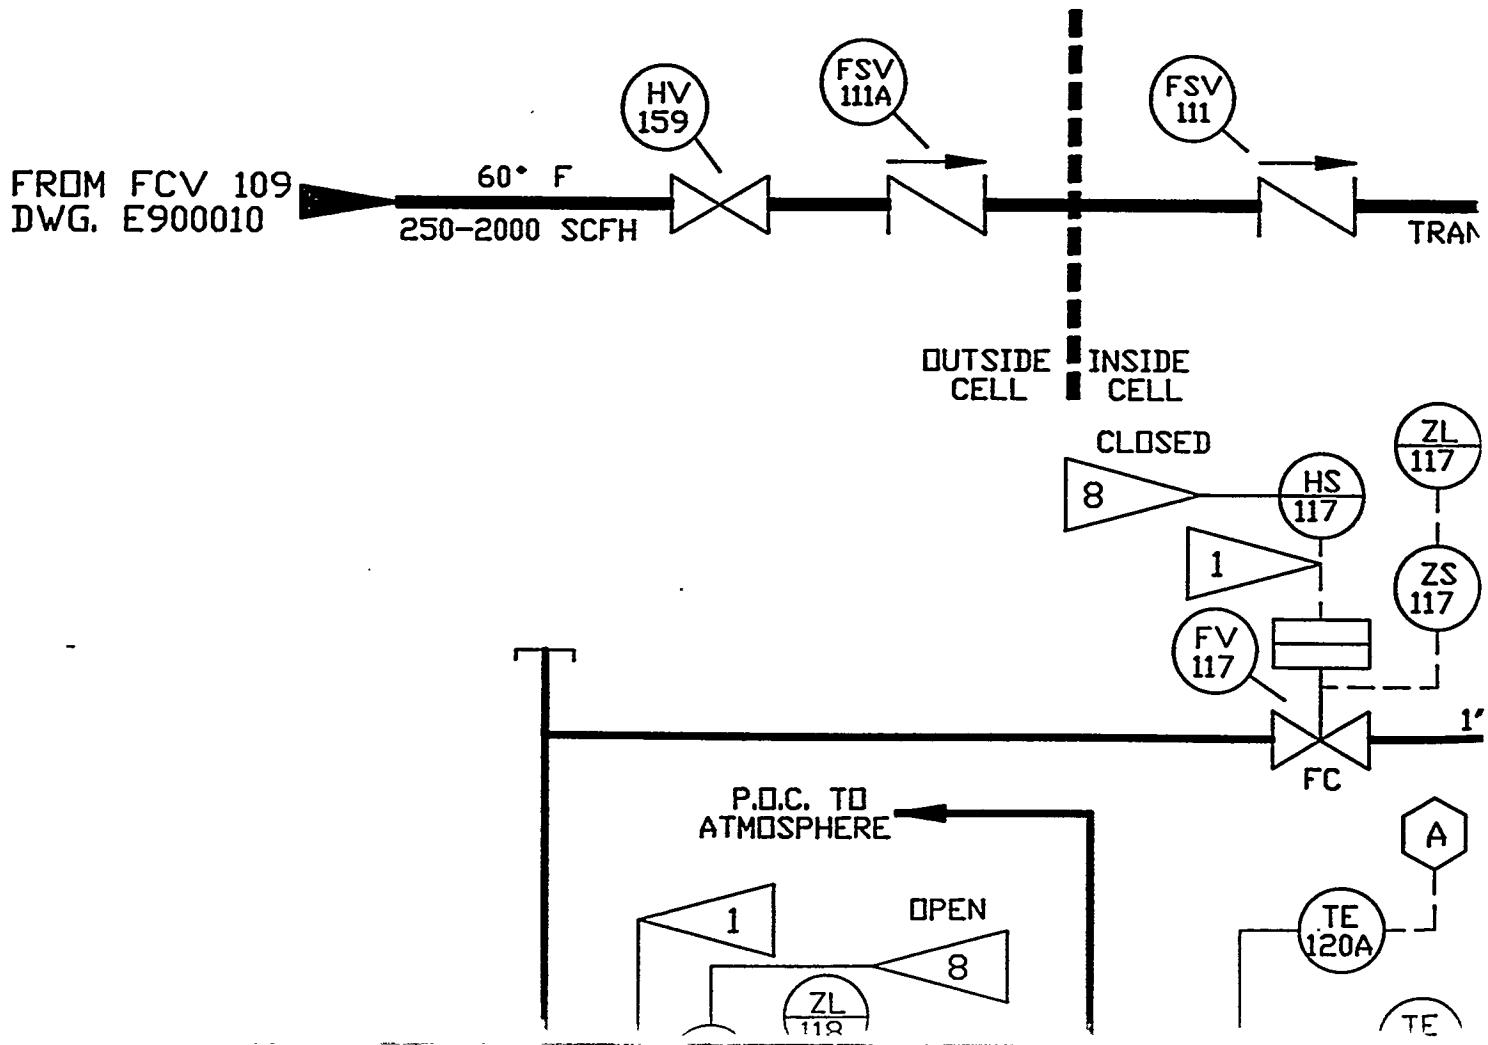


F

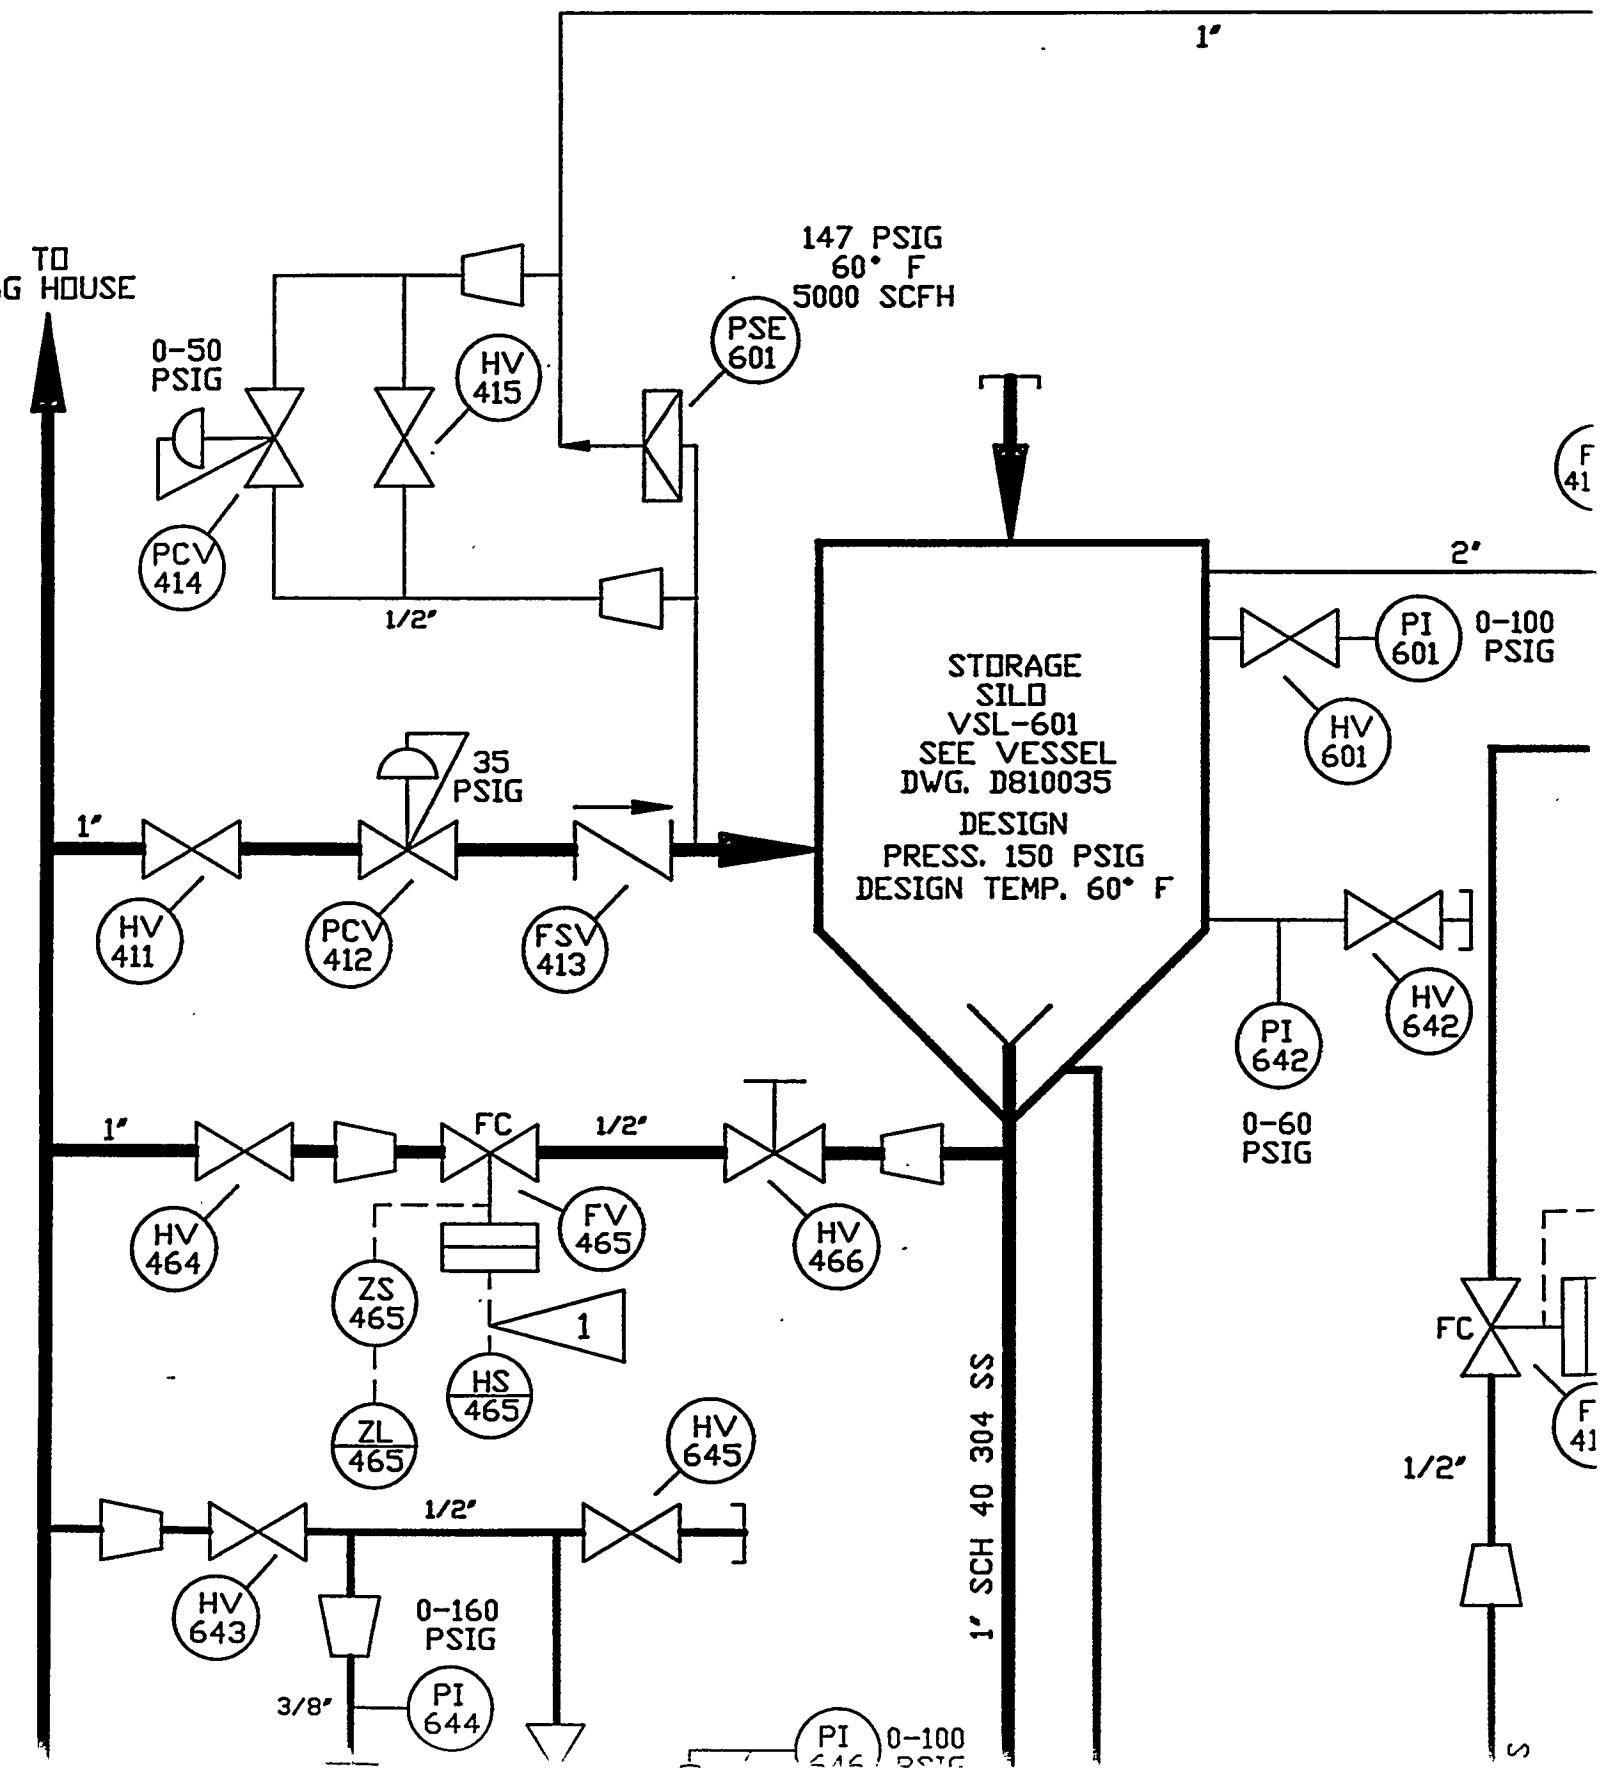


5


4

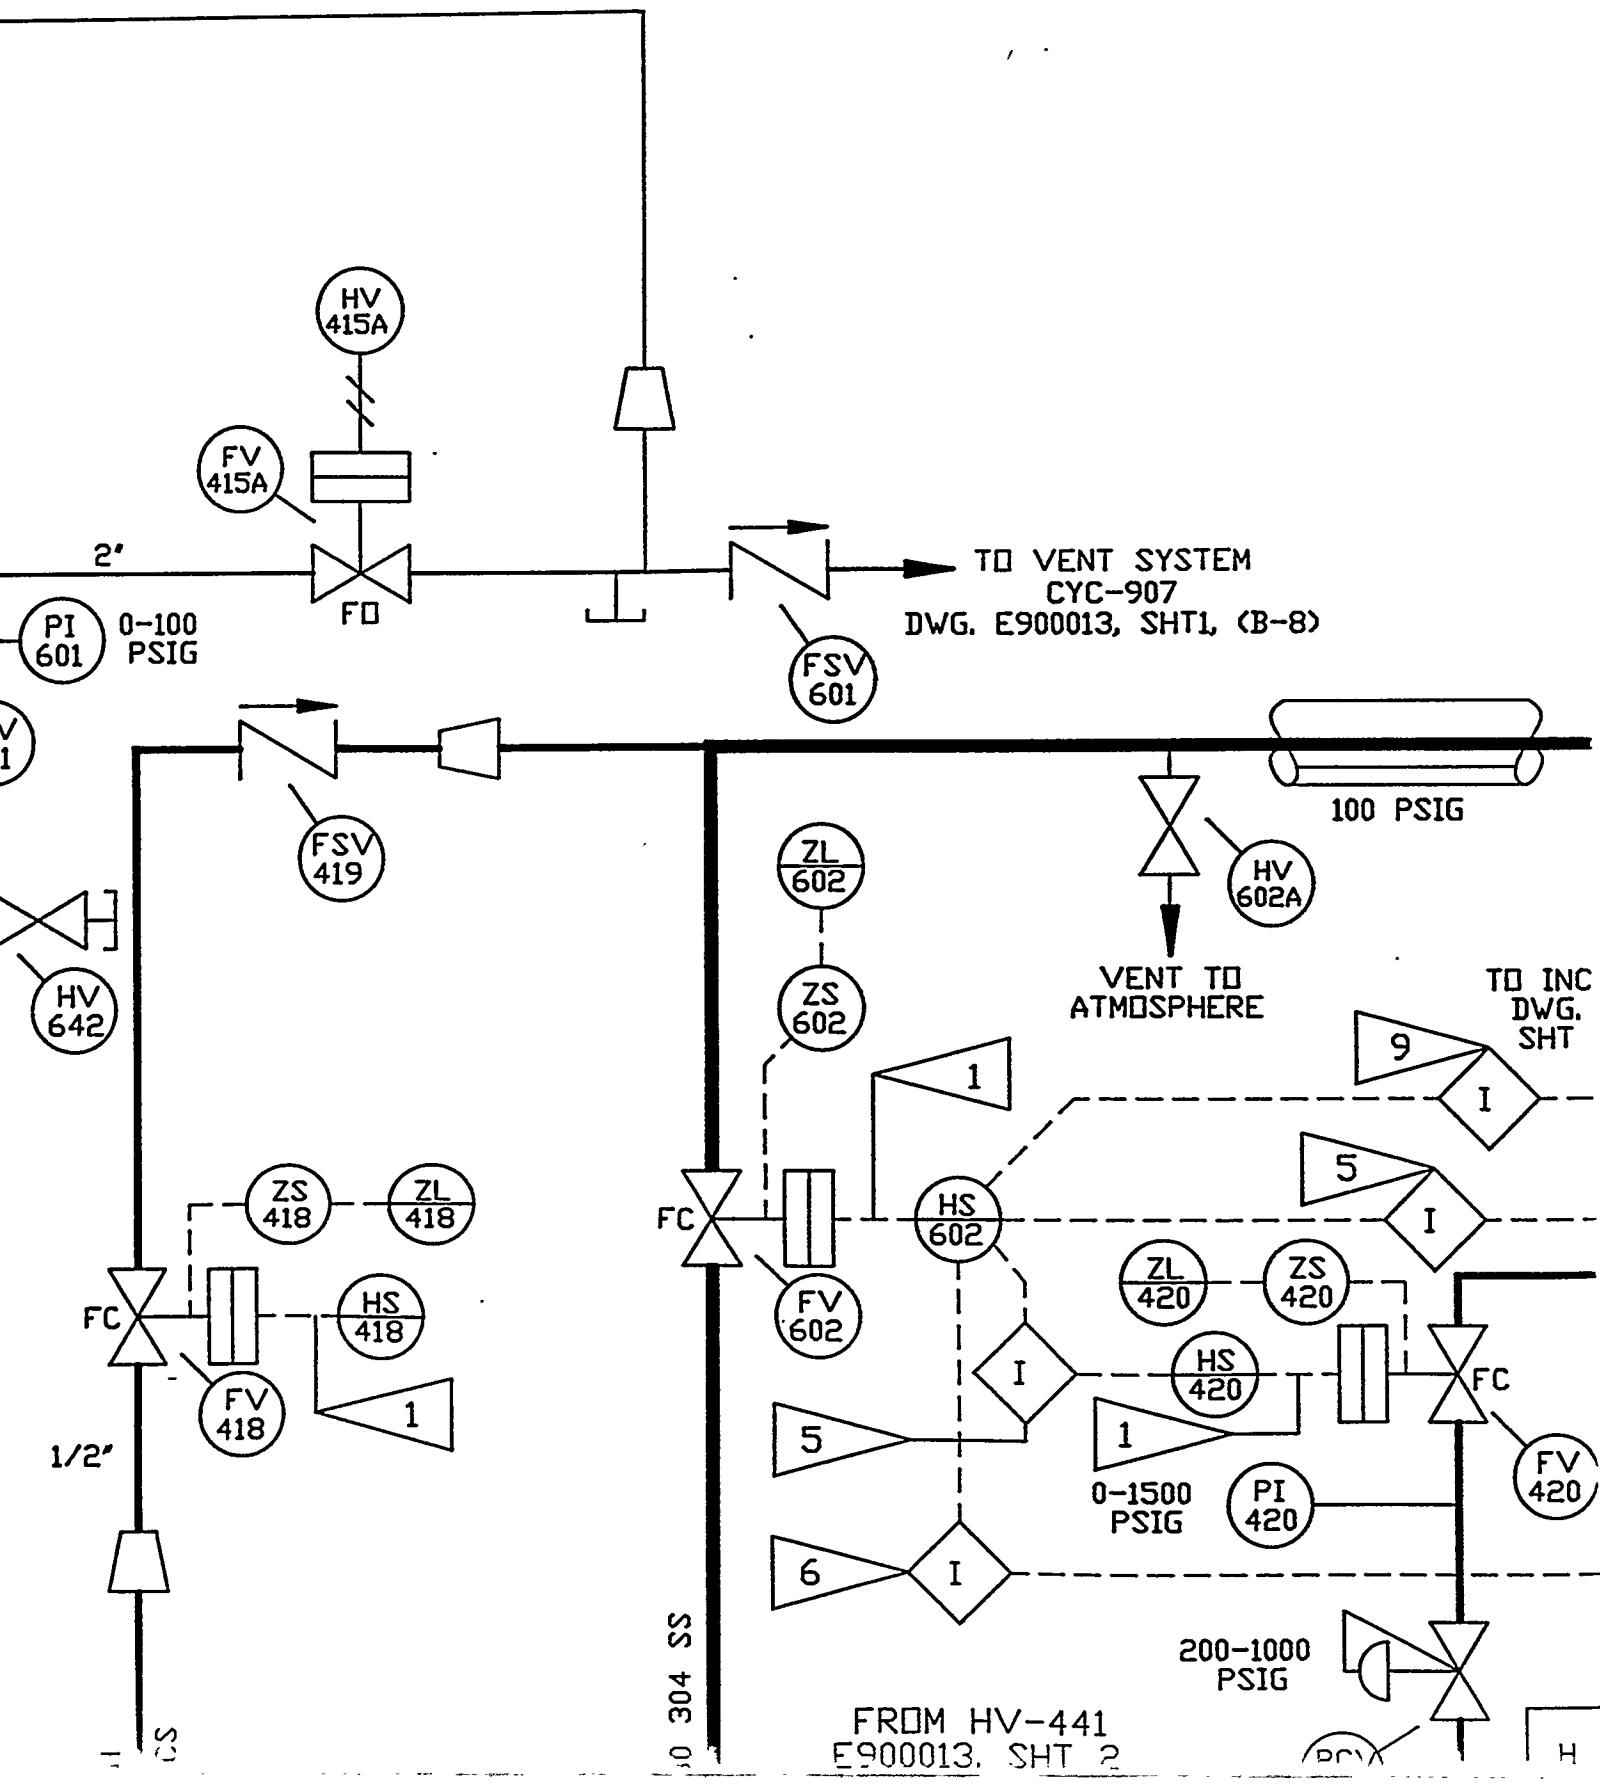

TO STORAGE
CYCLONE CYC-907
DWG. E900013, SHEET 1
AREA B-8

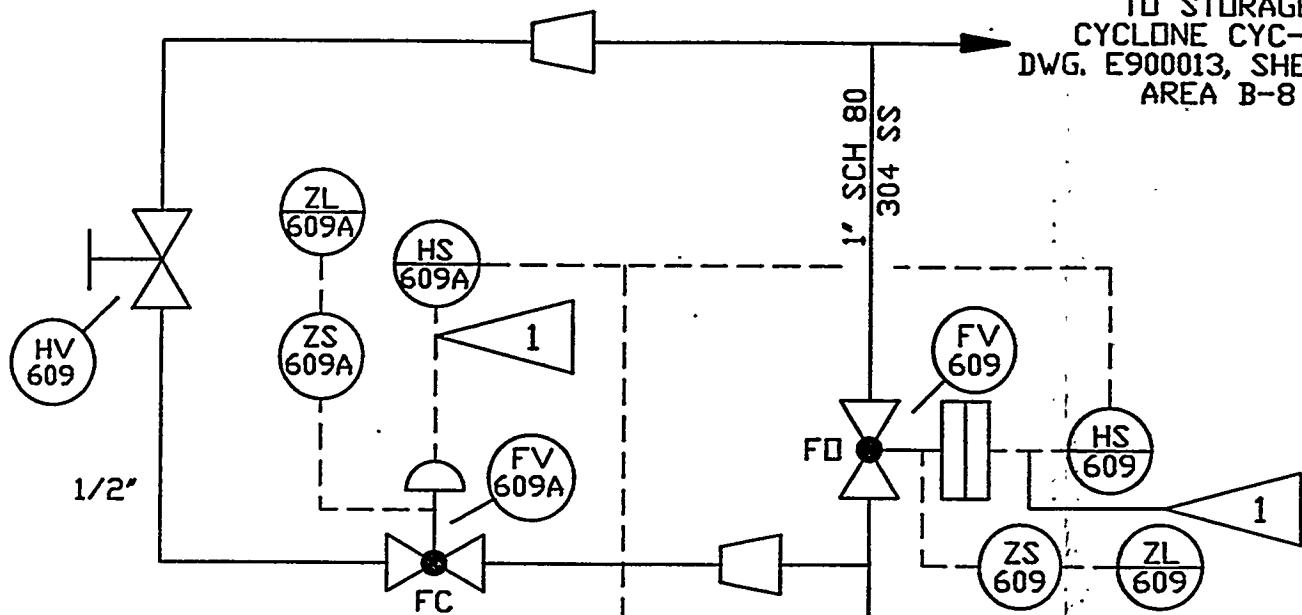


1' COAL TRANSFER LINE

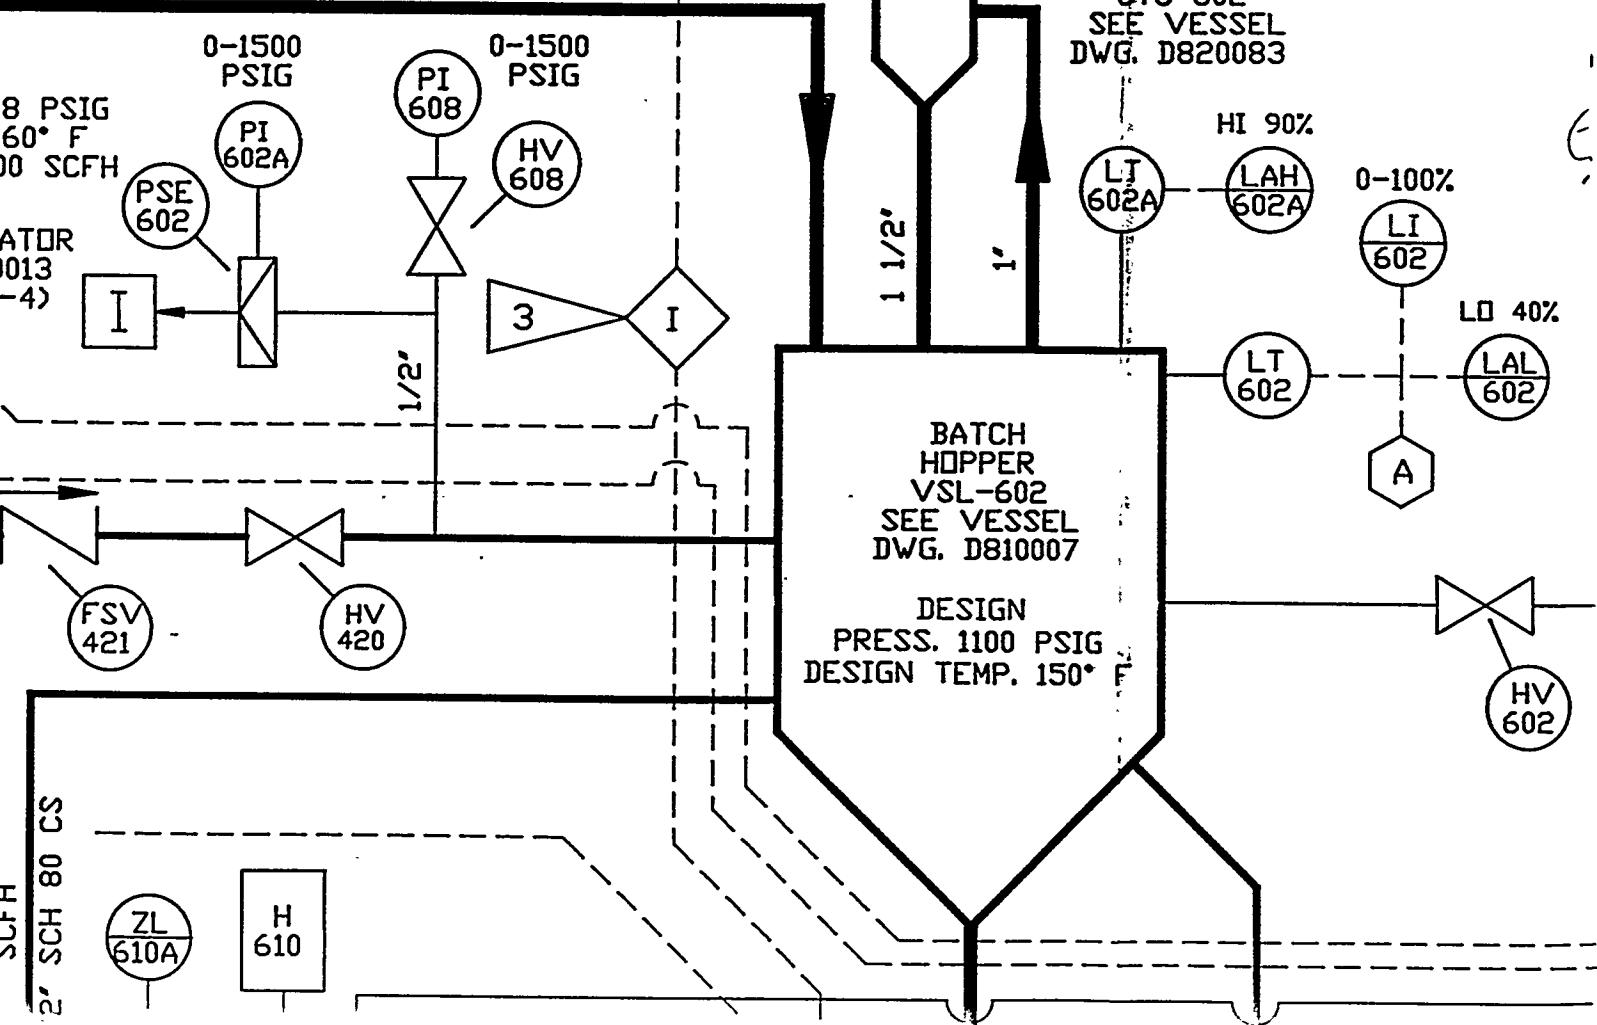

REVISION


LINE	REV	DESCRIPTION						DATE
-1 EN EN EN	3	CHANGED DWG. TITLE UPDATED AS PER MARKED PRINT WITH WORK PLAN ISSUED FOR CONSTRUCTION						9/16/92
		RELOCATED SAMPLE SYSTEM TO E900013_SHT_2 REVISED AS PER MARKED PRINT						11/16/92
TER GARY KULCHOCK	DATE 11/18/92	CHECKER S CONKO	DATE 11/18/92	EG&G RESPON ENGR JAY RUTTEN	DATE 11/19/92	EG&G REVIEWER D. LUNIFIELD	DATE 11/19/92	
RESPON SECT SUPV NA	DATE	EG&G E&H J. L. BUCKLEW	DATE 11/19/92		DATE	JOHN ROTUNDA	DATE 11/24/92	
LINE	REV	DESCRIPTION						DATE
EN	4	ADDED DESIGN PRESS. AND TEMP. TO FDR-601, VSL-602, & VSL-601 ADDED MAX. OPP. PRESS. AND COIL TEMP. TO SHTR-202 AND HTR-101 ADDED PSE-120, REMOVED NUMBERS FROM ALL ADACS SYMBOLS						4/1/93
TER GARY KULCHOCK	DATE 4/5/93	CHECKER S CONKO	DATE 4/5/93	EG&G RESPONSIBLE ENGR. JAY RUTTEN	DATE 4/7/93	REVIEWER D. LUNIFIELD	DATE 4/7/93	
E&H J. L. BUCKLEW	DATE 4/7/93	PROJECT ENGR. JOHN ROCKEY	DATE 5/27/93	BRANCH MANAGER LARRY STRICKLAND	DATE 5/27/93	DOE CEISID BILL AYERS	DATE 5/27/93	
LINE	REV	DESCRIPTION						DATE
EN	5	ADDED LT-602A, LT-603A, FSV-601, HV-321 & HV-320; MODIFIED LAHL 602 TO LAH-602 & LAL-602 MODIFIED LAHL 603 TO LAH-603 & LAL-603; ADDED "#1" TO N ₂ ; ADDED NOTE 10 ADDED INCINERATOR NOTES TO (2) INCINERATOR DESIGNATIONS; ADDED NOTE TO VENT SYSTEM (G-4) REMOVED PSE-120, HCV-118, TCV-126 AND RELATED PIPING; RELOCATED FSV-315 ISSUED FOR CONSTRUCTION						9/01/93
TER Gary Kulchock	DATE 9/10/93	CHECKER S. Conko	DATE 9/14/93	EG&G RESPONSIBLE ENGR. Jay Ruttent	DATE 9/15/93	REVIEWER Dave Lunifeld	DATE 9/20/93	
E&H Larry Bucklew	DATE 9/17/93	PROJECT ENGR. John Rockey	DATE 9/21/93	BRANCH MANAGER Larry Shadle	DATE 9/21/93	DOE CEISID John Rotunda/WJA	DATE 9/20/93	
LINE	REV	DESCRIPTION						DATE
EN	6	EXTENSIVE CHANGES AS PER MARKED PRINT REDLINED BY JAY RUTTEN ON 15 FEB 94. ISSUED FOR CONSTRUCTION						8/18/94
TER Larry Bucklew	DATE 10/17/94	CHECKER S. Conko	DATE 10-7-94	EG&G RESPONSIBLE ENGR. Jay Ruttent	DATE 10-11-94	REVIEWER D. Lunifeld	DATE 10/11/94	
E&H Larry Bucklew	DATE 10-11-94	PROJECT ENGR. John Rockey	DATE 10/13/94	BRANCH MANAGER Larry Shadle	DATE 10-19-94	DOE CEISID John Rotunda/WJA	DATE 10/14/94	

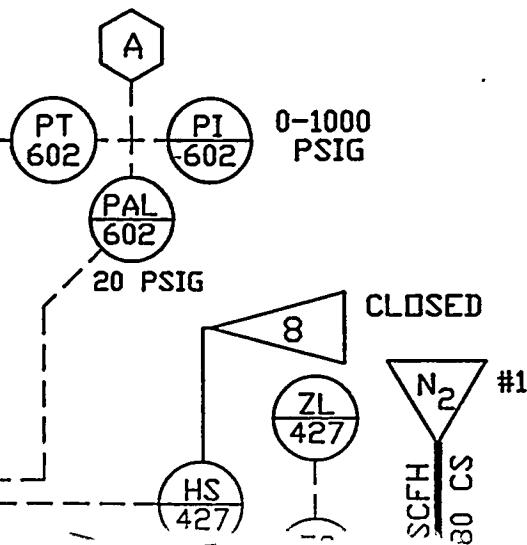


H


G


F

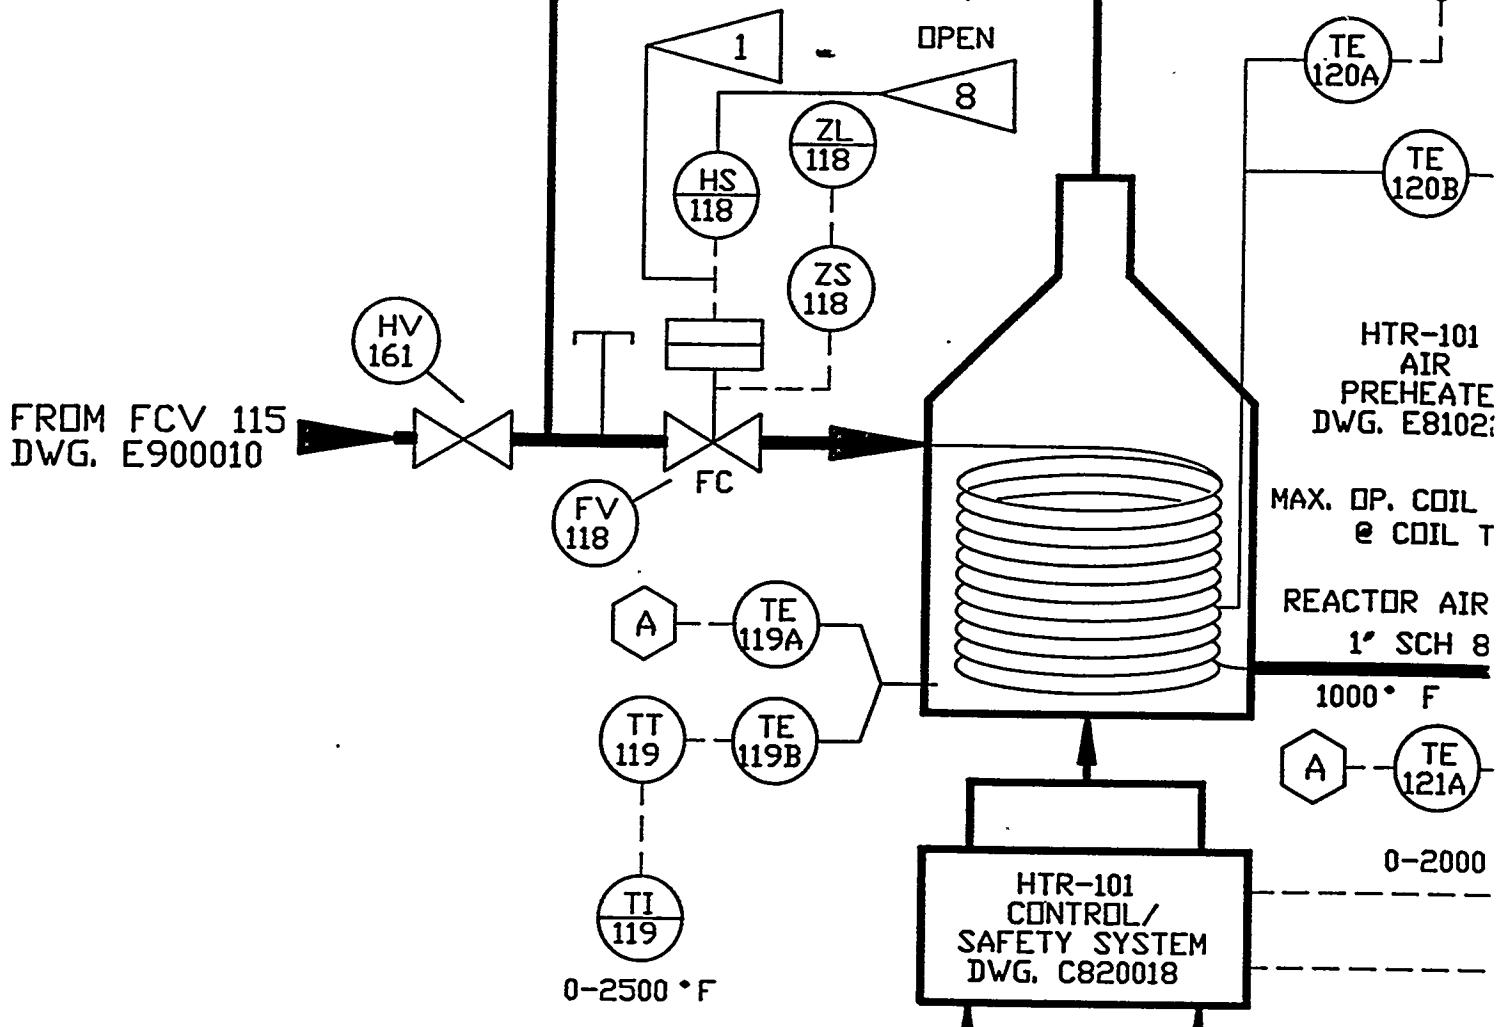


MAX. OP. PRESS. 1100 PSIG
MAX. OP. COIL TEMP. 1200° F
480V, 12 KW
SHTR-202
STEAM SUPER HEATER
DWG. E810220

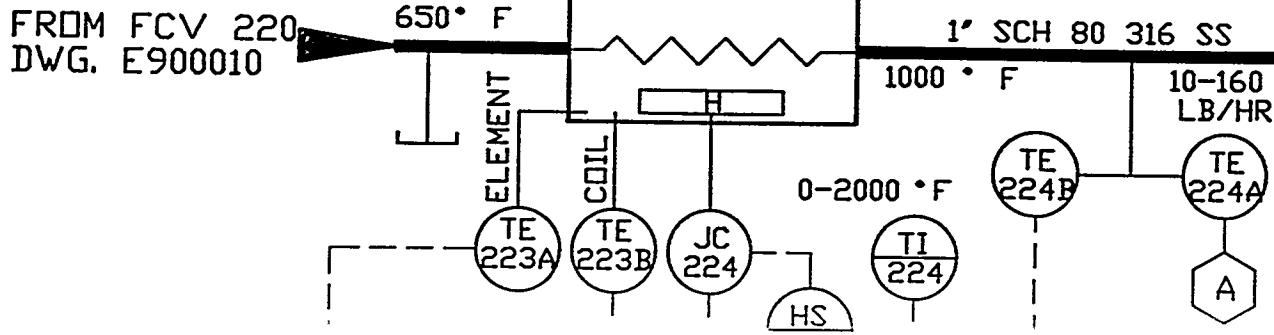


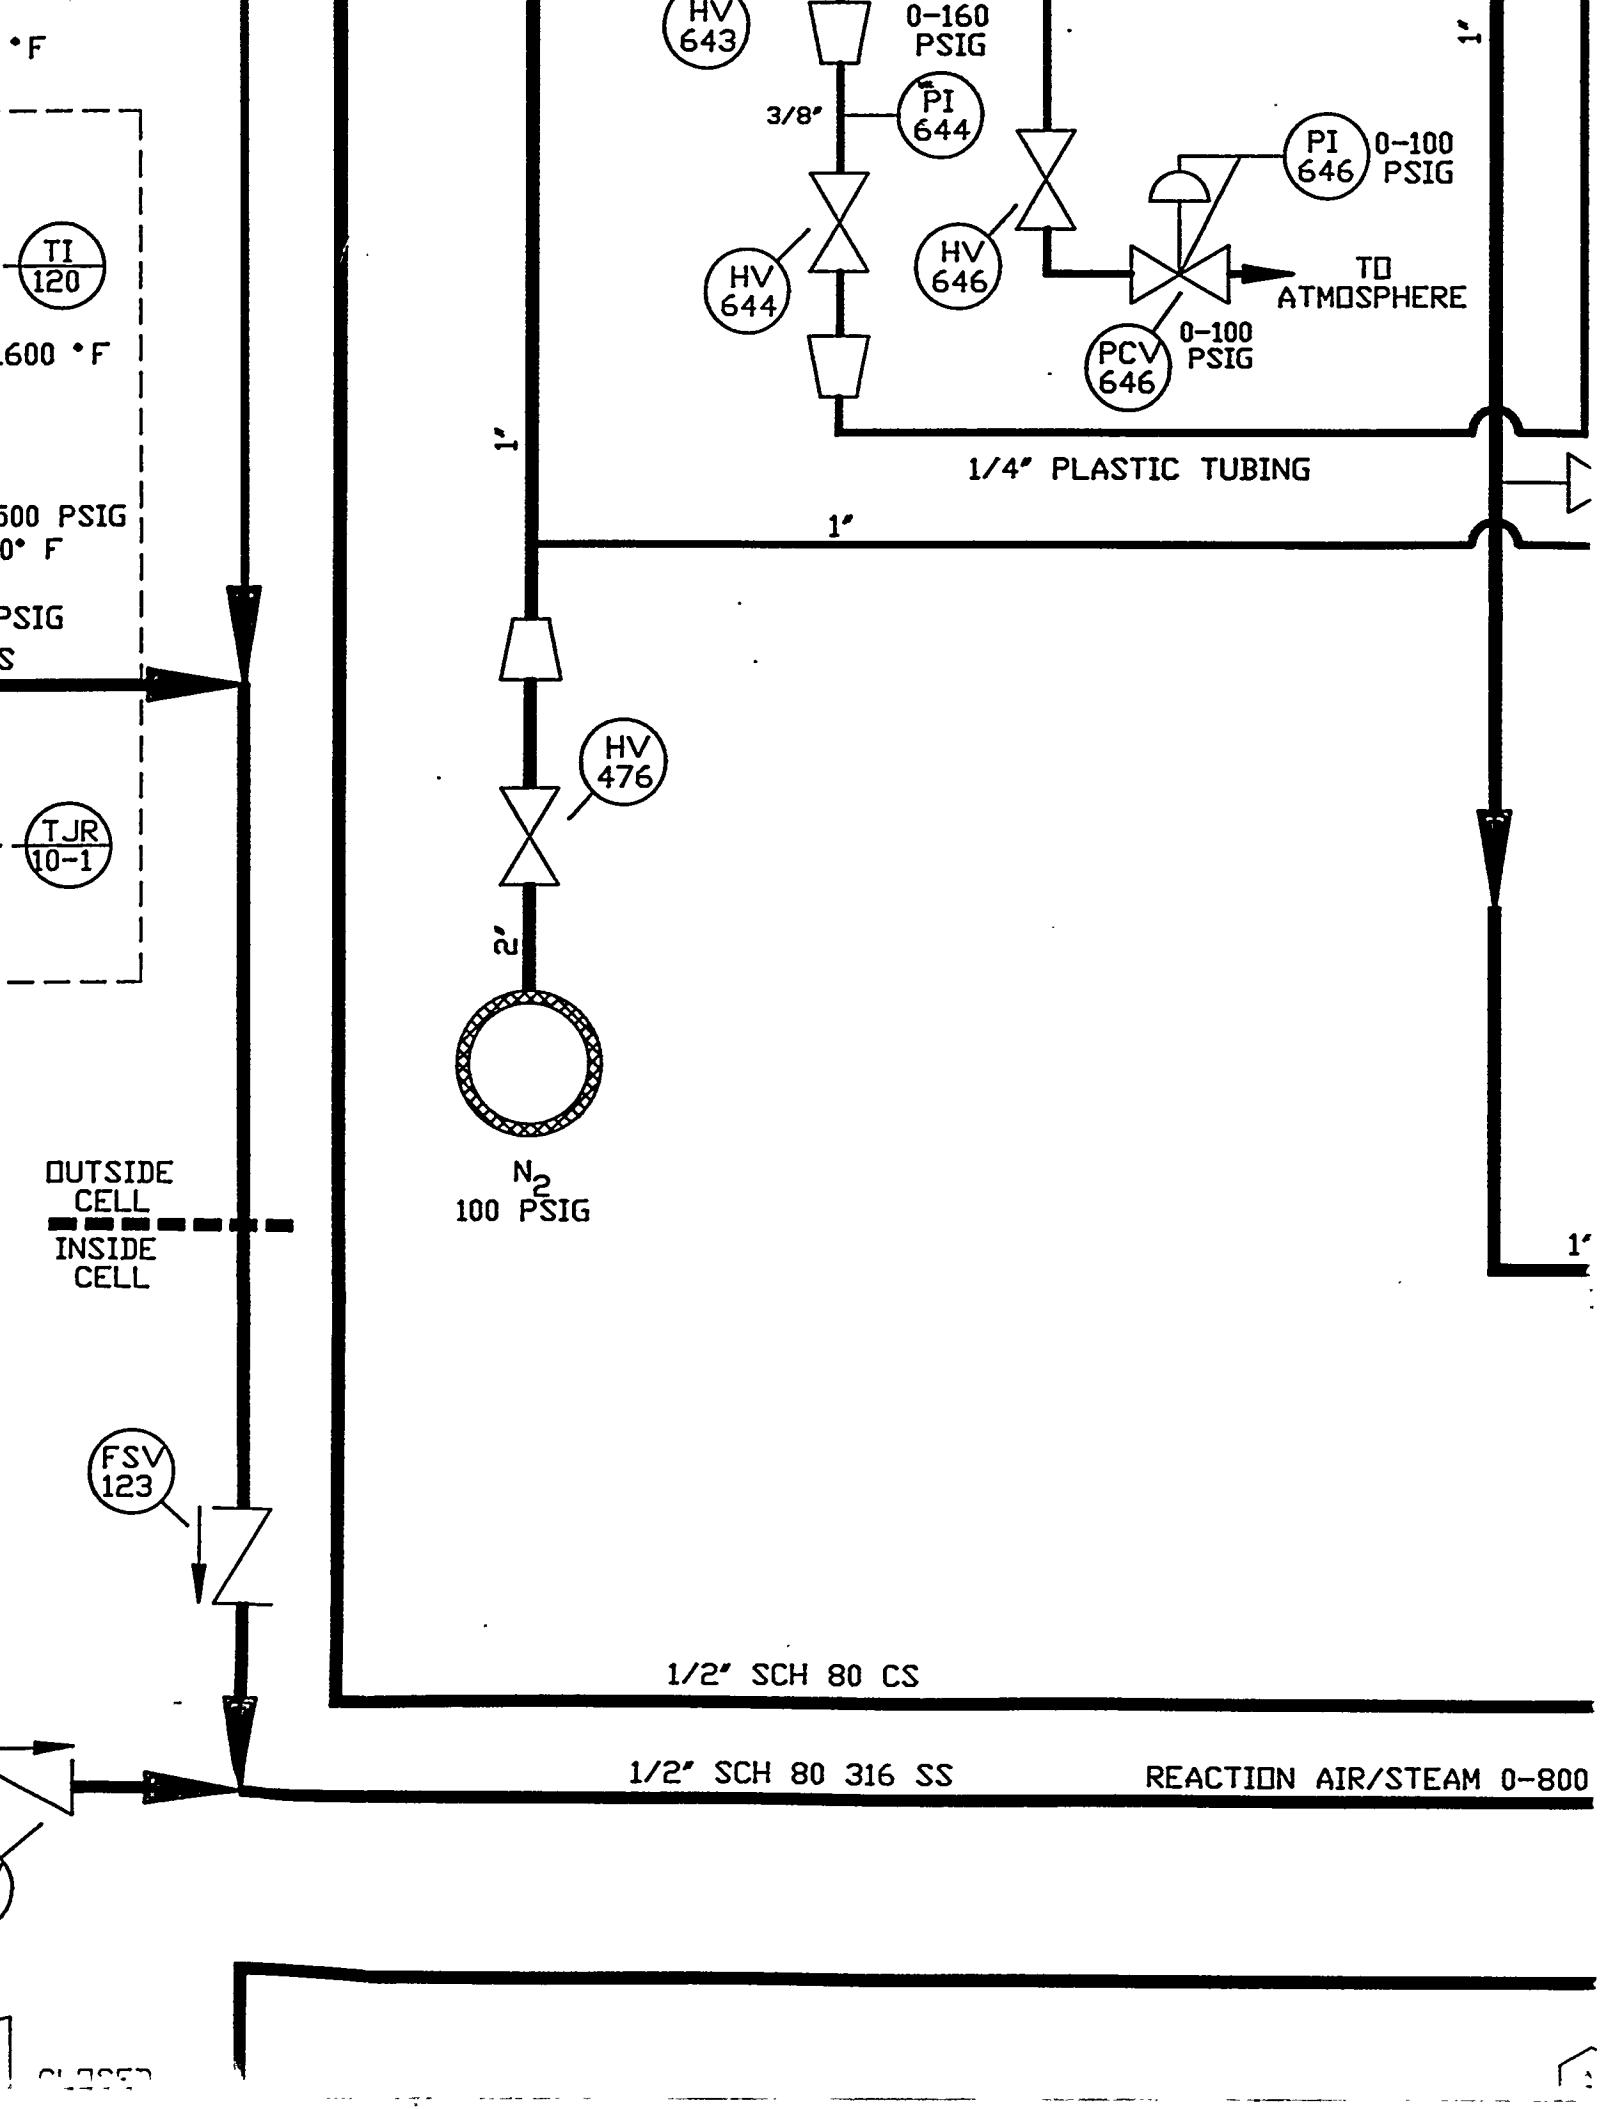


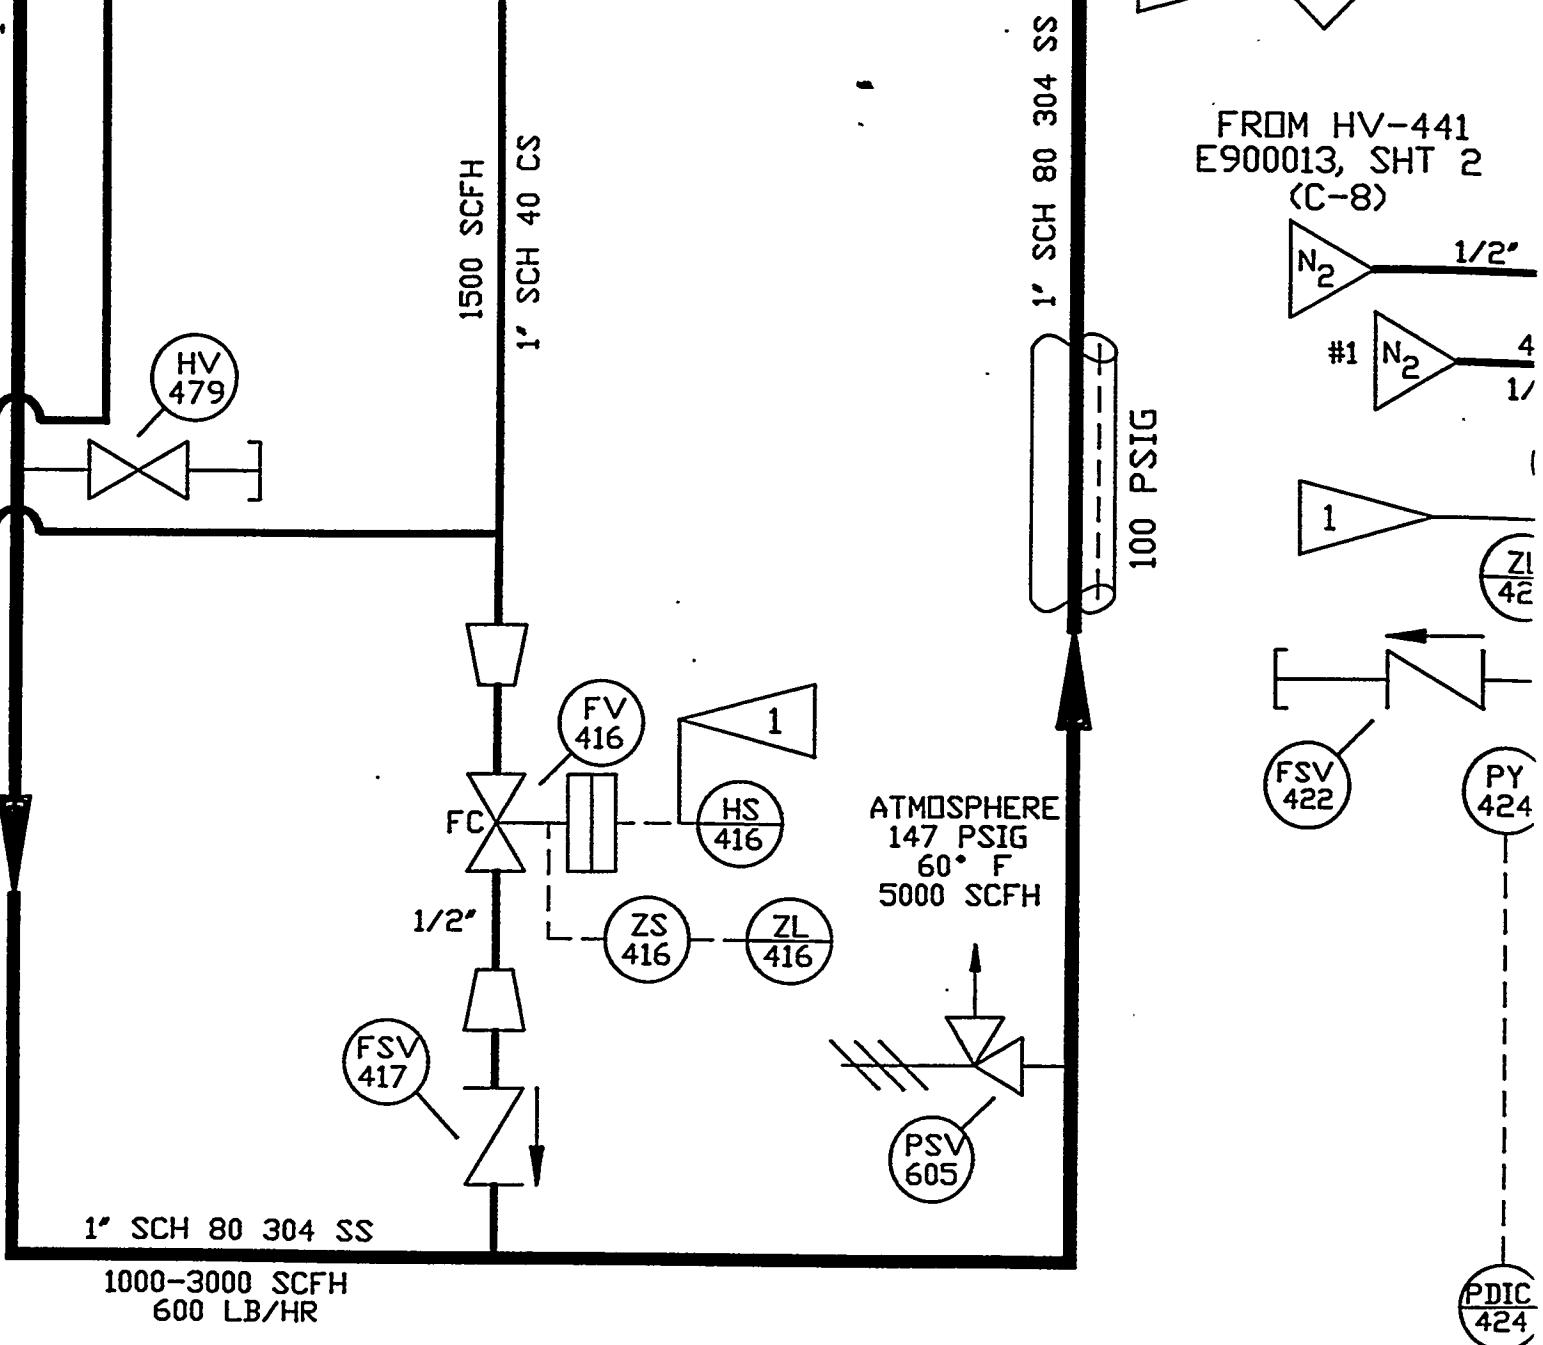


0-20

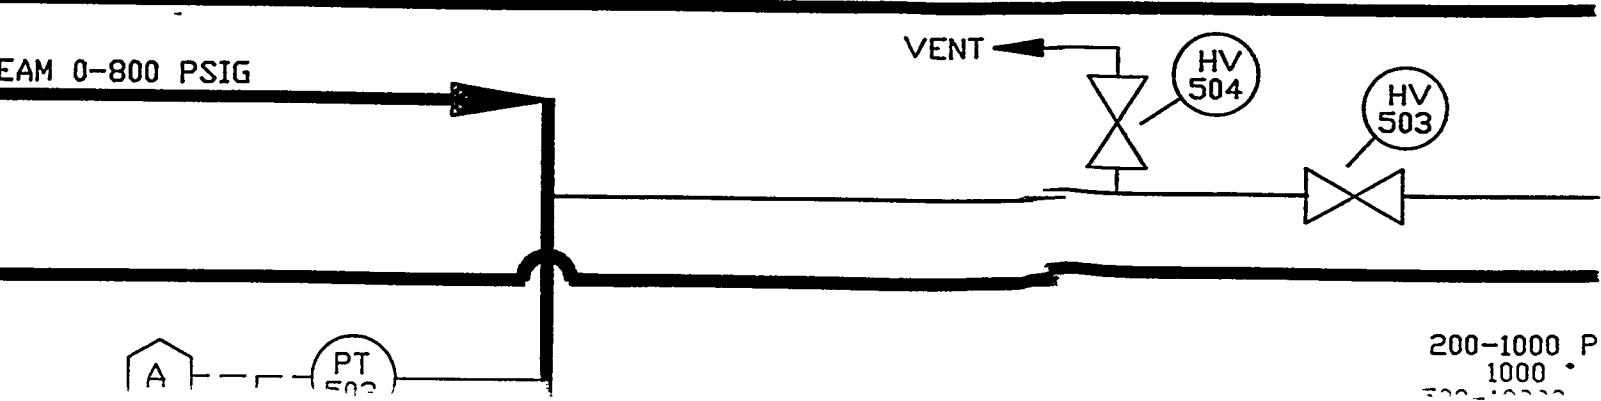

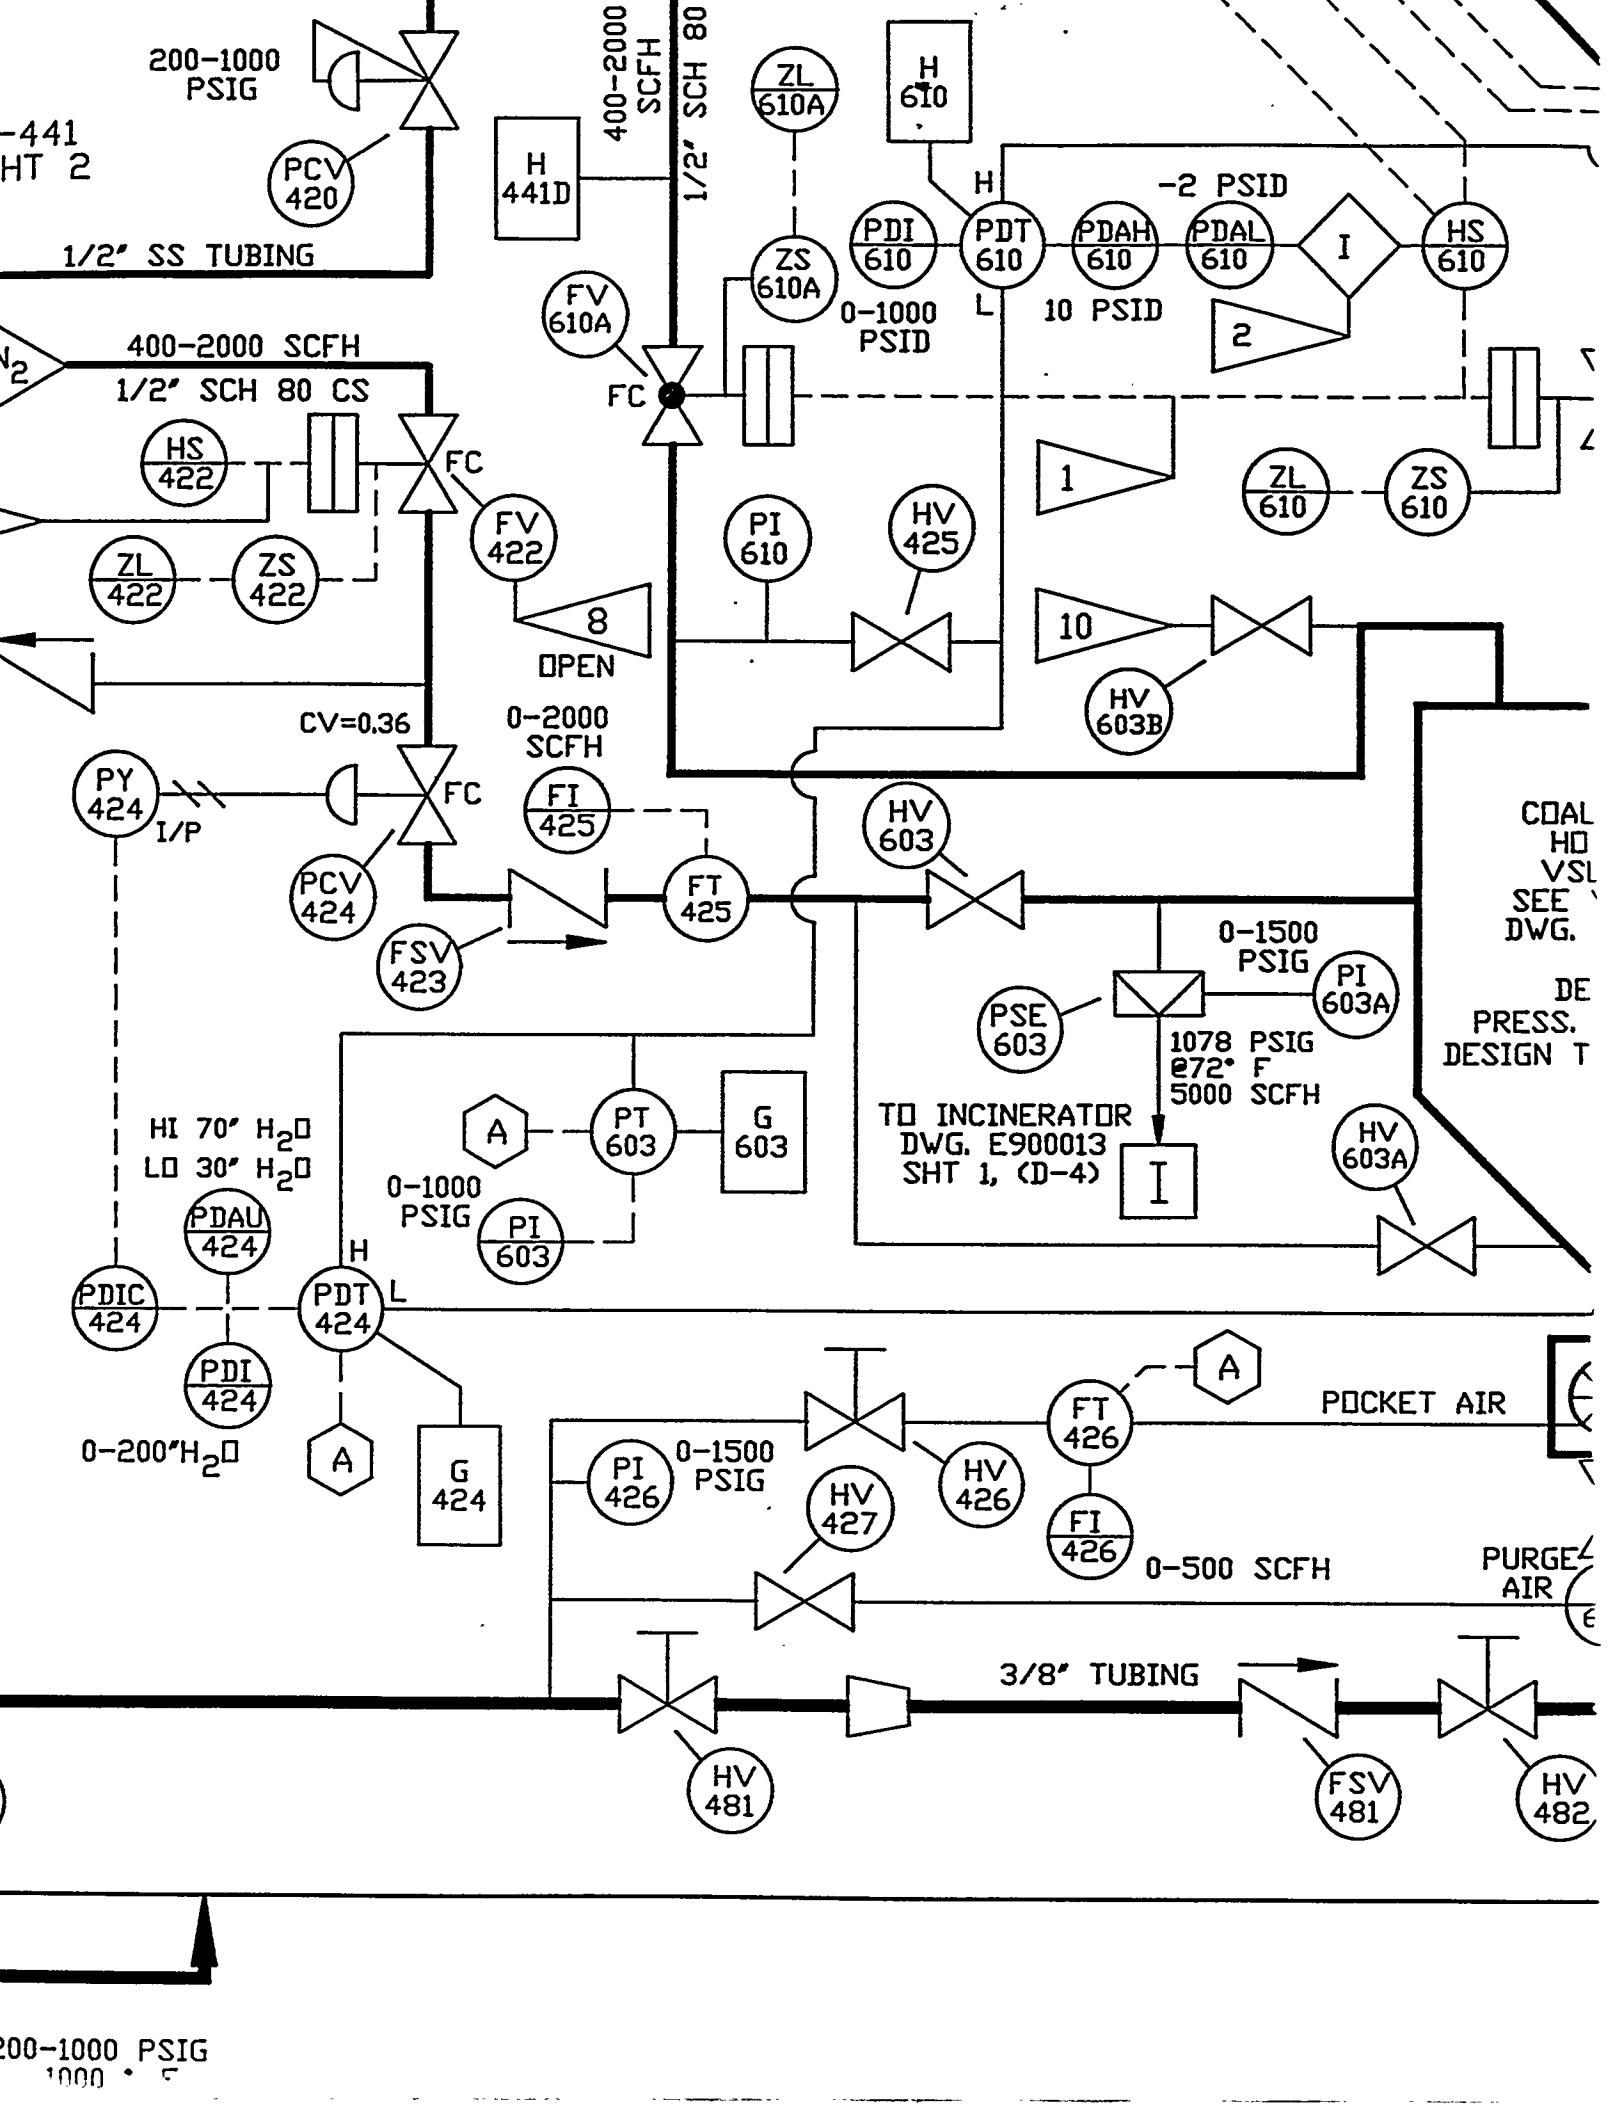

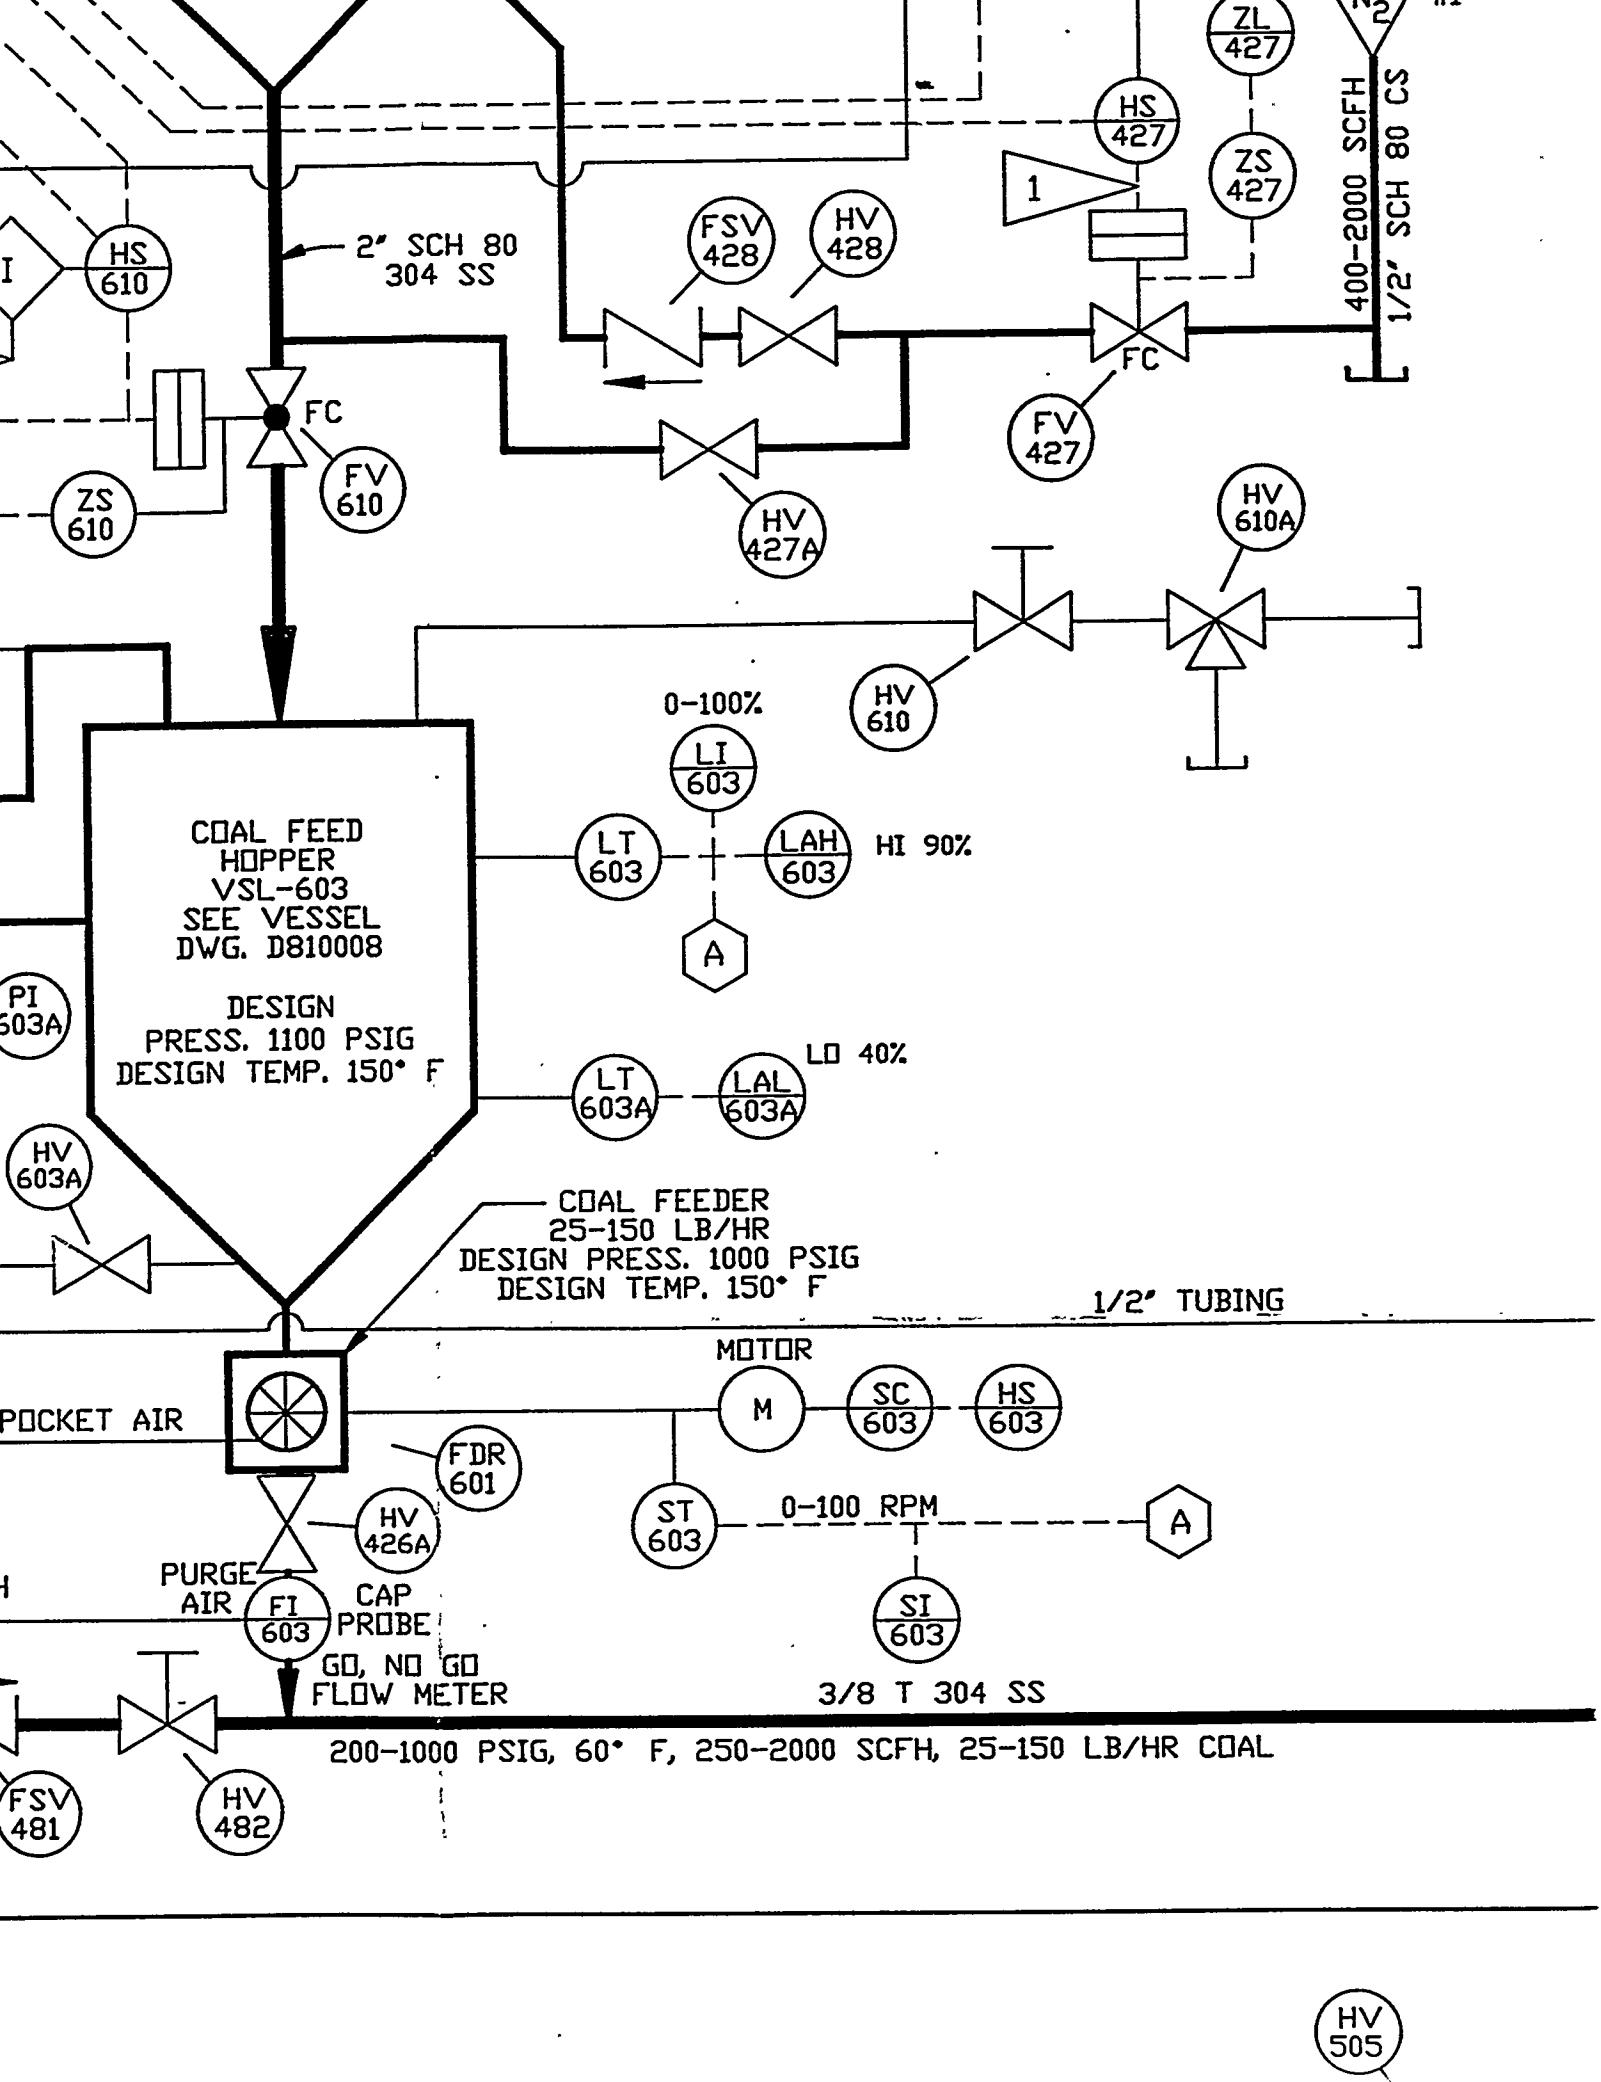

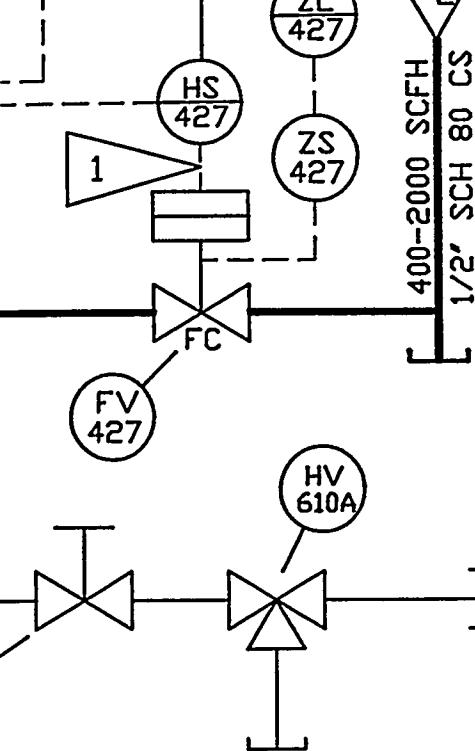

F

1/2" TUBING → TO HV 707
DWG. E900012



304 SS
25-150 LB/HR COAL → TO FLUID BED
GASIFIER
DWG. E900012


TO FLUID BED
GASIFIER
DWG. E900012



TO FLUID BED

E

D

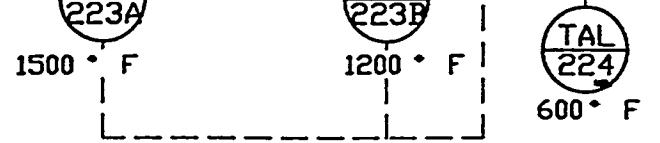

1' SCH 80 316 SS

VENT TO
ATMOSPHERE
10-160 LB/HR
650° F

HV
228

HV
229

FSV
315

FROM FCV 312
DWG. E900010

1/2" SCH 80 304 SS

60° F 125-2000 SCFH

FROM FV 407
DWG. E900010


NITROGEN PURGE

0-1050 PSIG


FSV
408

N_2 PURG
FROM FSV--
E900013 (SHT 2)


H
441C

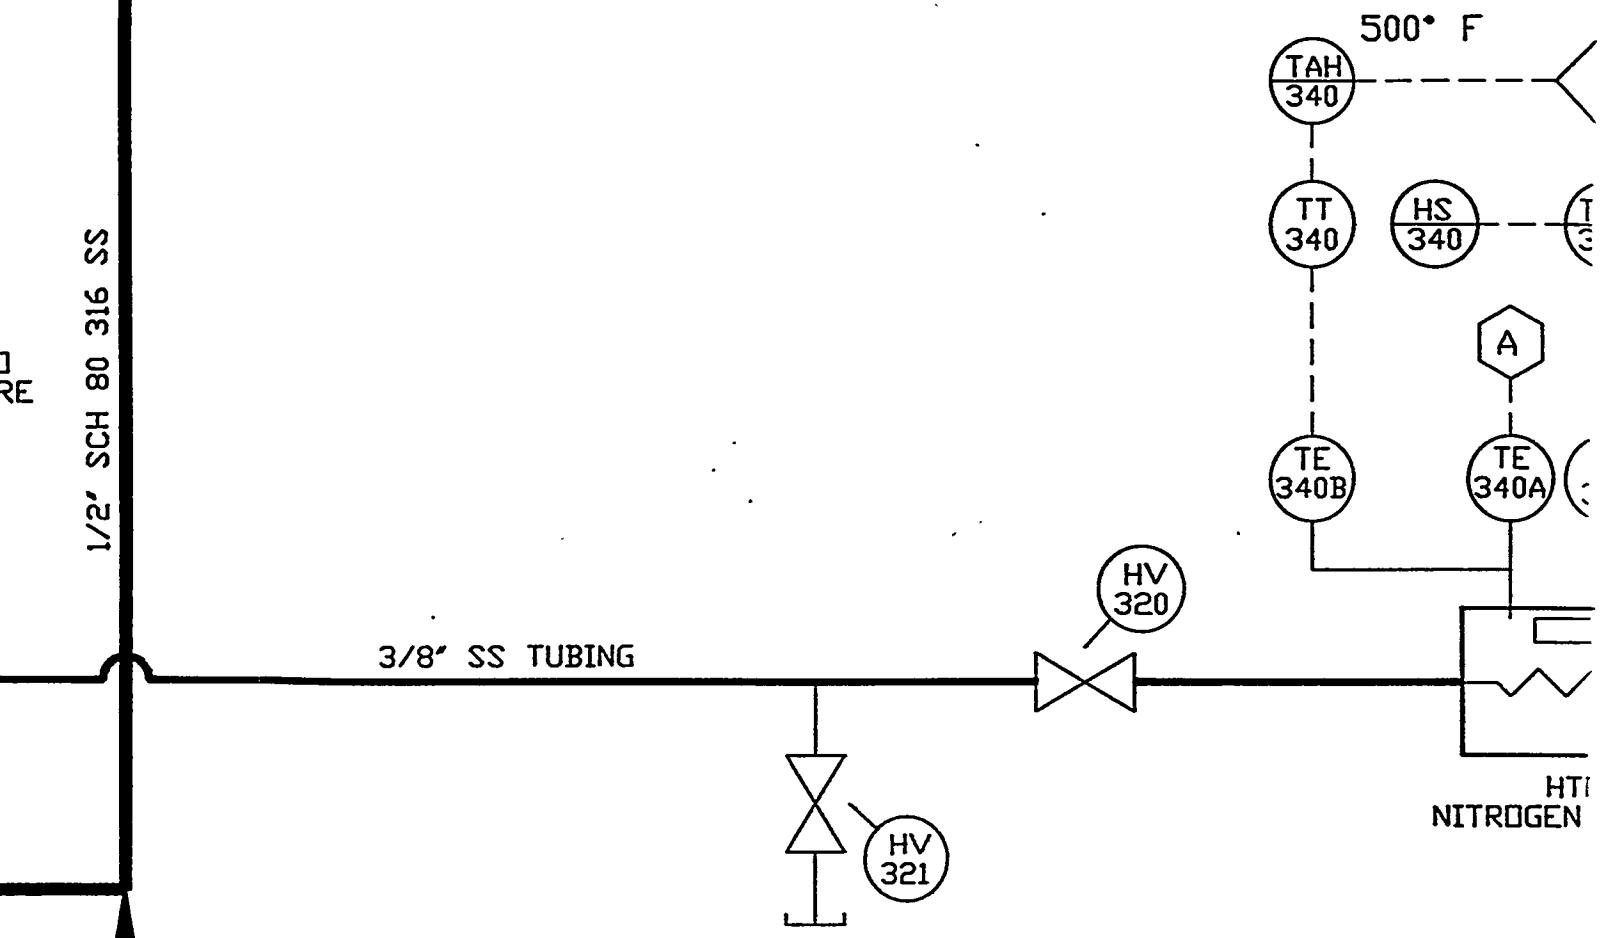


LEGEND:

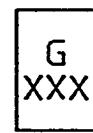


IDENTI
PURGE
NUMBER
THIS S
IS IN
TRANS
FV-
FSV-

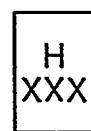


IDENTI
PURGE
NUMBER
THIS S
IS IN
TRANS
FV-

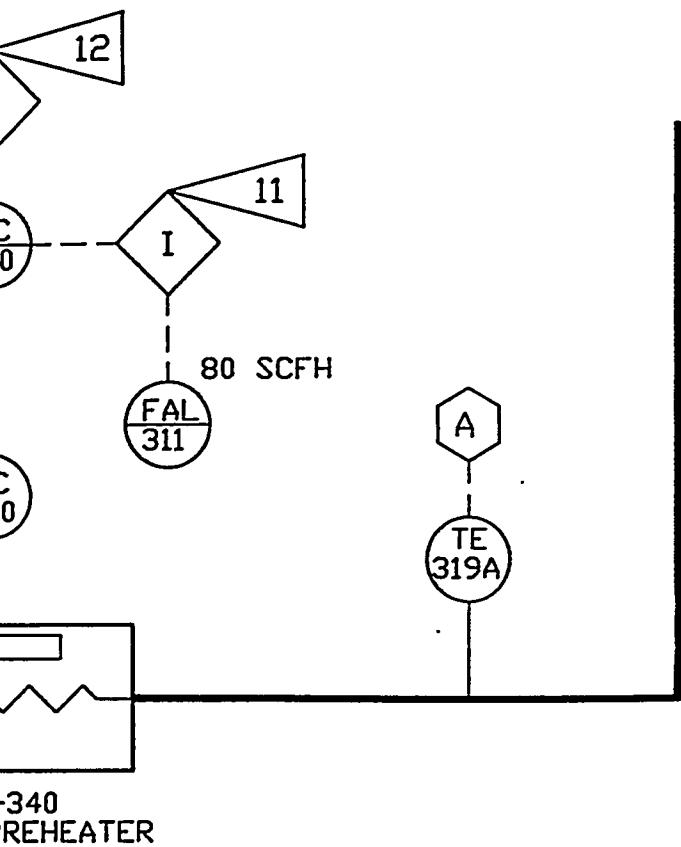


NOTES:

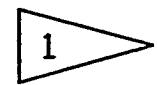

I
F
I
E

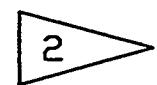


F
E
F
I

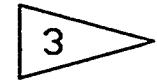


F
E
F
E


4

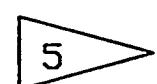


F
E
F
E

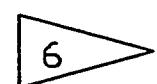


F
E
F
E

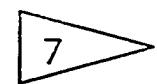


7

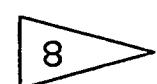


I
L

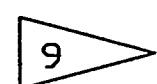


F
L

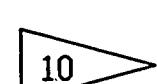

T
S

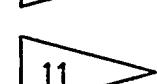

I
F

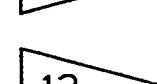

I
C

IES THE CONNECTING SEGMENT OF THE TRANSMITTER SYSTEM, WHERE XXX IS THE SEGMENT IDENTIFICATION
 SEE DWG. E900013, SHT. 2 OF 2 FOR DETAILS)
 SYMBOL INDICATES THAT THE FOLLOWING EQUIPMENT
 THE PURGE LINE FROM THE NITROGEN HEADER TO THE
 TTER:
 40, FSV-441, HV-441, HV-XXXP, FV-XXXP, &
 XXXP

IES THE CONNECTING SEGMENT OF THE TRANSMITTER SYSTEM, WHERE XXX IS THE SEGMENT IDENTIFICATION
 SEE DWG. E900013, SHT. 2 OF 2 FOR DETAILS)
 SYMBOL INDICATES THAT THE FOLLOWING EQUIPMENT
 THE PURGE LINE FROM THE NITROGEN HEADER TO THE
 TTER:
 40, FSV-441, HV-441, HV-XXXP, & FSV-XXXP.

DESIGNS EQUIPMENT WHICH IS NOT SHOWN ON THIS DWG.
FOR CLARITY, PANEL MOUNTED ON/OFF STATION (HAND SWITCH
WITH POSITION INDICATION LAMPS), 24VDC RELAY, 117 VAC
60 Hz SOLENOID VALVES.

FV-610 & FV-610A WILL NOT OPEN UNTIL PDT-610 MEASURES
A PRESSURE DIFFERENTIAL LESS THAN OR EQUAL TO 10 PSID.
REF. DWGS: D820047 SHT 14 & D820030 SHT 9. THE
PRESSURE IN VSL-602 MUST BE HIGHER THAN THE PRESSURE
IN VSL-603.

RELAY INTERLOCKS DO NOT ALLOW THE TWO PAIRS OF
PARALLEL FLOW VALVES (609 & 609A, 610 & 610A) TO BE
OPEN AT THE SAME TIME. REFERENCE DRAWING: D920031

THIS DWG. & DWGS. E900010, E900012, & E900013
SUPERCEDES DWG. R800524 (SEE DWG. E900013 FOR NOTES,
TUBING AND PIPING SUMMARY).

RELAY INTERLOCKS DO NOT ALLOW FV-602 AND FLOW VALVES
420 OR 427 TO BE OPEN AT THE SAME TIME.

RELAY INTERLOCKS DO NOT ALLOW FV-602 AND THE PAIR OF
PARALLEL FLOW VALVES 610 & 610A TO BE OPEN AT THE
SAME TIME.

"NOTE DELETED"


DESIGNS THAT THE CONTROL PANEL SWITCH IS PHYSICALLY
LOCKED TO PREVENT ACCIDENTAL ACTUATION.

FV-602 WILL NOT OPEN UNTIL PT-602 MEASURES A PRESSURE
LESS THAN 20 PSIG.

THROUGH FV-912 TO VENT SYSTEM VSL-906, DWG. E900013,
SHEET 1, (B-3)


INTERLOCKS PREVENT HTR-340 FROM OPERATING UNTIL NITROGEN
FLOWS EXCEED 80 SCFH

INTERLOCKS PREVENT HTR-340 FROM OPERATING WHEN THE
COIL TEMPERATURE EXCEEDS 500° F

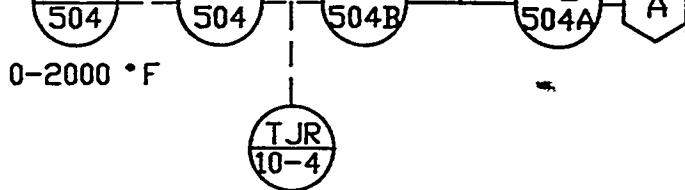

TO FLUID BED
GASIFIER
DWG. E900012

REFERENCE DRAWINGS	DRAFTER S. CONKO	DATE 3/6/90	UNITED STATES DEPARTMENT OF ENERGY MORGANTOWN ENERGY Morgantown
E900010	CHECKER A. R. KUBALA	DATE 3/6/90	
E900012	PROJECT ENGINEER J. P. KANOISKY	DATE 3/6/90	
E900013		DATE	
		DATE	TITLE B-12 P& FLUIDIZED BED A.G.C.
		SIZE E	DWG NO E90

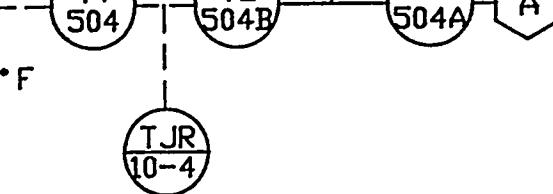

TO FLUID BED
GASIFIER
DWG. E900012

C

EN SAD

E
900011
110006

T HS


DRAFTER S. CONKO	DATE 3/6/90	United States Department of Energy MORGANTOWN ENERGY TECHNOLOGY CENTER Morgantown, WV		
CHECKER A. R. KUBALA	DATE 3/6/90			
PROJECT ENGINEER J. P. KANDSKY	DATE 3/6/90			
	DATE	TITLE		
	DATE	B-12 P&ID		
	DATE	FLUIDIZED BED GASIFIER		
	DATE	A.G.C.		
	DATE	SIZE E	FSCH NO	DWG NO E900011
	DATE			REV 6


A

H

G

F

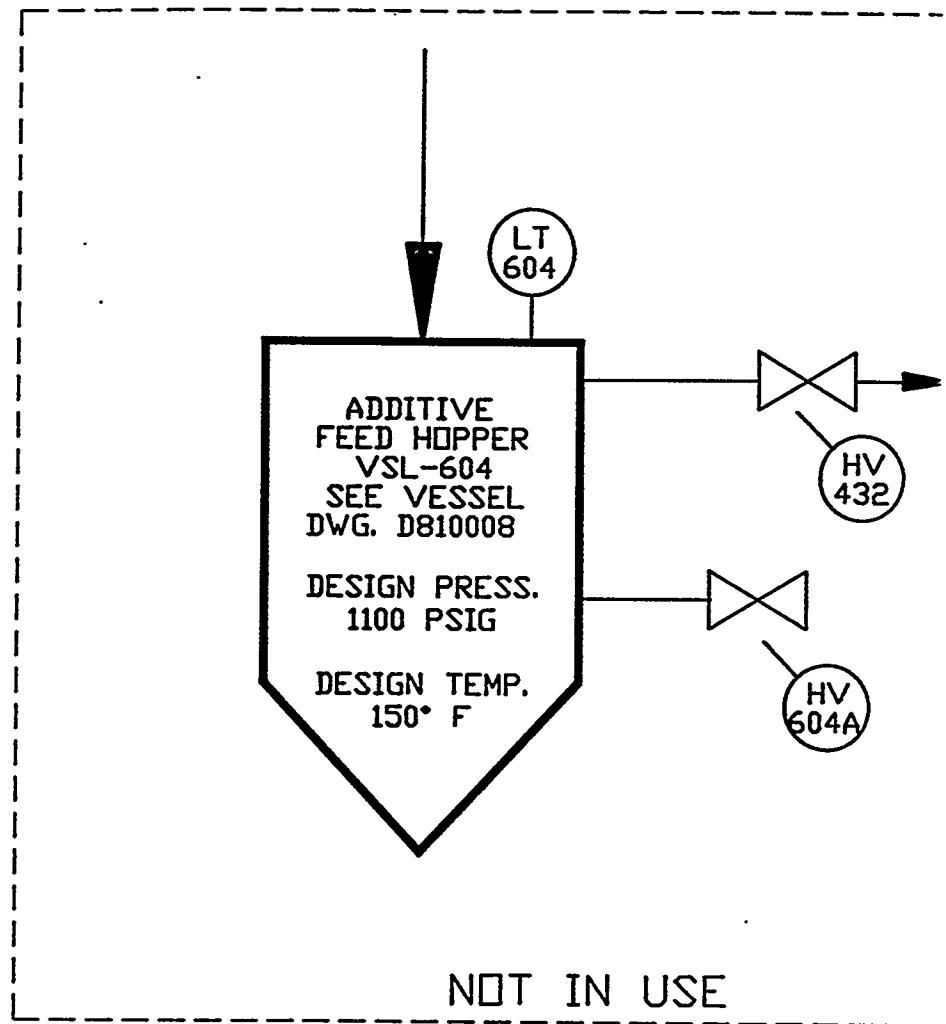

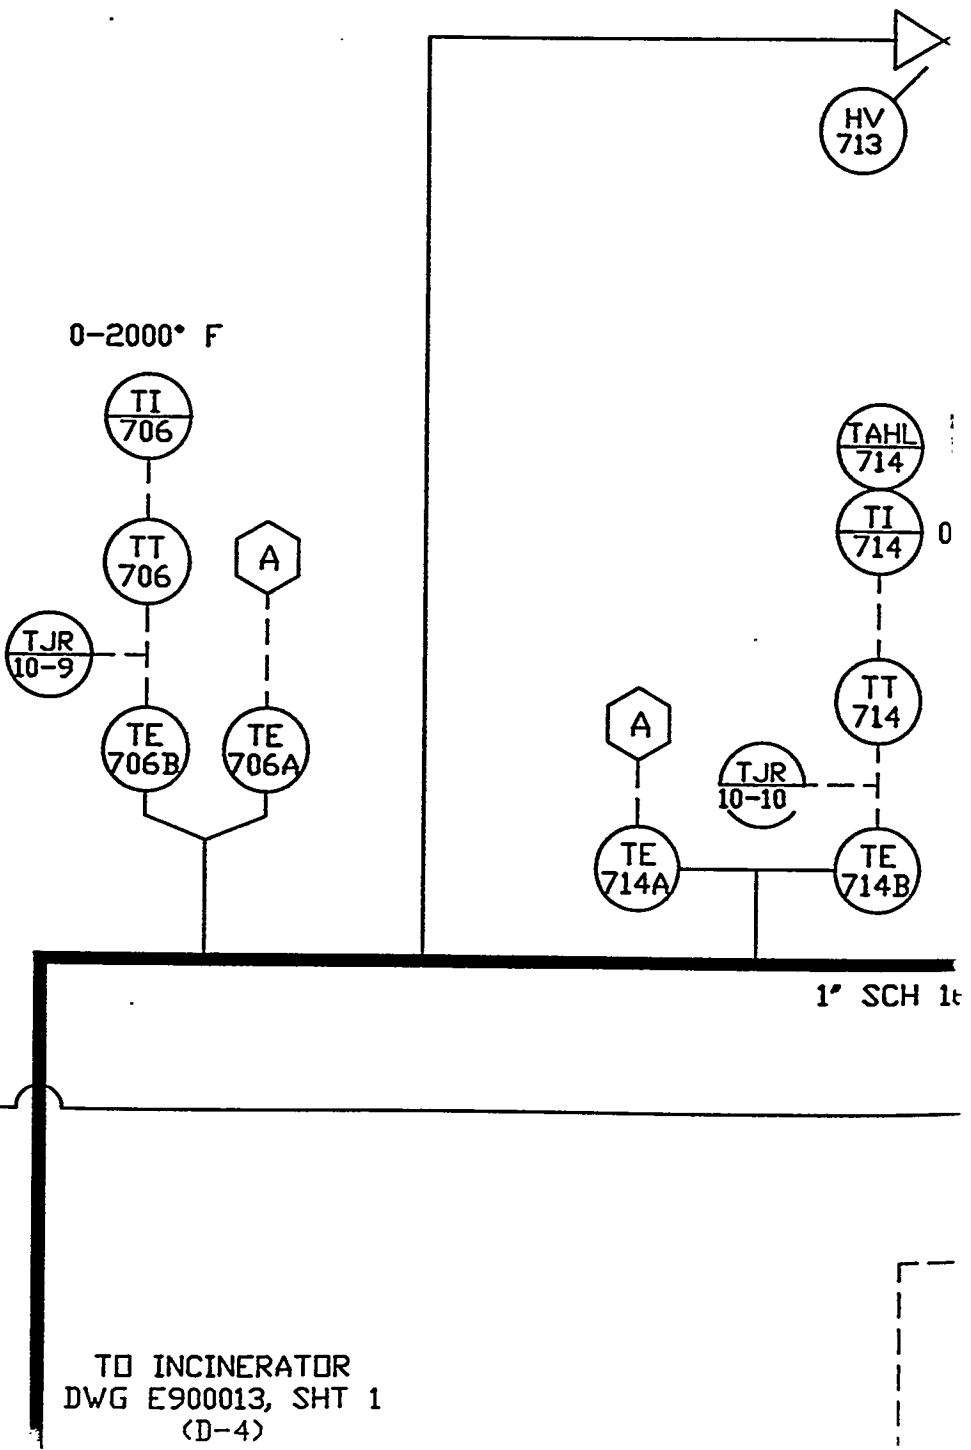

0-1000
PSIG



HI 450 PSIG
LO 400 PSIG



0-200° H₂O




8 CLOS



PRIMARY
CYCLONE
CYC-701

DESIGN PRESS.
550 PSIG

DESIGN TEMP.
1300° F

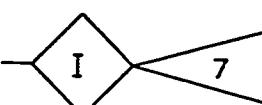

7




I

E



J

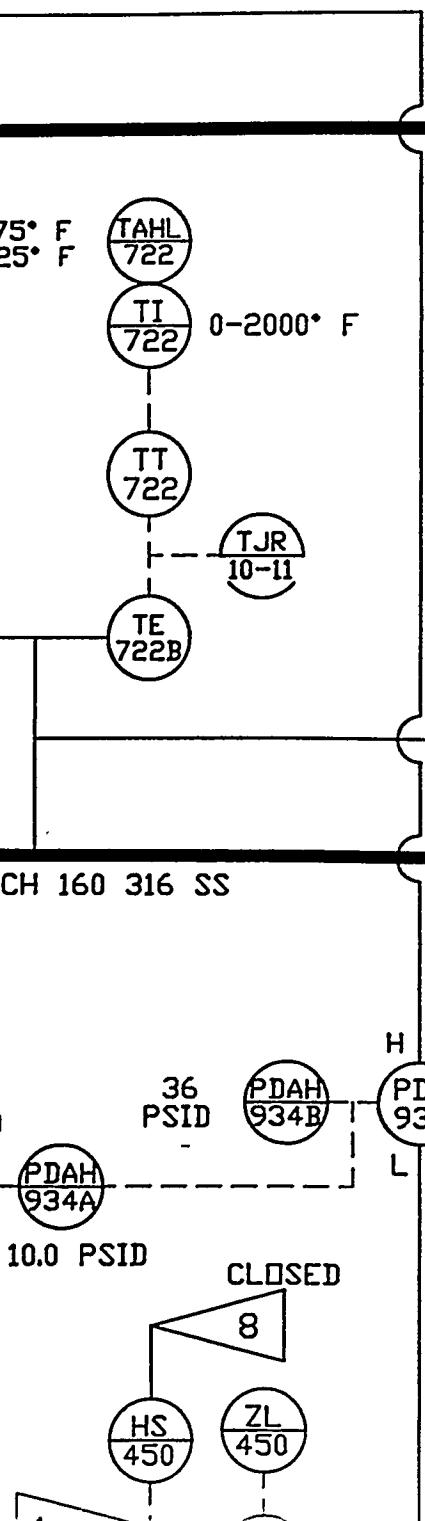


TO
PCV 713
& PCV 713A
DWG. E900013
(G-4)

TO HV 728
DWG. E900013

TO HV 726
DWG. E900013

TO SECONDARY
CYCLONE
DWG. E900013

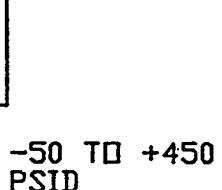

ZONE	REV	
GEN		UPDATED AS PER MARKED
E-6	1	REVISED PRESSURE RATING
GEN		REVISED PER MARKED PRI
B-3		REMOVED LS AND LAH-90
C-3		REMOVED LS AND LAH-90
E-3		REMOVED LS AND LAH-90
G-7		REWORDED NOTE FOR ADD:
F-6		NOTE 1150 °F WAS 1100 °F
DRAFTER	G.J.K.	DATE 1/3/91
		CHECKER
		DATE
ZONE	REV	
GEN	2	UPDATED AS PER MARKED
GEN		ADDED NEW DWG. FORMAT
GEN		UPDATED AS PER MARKED
GEN		UPDATED AS PER MARKED
GEN		ISSUED FOR CUSTOMER RE
DRAFTER	JIMMY SMITH	DATE 7/17/92
EG&G RESPON SECT SUPV		DATE 7/20/92
BURTON W. HARRELL		EG&G ES J. L.
ZONE	REV	
A-1		CHANGED DWG. TITLE
GEN		UPDATED AS PER MARKED
GEN	3	ISSUED FOR CONSTRUCTI
B-2		ADDED NOTES 13 AND 14,
GEN		UPDATED AS PER MARKED
DRAFTER	GARY J. KULCHOCK	DATE 11/18/92
EG&G ES&H		DATE 11/19/92
J. L. BUCKLEW		PROJECT
ZONE	REV	
GEN	4	ADDED DESIGN PRESSURE VSL-904, VSL-604, RPV- REMOVED NUMBERS FROM ISSUED FOR CONSTRUCTI
DRAFTER	GARY J. KULCHOCK	DATE 4/5/93
EG&G ES&H		DATE 4/7/93
J. L. BUCKLEW		PROJECT JOH
ZONE	REV	
GEN	5	ADDED NOTE ON ALL IN 'PDAH-934B', 'PDAH-9 'FO' WAS 'FC' ON FV- T1-901, AND TE-901B; REVISED PIPING AROUND ISSUED FOR CONSTRUCT
DRAFTER	Gary Kulchack	DATE 9/10/93
EG&G ES&H	Larry Bucklew	DATE 9/17/93
		PROJECT Jo
ZONE	REV	
GEN	6	EXTENSIVE CHANGES AS; ISSUED FOR CONSTRUCTIO
DRAFTER	Gary Kulchack	DATE 10/11/93
EG&G ES&H	Larry Bucklew	DATE 10/11/93
		PROJECT Jo


REVISION

ZONE	REV	DESCRIPTION						DATE
GEN		UPDATED AS PER MARKED PRINT						4/25/90
E-6		REVISED PRESSURE RATINGS						6/26/90
GEN	1	REVISED PER MARKED PRINT REMOVED LS AND LAH-904 REMOVED LS AND LAH-903 REMOVED LS AND LAH-902 REWORDED NOTE FOR ADDITIVE FEED HOPPER NOTE 1150 °F WAS 1100 °F						10/11/90
FTER	G.J.K.	DATE 1/3/91	CHECKER D.F.	DATE 1/3/91	PROJECT ENGINEER J.P.K.	DATE 2/13/91		DATE
		DATE		DATE		DATE		DATE
ZONE	REV	DESCRIPTION						DATE
GEN		UPDATED AS PER MARKED PRINT WITH W.D. #68547						10/3/91
GEN	2	ADDED NEW DWG. FORMAT UPDATED AS PER MARKED PRINT WITH W.D. #70756						1/10/92
GEN		UPDATED AS PER MARKED PRINT WITH WORK PLAN ISSUED FOR CUSTOMER REVIEW AND COMMENT						7/17/92
FTER	JIMMY SMITH	DATE 7/17/92	CHECKER GARY J. KULCHOCK	DATE 7/17/92	EG&G RESPONSIBLE ENGR. JAY RUTTEN	DATE 7/17/92	EG&G REVIEWER D. LUNIFELD	DATE 7/17/92
G RESPON SECT SUJV		DATE	EG&G ESTH	DATE		DATE		DATE
RTON W. HARRELL		7/20/92	J. L. BUCKLEW					
ZONE	REV	DESCRIPTION						DATE
A-1		CHANGED DWG. TITLE UPDATED AS PER MARKED PRINT WITH WORK PLAN						9/10/92
GEN	3	ISSUED FOR CONSTRUCTION ADDED NOTES 13 AND 14, AND CORRESPONDING INTERLOCKS						9/16/92
GEN		UPDATED AS PER MARKED PRINT WITH WORK PLAN						11/16/92
FTER	J. KULCHOCK	DATE 11/18/92	CHECKER S CONKO	DATE 11/18/92	EG&G RESPONSIBLE ENGR. JAY RUTTEN	DATE 11/19/92	REVIEWER D. LUNIFELD	DATE 11/19/92
G ESTH	J. L. BUCKLEW	DATE 11/19/92	PROJECT ENGR. JOHN ROCKEY	DATE	BRANCH MANAGER	DATE	DOE (EISD) JOHN ROTUNDA	DATE 11/24/92
ZONE	REV	DESCRIPTION						DATE
GEN	4	ADDED DESIGN PRESSURE AND DESIGN TEMPERATURE TO VSL-901, VSL-902, VSL-903, VSL-904, VSL-604, RPV-701 AND CYC-701 REMOVED NUMBERS FROM ADACS SYMBOLS ISSUED FOR CONSTRUCTION						03/26/93
FTER	J. KULCHOCK	DATE 4/5/93	CHECKER S CONKO	DATE 4/5/93	EG&G RESPONSIBLE ENGR. JAY RUTTEN	DATE 4/7/93	REVIEWER D. LUNIFELD	DATE 4/7/93
G ESTH	J. L. BUCKLEW	DATE 4/7/93	PROJECT ENGR. JOHN ROCKEY	DATE 5/27/93	BRANCH MANAGER LARRY STRICKLAND	DATE 5/27/93	DOE (EISD) BILL AYERS	DATE 5/27/93
ZONE	REV	DESCRIPTION						DATE
GEN	5	ADDED NOTE ON ALL INCINERATOR DESIGNATIONS; "PLAL-934A" WAS "PLAL-934B"; "PDAH-934A" WAS "PDAH-934B"; "PDAH-934B" WAS "PDAH-934A"; MODIFIED PSID RANGE ON PDI-934, WAS "0-50" "FD" WAS "FC" ON FV-725; ADDED "#1" TO ALL N DESIGNATIONS; RELOCATED HV-436A, TE-901A, T1-901, AND TE-901B; ADDED HV-437 AND HV-438; ADDED NOTE TO VENT SYSTEM, ZONE A-6 REVISED PIPING AROUND VSL-901; ADDED LINE AHEAD OF FSV-435, ZONE C-8 & C-7 ISSUED FOR CONSTRUCTION						09/01/93
FTER	Gary Kulchock	DATE 9/10/93	CHECKER S. Conko	DATE 9/14/93	EG&G RESPONSIBLE ENGR. Jay Rutten	DATE 9/15/93	REVIEWER Dave Lunifeld	DATE 9/20/93
G ESTH	Larry Bucklew	DATE 9/17/93	PROJECT ENGR. John Rockey	DATE 9/21/93	BRANCH MANAGER Larry Shadie	DATE 9/21/93	DOE (EISD) John Rotunda/WJA	DATE 9/20/93
ZONE	REV	DESCRIPTION						DATE
GEN	6	EXTENSIVE CHANGES AS PER MARKED PRINT REDLINED BY JAY RUTTEN ON 15 FEB 94. ISSUED FOR CONSTRUCTION						9/30/94
FTER	Gary Kulchock	DATE 10/7/94	CHECKER S. Conko	DATE 10-7-94	EG&G RESPONSIBLE ENGR. Jay Rutten	DATE 10-11-94	REVIEWER Dave Lunifeld	DATE 10/11/94
G ESTH	Larry Bucklew	DATE 10-11-94	PROJECT ENGR. John Rockey	DATE 10/13/94	BRANCH MANAGER Larry Shadie	DATE 10-12-94	DOE (EISD) John Rotunda/WJA	DATE 10/11/94


H

G

F

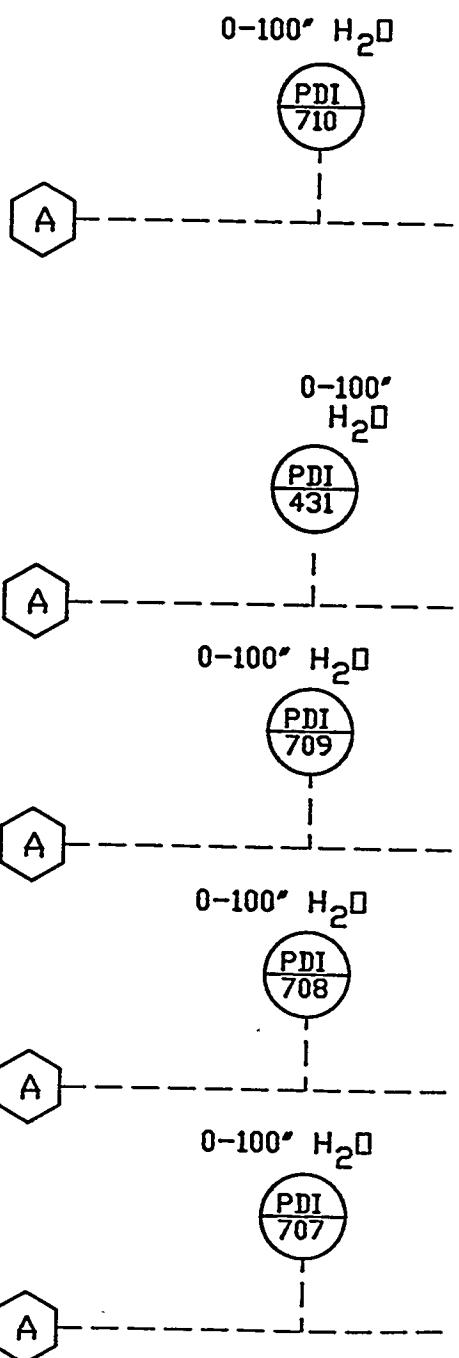


FROM PDT 424
DWG. E900011

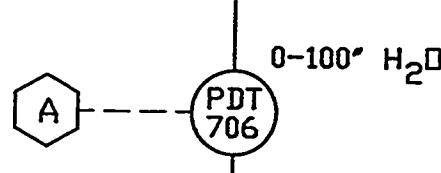

FROM HV 482
DWG. E900011

TO INCINERATOR
DWG E900013, SHT 1
(D-4)

200-550 PSIG
1150° F
500-13500 SCFH
1" SCH 160 316 SS

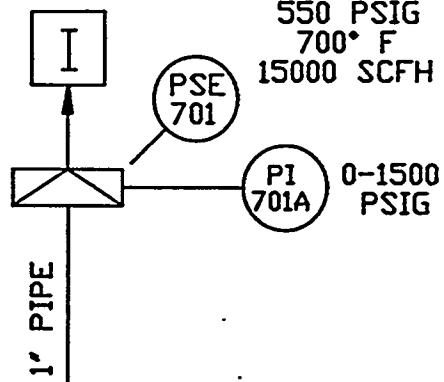

FLUIDIZED
BED
GASIFIER
RPV-701

DESIGN PRESS.
1100 PSIG

DESIGN STEEL TEMP.
650° F

OPERATING PRESS.
200-425 PSIG

OPERATING INTERNAL
TEMPERATURE
1400°-1800° F

SEE VESSEL
DWG. E910191

550 PSIG
700° F
15000 SCFH
0-1500 PSIG

TJR
10-8

TE
705B
TE
705A

TT
705
A

0-2000° F

TJR
10-7

TE
704B
TE
704A

TT
704
A

0-2000° F

TE
703A
TE
703B

A

TJR
10-6

TT
703
TAH
703

0-2000 ° F

1800 ° F

TE
702A
TE
702B


A


TE
702B

TT
702
TI
702

0-2000° F

35
PSID
(935)
PDAH
(935)
P
9

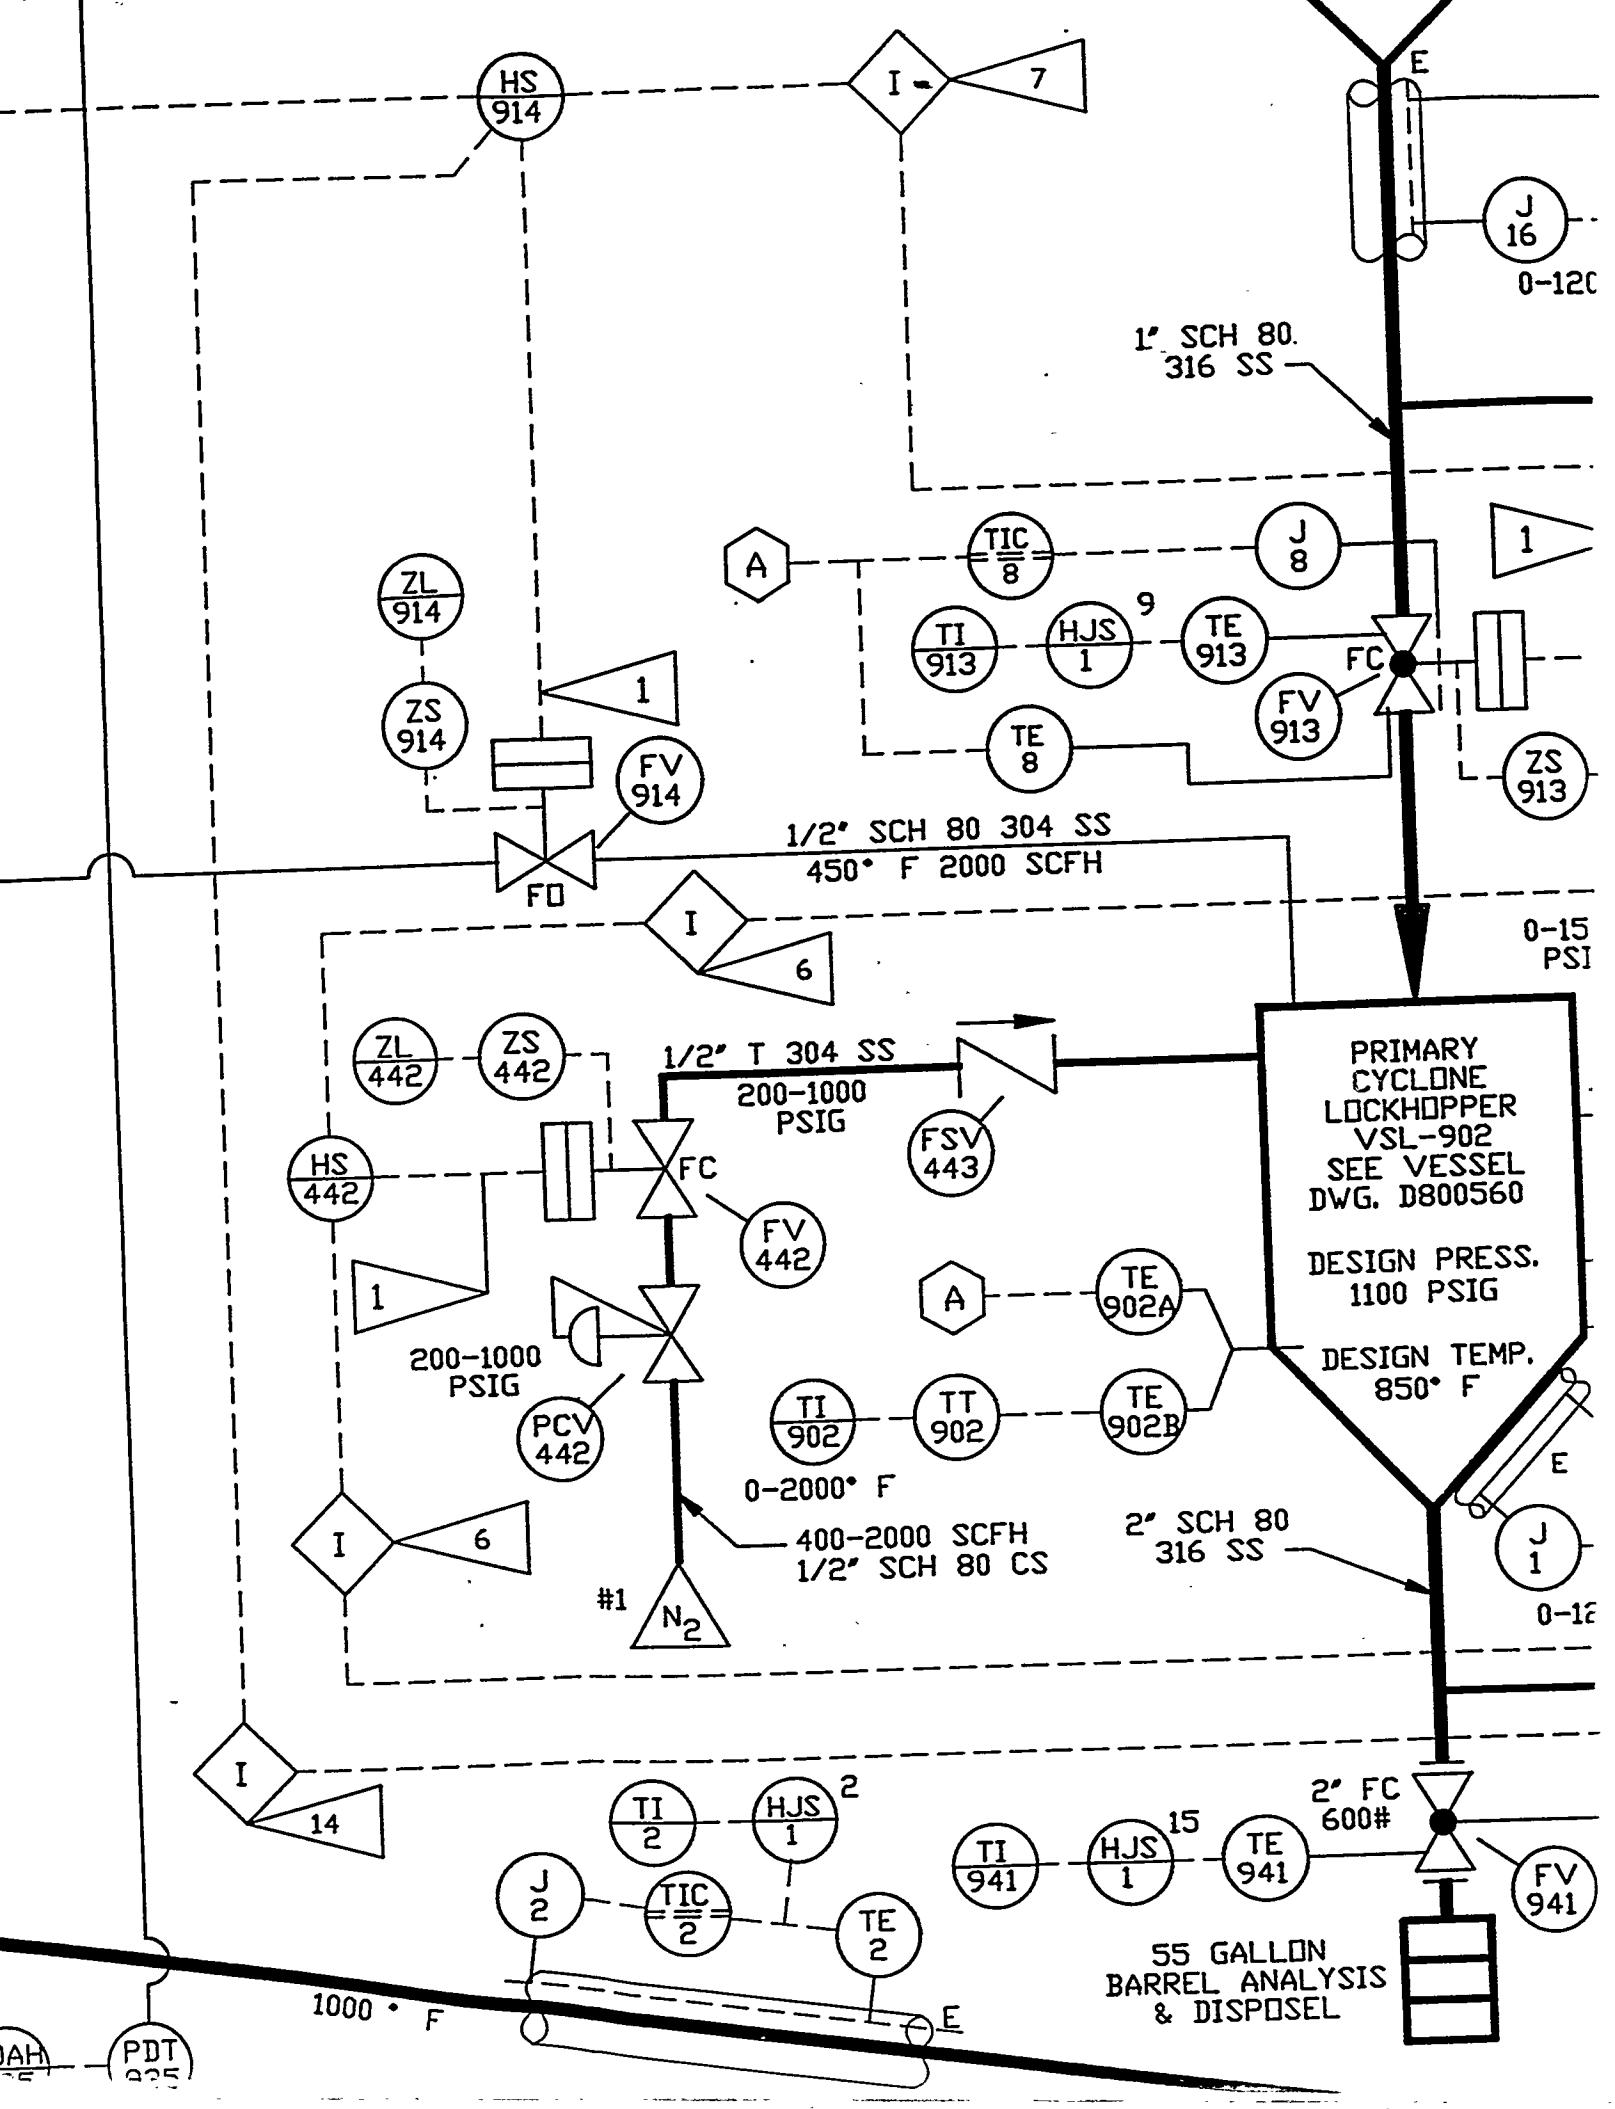

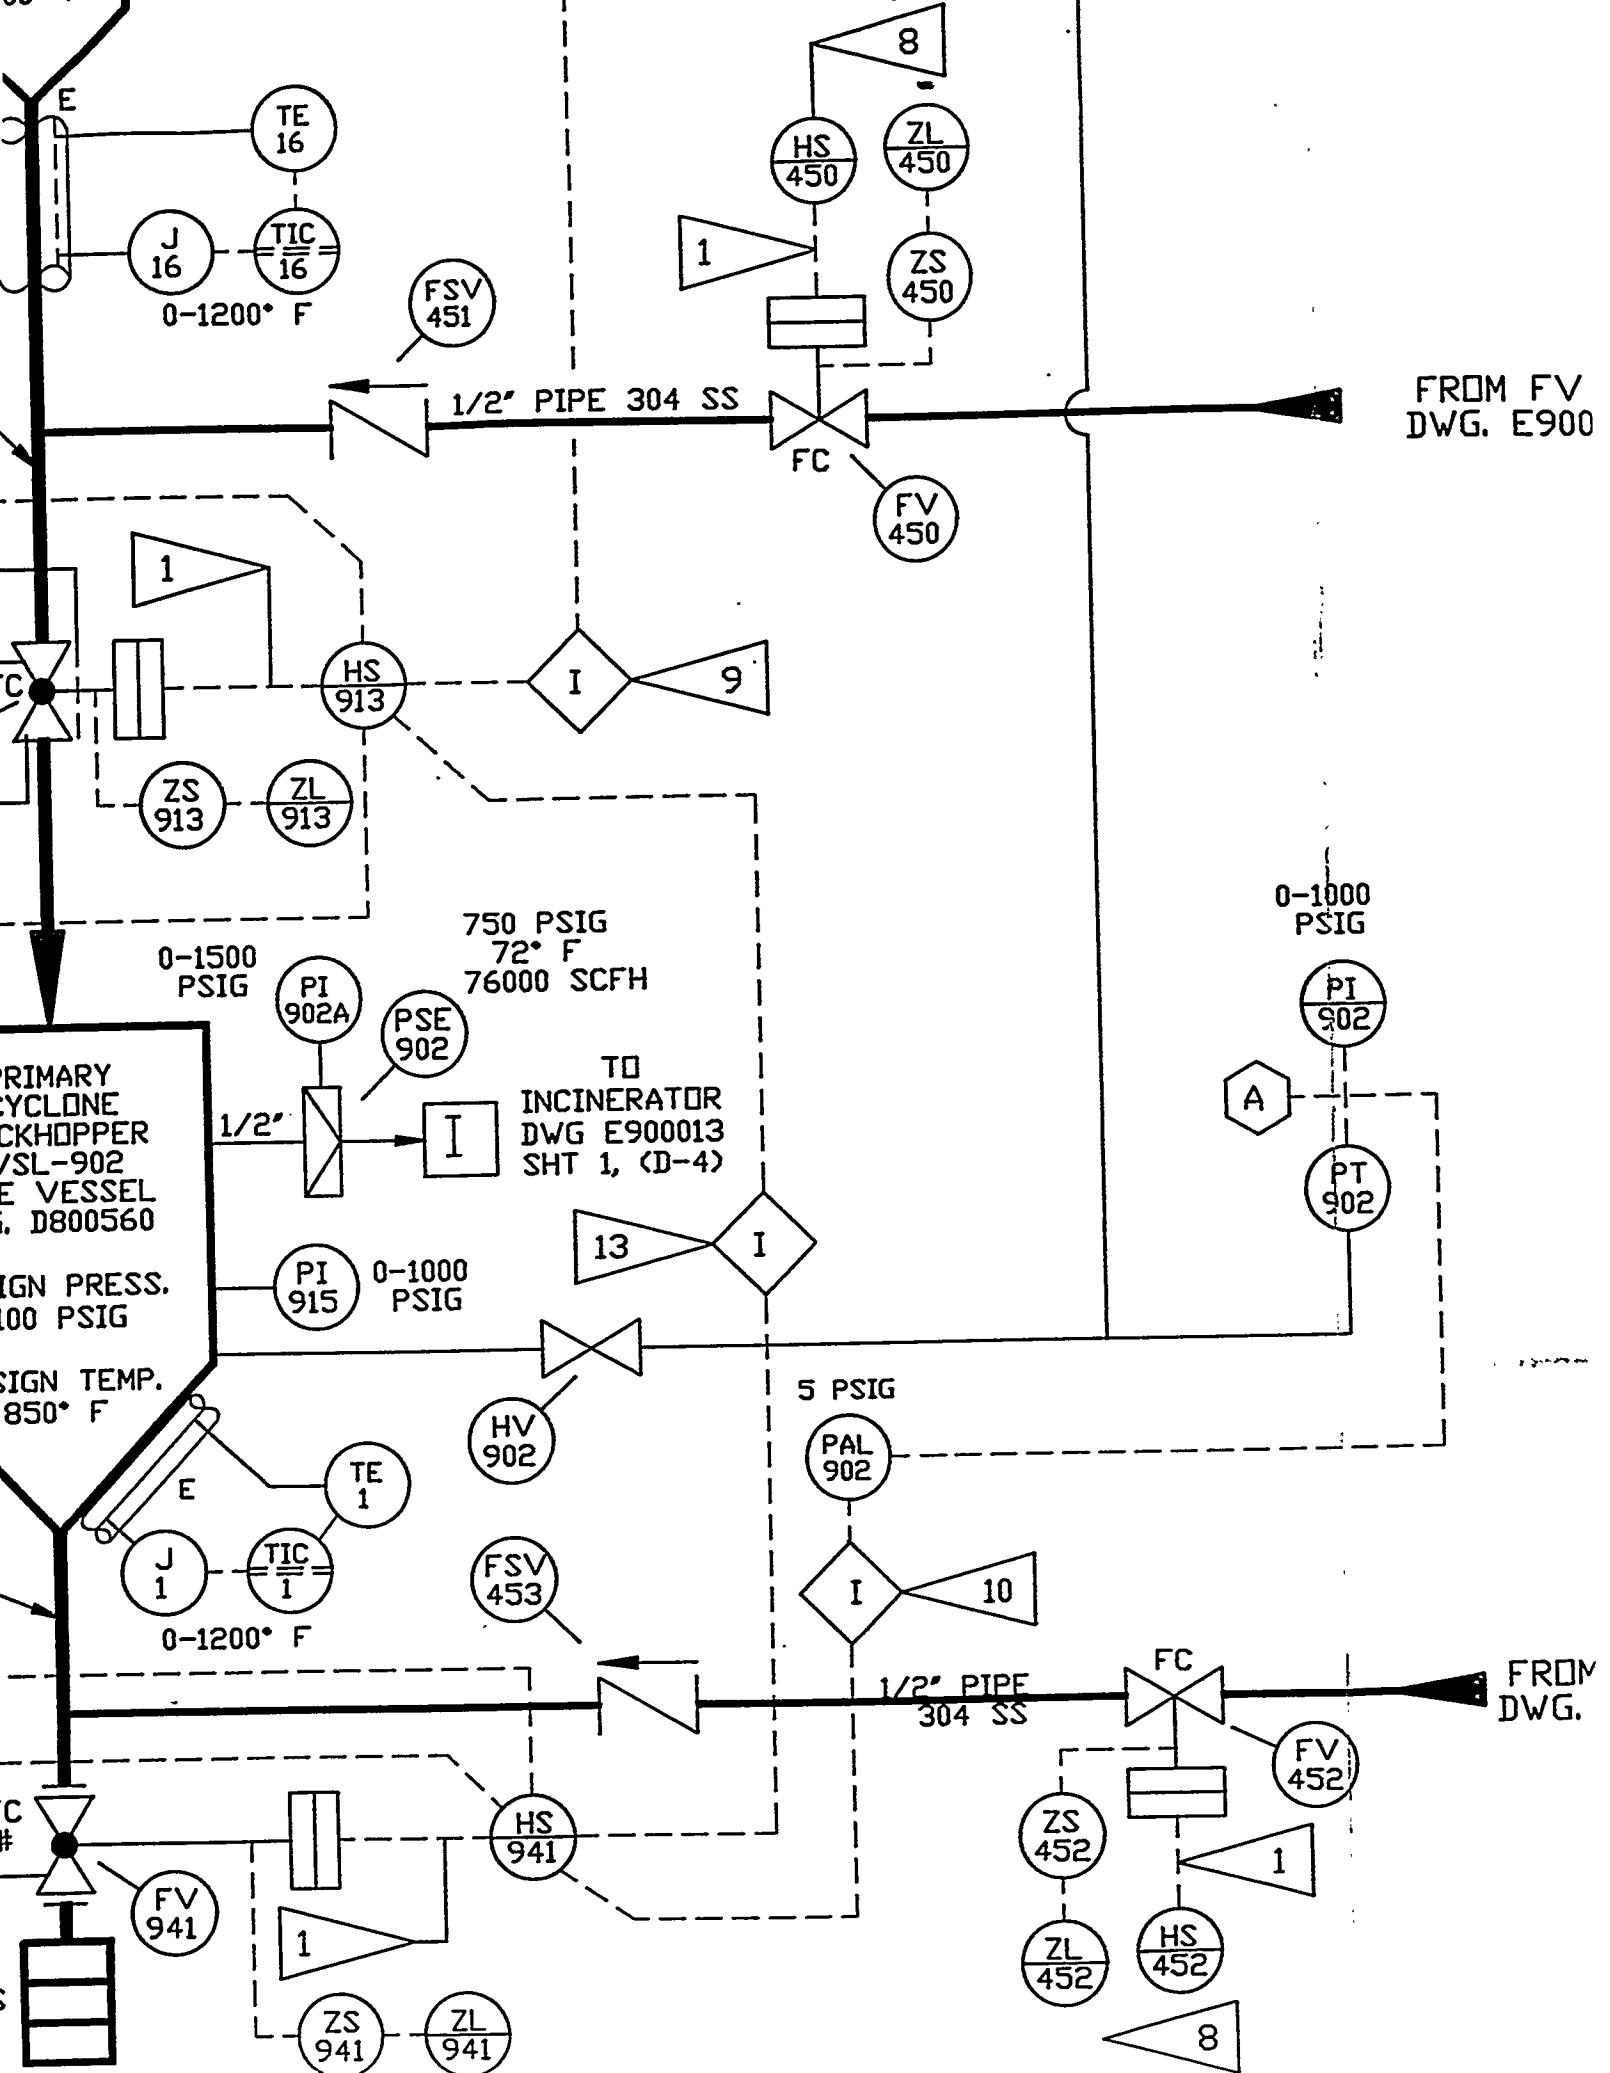

DRAFTER	DATE	CHECKER	DATE	EG&G RESPONSIBLE ENGR.	DATE
<i>Patricia M. Kuhne</i>	10/7/94	<i>J. C. Lue</i>	10-7-94	<i>Patricia M. Kuhne</i>	10-11-94
EG&G ENGR.	DATE	PROJECT ENGR.	DATE	BRANCH MANAGER	DATE
<i>Patricia M. Kuhne</i>	10-11-94	<i>J. M. Kotey</i>	10/13/94	<i>Terry Shadley</i>	10-18-94

FROM FV 454
DWG. E900013

LEGEND:



= PIPED TO PACKAGED INCINERATOR SYSTEM



= INPUT TO THE DDAS SYSTEM



IDENTIFIES THE CONNECTING SEGMENT OF THE T PURGE SYSTEM, WHERE XXX IS THE SEGMENT IDE NUMBER. (SEE DWG. E900013, SHT. 2 OF 2 FOR THIS SYMBOL INDICATES THAT THE FOLLOWING E IS IN THE PURGE LINE FROM THE NITROGEN HE TRANSMITTER:
FV-440, FSV-441, HV-441, HV-XXXP, FV-XXXI
FSV-XXXP




IDENTIFIES THE CONNECTING SEGMENT OF THE T PURGE SYSTEM, WHERE XXX IS THE SEGMENT II NUMBER. (SEE DWG. E900013, SHT. 2 OF 2 FOR THIS SYMBOL INDICATES THAT THE FOLLOWING E IS IN THE PURGE LINE FROM THE NITROGEN HE TRANSMITTER:
FV-440, FSV-441, HV-441, HV-XXXP, & FSV-XXXP

FROM FV 458
DWG. E900013

NOTES:



THIS FLAGGED NOTE DESIGNATES THE FOLLOWING WHICH IS NOT SHOWN ON THIS DWG. FOR CLARIFICATION: PANEL-MOUNTED ON/OFF STATION (HAND SWITCH, POSITION INDICATION LAMPS), 24 VDC RELAY, 11 60 HZ SOLENOID VALVE.

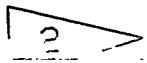

FV-940 WILL NOT OPEN UNTIL PT-901 MEASURED

FTER Parry Kuhfeld	DATE 10/7/94	CHECKER S. Carter	DATE 10-7-94	EG&G RESPONSIBLE ENGR. Gary Gantner	DATE 10-11-94	REVIEWER A. Heinfeld	DATE 10/11/94
GESTD G. Kuhfeld	DATE 10-11-94	PROJECT ENGR. John Kotter	DATE 10/13/94	BRANCH MANAGER Larry Shultz	DATE 10-18-94	DOE ACUSTD John DeWitt	DATE 10/18/94

F

GEND:

I = PIPED TO PACKAGED INCINERATOR SYSTEM

A = INPUT TO THE DDAS SYSTEM

E

G
XXX

IDENTIFIES THE CONNECTING SEGMENT OF THE TRANSMITTER PURGE SYSTEM, WHERE XXX IS THE SEGMENT IDENTIFICATION NUMBER. (SEE DWG. E900013, SHT. 2 OF 2 FOR DETAILS.) THIS SYMBOL INDICATES THAT THE FOLLOWING EQUIPMENT IS IN THE PURGE LINE FROM THE NITROGEN HEADER TO THE TRANSMITTER:

FV-440, FSV-441, HV-441, HV-XXXP, FV-XXXP, &
FSV-XXXP

H
XXX

IDENTIFIES THE CONNECTING SEGMENT OF THE TRANSMITTER PURGE SYSTEM, WHERE XXX IS THE SEGMENT IDENTIFICATION NUMBER. (SEE DWG. E900013, SHT. 2 OF 2 FOR DETAILS.) THIS SYMBOL INDICATES THAT THE FOLLOWING EQUIPMENT IS IN THE PURGE LINE FROM THE NITROGEN HEADER TO THE TRANSMITTER:

FV-440, FSV-441, HV-441, HV-XXXP, & FSV-XXXP.

D


S:


THIS FLAGGED NOTE DESIGNATES THE FOLLOWING EQUIPMENT WHICH IS NOT SHOWN ON THIS DWG. FOR CLARITY; PANEL-MOUNTED ON/OFF STATION (HAND SWITCH WITH POSITION INDICATION LAMPS), 24 VDC RELAY, 117 VAC 60 HZ SOLENOID VALVE.



>>> FV-940 WILL NOT OPEN UNTIL PT-901 MEASURES A PRESSURE LESS THAN OR EQUAL TO 2 PSIG.


FROM HV 505
DWG. E900011




FROM HV 320
DWG. E900011

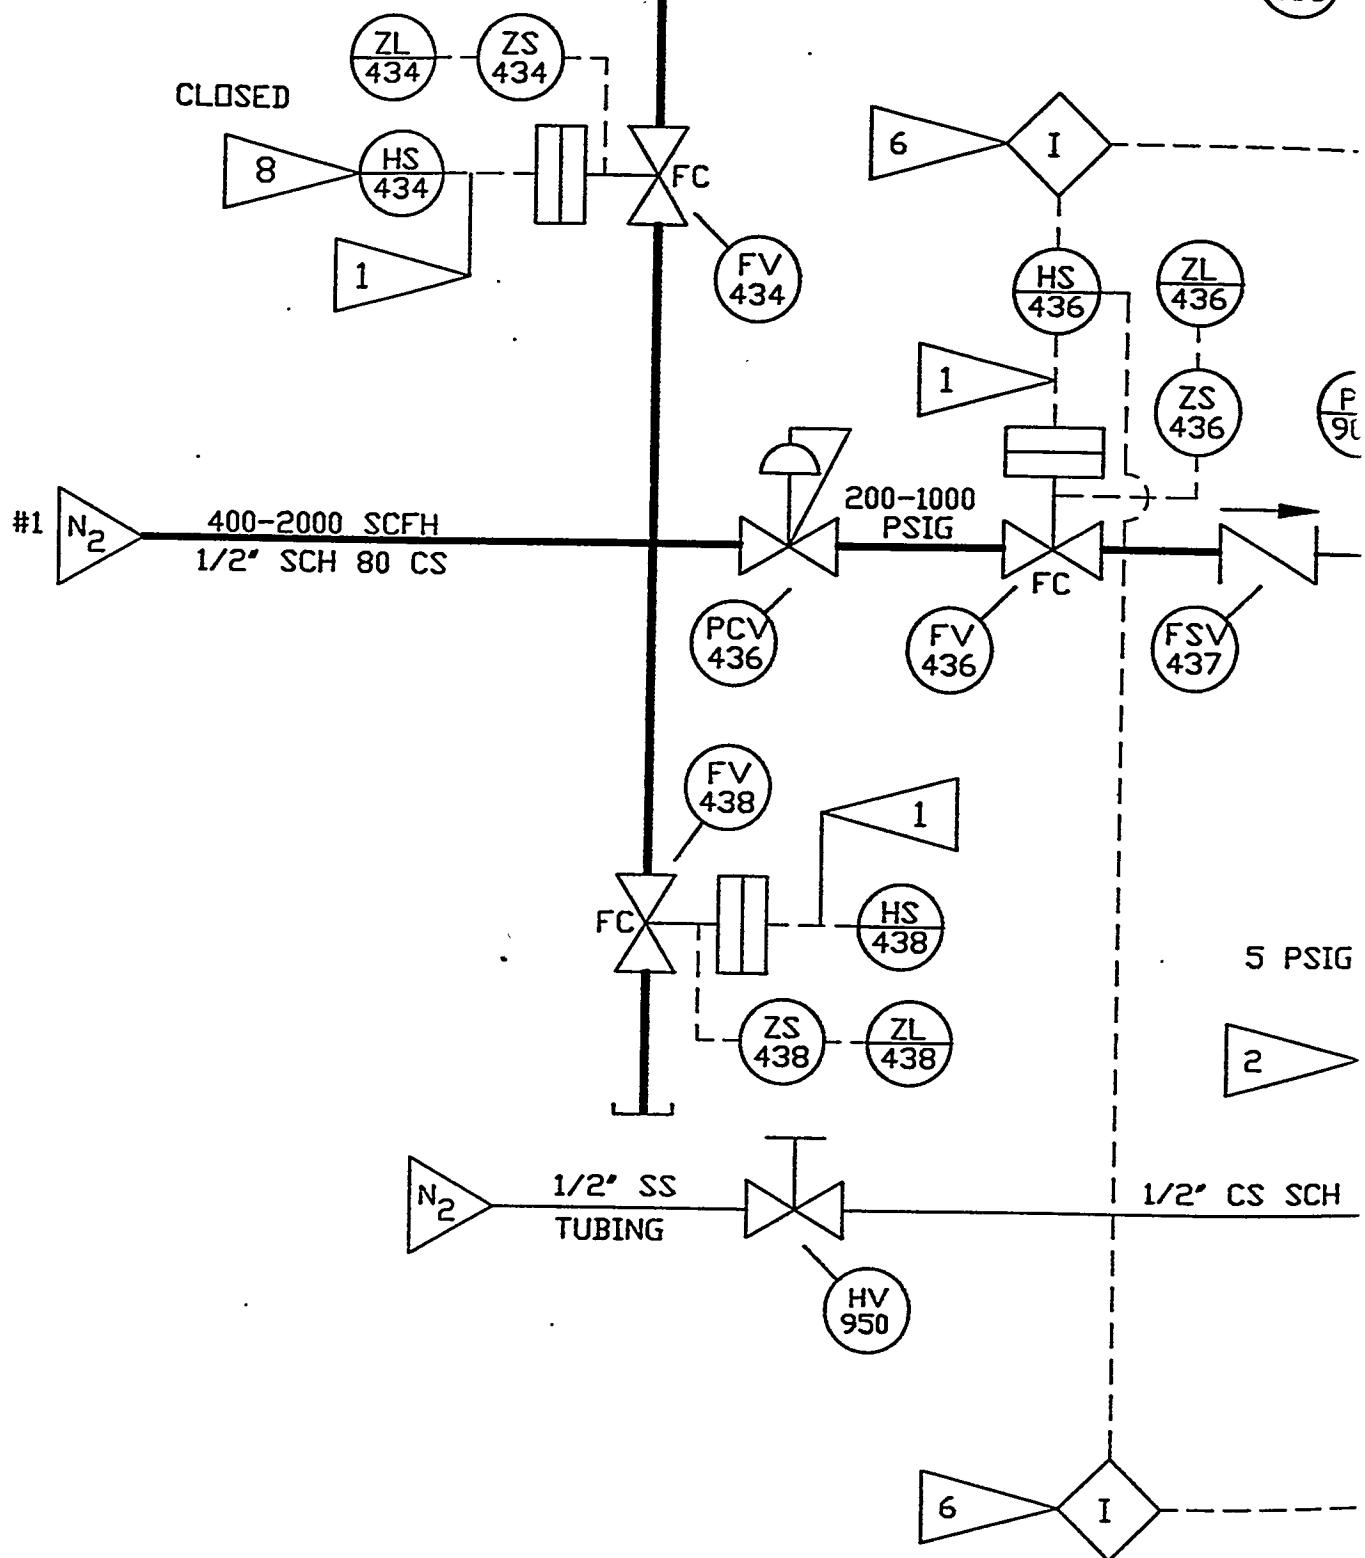

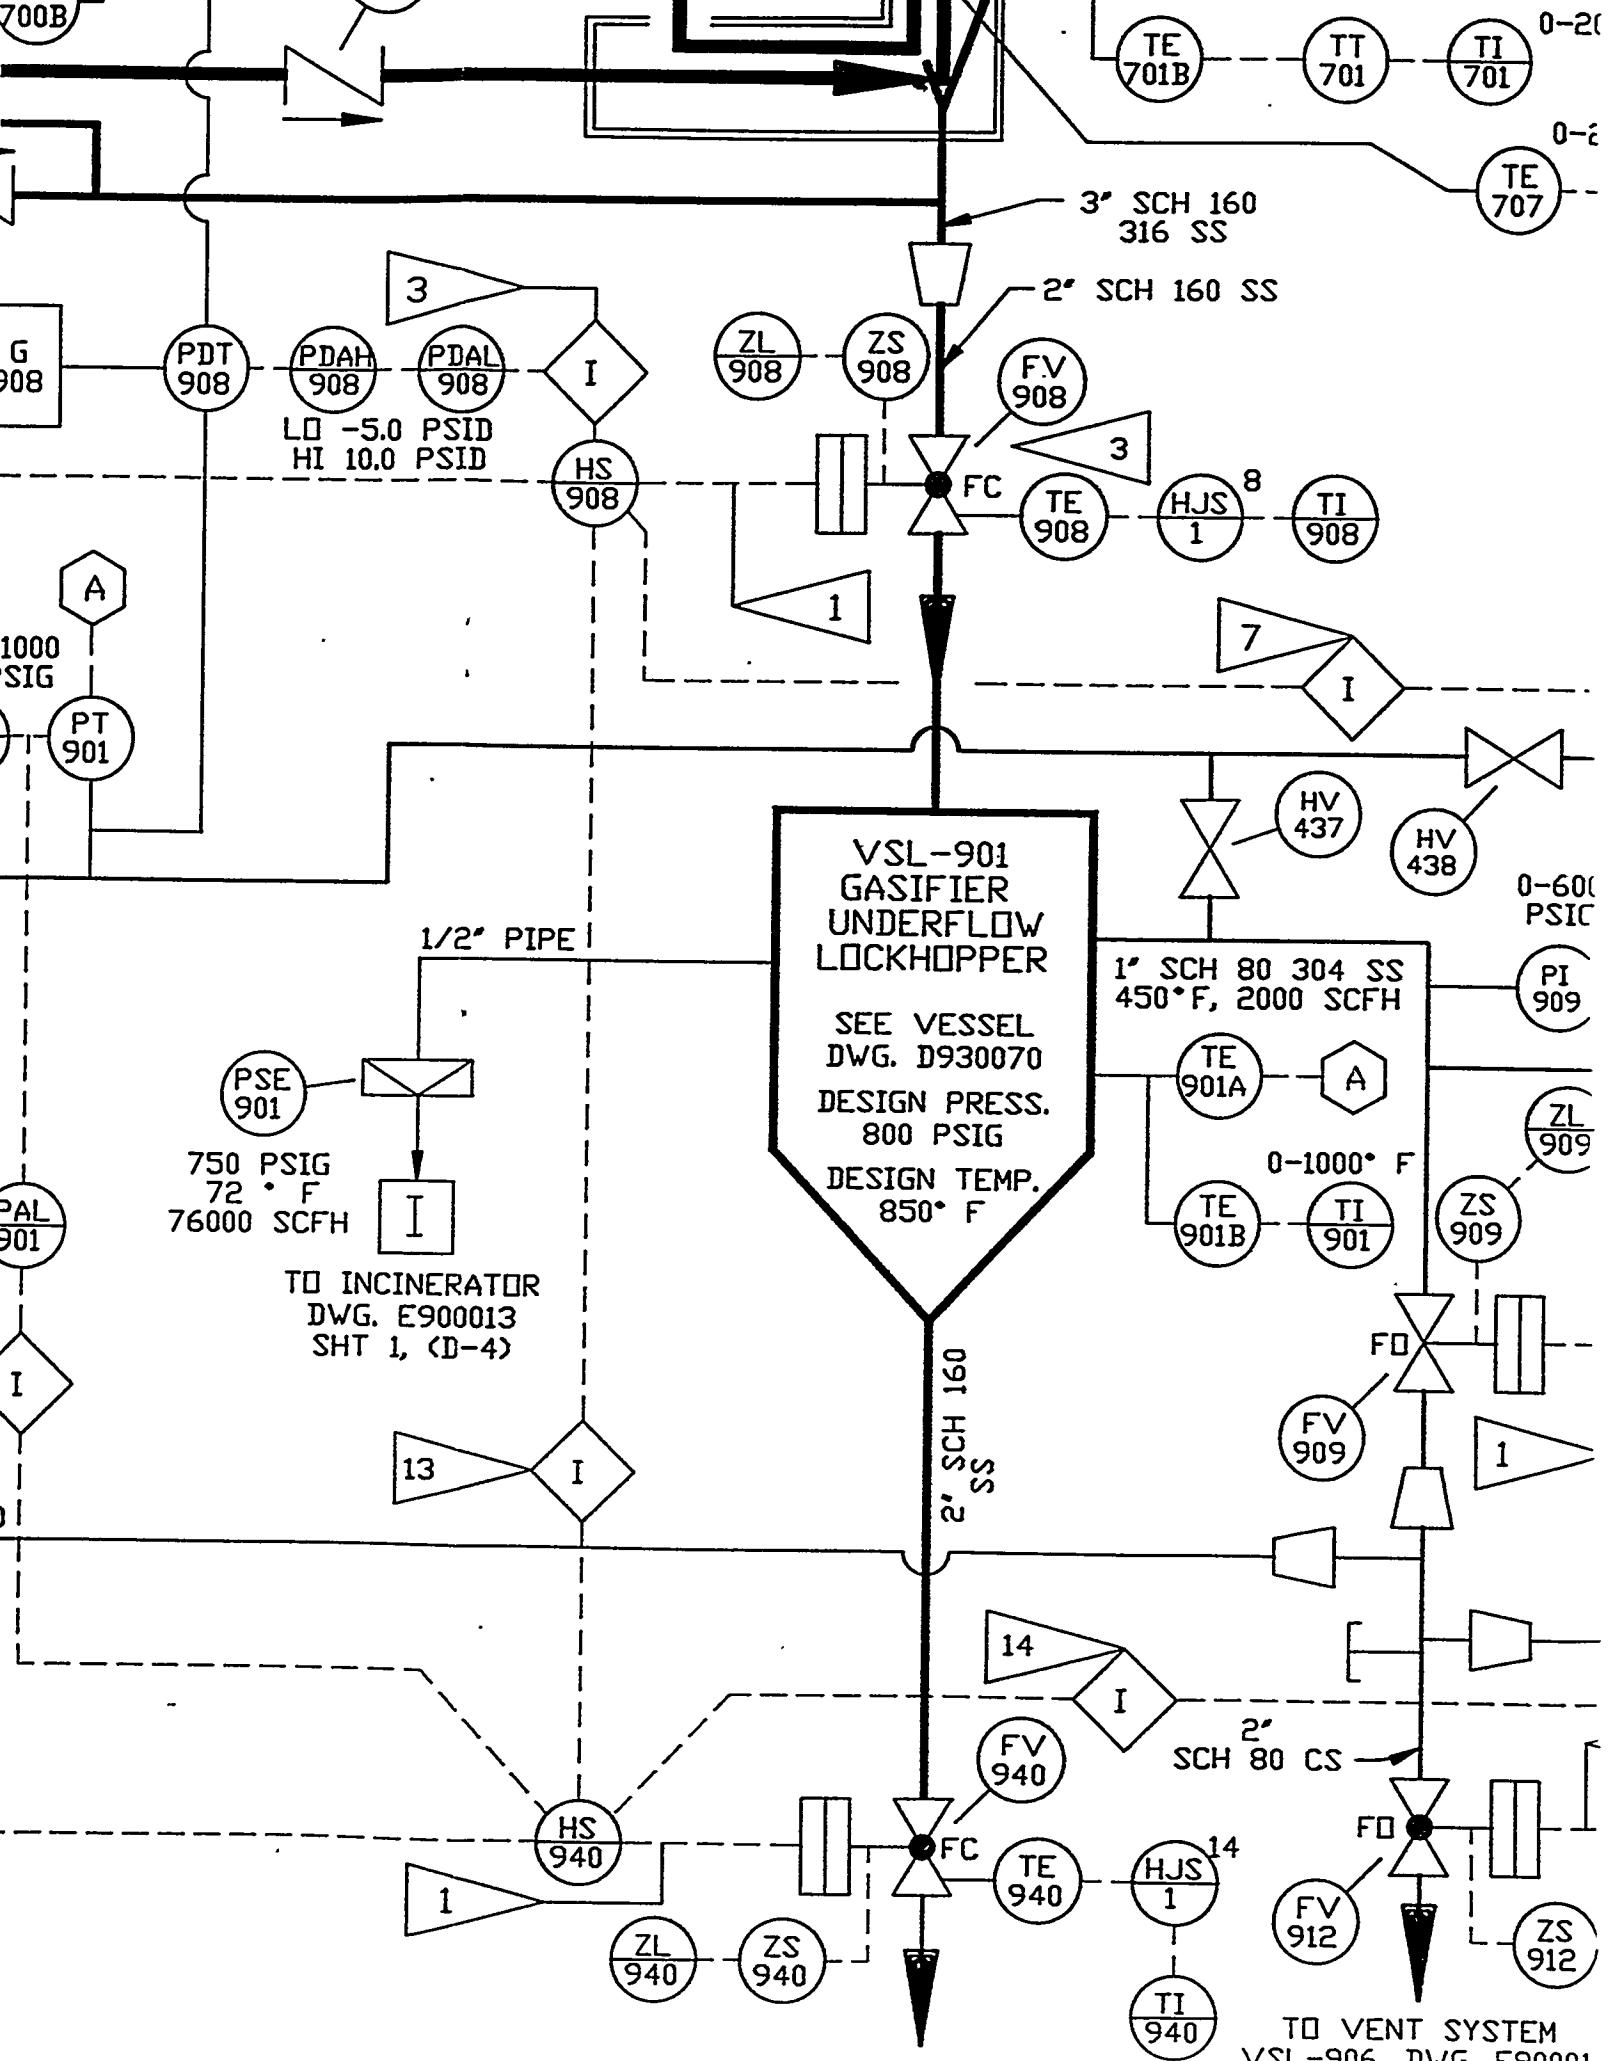


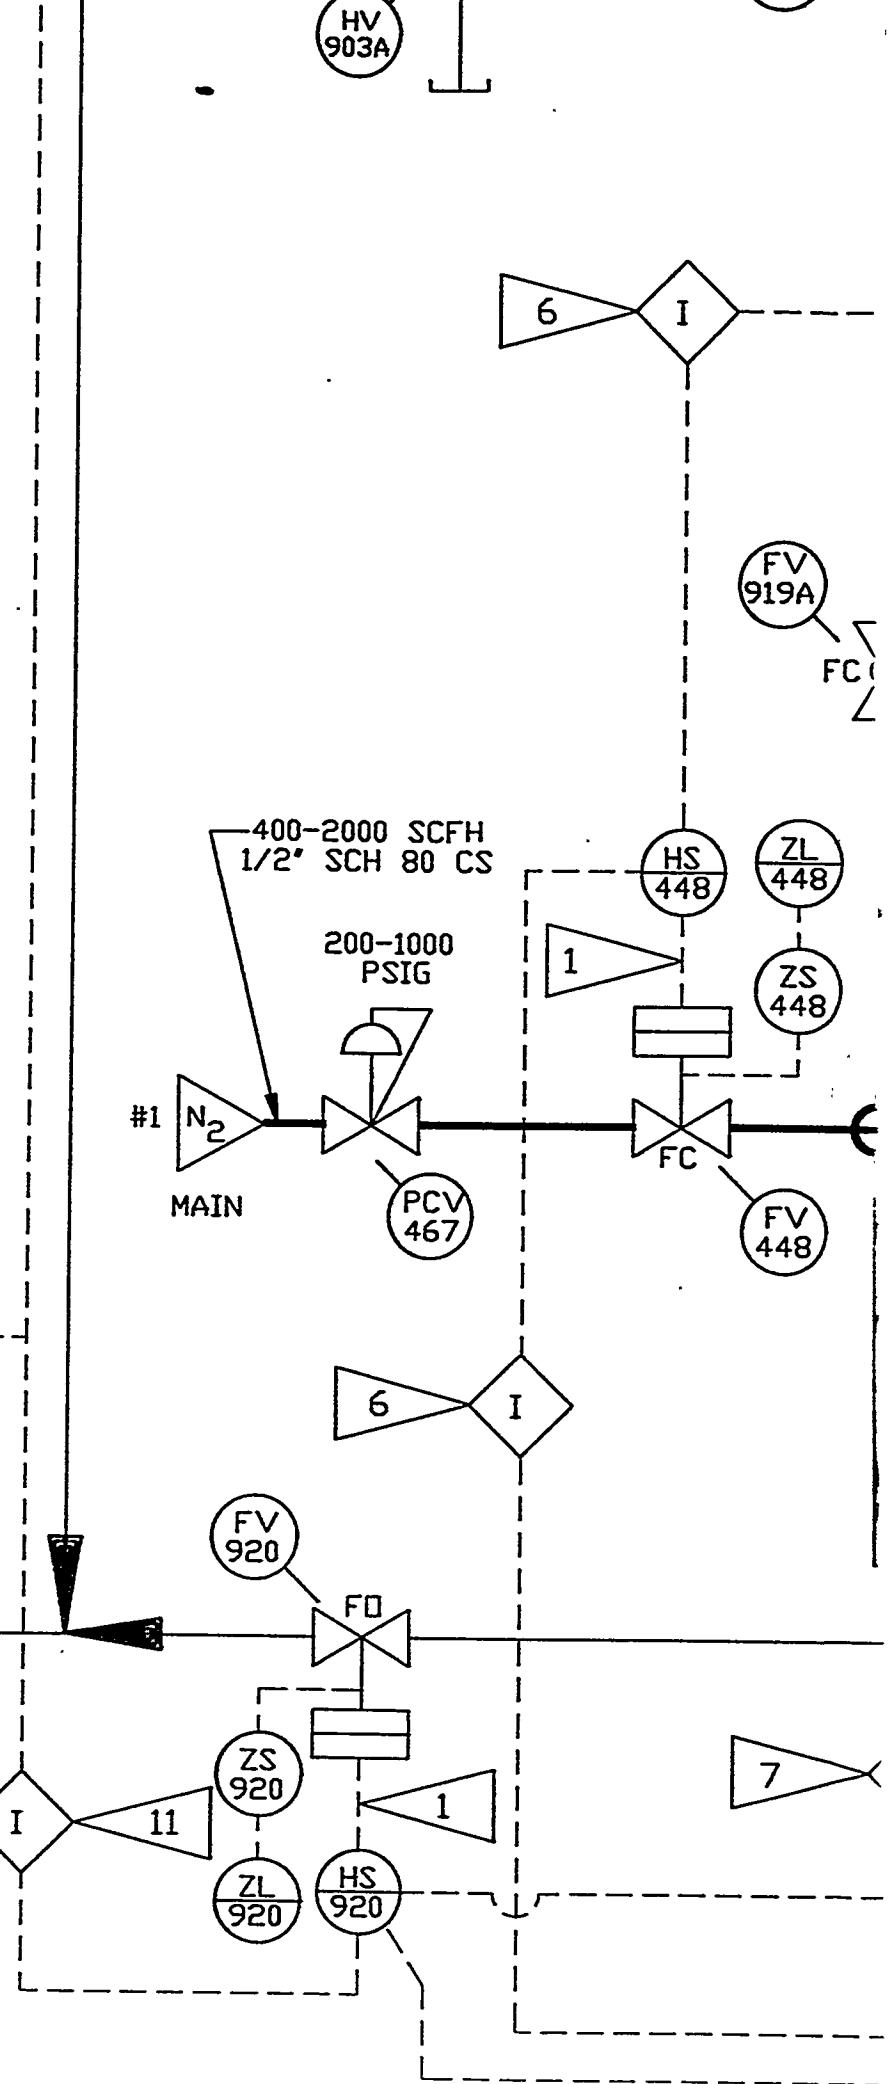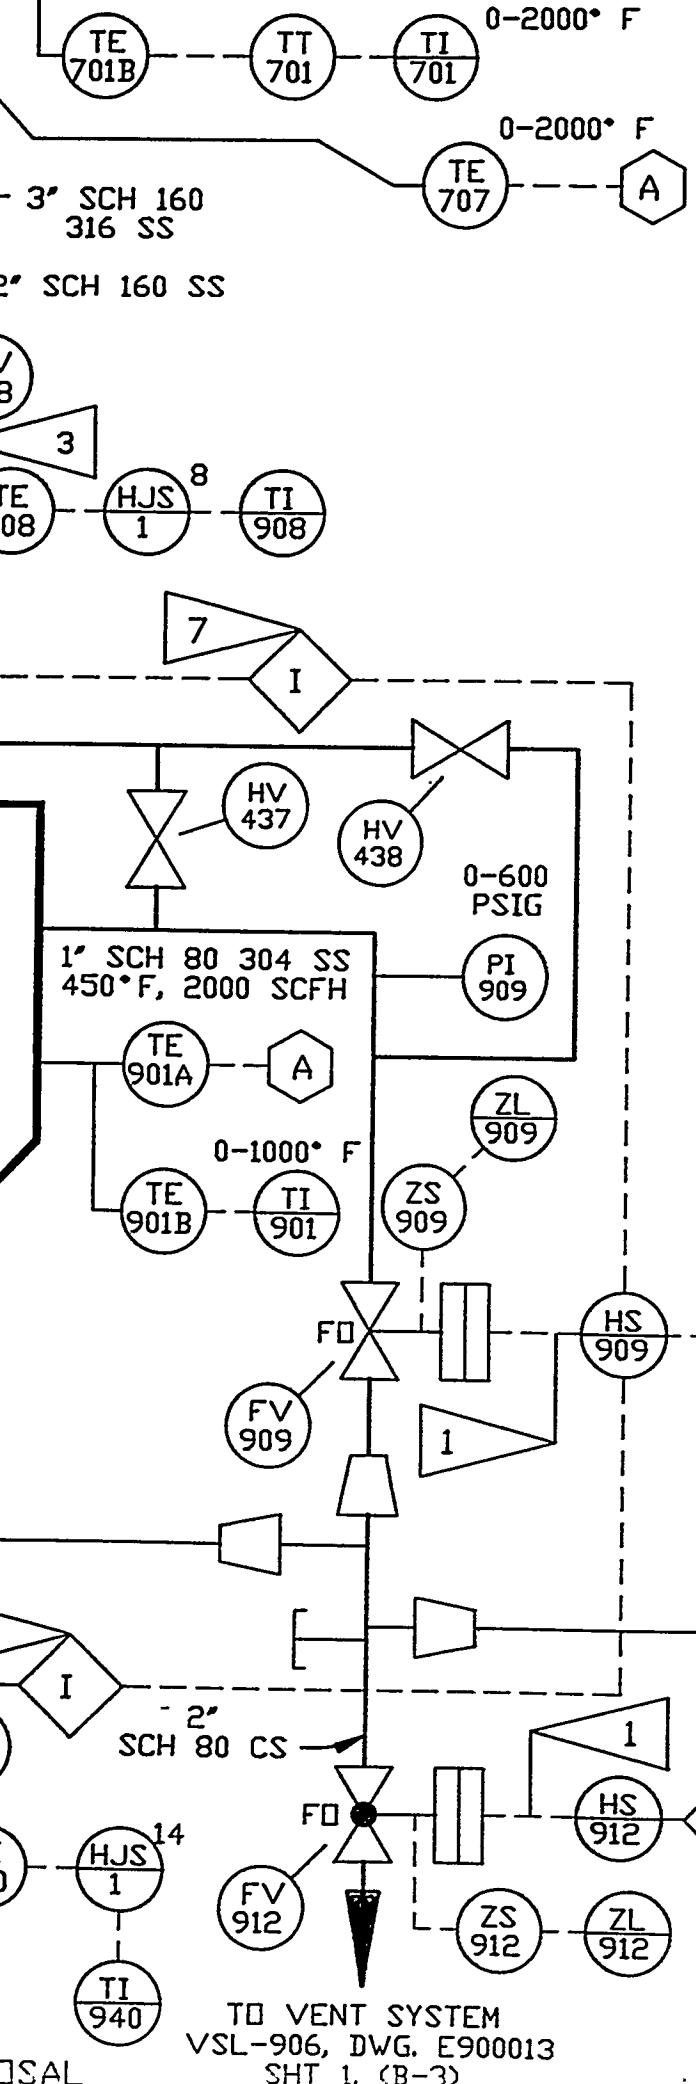

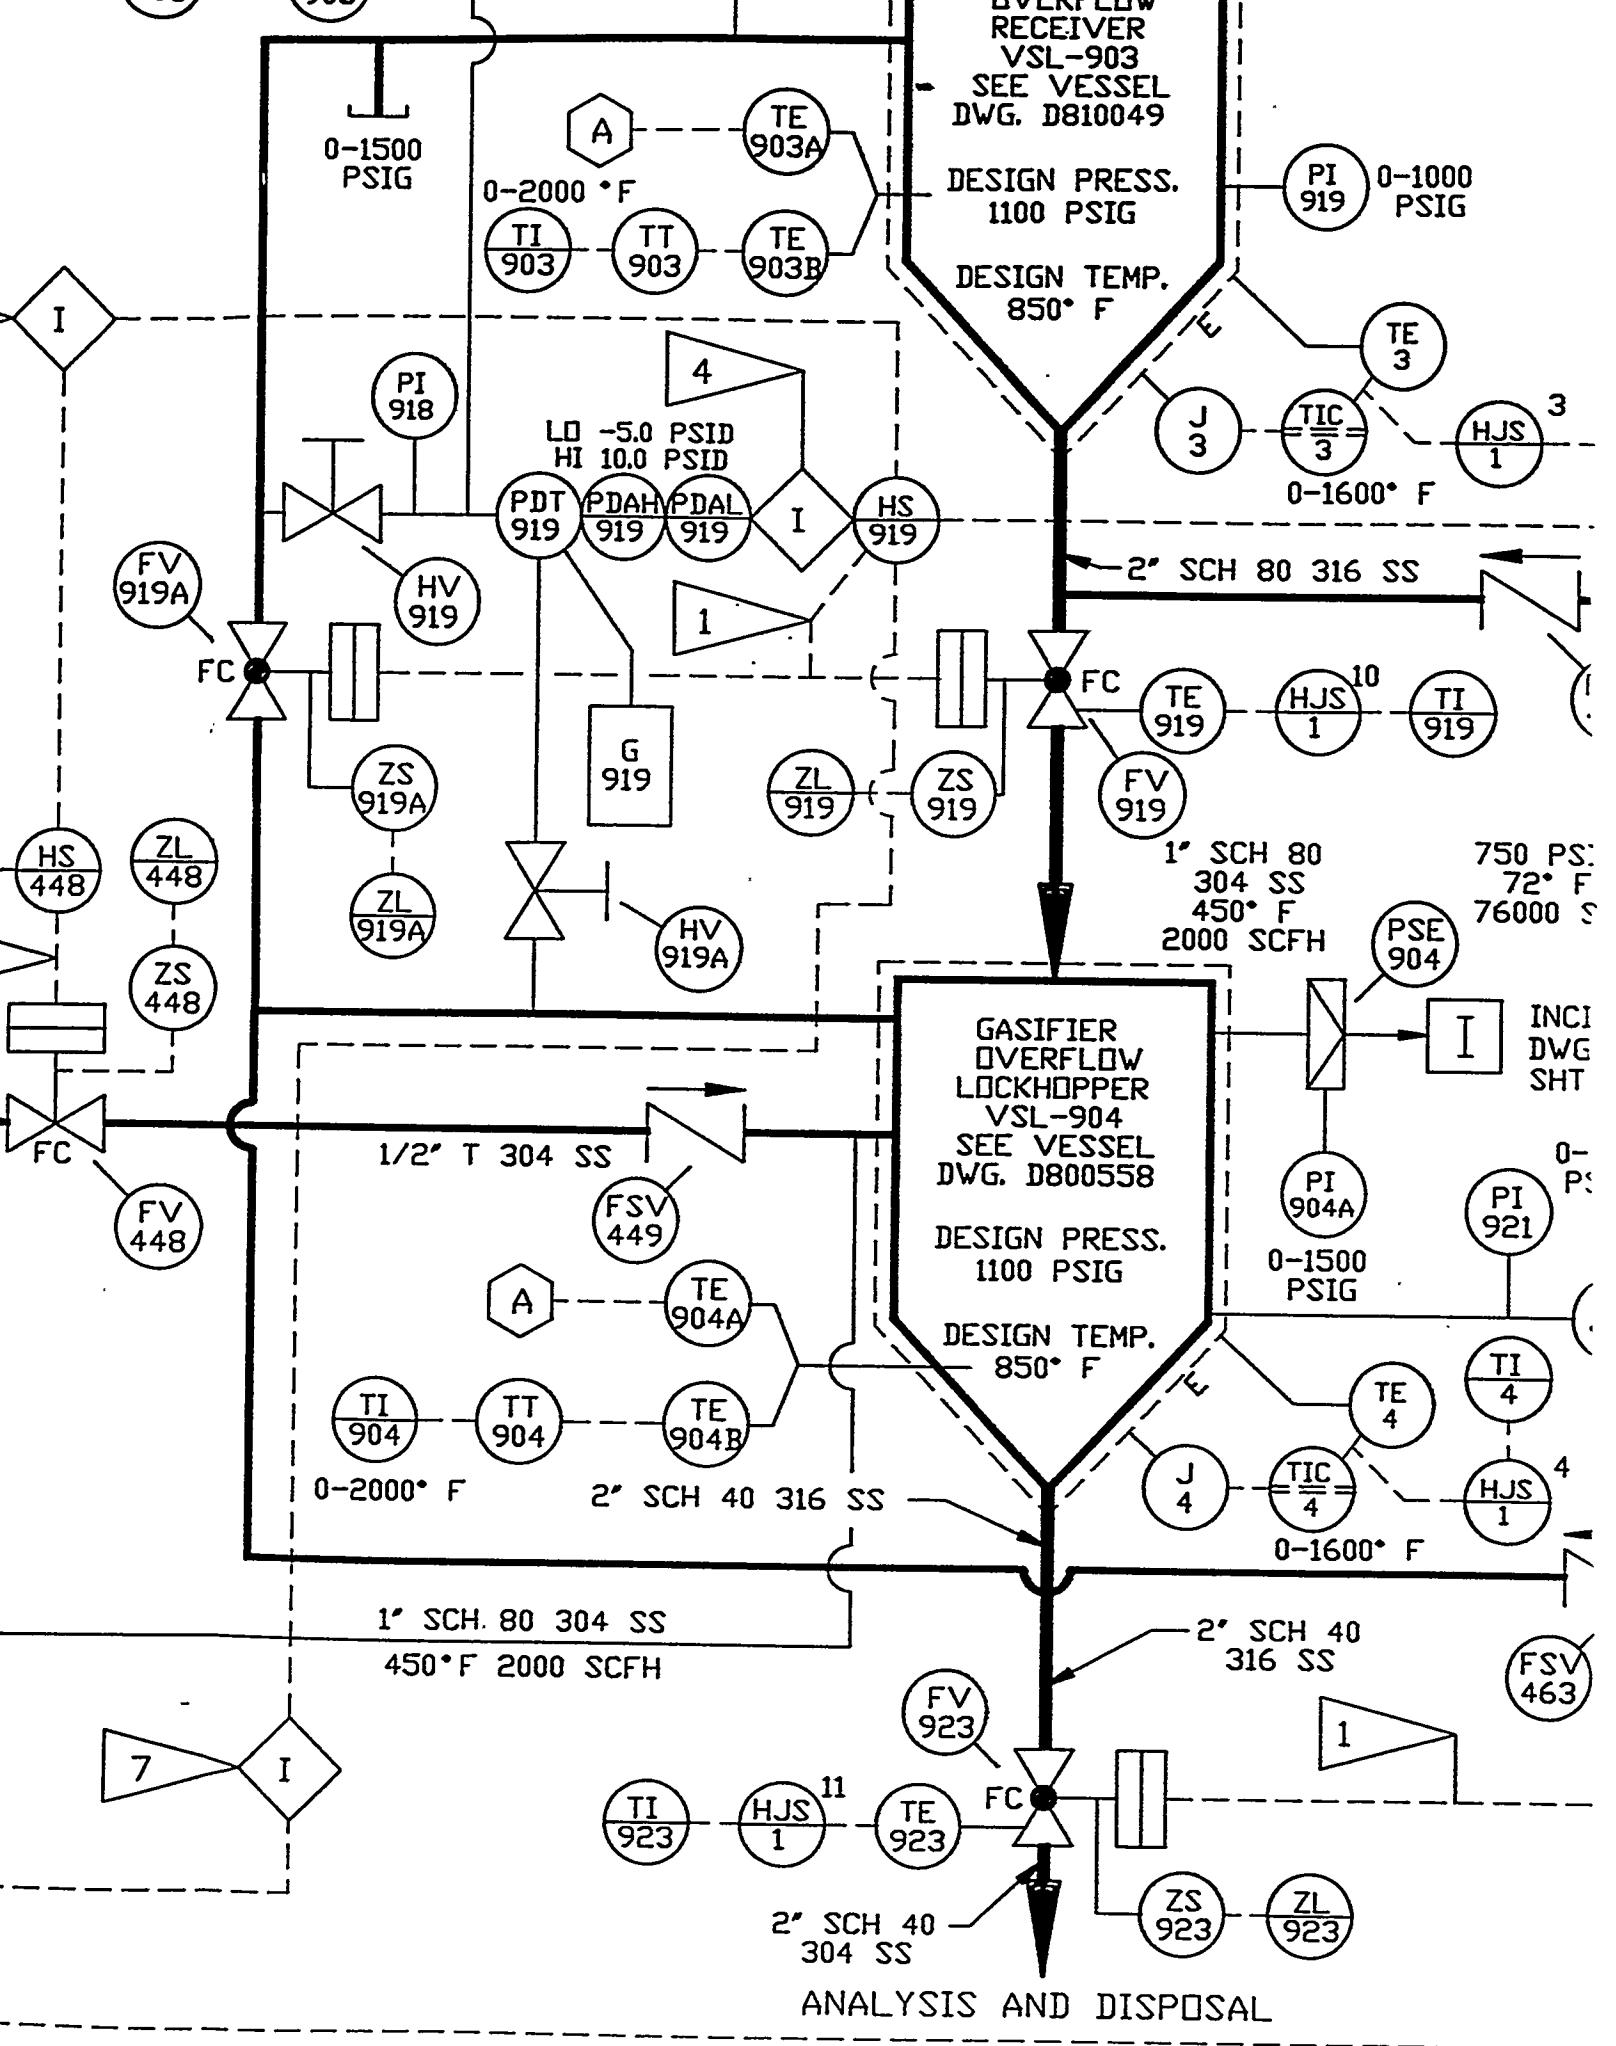

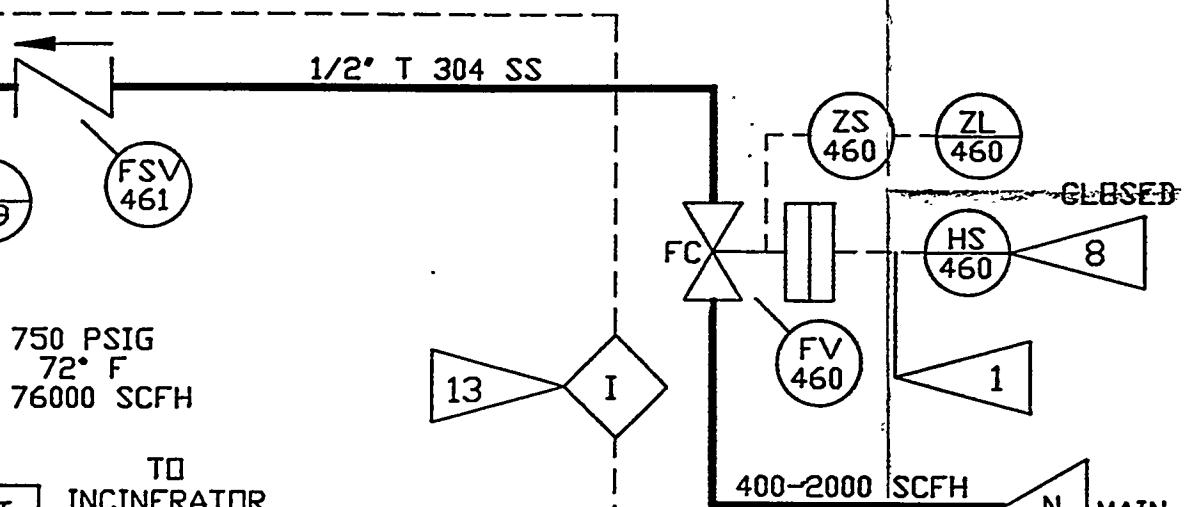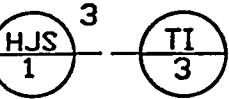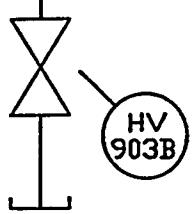

I TO
INCINERATOR
DWG E900013
SHT 1, (D-4)

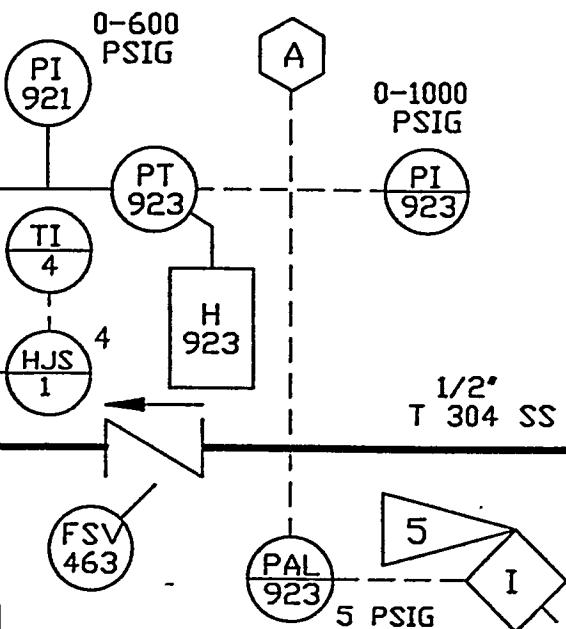

THIS DRAWING IS PART
OF THE EG&G DOCUMENT
CONTROL SYSTEM

REFERENCE DRAWINGS
E900010
E900011
E900013

DRAFTER	S. COI
CHECKER	A. R. KL
PROJECT ENGINEER	J.P. KAN

- 4 FV-C A PR 5.0 F MUST
- 5 FV-C LESS
- 6 LOCK VAL N₂ C OPEN
- 7 RELA VEN
- 8 DESI LOCK
- 9 FV-C PRES 5.0 F LOW
- 10 FV-C PRES
- 11 RELA 909
- 12 THIS SUPE TUBI
- 13 RELA VAL
- 14 RELA FRON

I 14

FV-919 & FV-919A WILL NOT OPEN UNTIL PDT-919 MEASURES A PRESSURE DIFFERENTIAL LESS THAN OR EQUAL TO 5.0 PSID. REF. DWG. NO. D910379. THE PRESSURE IN VSL-903 MUST BE HIGHER THAN THE PRESSURE IN VSL-904.

FV-923 WILL NOT OPEN UNTIL PT-923 MEASURES A PRESSURE LESS THAN OR EQUAL TO 2 PSIG. REF. DWG. NO. D910379

LOCKHOPPER FILL VALVE CANNOT BE OPENED IF THE N₂ CHARGING VALVE IS OPENED. DUMP VALVE CANNOT BE OPENED IF THE N₂ CHARGING VALVE IS OPENED. N₂ CHARGING VALVE CANNOT BE OPENED IF THE FILL OR DUMP VALVES ARE OPEN.

RELAY INTERLOCKS PREVENT THE LOCKHOPPER'S FILL VALVE AND VENT VALVE FROM BEING OPEN AT THE SAME TIME.

DESIGNATES THAT THE CONTROL PANEL SWITCH IS PHYSICALLY LOCKED TO PREVENT ACCIDENTAL ACTUATION.

FV-913 WILL NOT OPEN UNTIL PDT-934 MEASURES A PRESSURE DIFFERENTIAL LESS THAN OR EQUAL TO 5.0 PSID. THE PRESSURE IN VSL-902 MUST BE LOWER THAN THE PRESSURE IN CYC-701.

FV-941 WILL NOT OPEN UNTIL PT-902 MEASURES A PRESSURE LESS THAN OR EQUAL TO 2 PSIG.

RELAY INTERLOCKS PREVENT THE LOCKHOPPER VENT VALVES 909, 920 & 914 FROM OPENING UNLESS FV-912 IS OPEN.

THIS DWG. & DWGS. E900010, E900011 & E900013 SUPERCEDES DWG. R800524 (SEE DWG. E900013 FOR NOTES, TUBING & PIPING SUMMARY).

RELAY INTERLOCKS PREVENT THE LOCKHOPPER'S FILL AND DUMP VALVES FROM BEING OPEN AT THE SAME TIME.

RELAY INTERLOCKS PREVENT THE LOCKHOPPER'S DUMP VALVE FROM OPENING UNLESS THE VENT VALVE IS OPEN.

C



D&E
IN


E900012

1 HS

DRAFTER S. CONKO	DATE 3/6/90	 <p>United States Department of Energy MORGANTOWN ENERGY TECHNOLOGY CENTER Morgantown, WV</p>		
CHECKER A. R. KUBALA	DATE 3/6/90			
PROJECT ENGINEER J.P. KANDSKY	DATE 3/6/90			
	DATE	<p>B-12 P&ID FLUIDIZED BED GASIFIER A.G.C.</p>		
	DATE			
	DATE			
	DATE			
	DATE	SIZE E	FSCH NO	DVG NO E900012
	DATE			REV 6


A

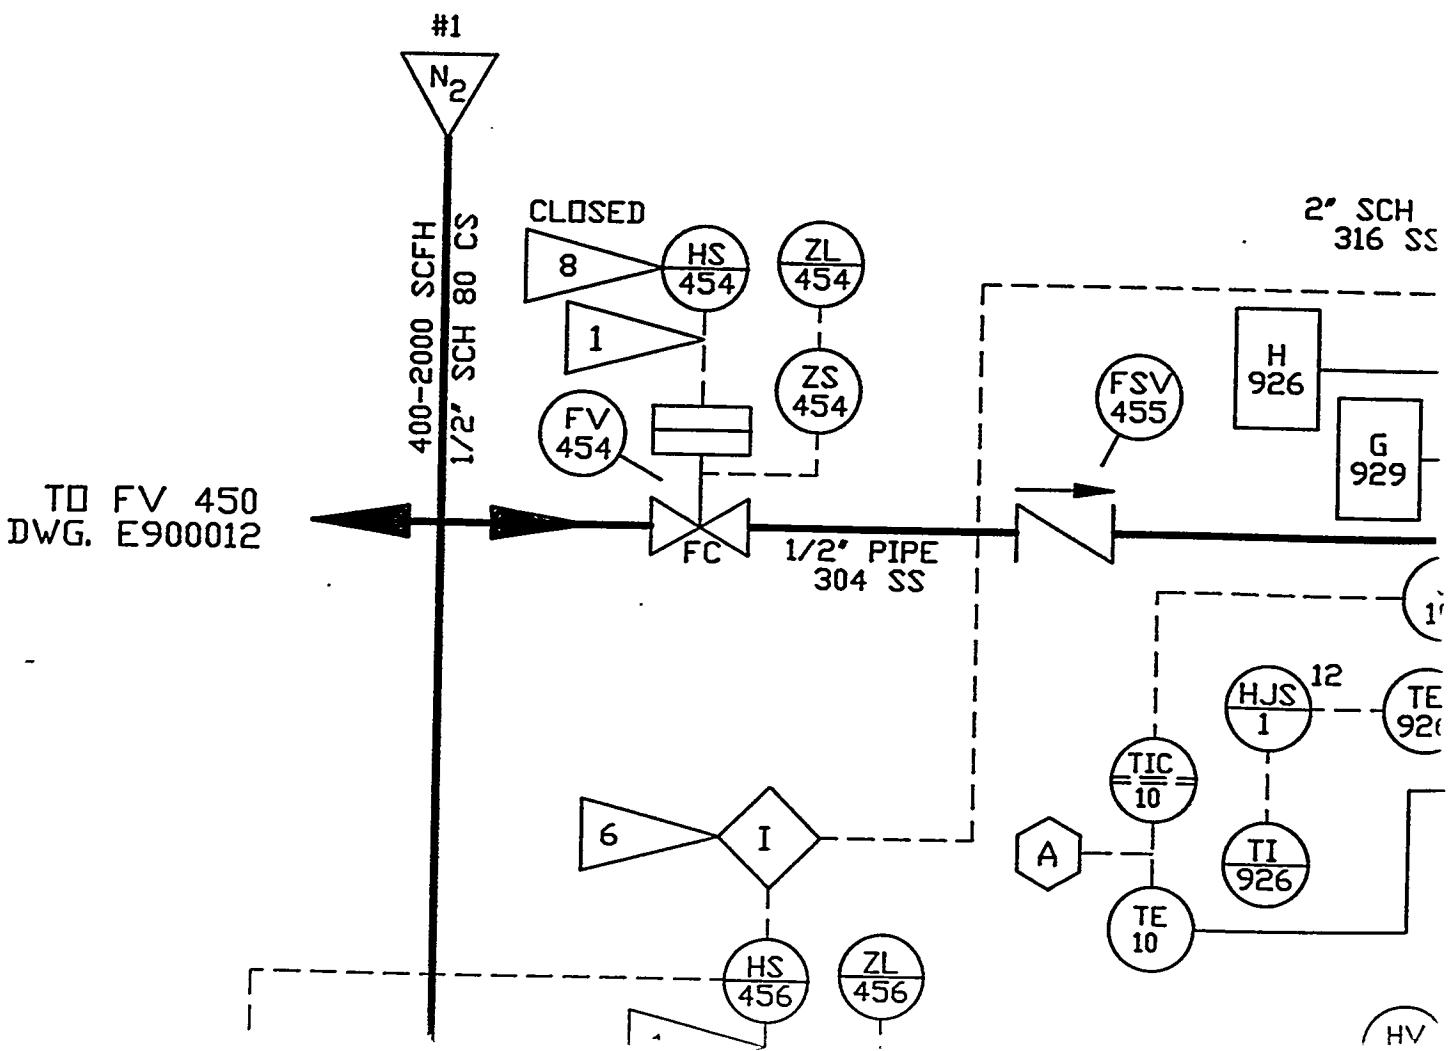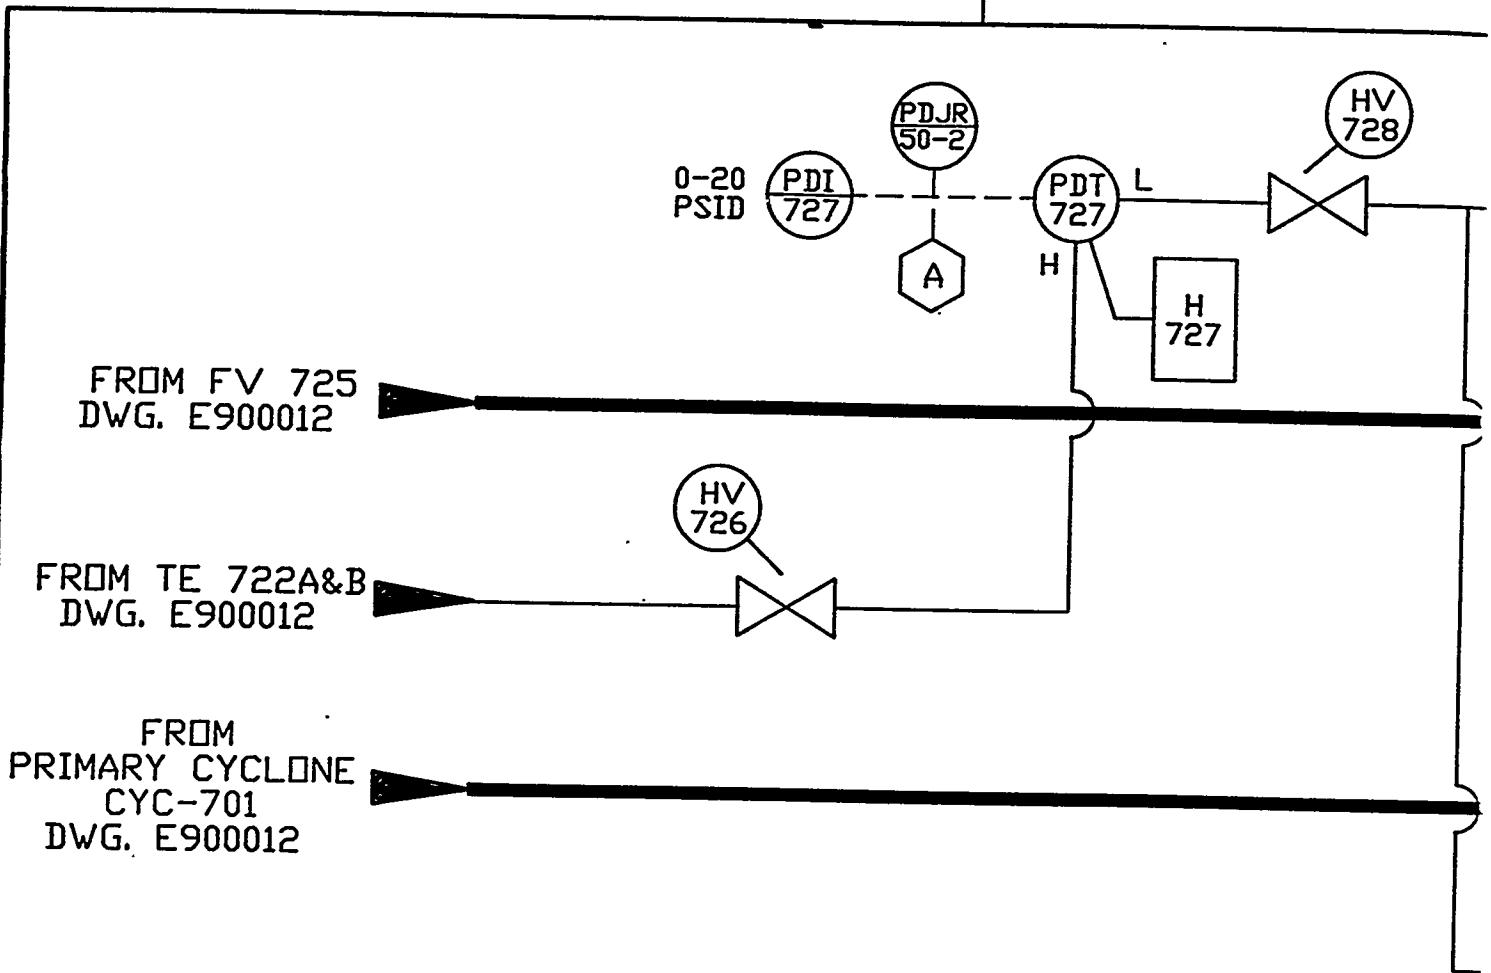

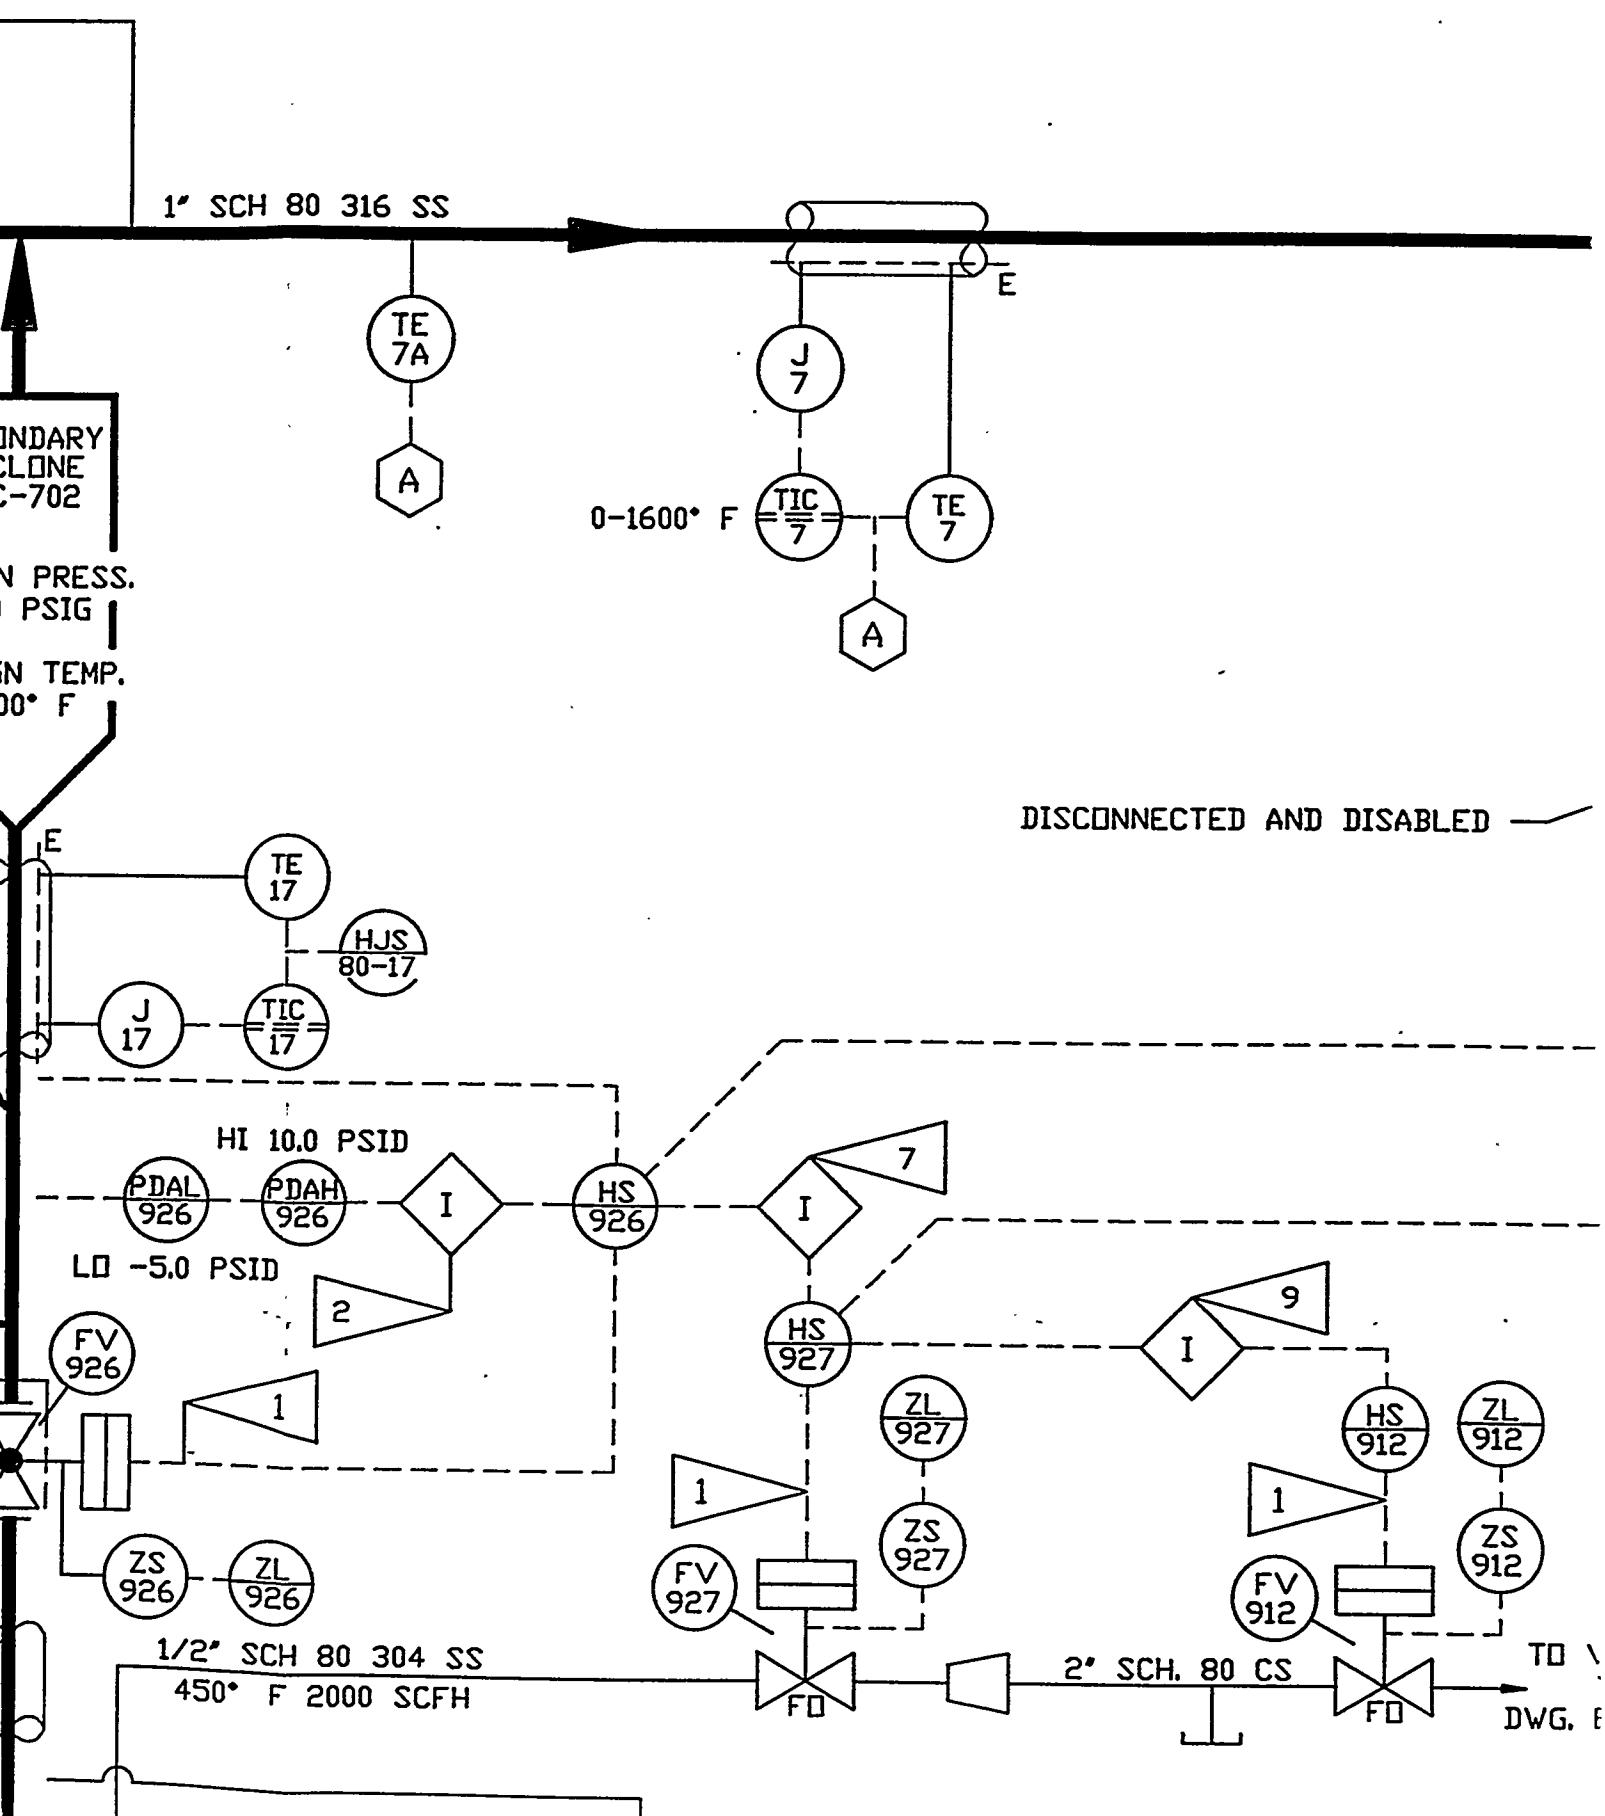


T



1" SCH 80 316 SS

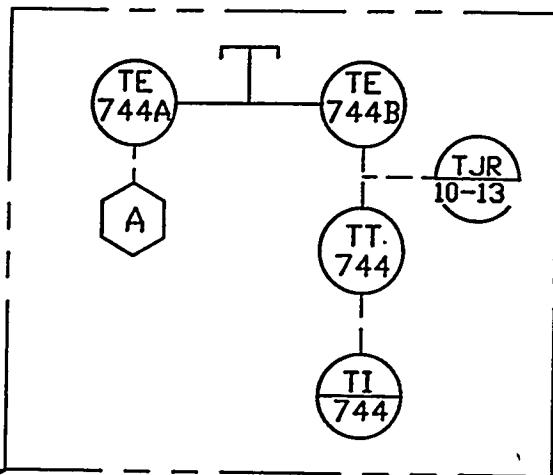

FROM PY 713
DWG. E900012
(H-2)

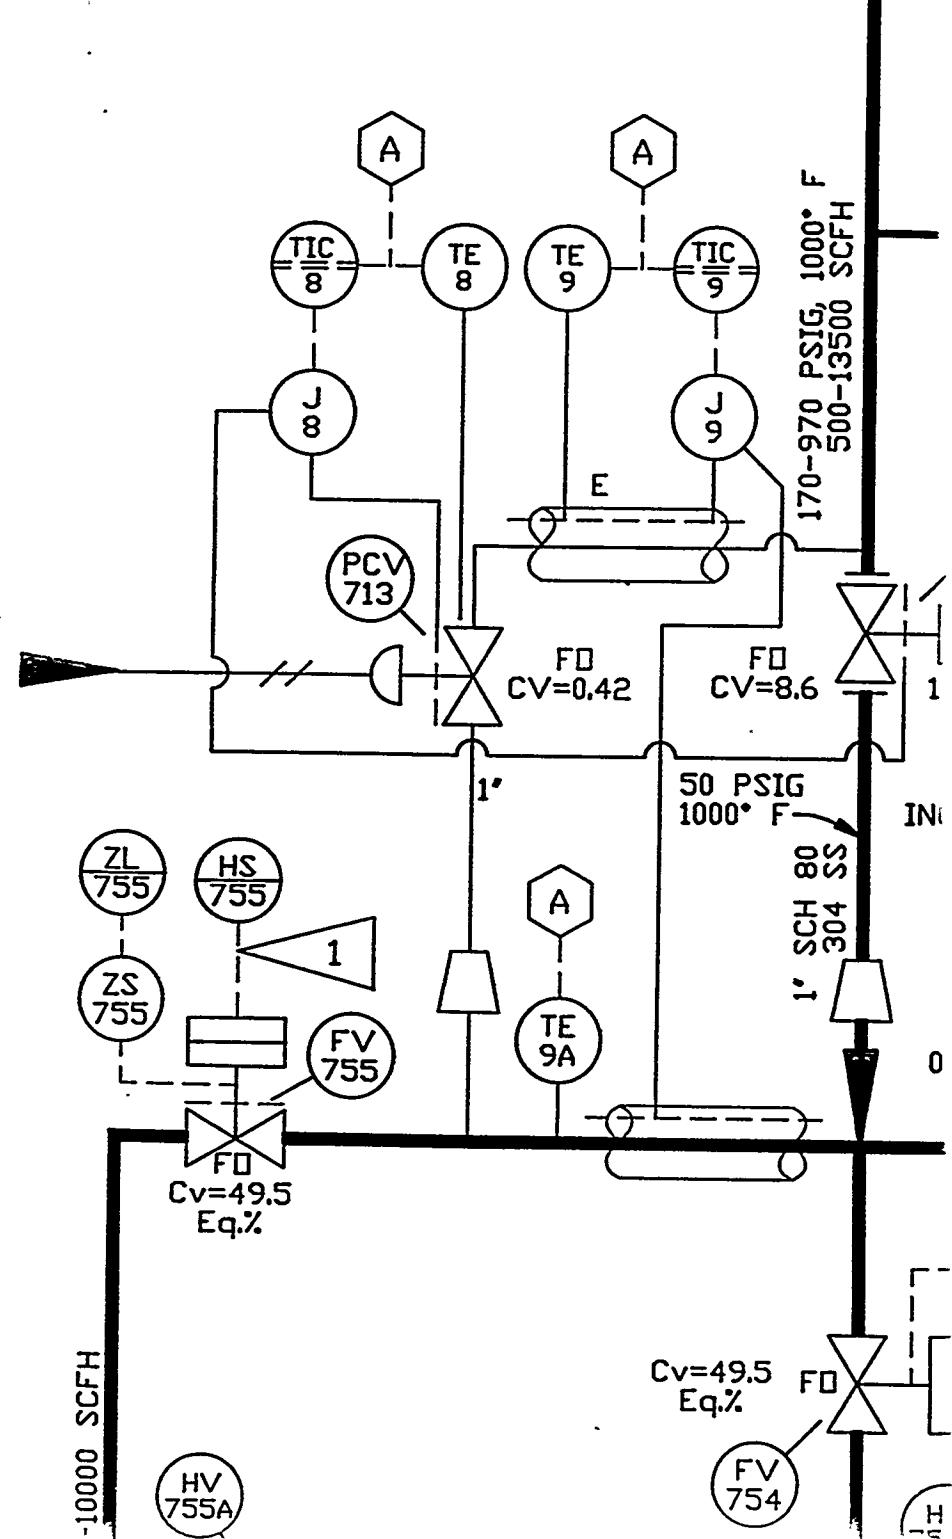

SYSTEM
906
13, SHT 1
(3)

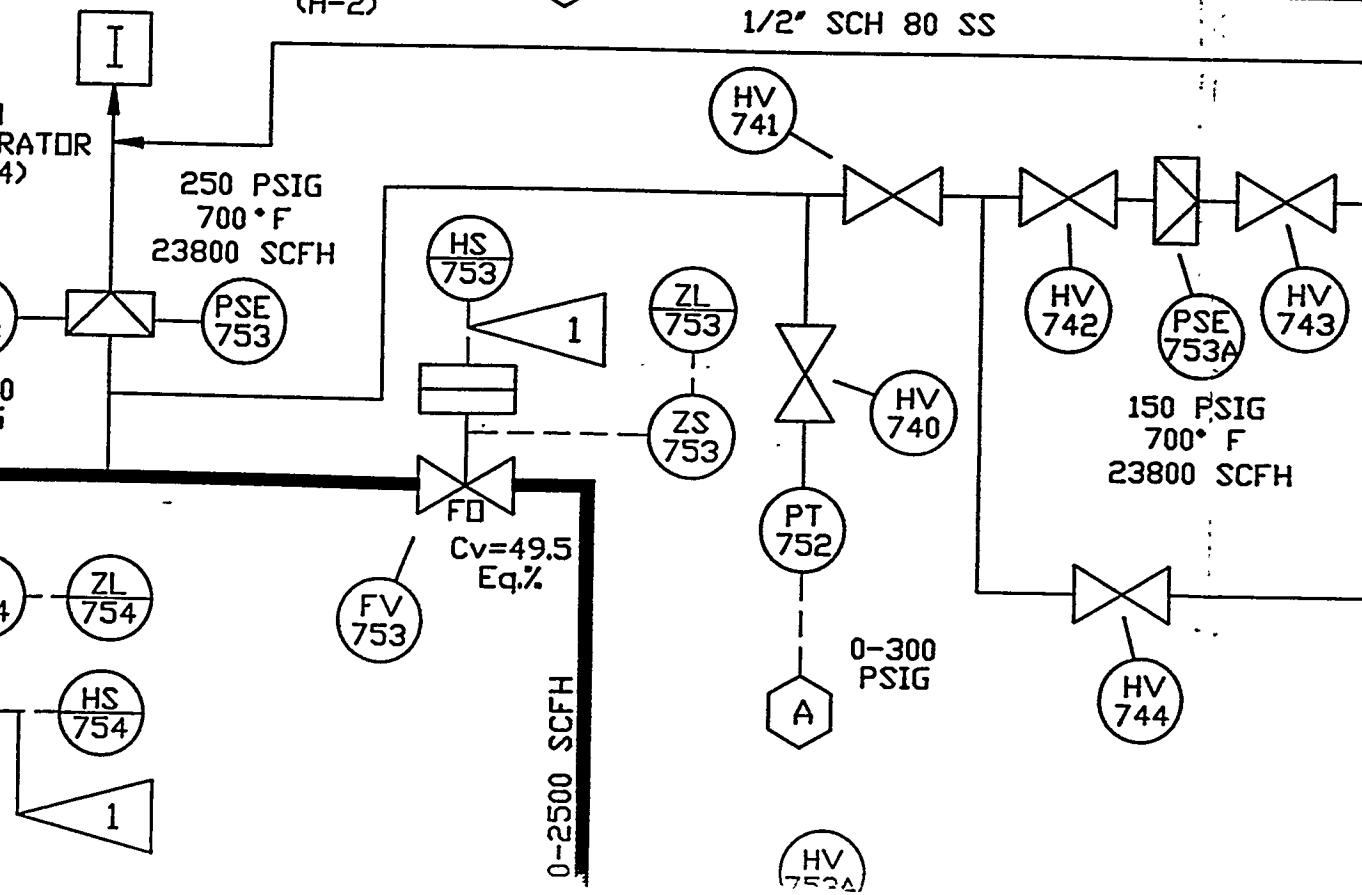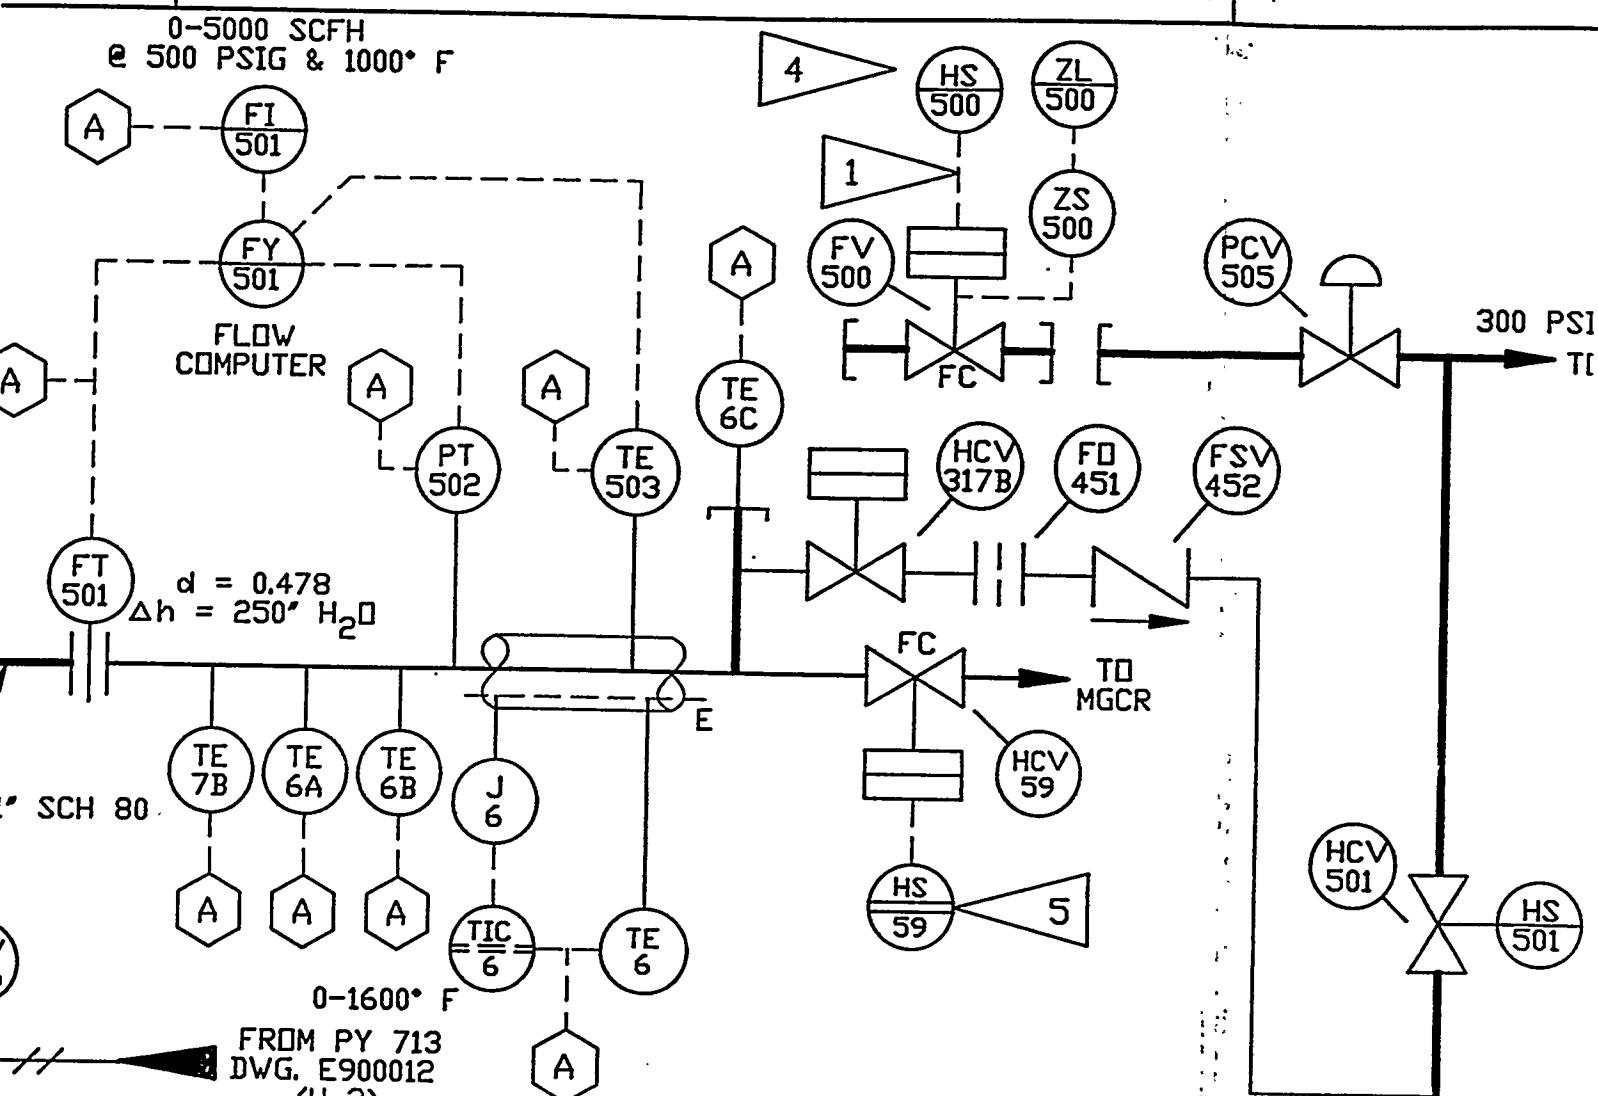

REVISION

ONE	REV	DESCRIPTION						BATE
EN	4	ADDED DESIGN PRESSURE AND DESIGN TEMPERATURE TO VSL-905, VSL-906, VSL-907, CYC-906, CYC-908, AND CYC-702; MODIFIED FI-501 AND VARIOUS SCFH'S REMOVED ALL NUMBERS FROM ADACS SYMBOLS ADDED FD-451, HCV-317B & FSV-452 ISSUED FOR CONSTRUCTION						04/01/93
TER	J. KULCHOCK	DATE 4/5/93	CHECKER S CONKO	DATE 4/5/93	EG&G RESPONSIBLE ENGR. JAY RUTTEN	DATE 4/7/93	REVIEWER D. LUNIFELD	DATE 4/7/93
ESTH	L. BUCKLEW	DATE 4/7/93	PROJECT ENGR. JOHN ROCKEY	DATE 5/27/93	BRANCH MANAGER LARRY STRICKLAND	DATE 5/27/93	DOE (EDSD) BILL AYERS	DATE 5/27/93
NE	REV	DESCRIPTION						BATE
EN	5	ADDED NOTE ON (2) INCINERATOR DESIGNATIONS; ADDED PIPE SIZE (ZONE C-6) ADDED "#1" TO ALL N ₂ DESIGNATIONS; REMOVED HV-932; REVISED AND RENAMED FV-931 "WAS HV-931" MODIFIED INCINERATOR DESCRIPTION IN "LEGEND"; ADDED TUBING SIZE TO SAMPLE SYSTEM B (ZONE D-3) ADDED NOTE TO VENT SYSTEM, ZONE F-5; ADDED HV-800B, HV-800A & TE-900 CONNECTED PIPING FROM VENT SYSTEM, ZONE A-7 & VSL-906 TO EXISTING SYSTEM ISSUED FOR CONSTRUCTION						09/01/93
TER	Gary Kulchock	DATE 9/10/93	CHECKER S. Conko	DATE 9/14/93	EG&G RESPONSIBLE ENGR. Jay Rutten	DATE 9/15/93	REVIEWER Dave Lunifeld	DATE 9/20/93
ESTH	Larry Bucklew	DATE 9/17/93	PROJECT ENGR. John Rockey	DATE 9/21/93	BRANCH MANAGER Larry Shadie	DATE 9/21/93	DOE (EDSD) John Rotunda/WJA	DATE 9/20/93
NE	REV	DESCRIPTION						BATE
EN	6	EXTENSIVE CHANGES AS PER MARKED PRINT REDLINED BY JAY RUTTEN ON 15 FEB 94. ISSUED FOR CONSTRUCTION						9/29/94
TER	15 Feb 94	DATE 10/17/94	CHECKER S. Conko	DATE 10-7-94	EG&G RESPONSIBLE ENGR. Jay Rutten	DATE 10-11-94	REVIEWER D. Lunifeld	DATE 10/11/94
ESTH	Redline	DATE 10-11-94	PROJECT ENGR. John Rockey	DATE 10/13/94	BRANCH MANAGER Larry Shadie	DATE 10-18-94	DOE (EDSD) WJA	DATE 10/14/94

H

G


TUBING SUMMARY


SIZE	WALL THICKNESS	TYPE
1/4"	0.035	304 SS
1/2"	0.035	CU TYPE K
1/2"	0.065	304 SS
1"	0.049	CU TYPE K



PIPING SUMMARY



SIZE	WALL THICKNESS	TYPE
1/2"	SCH 40	CS
1/2"	SCH 80	CS
1/2"	SCH 80	304 SS
1/2"	SCH 80	316 SS

F

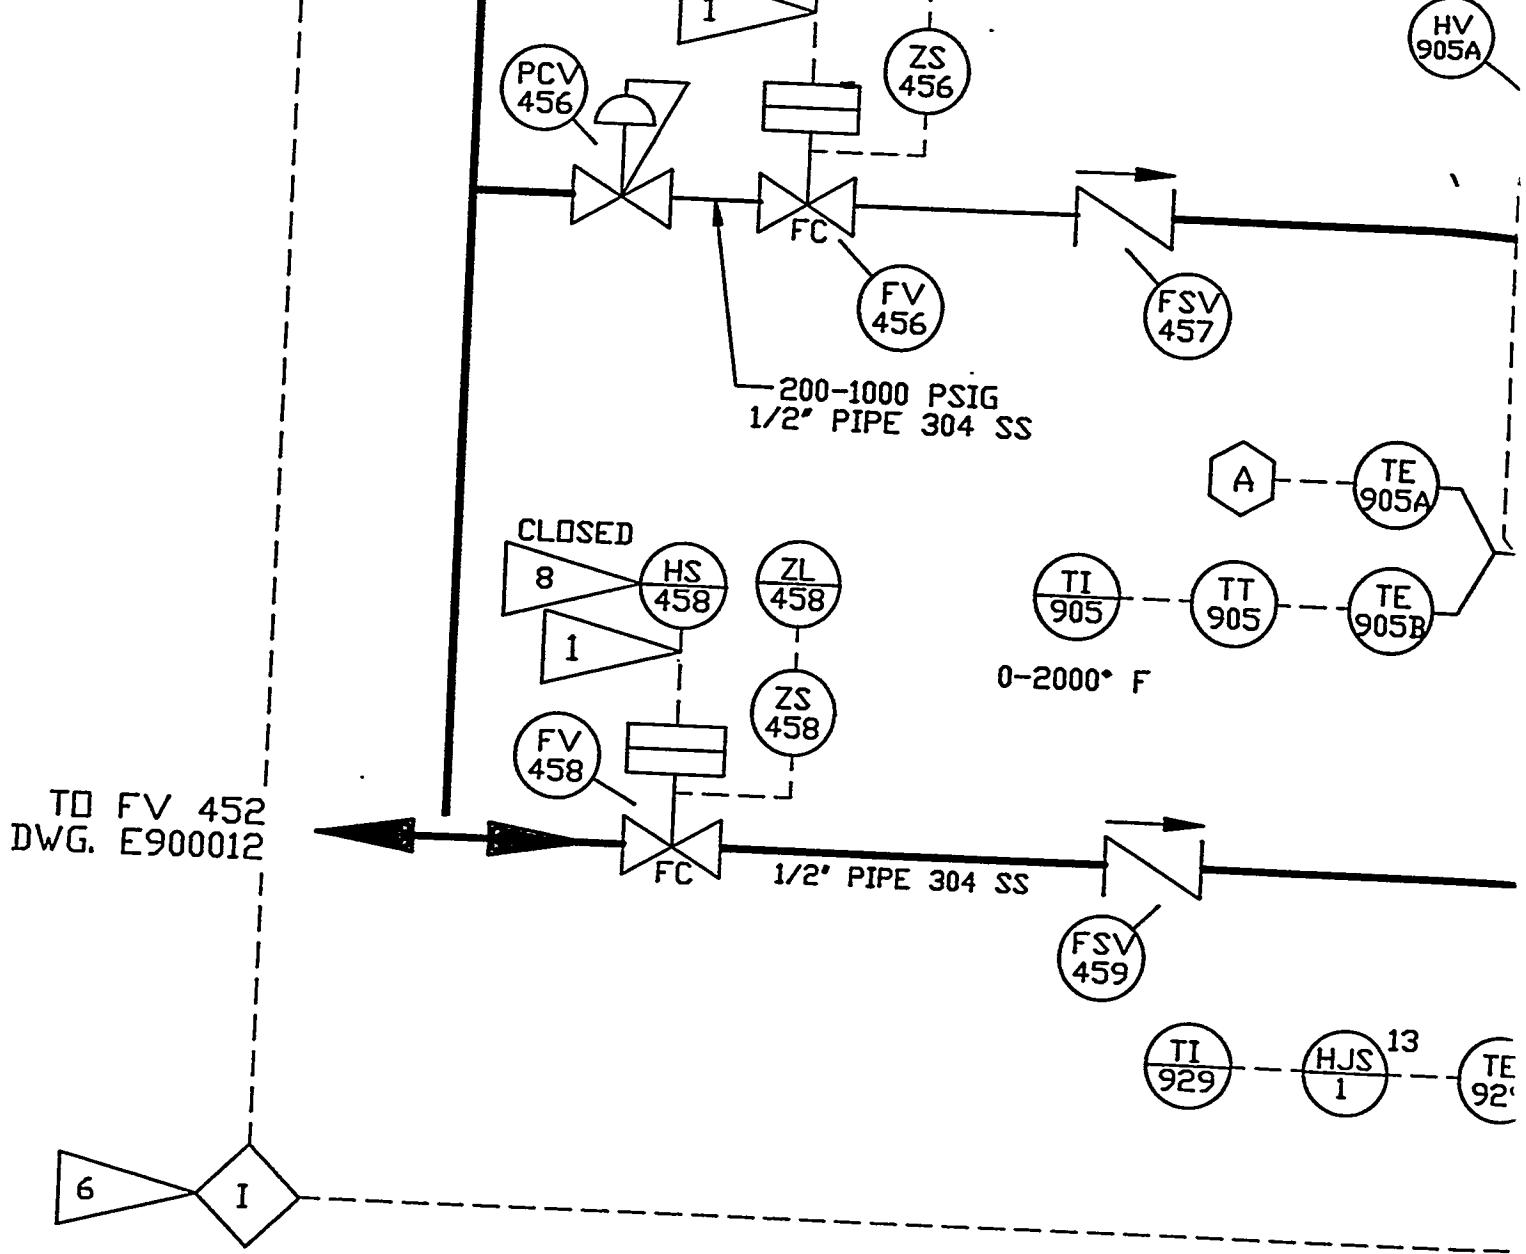

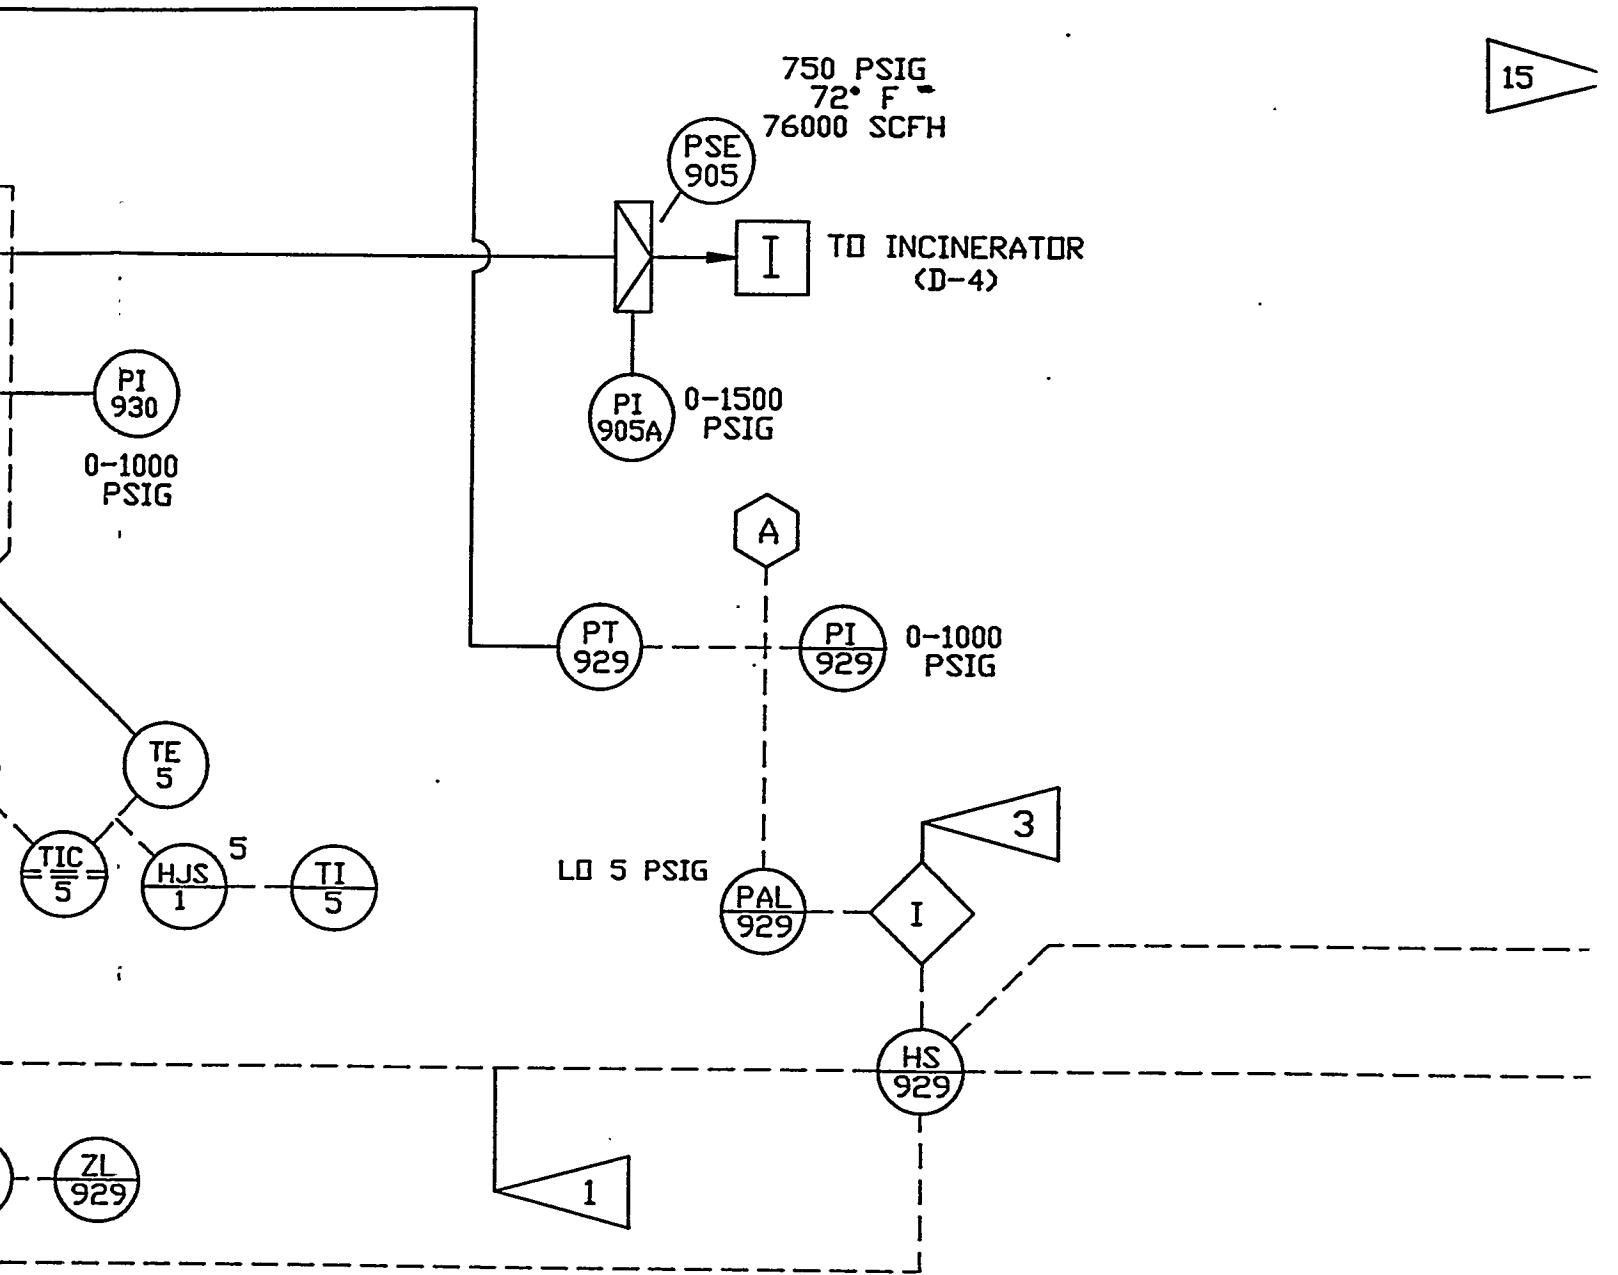

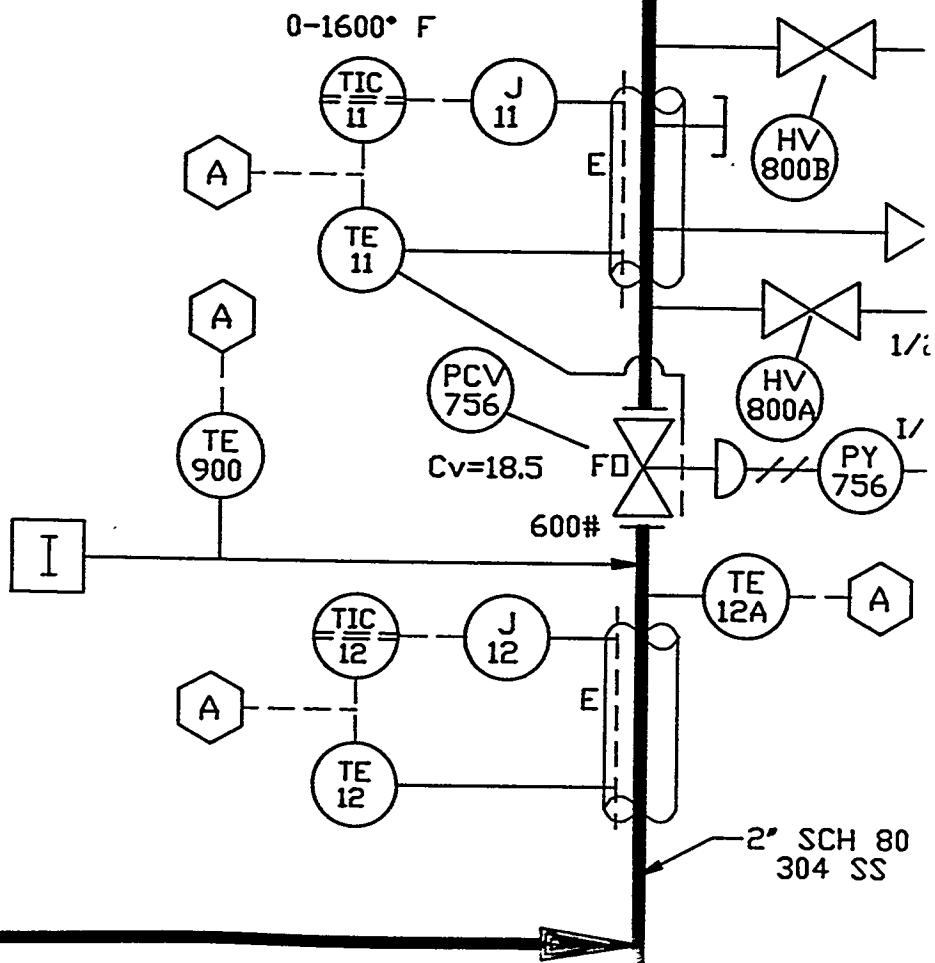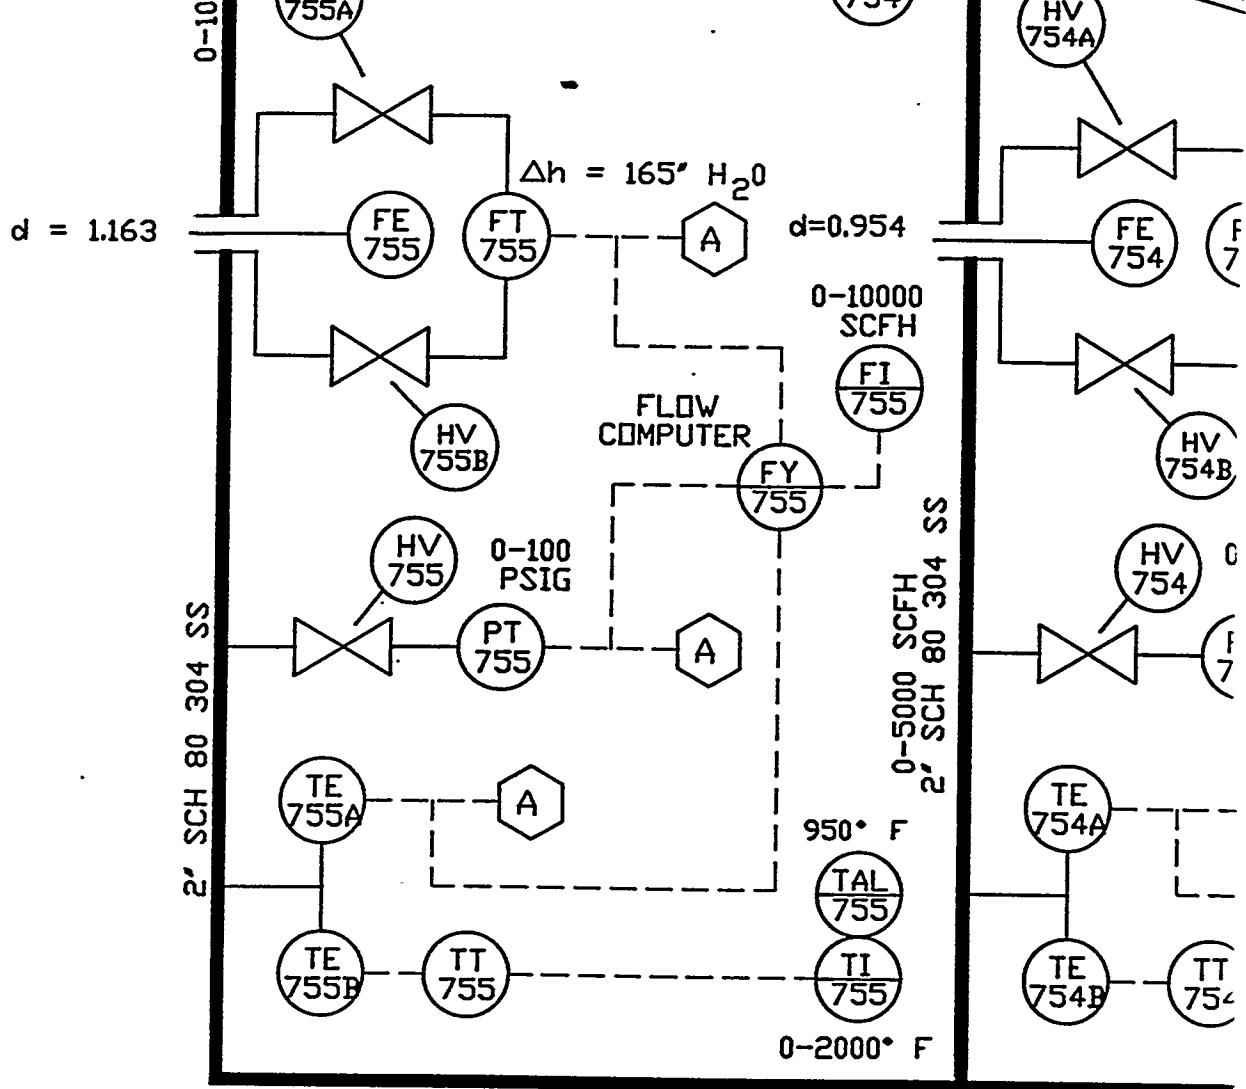

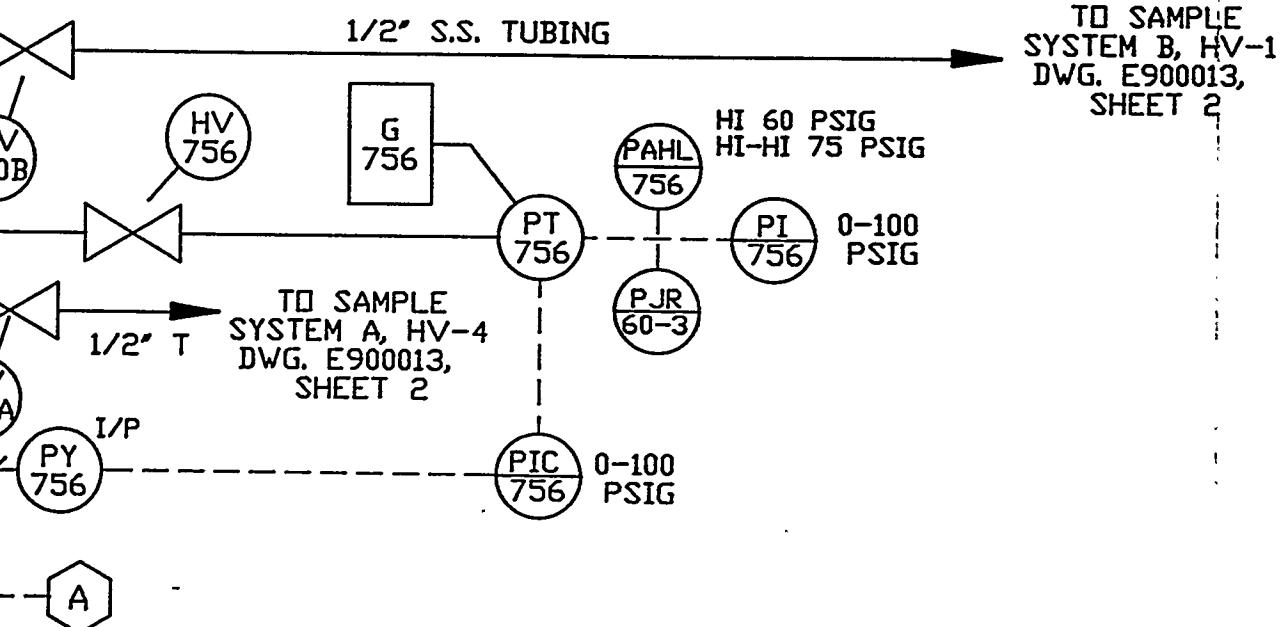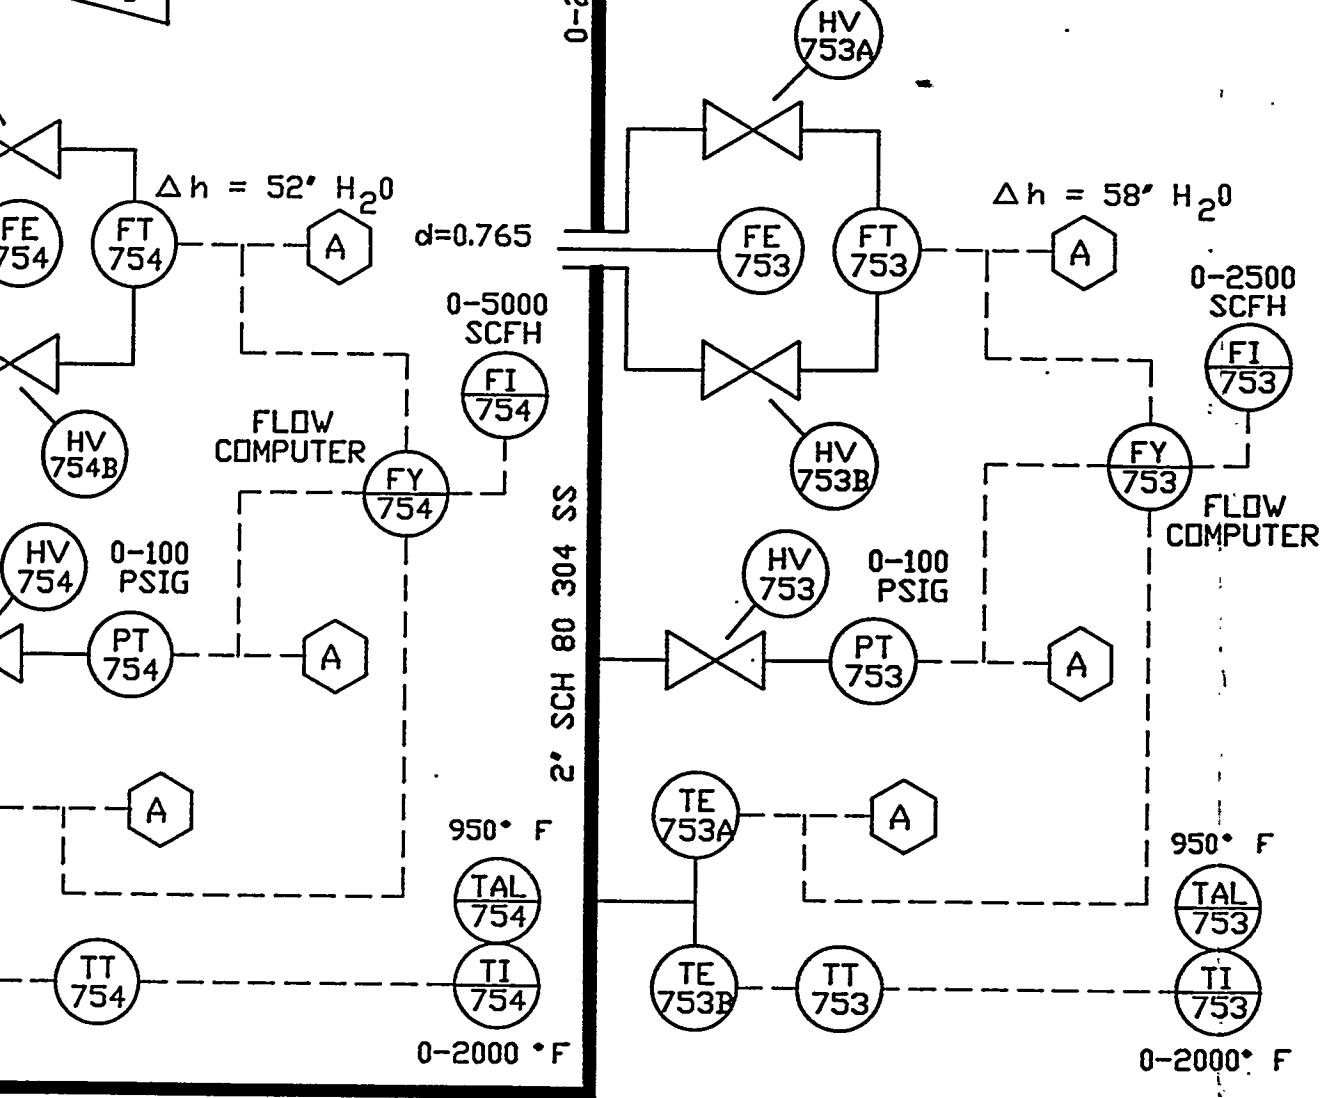


SCH 80
04 SS

1/2"	SCH 80	304 SS
1/2"	SCH 80	316 SS
1"	SCH 40	CS
1"	SCH 80	CS
1"	SCH 80	304 SS
1"	SCH 80	316 SS
1"	SCH 160	316 SS
2"	SCH 40	CS
2"	SCH 80	304 SS
2"	SCH 80	316 SS
3"	SCH 160	316 SS
4"	SCH 40	CS
4"	SCH 40	304 SS


500
FH
1
53

OW
UTER

NOTES:

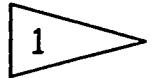


THIS FLAGGED NOTE DESIGNATES THE FOLLOWING WHICH IS NOT SHOWN ON THIS DWG. FOR CLARIT PANEL-MOUNTED ON/OFF STATION (HAND SWITCH POSITION INDICATION LAMPS), 24 VDC RELAY, 117 60 HZ SOLENOID VALVE.

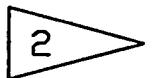

FV-926 WILL NOT OPEN UNTIL PDT-926 MEASURE DIFFERENTIAL LESS THAN OR EQUAL TO 5.0 PSID REF. DWG. NO. D910378. THE PRESSURE IN VSL-905 MUST BE LOWER THAN THE PRESSURE I



FV-929 WILL NOT OPEN UNTIL PT-929 MEASURE LESS THAN OR EQUAL TO 2 PSIG. REF. DWG. NO.

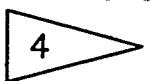


THE (B-12) FBG'S HS-500 AND THE (B-4) SIDEST HS-500 MUST BOTH BE ON FOR FV-500 TO OPEN.




HS-59 IS LOCATED ON THE MGCR CONTROL PANEL




LOCKHOPPER FILL VALVE CANNOT BE OPENED IF VALVE IS OPENED. DUMP VALVE CANNOT BE OPENED IF CHARGING VALVE IS OPENED. N₂ CHARGING VALVE CANNOT BE OPENED IF THE FILL OR DUMP VALVES ARE OPENED.

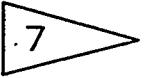

RELAY INTERLOCKS PREVENT THE LOCKHOPPERS FROM OPENING UNLESS THE VENT VALVE IS OPEN AT THE SAME TIME.

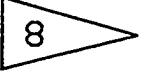

DESIGNATES THAT THE CONTROL PANEL SWITCH IS LOCKED TO PREVENT ACCIDENTAL ACTUATION.

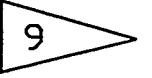

RELAY INTERLOCKS PREVENT THE LOCKHOPPER VALVE FV-927 FROM OPENING UNLESS FV-912 IS OPEN.

10

LINES TO GAUGES, TRANSMITTERS, & MANUAL PRESSURE REGULATORS TO FLAIR ARE 1/2".

11

VALVE TYPES & END CONNECTIONS ARE NOT IDENTIFIED.

1/2"	SCH 80	304 SS
1"	SCH 40	316 SS
1"	SCH 80	- CS
1"	SCH 80	CS
1"	SCH 80	304 SS
1"	SCH 80	316 SS
1"	SCH 160	316 SS
2"	SCH 40	CS
2"	SCH 80	304 SS
2"	SCH 80	316 SS
3"	SCH 160	316 SS
4"	SCH 40	CS
4"	SCH 40	304 SS

ES:

1 THIS FLAGGED NOTE DESIGNATES THE FOLLOWING EQUIPMENT WHICH IS NOT SHOWN ON THIS DWG. FOR CLARITY; PANEL-MOUNTED ON/OFF STATION (HAND SWITCH WITH POSITION INDICATION LAMPS), 24 VDC RELAY, 117 VAC 60 HZ SOLENOID VALVE.

2 FV-926 WILL NOT OPEN UNTIL PDT-926 MEASURES A PRESSURE DIFFERENTIAL LESS THAN OR EQUAL TO 5.0 PSID. REF. DWG. NO. D910378. THE PRESSURE IN VSL-905 MUST BE LOWER THAN THE PRESSURE IN CYC-702

3 FV-929 WILL NOT OPEN UNTIL PT-929 MEASURES A PRESSURE LESS THAN OR EQUAL TO 2 PSIG. REF. DWG. NO. D910378

4 THE (B-12) FBG'S HS-500 AND THE (B-4) SIDESTREAM'S HS-500 MUST BOTH BE ON FOR FV-500 TO OPEN.

5 HS-59 IS LOCATED ON THE MGCR CONTROL PANEL

2 LOCKHOPPER FILL VALVE CANNOT BE OPENED IF THE N₂ CHARGING VALVE IS OPENED. DUMP VALVE CANNOT BE OPENED IF THE N₂ CHARGING VALVE IS OPENED. N₂ CHARGING VALVE CANNOT BE OPENED IF THE FILL OR DUMP VALVES ARE OPEN.

7 RELAY INTERLOCKS PREVENT THE LOCKHOPPERS FILL VALVE AND VENT VALVE FROM BEING OPEN AT THE SAME TIME.

8 DESIGNATES THAT THE CONTROL PANEL SWITCH IS PHYSICALLY LOCKED TO PREVENT ACCIDENTAL ACTUATION.

D RELAY INTERLOCKS PREVENT THE LOCKHOPPER VENT VALVE FV-927 FROM OPENING UNLESS FV-912 IS OPEN.

LINES TO GAUGES, TRANSMITTERS, & MANUAL PRESSURE RELIEF TO FLAIR ARE 1/2".

VALVE TYPES & END CONNECTIONS ARE NOT INDICATED


E


D

C

B


A

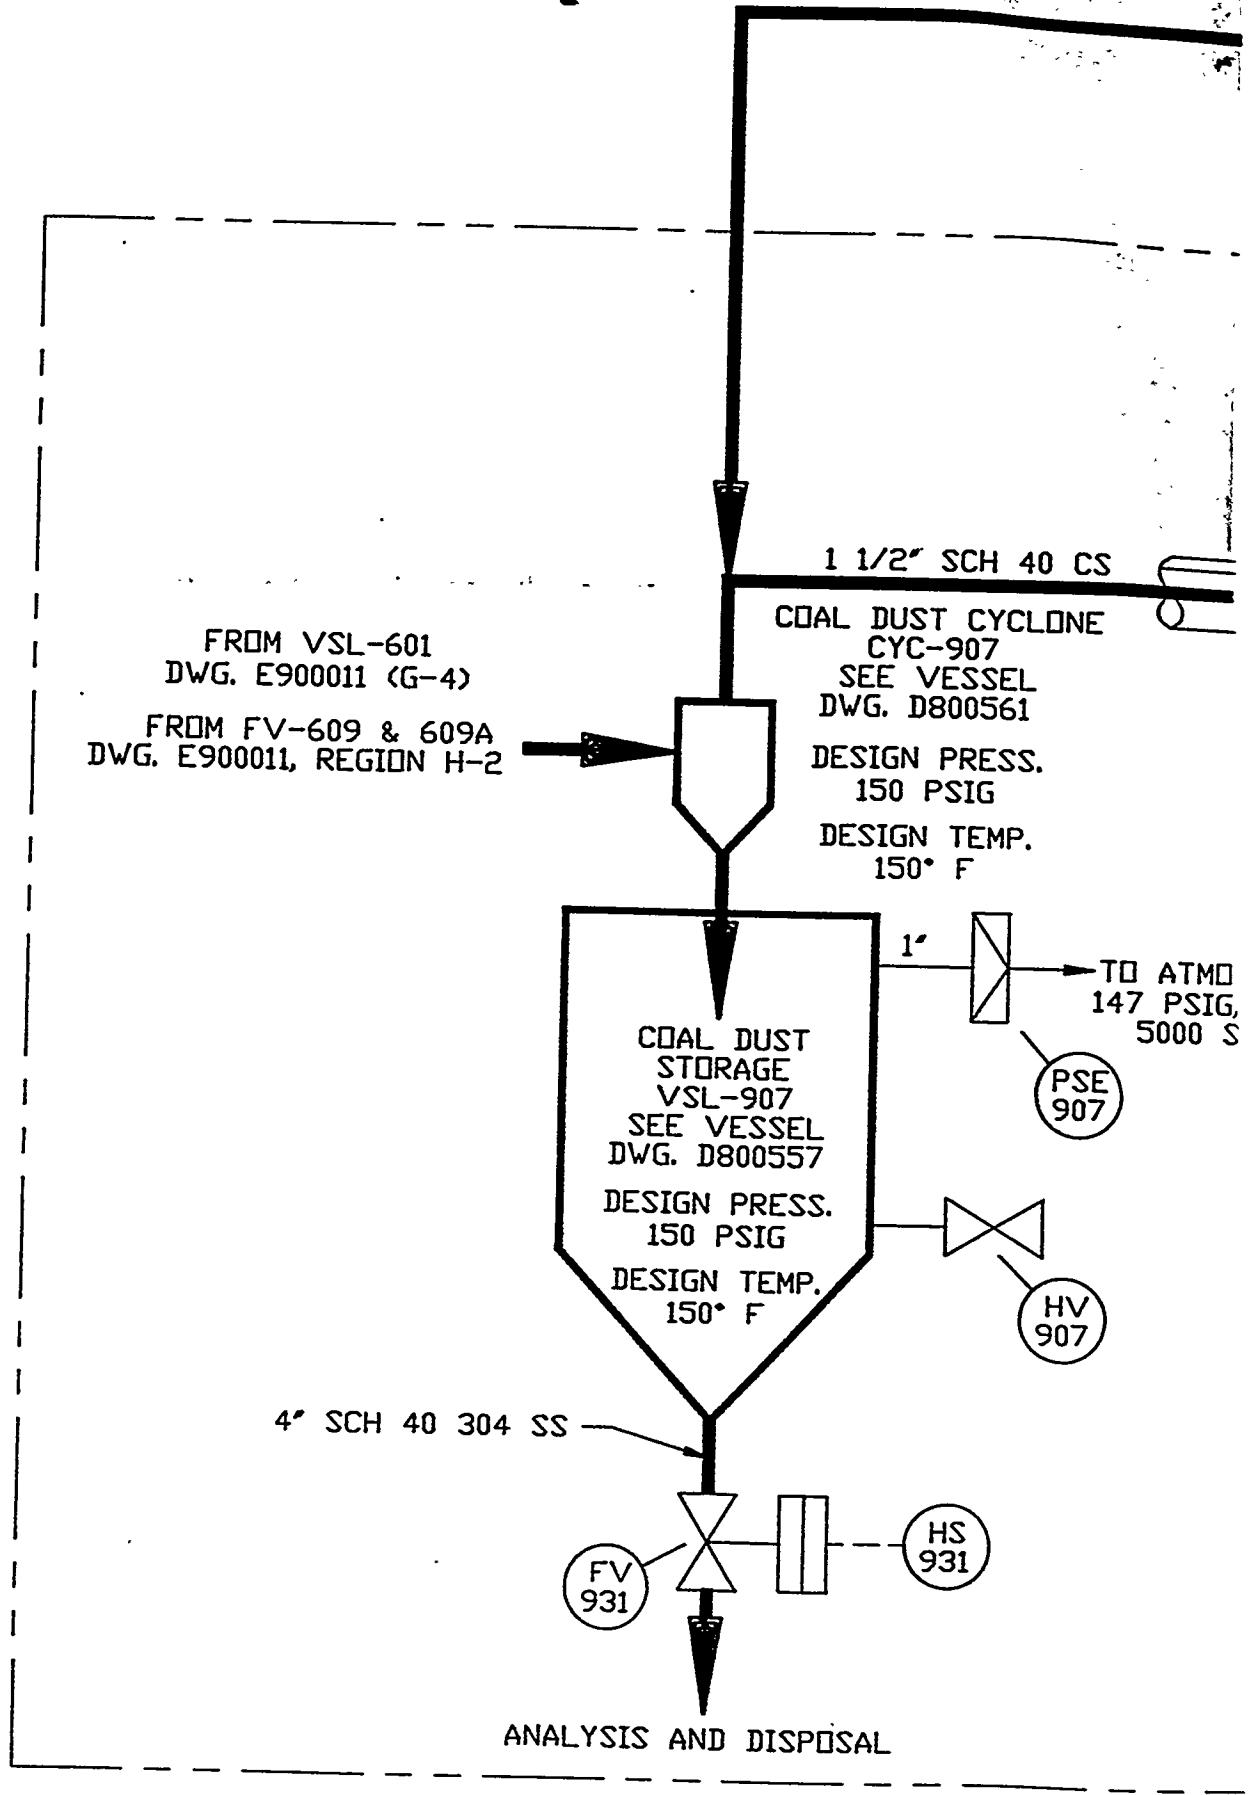

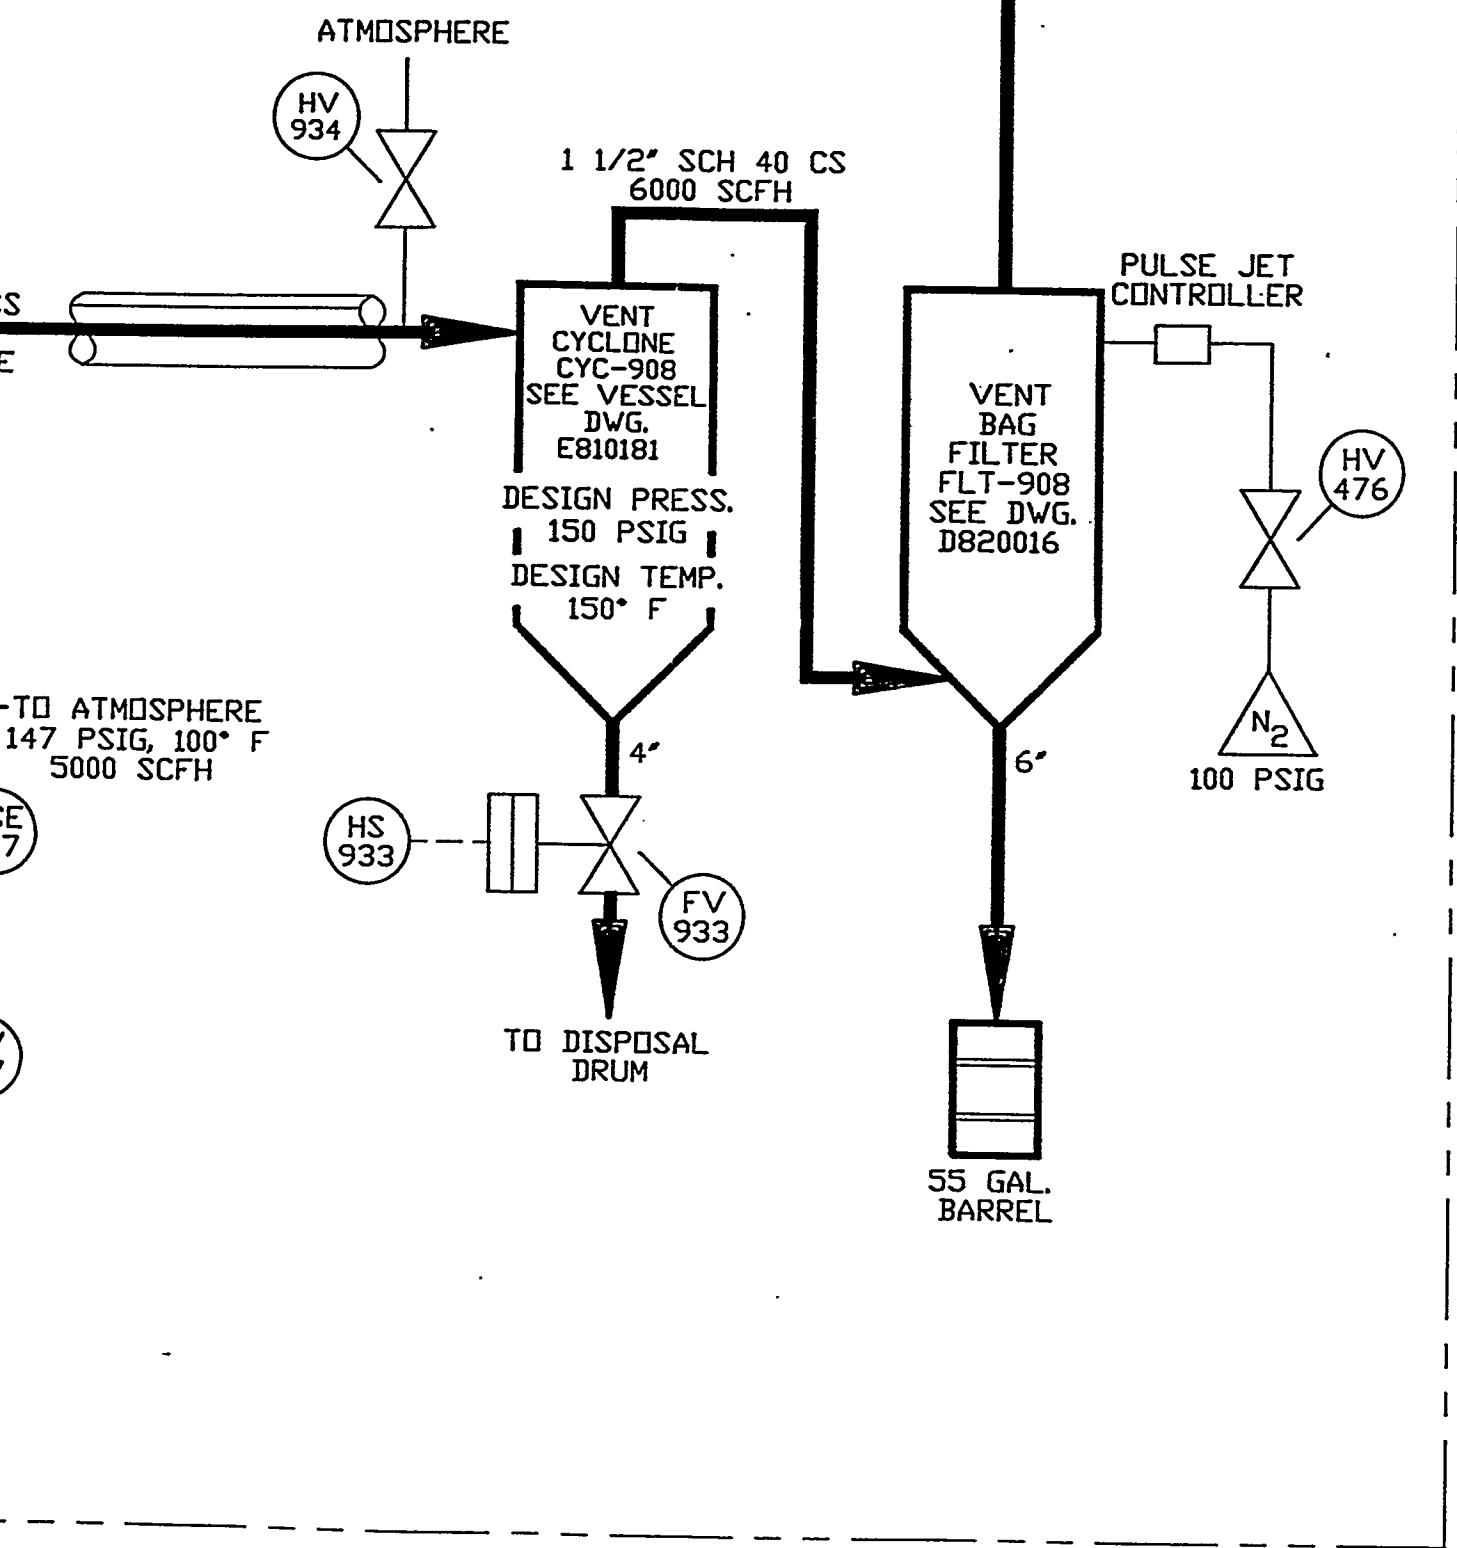

VENT SYSTEM

FROM SAMPLING
SYSTEM
DWG. E900013, SHT
(G-1, H-6, F-6, E-

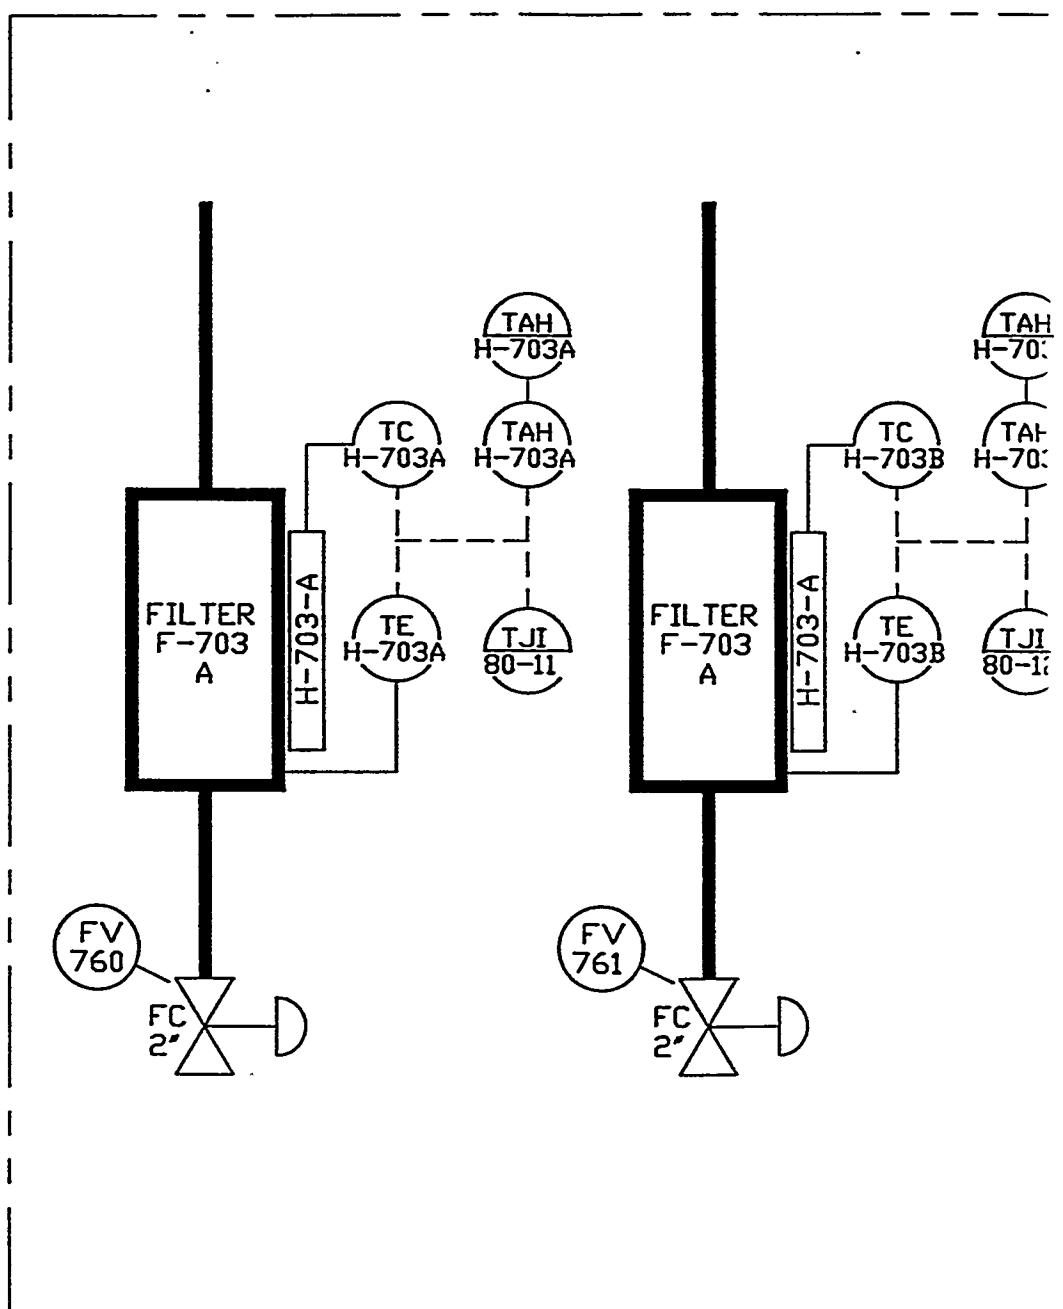


DISCONNECTED AND DISAE

FROM B-12
ENTRAINED UNIT

DM SAMPLING
SYSTEM
E900013, SHT 2
H-6, F-6, E-3

PACKAGED
INCINERATOR
SYSTEM

NATURAL GAS
35 PSIG

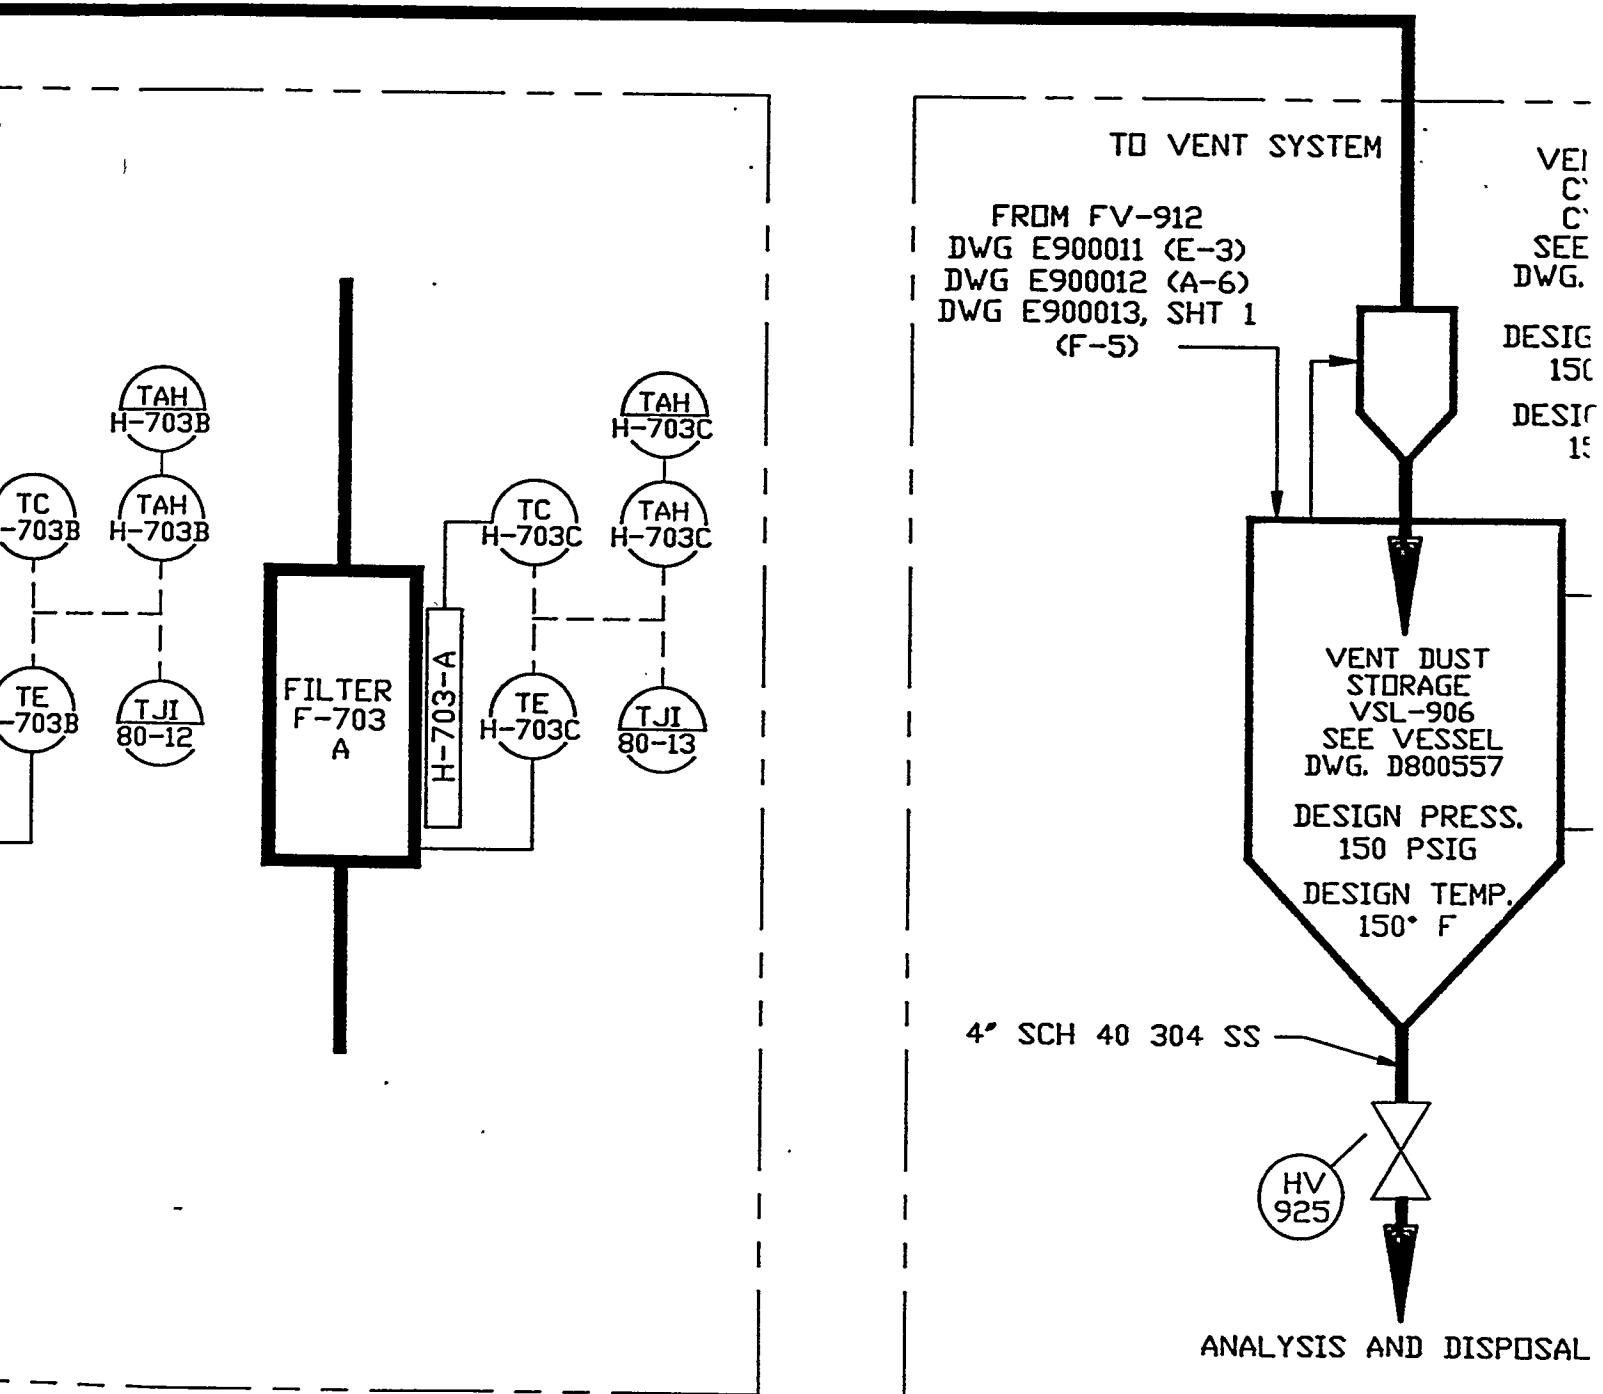

D DISABLED

SCF IS A

12 THIS DWG.
SUPERCEDE

13 RELAY IN
VALVES

14 RELAY IN
FROM OPE

LEGEND:

RSS = RANGE SE

I = MANIFOLI

A = INPUT TC


G XXX IDENTIFI
PURGE S
NUMBER.
THIS SYM
IS IN TH
TRANSMIT
FV-44
FSV-X

H XXX IDENTIFI
PURGE S
NUMBER.
THIS SYI
IS IN TH
TRANSMI
FV-44

VENT DUST
CYCLONE
CYC-906
SEE VESSEL
DWG. D800561


DESIGN PRESS.
150 PSIG

DESIGN TEMP.
150° F

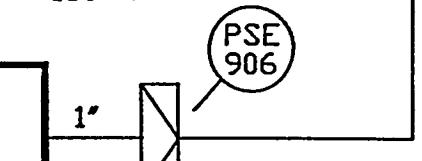

147 PSIG, 100° F
5000 SCFH

0-200
PSIG

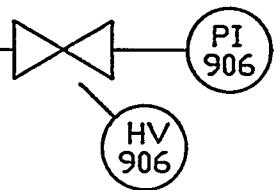

OSAL

REFERENCE DRAWINGS

E900010
E900011
E900012
E920205

DRAFTER

S. CONKO

CHECKER

A. R. KUBALA

PROJECT ENGINEER

J. P. KANDSKY

THIS DRAWING IS PART
OF THE EG&G DOCUMENT
CONTROL SYSTEM

12 SCF IS AT 14.7 PSIA AND 60° F

13 THIS DWG. & DWGS. E900010, E900011, AND E900012
SUPERCEDES DWG. R800524.

14 RELAY INTERLOCKS PREVENT THE LOCKHOPPERS FILL AND DUMP
VALVES FROM BEING OPEN AT THE SAME TIME.

15 RELAY INTERLOCKS PREVENT THE LOCKHOPPERS DUMP VALVE
FROM OPENING UNLESS THE VENT VALVE IS OPEN.

C

LEGEND:

RSS = RANGE SELECTOR SWITCH

I = MANIFOLD TO PACKAGED INCINERATOR SYSTEM

A = INPUT TO THE DDAS SYSTEM

G XXX IDENTIFIES THE CONNECTING SEGMENT OF THE TRANSMITTER
PURGE SYSTEM, WHERE XXX IS THE SEGMENT IDENTIFICATION
NUMBER. (SEE DWG. E900013, SHT. 2 OF 2 FOR DETAILS.)
THIS SYMBOL INDICATES THAT THE FOLLOWING EQUIPMENT
IS IN THE PURGE LINE FROM THE NITROGEN HEADER TO THE
TRANSMITTER:

FV-440, FSV-441, HV-441, HV-XXXP, FV-XXXP, &
FSV-XXXP

H XXX IDENTIFIES THE CONNECTING SEGMENT OF THE TRANSMITTER
PURGE SYSTEM, WHERE XXX IS THE SEGMENT IDENTIFICATION
NUMBER. (SEE DWG. E900013, SHT. 2 OF 2 FOR DETAILS.)
THIS SYMBOL INDICATES THAT THE FOLLOWING EQUIPMENT
IS IN THE PURGE LINE FROM THE NITROGEN HEADER TO THE
TRANSMITTER:

FV-440, FSV-441, HV-441, HV-XXXP, & FSV-XXXP.

E900013
1
REV B

DRAFTER	S. CONKO	DATE	3/6/90	 <p>United States Department of Energy MORGANTOWN ENERGY TECHNOLOGY CENTER Morgantown, WV</p>
CHECKER	A. R. KUBALA	DATE	3/6/90	
PROJECT ENGINEER	J. P. KANDSKY	DATE	3/6/90	
		DATE		TITLE
B-12 P&ID FLUIDIZED BED GASIFIER A.G.C.				
		SIZE	FSCH NO	DWG NO
		E		E900013

A